

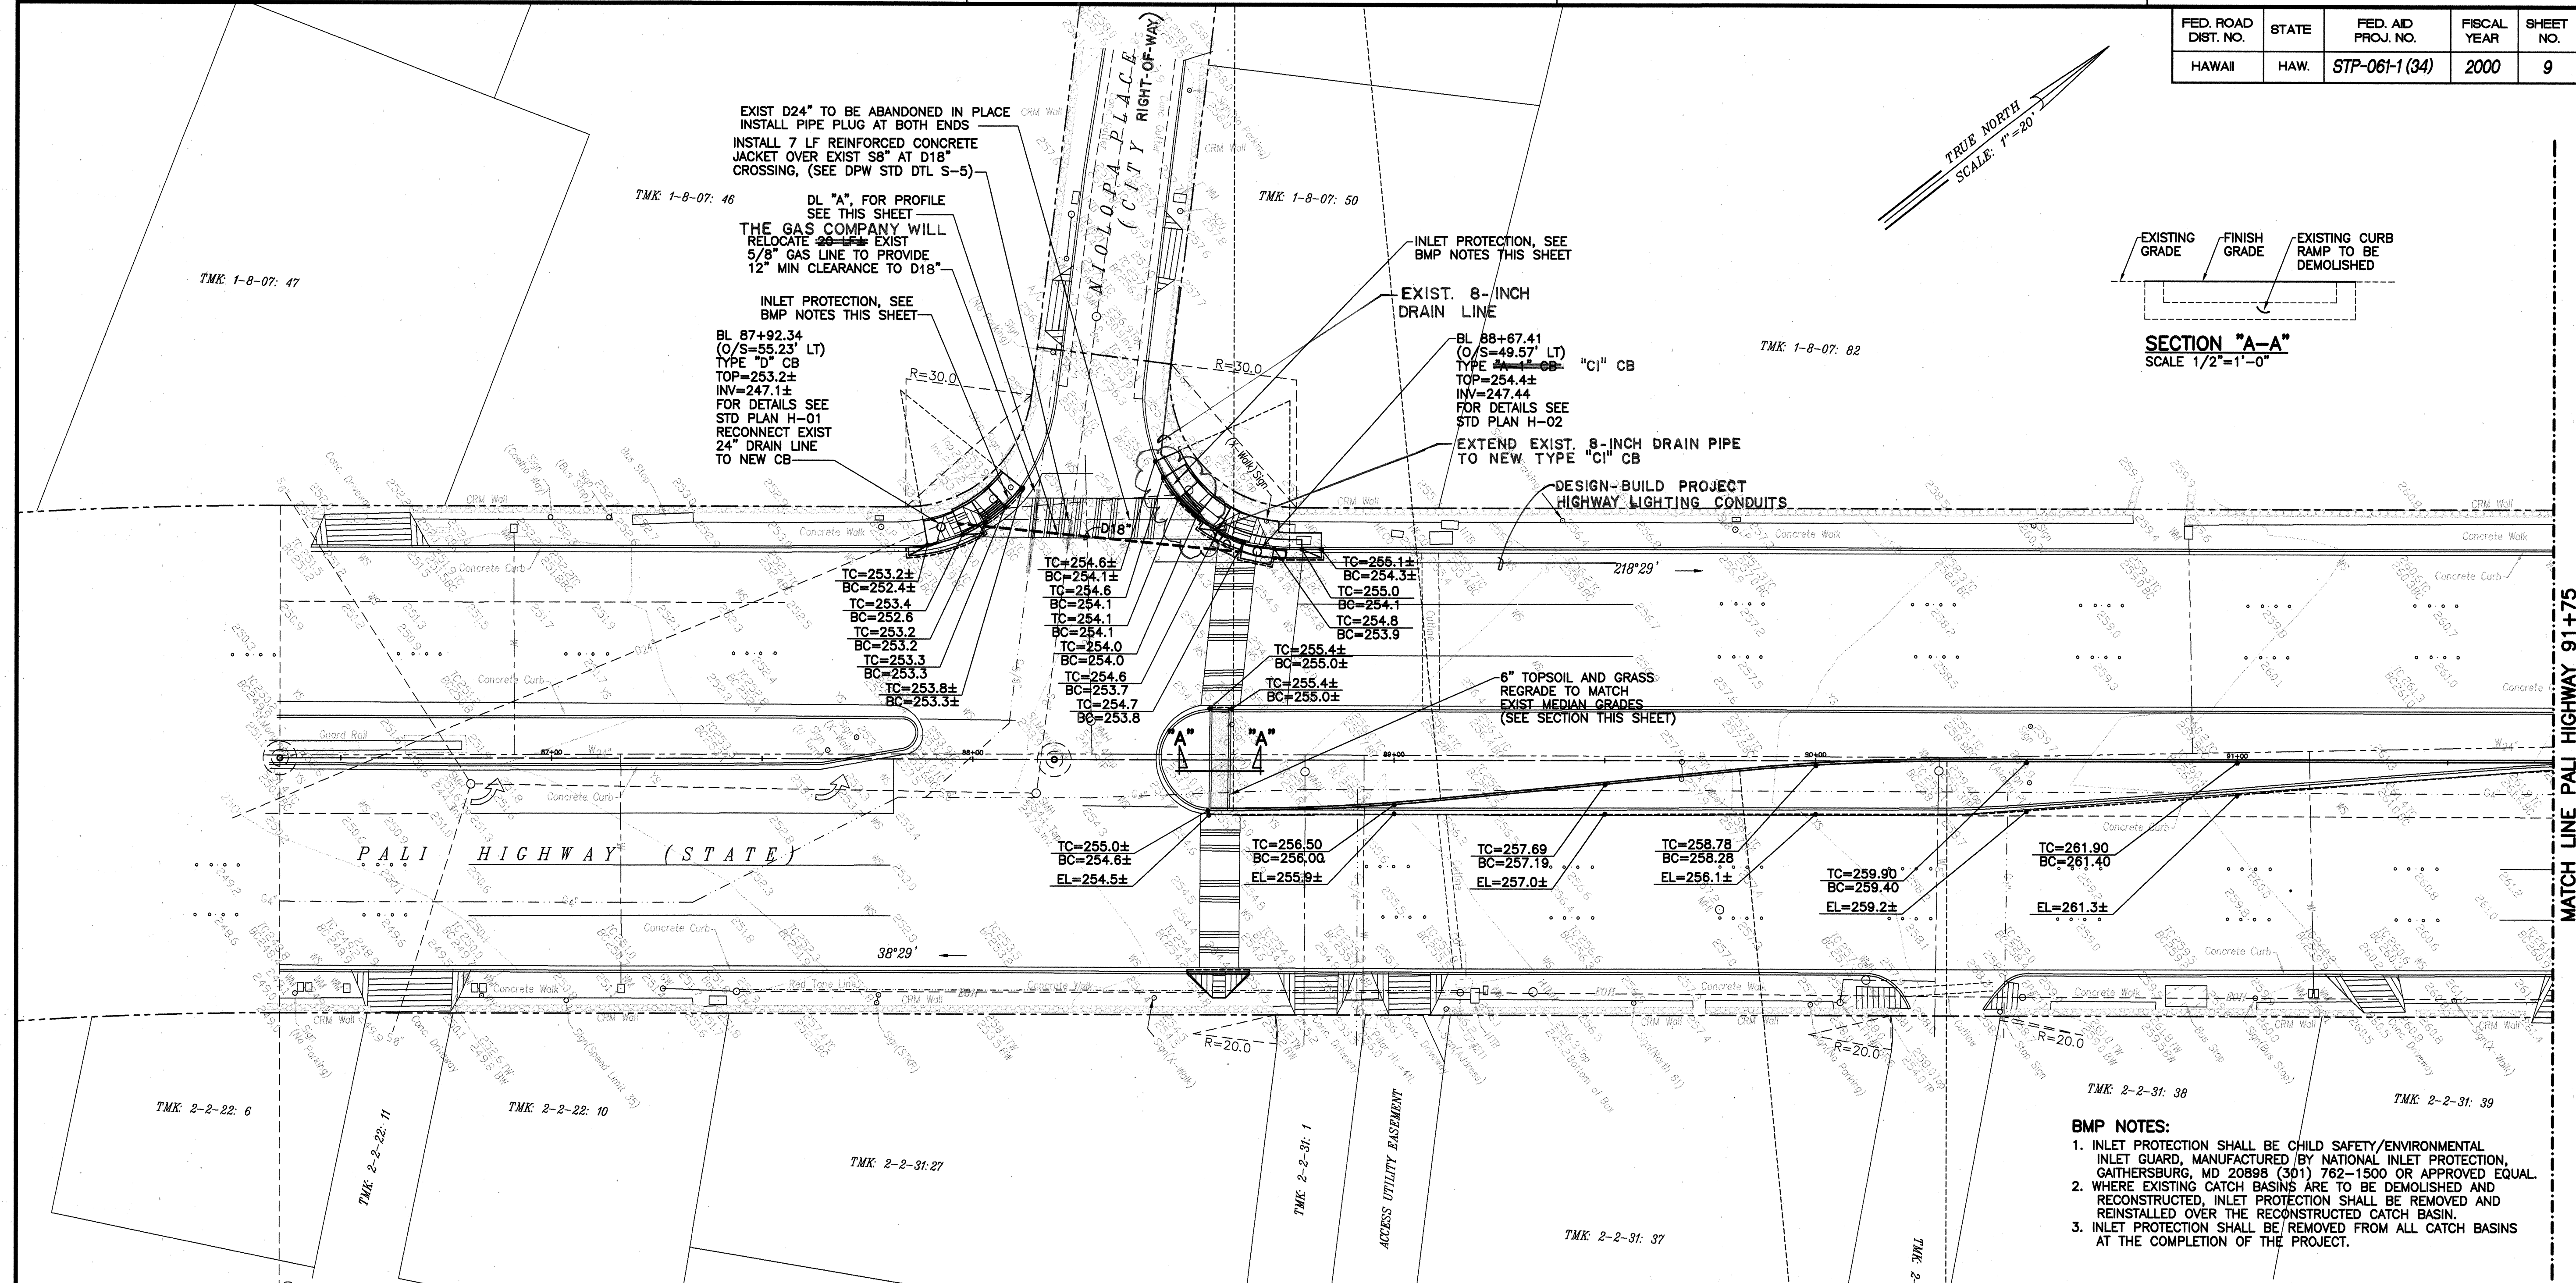
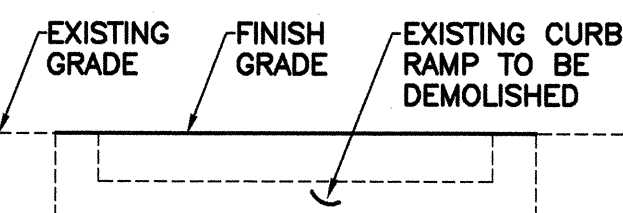


FED. ROAD DIST. NO.	STATE	FED. AID PROJ. NO.	FISCAL YEAR	SHEET NO.	TOTAL SHEETS
HAWAII	HAW.	STP-061-1 (34)	2000	9	38

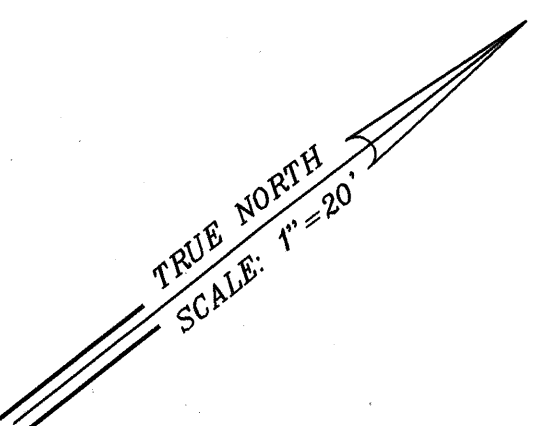

- BMP NOTES:**
1. INLET PROTECTION SHALL BE CHILD SAFETY/ENVIRONMENTAL INLET GUARD, MANUFACTURED BY NATIONAL INLET PROTECTION, GAITHERSBURG, MD 20898 (301) 762-1500 OR APPROVED EQUAL.
 2. WHERE EXISTING CATCH BASINS ARE TO BE DEMOLISHED AND RECONSTRUCTED, INLET PROTECTION SHALL BE REMOVED AND REINSTALLED OVER THE RECONSTRUCTED CATCH BASIN.
 3. INLET PROTECTION SHALL BE REMOVED FROM ALL CATCH BASINS AT THE COMPLETION OF THE PROJECT.

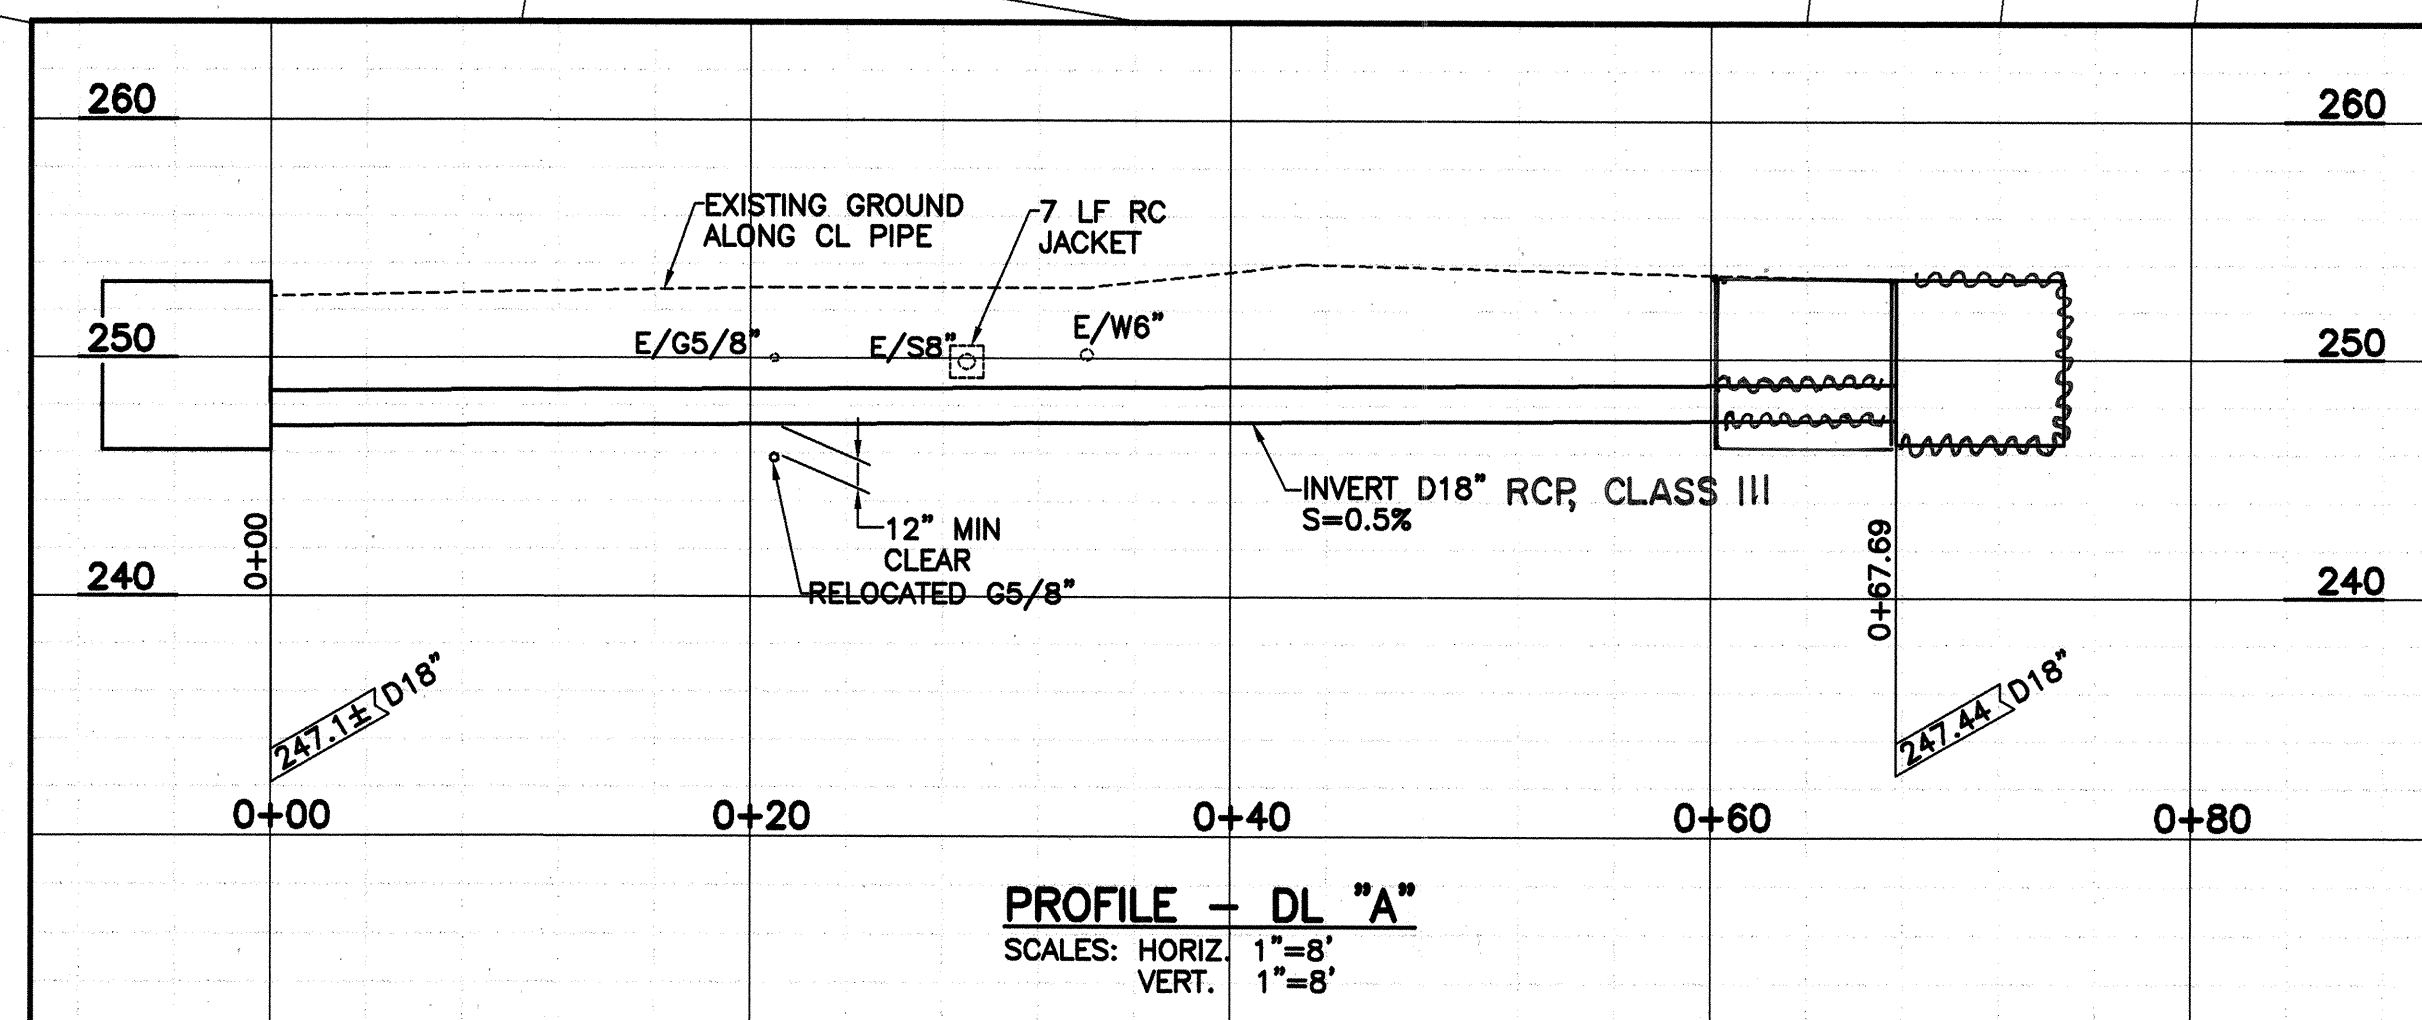

APPROVED BY:

Dennis M. Nishimura
CHIEF, WASTEWATER BRANCH, DPP

4/6/00
DATE



THIS WORK WAS PREPARED BY ME OR UNDER MY SUPERVISION

3/28/00	Revised D25' to D18" at Niolopa Place
DATE	REVISION
STATE OF HAWAII DEPARTMENT OF TRANSPORTATION HIGHWAYS DIVISION	
GRADING AND DRAINAGE PLAN	
PALI HIGHWAY INTERSECTION IMPROVEMENTS AT JACK LANE F.A. PROJECT NO. STP-061-1 (34)	
Scale: As Noted	Date: Feb 29, 2000
SHEET No. 1 OF 2 SHEETS	

ORIGINAL PLAN	DATE
NO. 1	3/28/00
DESIGNED BY	
CHECKED BY	
QUANTITIES BY	
DATE	

Installation 98420 09 Used (PH-CB)

AS-BUILT

ADD. 9

