


FED. ROAD DIST. NO.	STATE	FED. AID PROJ. NO.	FISCAL YEAR	SHEET NO.	TOTAL SHEETS
HAWAII	HAW.	STP-061-1 (34)	2000	6	38

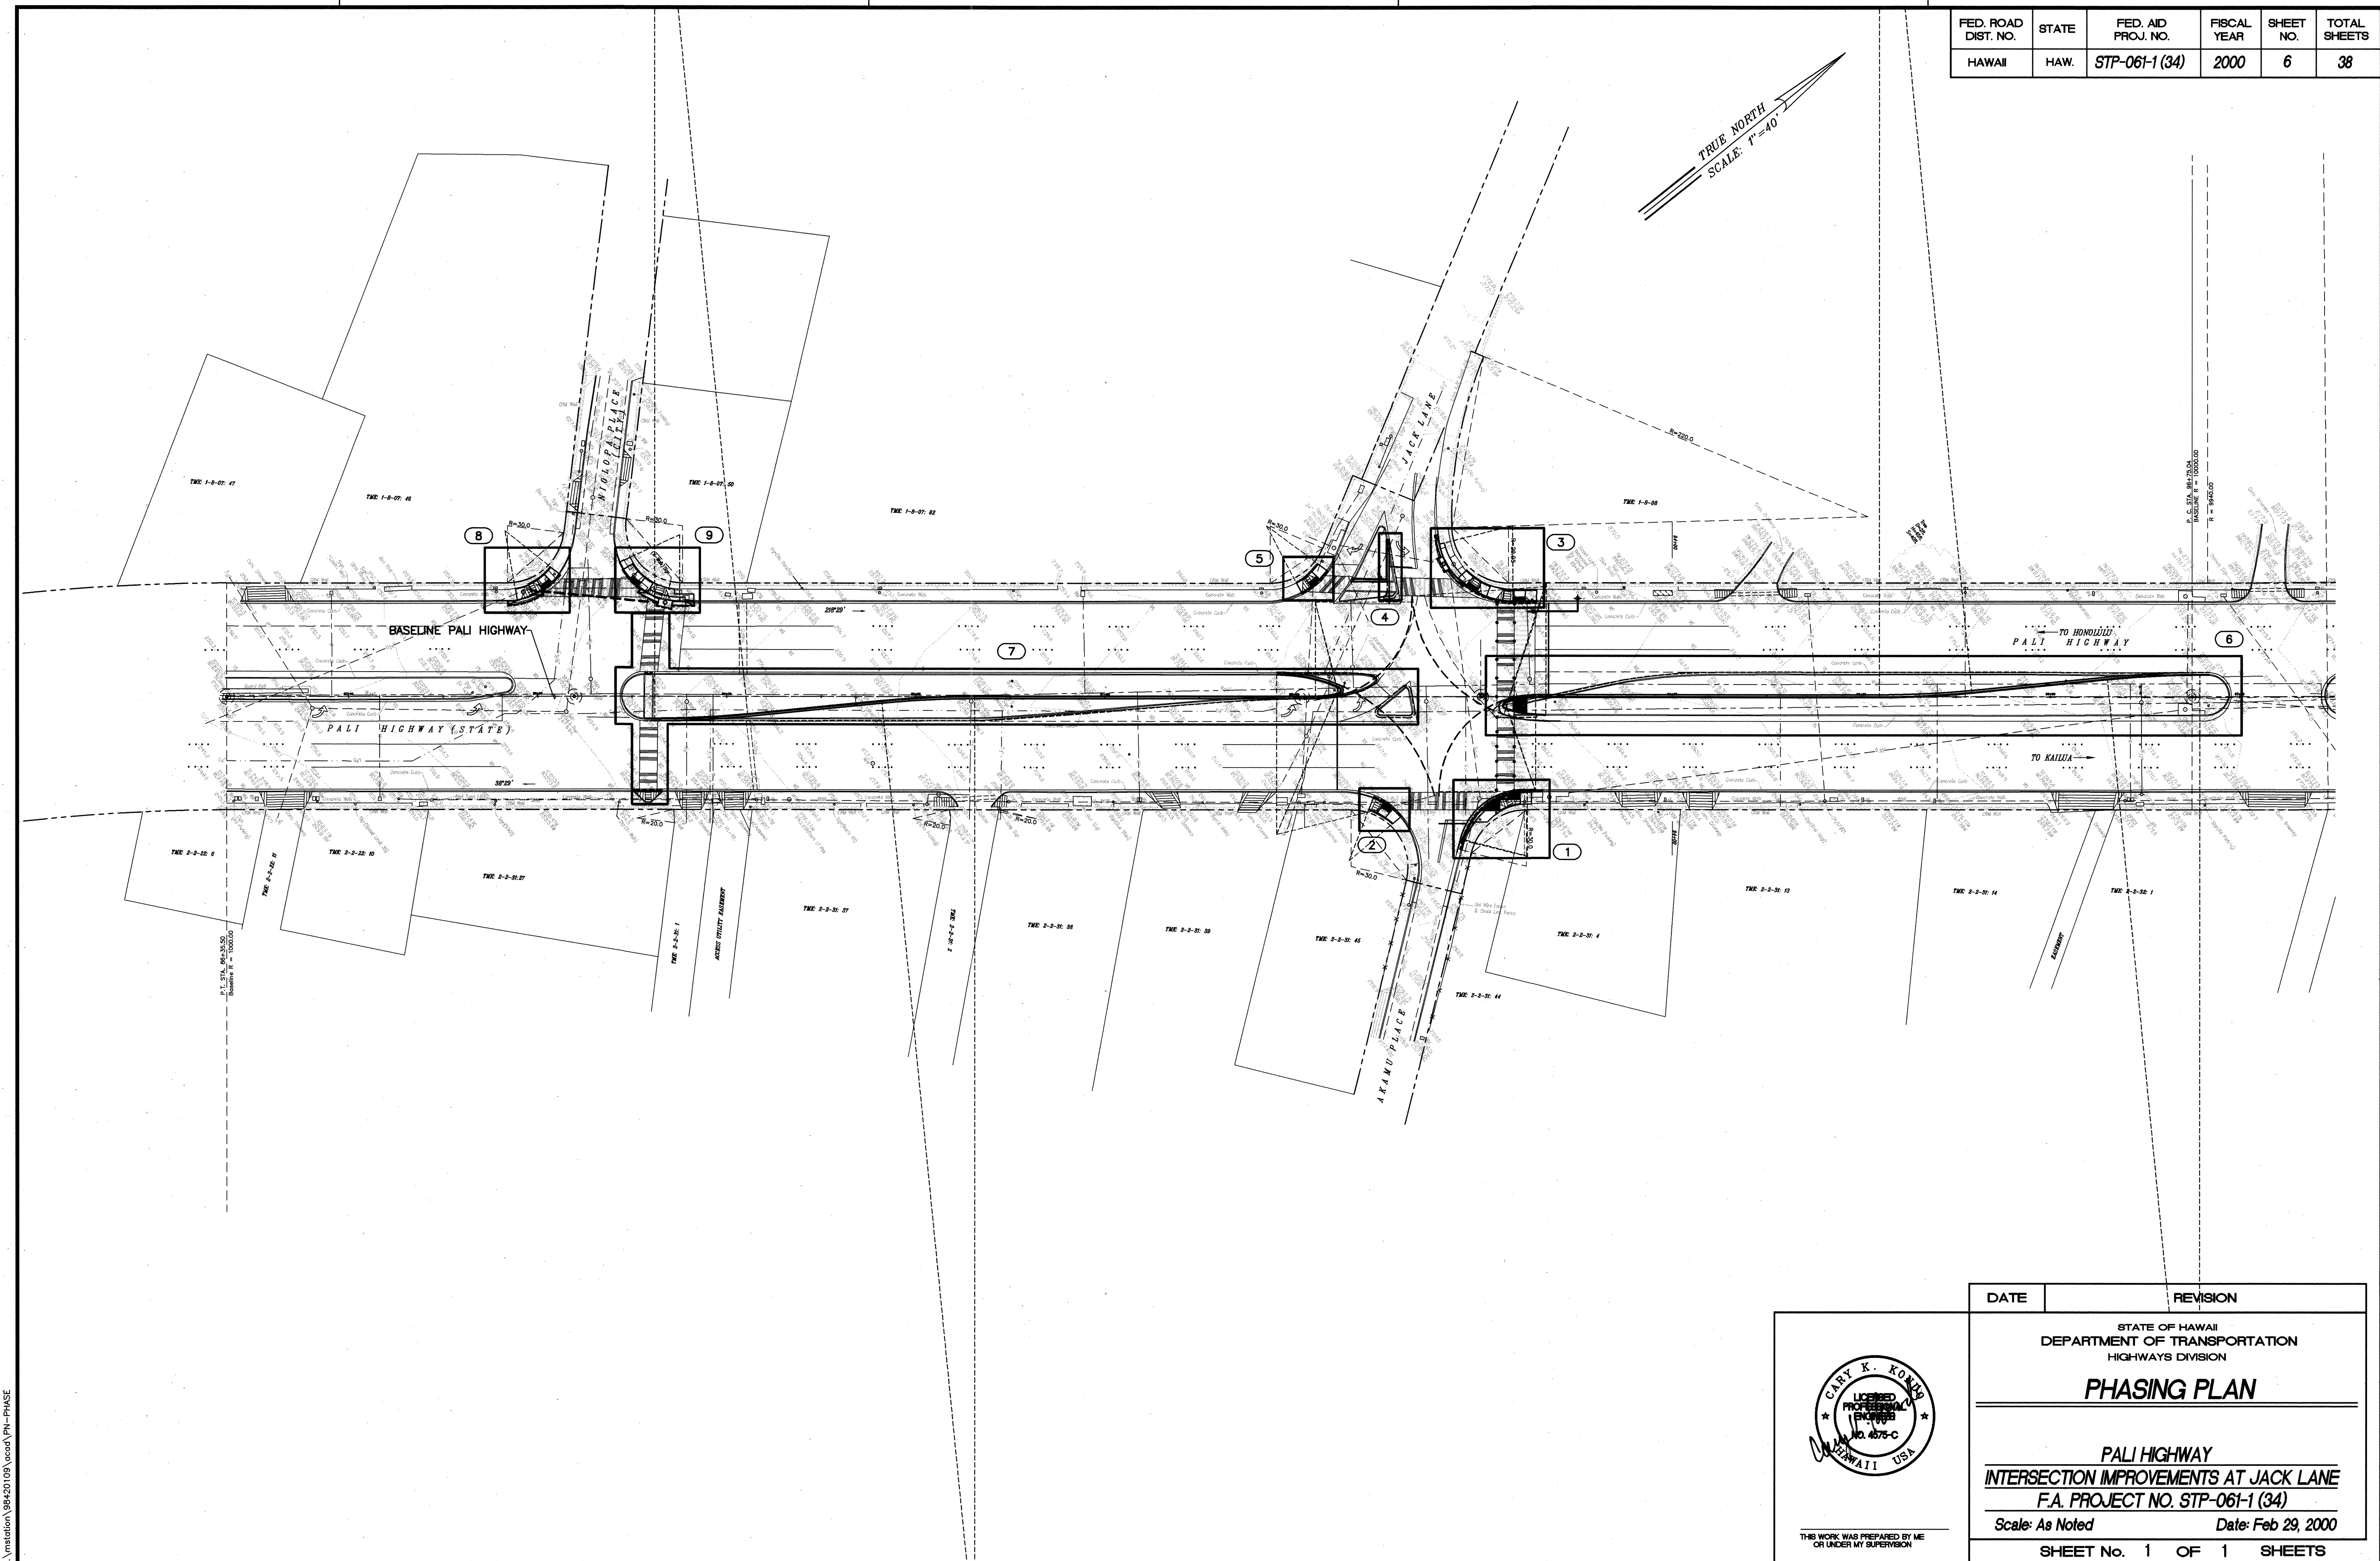

ORIGINAL PLAN	SURVEY PLOTTED BY	DATE
NOTE BOOK	DRAWN BY	
	DESIGNED BY	
	QUANTITIES BY	
	CHECKED BY	
No.		

\\station\98420109\road\PH-PHASE

DATE	REVISION
	STATE OF HAWAII DEPARTMENT OF TRANSPORTATION HIGHWAYS DIVISION
	PHASING PLAN
	PALI HIGHWAY INTERSECTION IMPROVEMENTS AT JACK LANE F.A. PROJECT NO. STP-061-1 (34)
	Scale: As Noted Date: Feb 29, 2000
	SHEET No. 1 OF 1 SHEETS