


FED. ROAD DIST. NO.	STATE	FED. AID PROJ. NO.	FISCAL YEAR	SHEET NO.	TOTAL SHEETS
HAWAII	HAW.	STP-061-1 (34)	2000	11	38

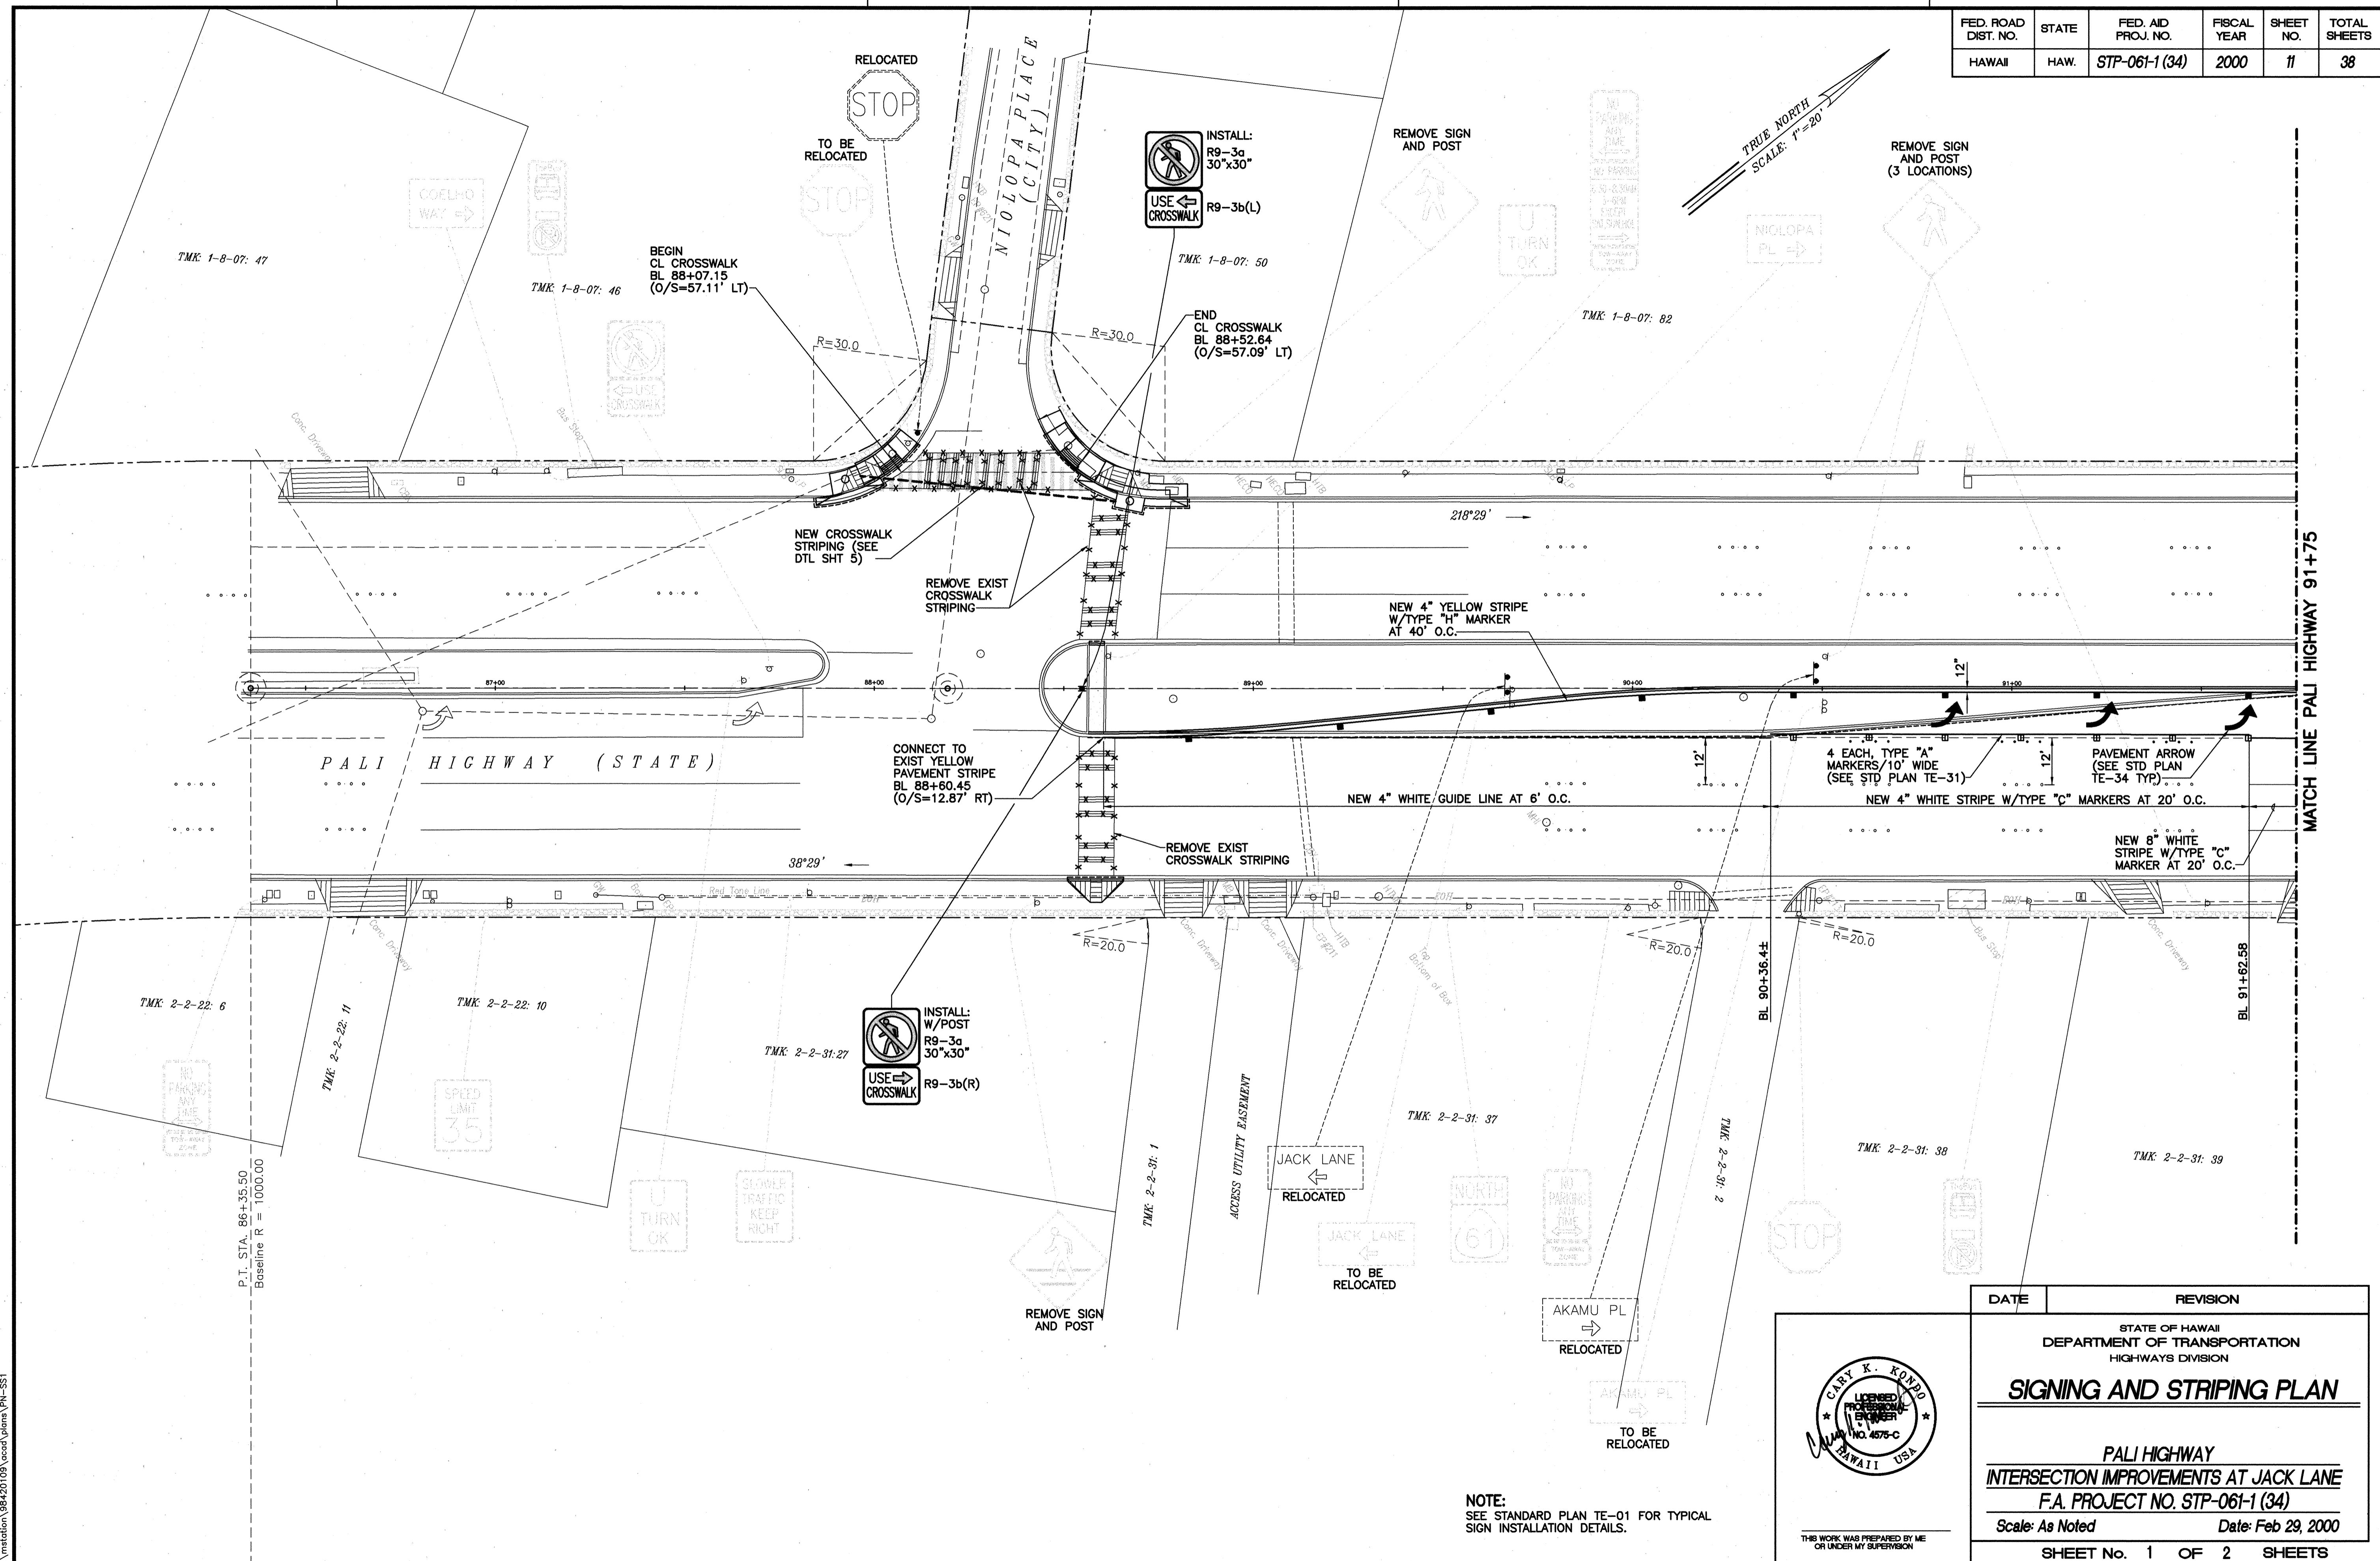


SURVEY PLOTTED BY	DATE
DRAWN BY	
DESIGNED BY	
QUANTITIES BY	
CHECKED BY	
NO.	

\\mstest01\984\201\09\Local\plans\SPN-SS1

P.I. STA. 86+35.50  
Baseline R = 1000.00

NOTE:  
SEE STANDARD PLAN TE-01 FOR TYPICAL SIGN INSTALLATION DETAILS.

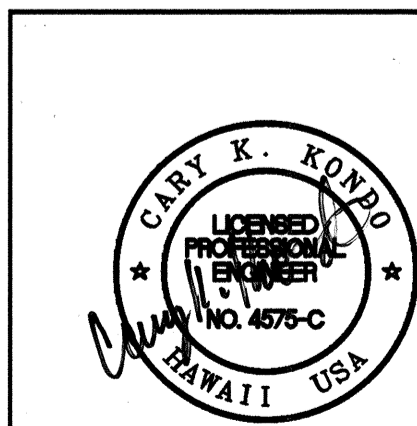

THIS WORK WAS PREPARED BY ME OR UNDER MY SUPERVISION

DATE	REVISION
STATE OF HAWAII DEPARTMENT OF TRANSPORTATION HIGHWAYS DIVISION	
<b>SIGNING AND STRIPING PLAN</b>	
PALI HIGHWAY INTERSECTION IMPROVEMENTS AT JACK LANE F.A. PROJECT NO. STP-061-1 (34)	
Scale: As Noted	Date: Feb 29, 2000
SHEET No. 1 OF 2 SHEETS	

