
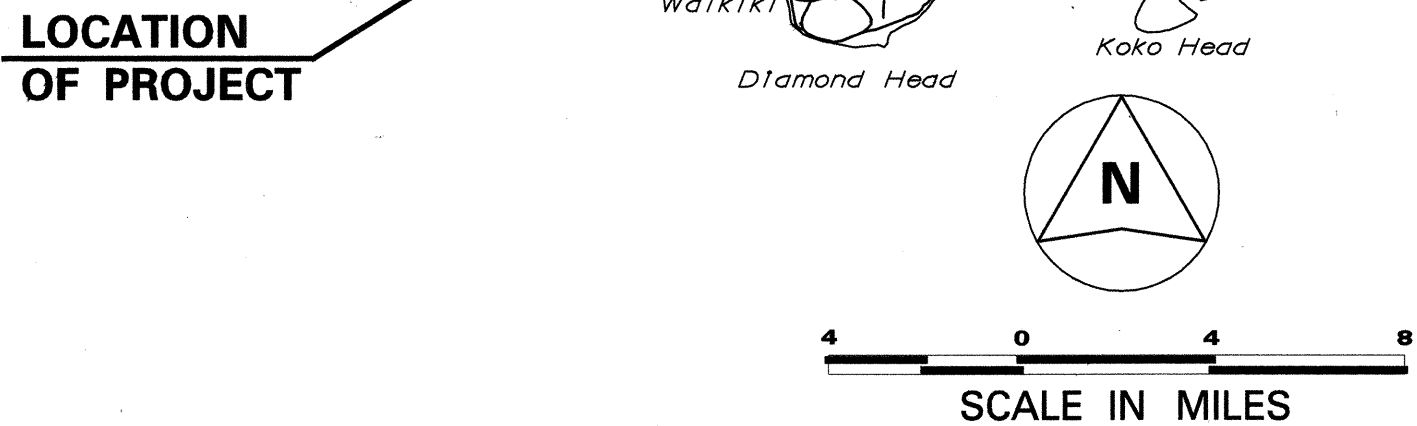
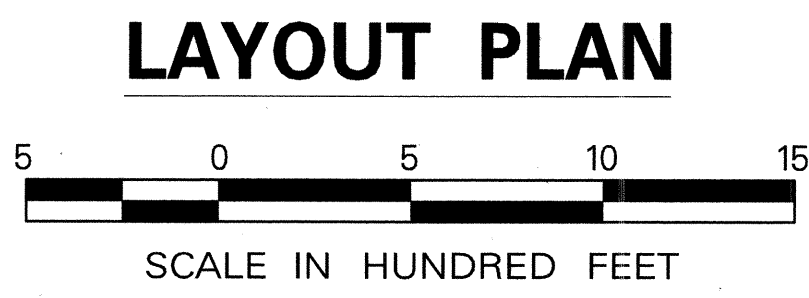
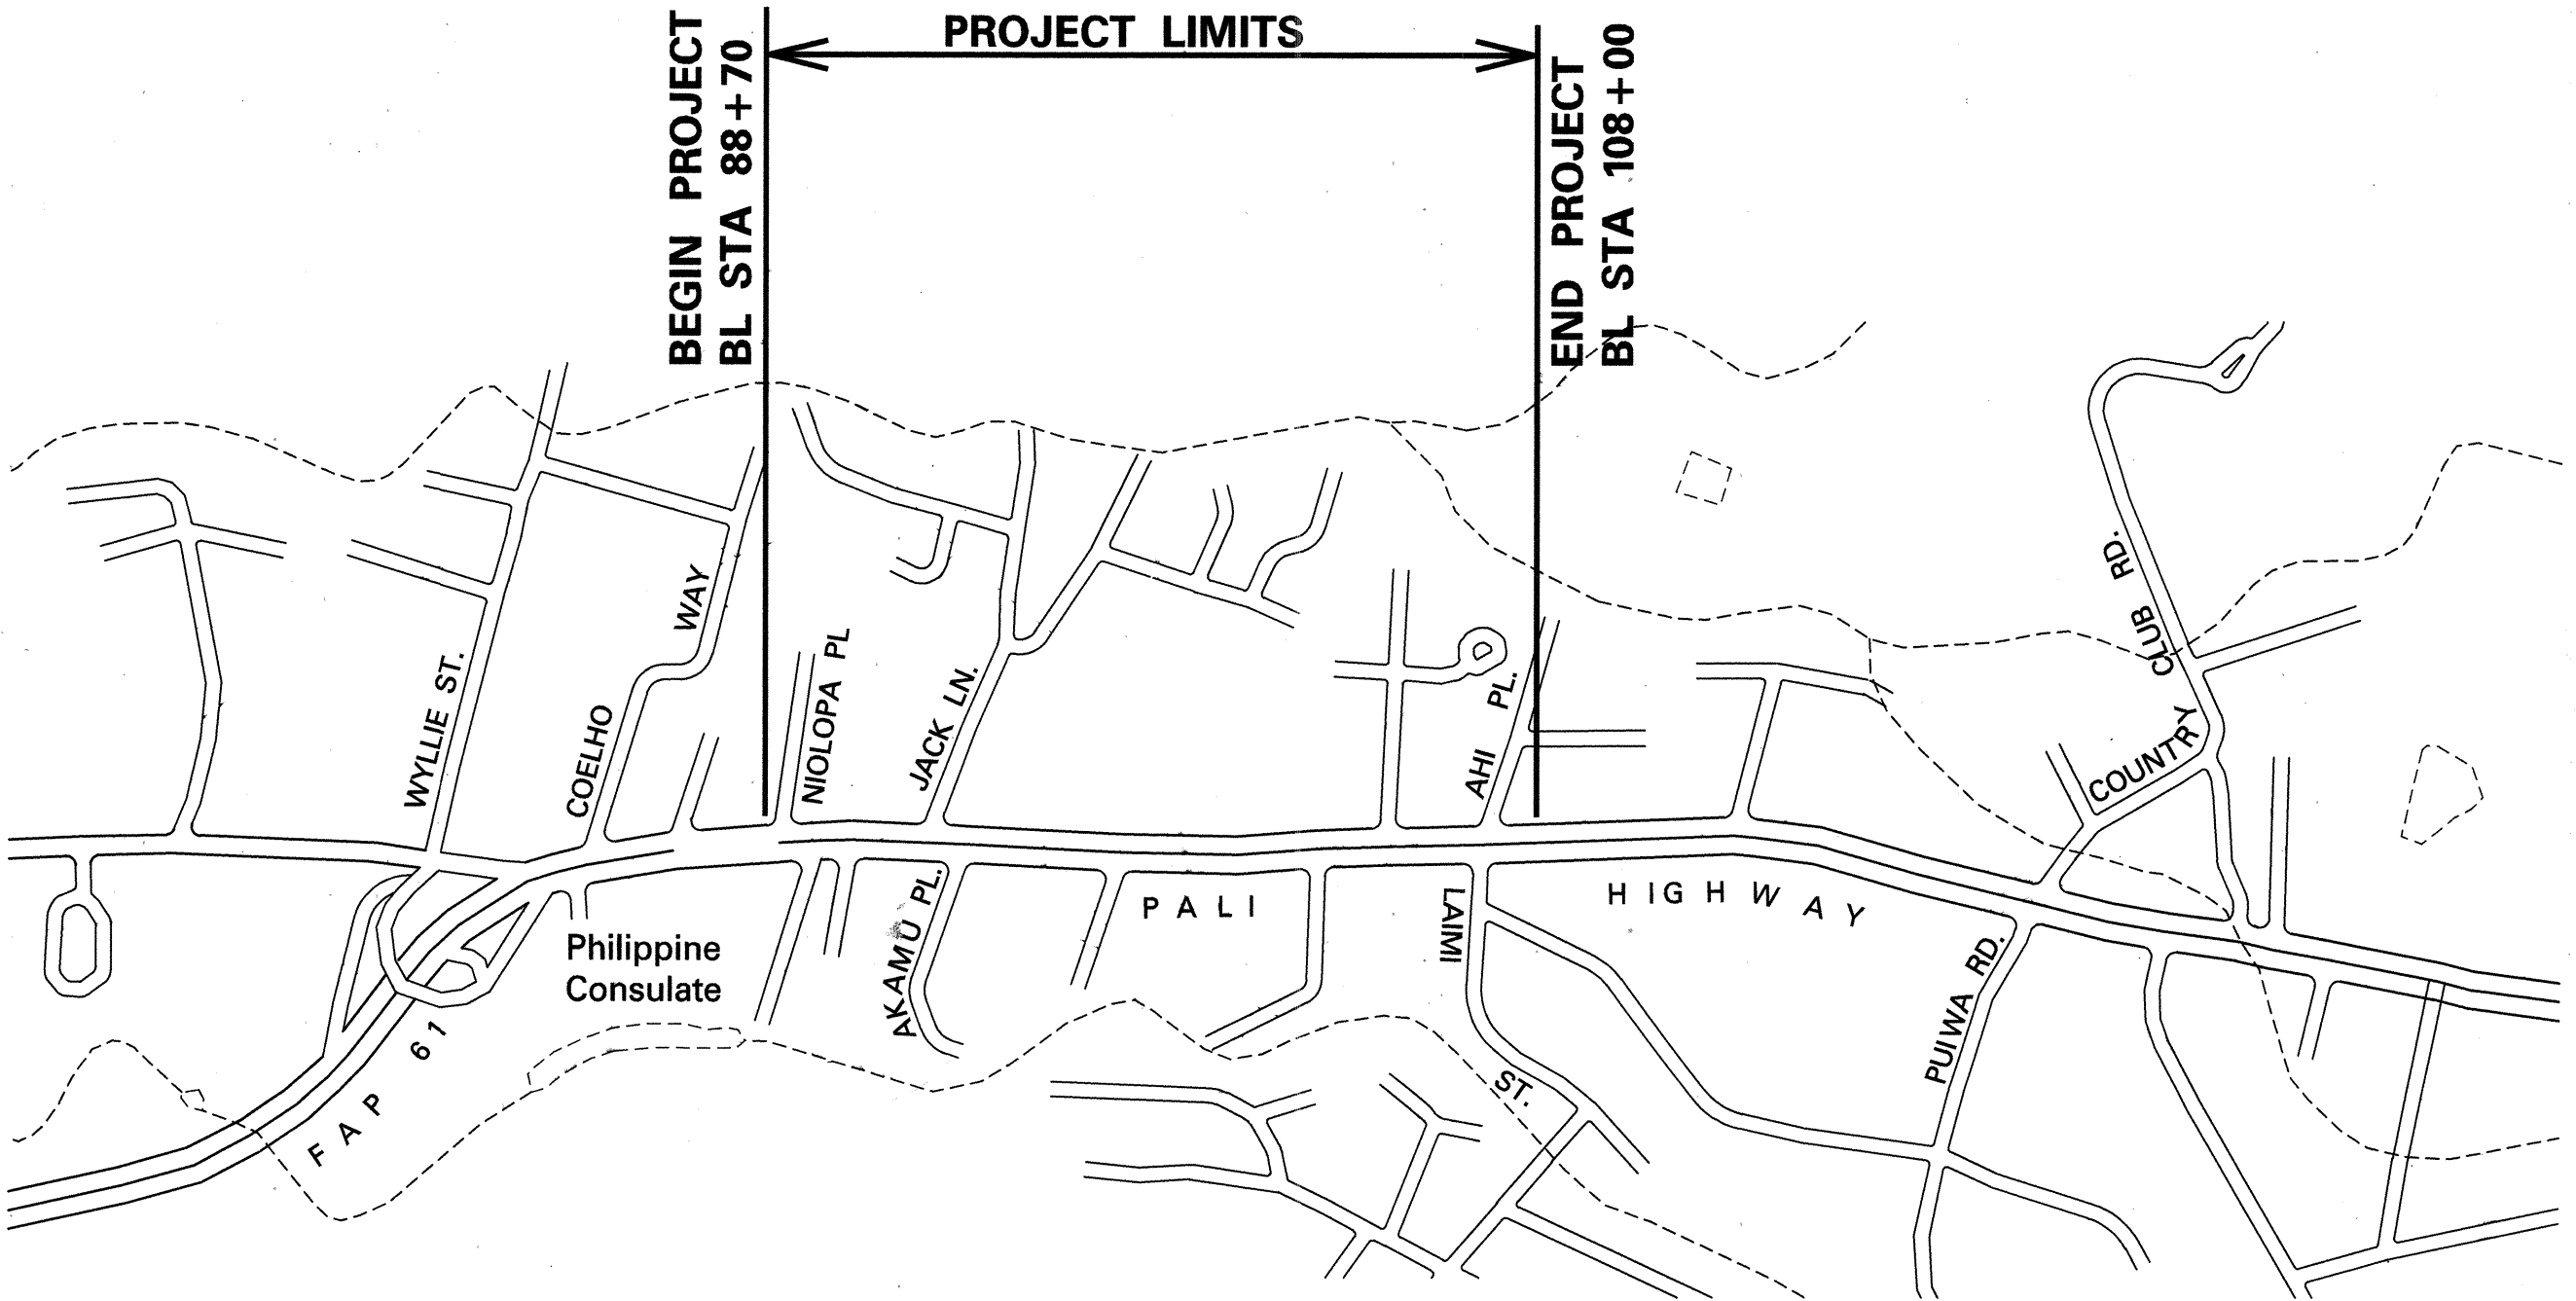
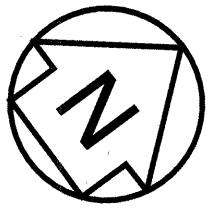
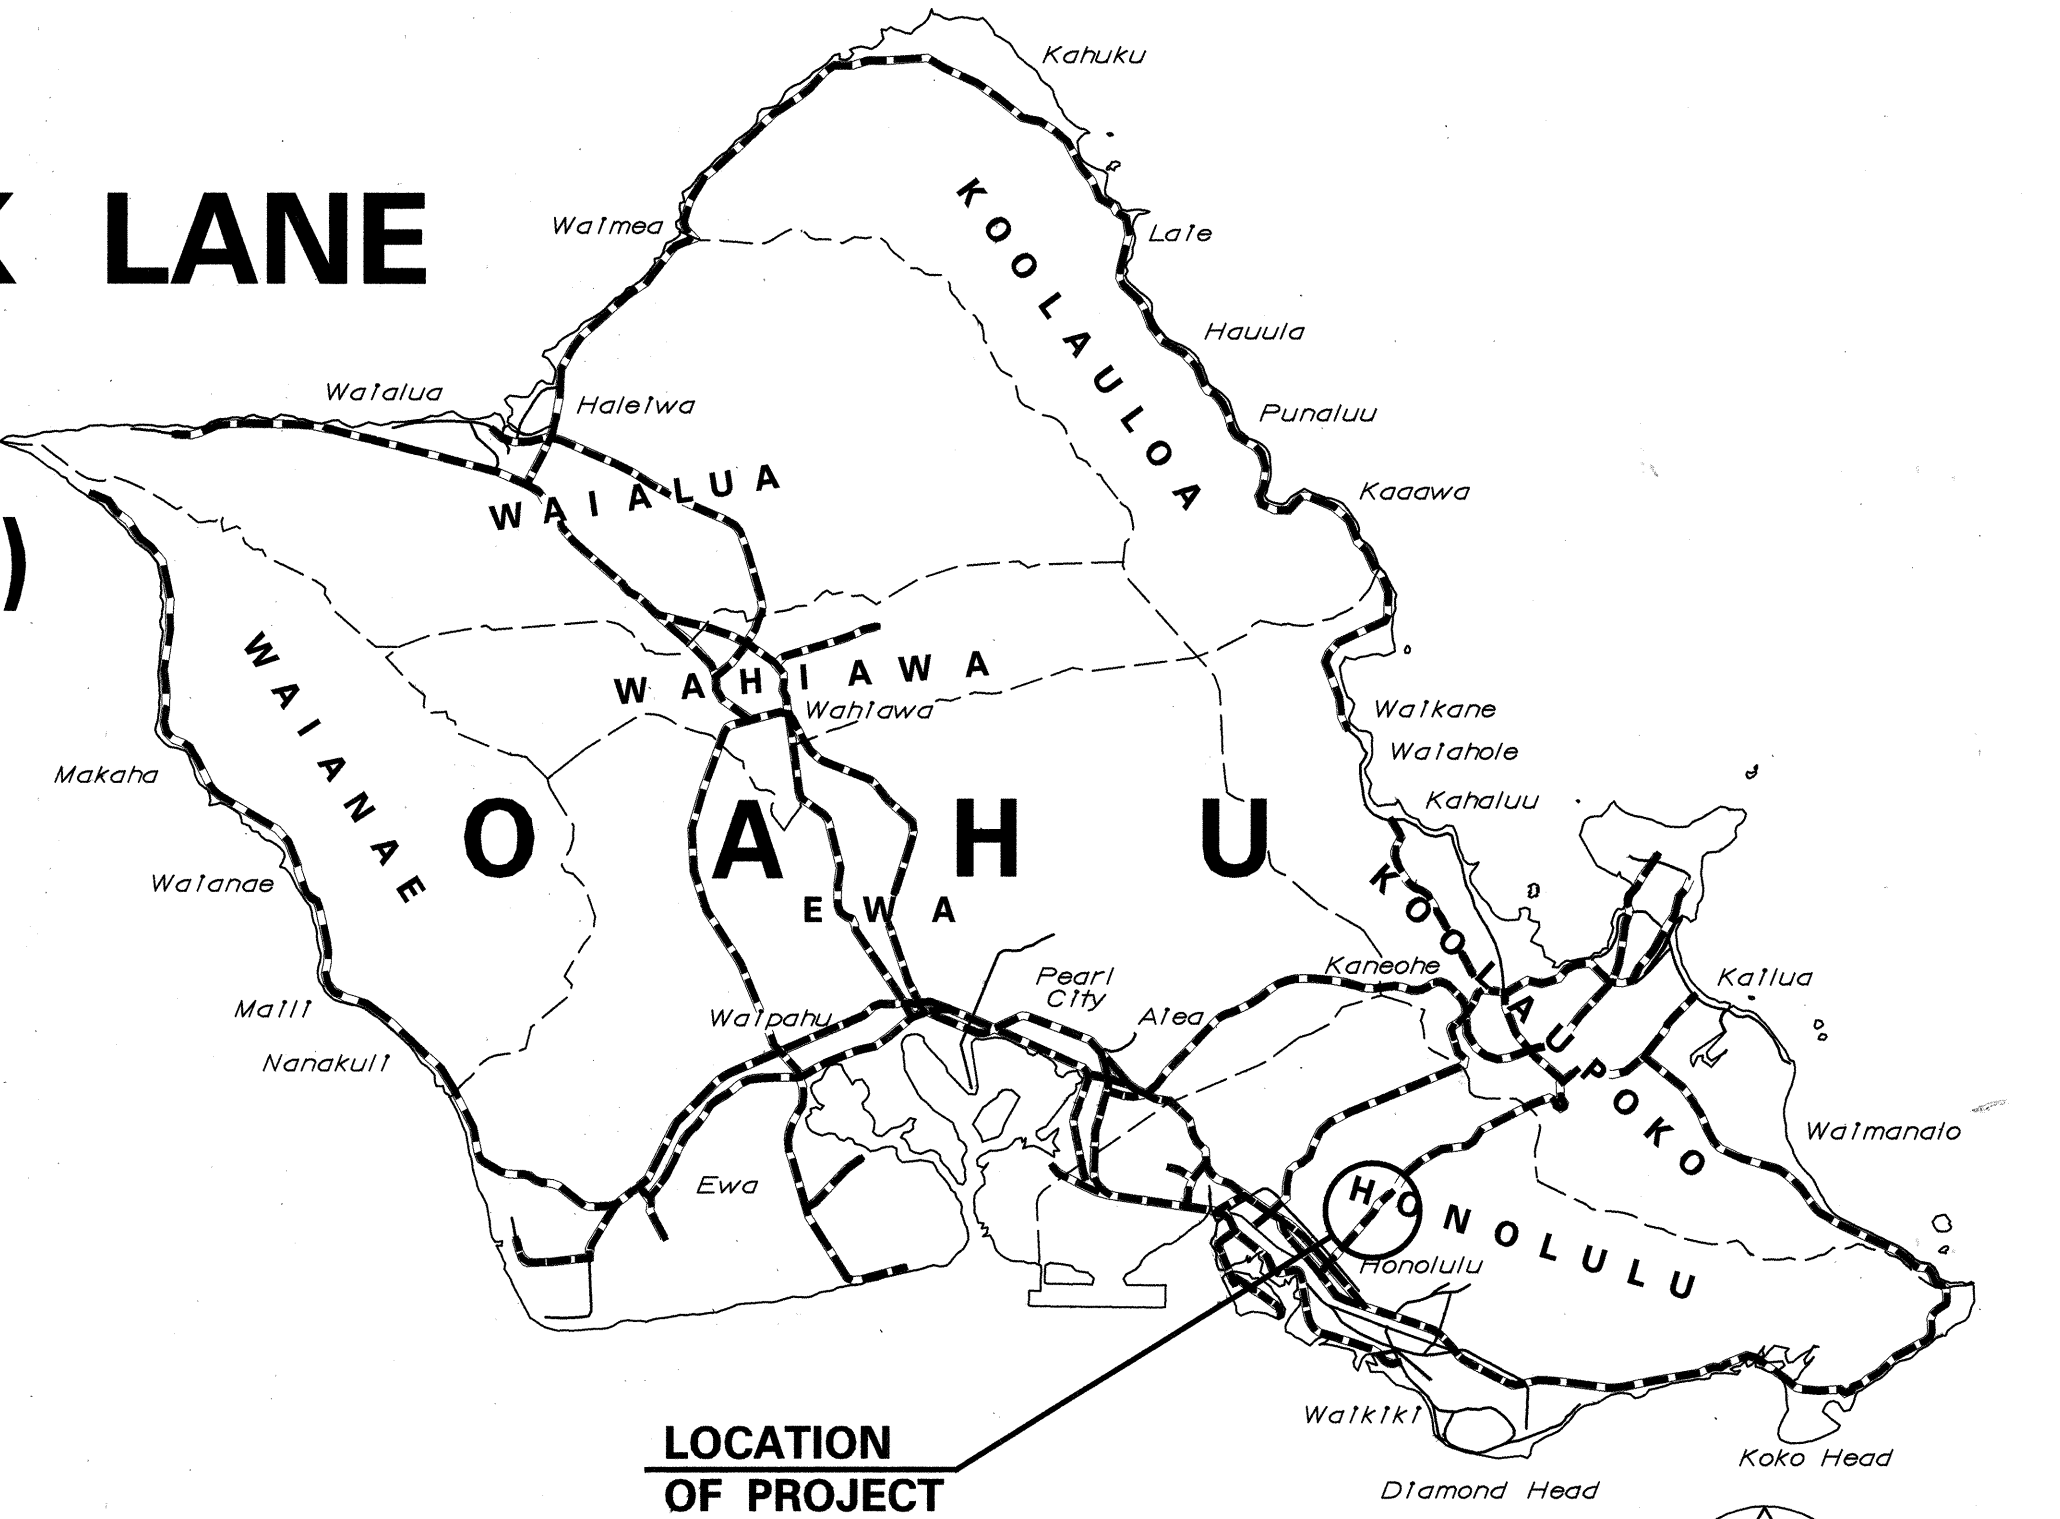


INDEX TO DRAWINGS	
SHEET NO.	DESCRIPTION
1	TITLE SHEET
2	STANDARD PLANS SUMMARY
3 - 4	GENERAL NOTES
5	TYPICAL SECTIONS AND DETAILS
6	PHASING PLAN
7 - 8	ROADWAY PLAN
9 - 10	GRADING AND DRAINAGE PLAN
11 - 12	SIGNING AND STRIPING PLAN
13	TRAFFIC CONTROL NOTES AND DETAILS
14 - 16	TRAFFIC CONTROL PLAN
17	CROSS SECTIONS
18 - 21	CURB RAMP DETAIL
22	SIGN MOUNTING DETAIL
23	TRAFFIC SIGNAL SITE PLAN
24	STREET LIGHT/ TRAFFIC SIGNAL LEGEND AND NOTES
25 - 26	TRAFFIC SIGNAL PLAN
27	CONDUIT, WIRING AND SIGNAL HEAD SCHEDULE, PHASE DIAGRAMS
28	TYPICAL BACKFILL SECTION DETAILS
29 - 31	TRAFFIC SIGNAL DETAILS
32	TRAFFIC SIGNAL STANDARD DETAILS
33	LOOP DETECTOR DETAILS
34	PULLBOX AND COVER DETAILS
35	CCTV SYSTEM INSTALLATION DETAIL
36	CONCRETE BASE DETAIL
37 - 38	EXISTING CONDITIONS PLAN

STATE OF HAWAII
DEPARTMENT OF TRANSPORTATION
HIGHWAYS DIVISION
HONOLULU, HAWAII
"AS-BUILT"
PLANS FOR
PALI HIGHWAY
INTERSECTION IMPROVEMENTS AT JACK LANE
FEDERAL AID PROJECT NO. STP-061-1 (34)
DISTRICT OF HONOLULU
ISLAND OF OAHU

FED. ROAD DIST. NO.	STATE	FED. AID PROJ. NO.	FISCAL YEAR	SHEET NO.	TOTAL SHEETS
HAWAII	HAW.	STP-061-1 (34)	2000	1	38

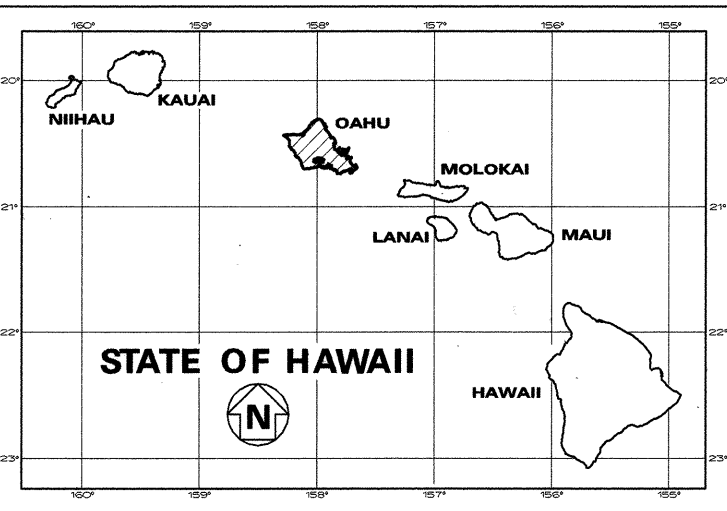

----- FEDERAL AID PROJECTS PREVIOUSLY CONSTRUCTED
OR UNDER CONSTRUCTION

MILE POST 1.45 TO MILE POST 1.83

CHANGES MADE DURING CONSTRUCTION HAVE BEEN
INCORPORATED ON THESE PLANS EXCEPT CHANGES
IN THE ORIGINAL THEORETICAL QUANTITIES. FOR
ACTUAL QUANTITIES, REFER TO PROJECT LEDGER
AND/OR COMPUTATION BOOK.

Sidney S. C. Z... 12/6/01
RESIDENT ENGINEER DATE

DEPARTMENT OF TRANSPORTATION
STATE OF HAWAII
APPROVED:
Glen M. O...
DIR. OF TRANSPORTATION DATE

BELT COLLINS HAWAII DESIGNED BY KARL KUNISHIGE P. S. & E. BY 692-7679 PHONE Feb 23, 2000 DATE