

FED. ROAD DIST. NO.	STATE	PROJ. NO.	FISCAL YEAR	SHEET NO.	TOTAL SHEETS
HAWAII	HAW.	61B-01-98	1999	7	18

ORIGINAL PLAN	DATE
DRAWN BY	
TRACED BY	
DESIGNED BY	
CHECKED BY	
NO.	

NOTES:

All exposed slopes shall be top soiled & grassed. This work shall be considered incidental to various contract items.

THIS WORK WAS PREPARED BY ME OR UNDER MY SUPERVISION.

Stanley T. Katsura

STATE OF HAWAII
DEPARTMENT OF TRANSPORTATION
HIGHWAYS DIVISION


DRAINAGE & GRADING

PALI HIGHWAY
EXTEND LEFT-TURN STORAGE LANE
AT WAKANAKA STREET
PROJECT NO. 61B-01-98

SCALE: 1" = 20' DATE: JANUARY 1999

SHEET NO. D1 OF 2 SHEETS

7

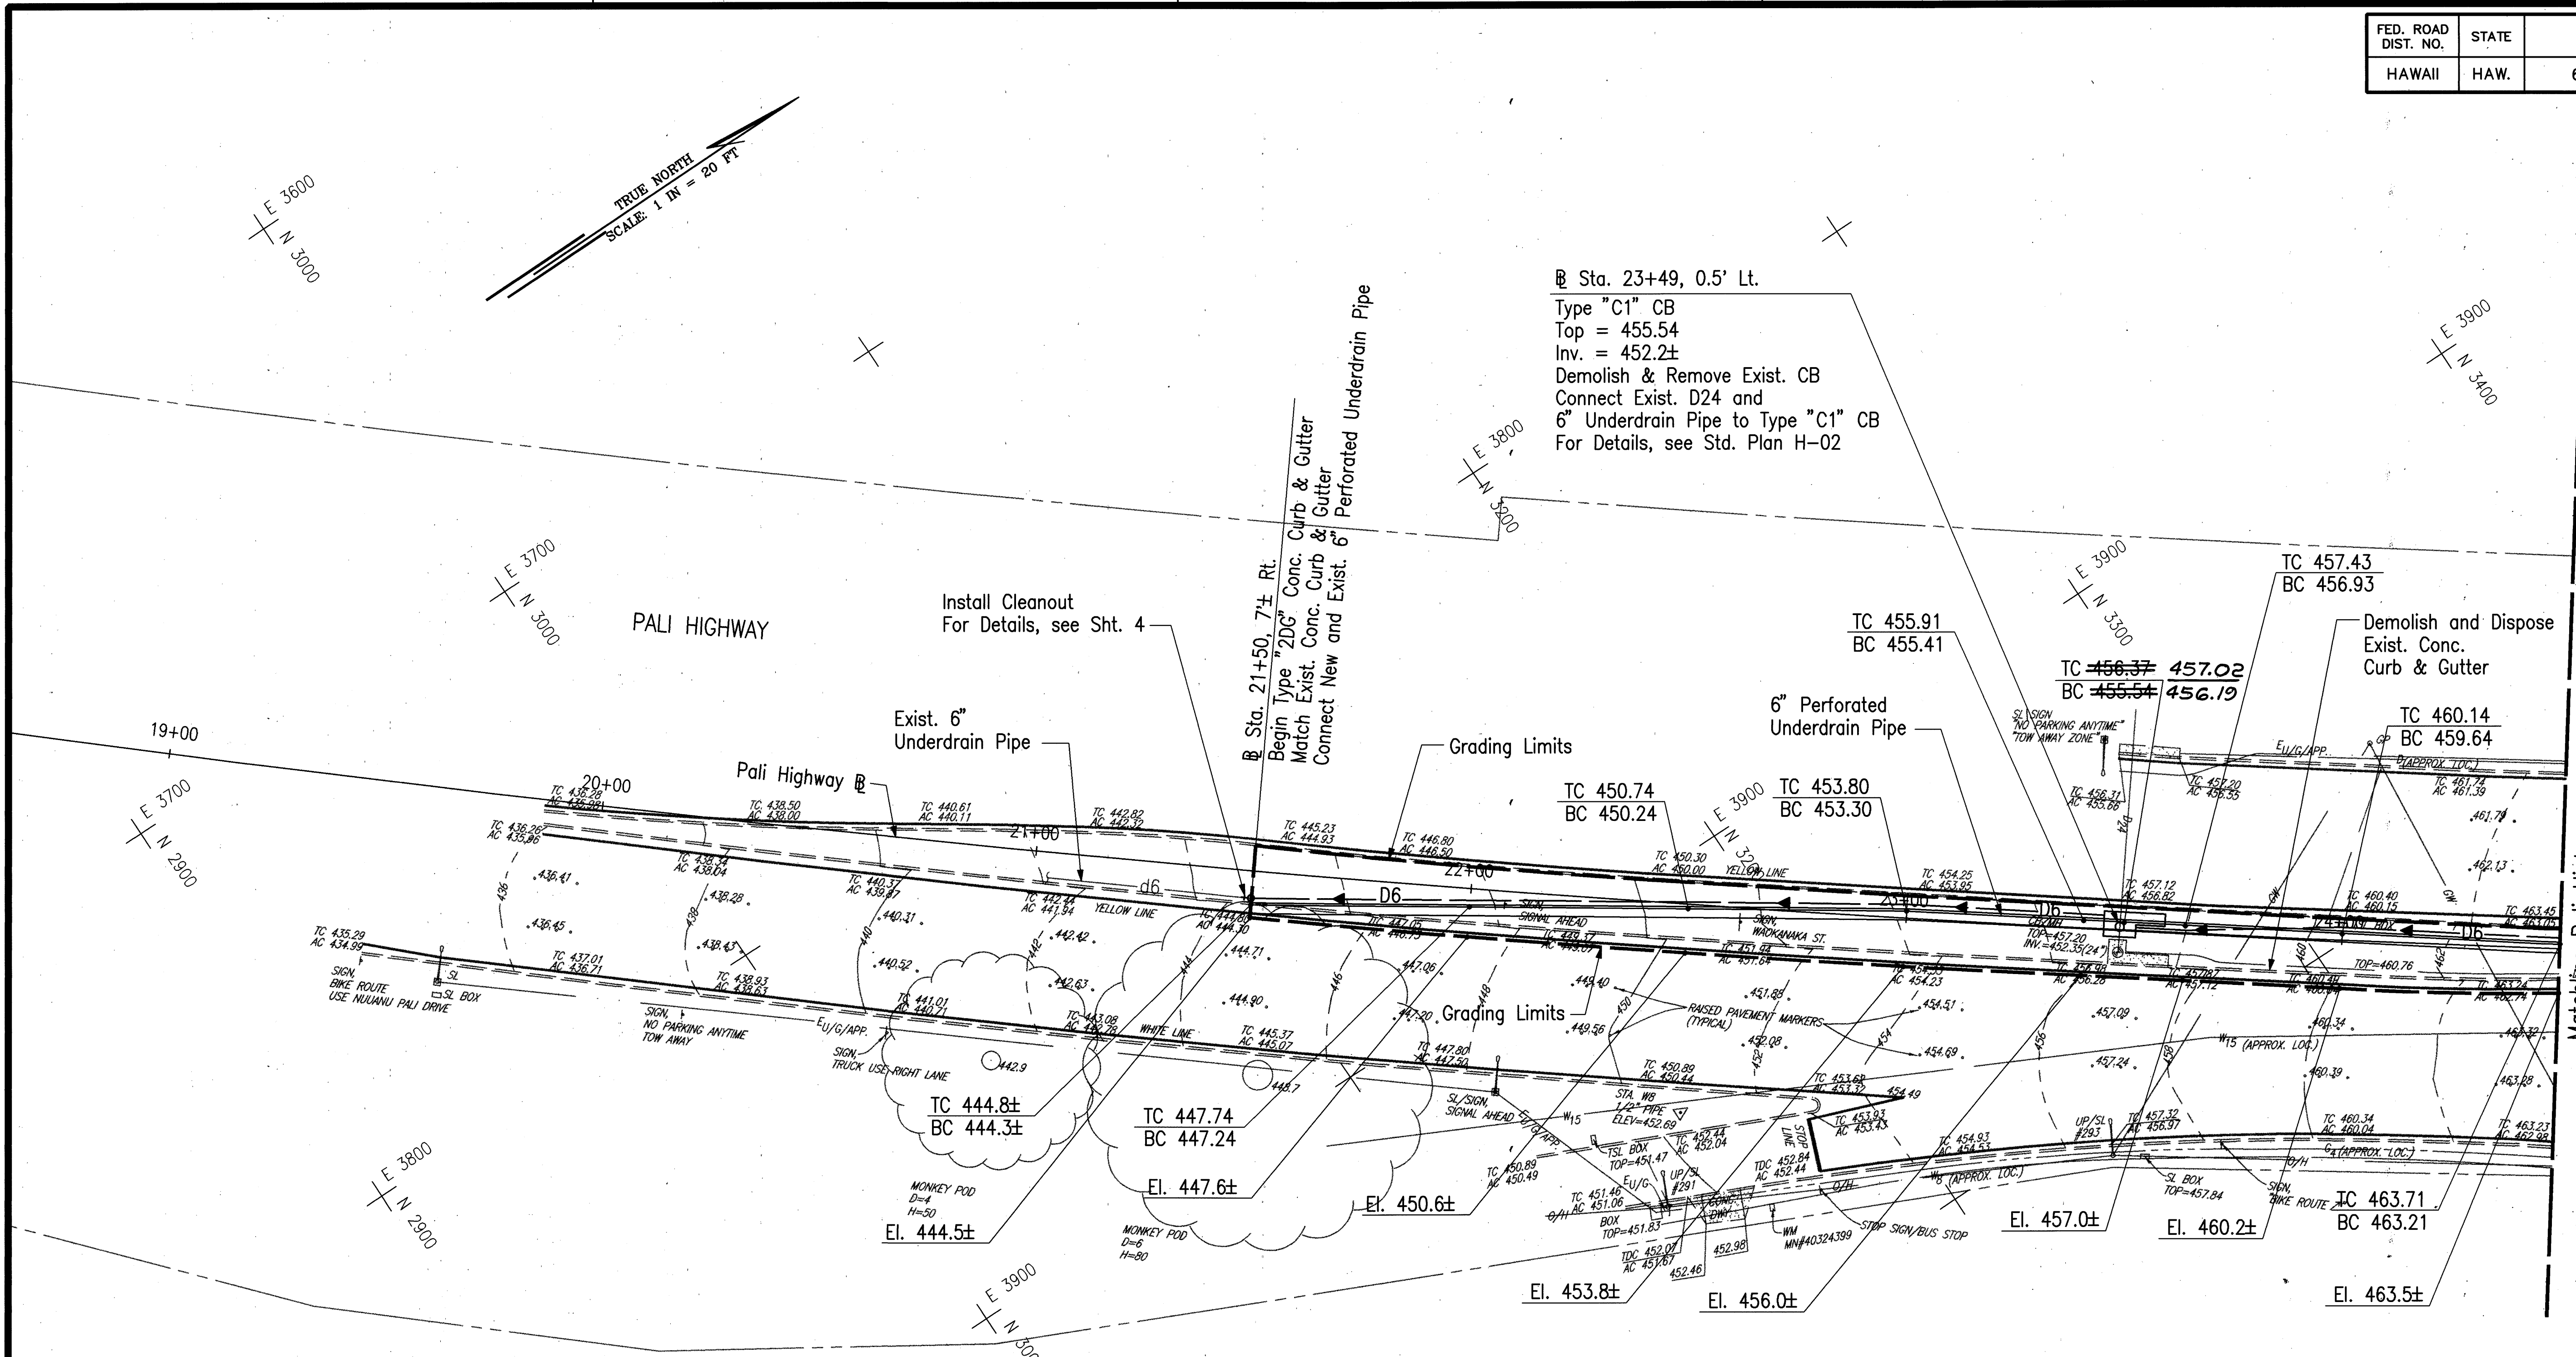

@ Sta. 23+49, 0.5' Lt.
Type "C1" CB
Top = 455.54
Inv. = 452.2±
Demolish & Remove Exist. CB
Connect Exist. D24 and
6" Underdrain Pipe to Type "C1" CB
For Details, see Std. Plan H-02

@ Sta. 21+50, 7± Rt.
Begin Type "2D6" Conc. Curb & Gutter
Match Exist. Conc. Curb & Gutter
Connect New and Exist. 6" Perforated Underdrain Pipe

Install Cleanout
For Details, see Sht. 4

Exist. 6" Underdrain Pipe


Grading Limits

6" Perforated Underdrain Pipe

Demolish and Dispose
Exist. Conc. Curb & Gutter


Matchline Pali Highway
Sta. 24+50
See Sheet No. D2

FED. ROAD DIST. NO.	STATE	PROJ. NO.	FISCAL YEAR	SHEET NO.	TOTAL SHEETS
HAWAII	HAW.	61B-01-98	1999	8	18

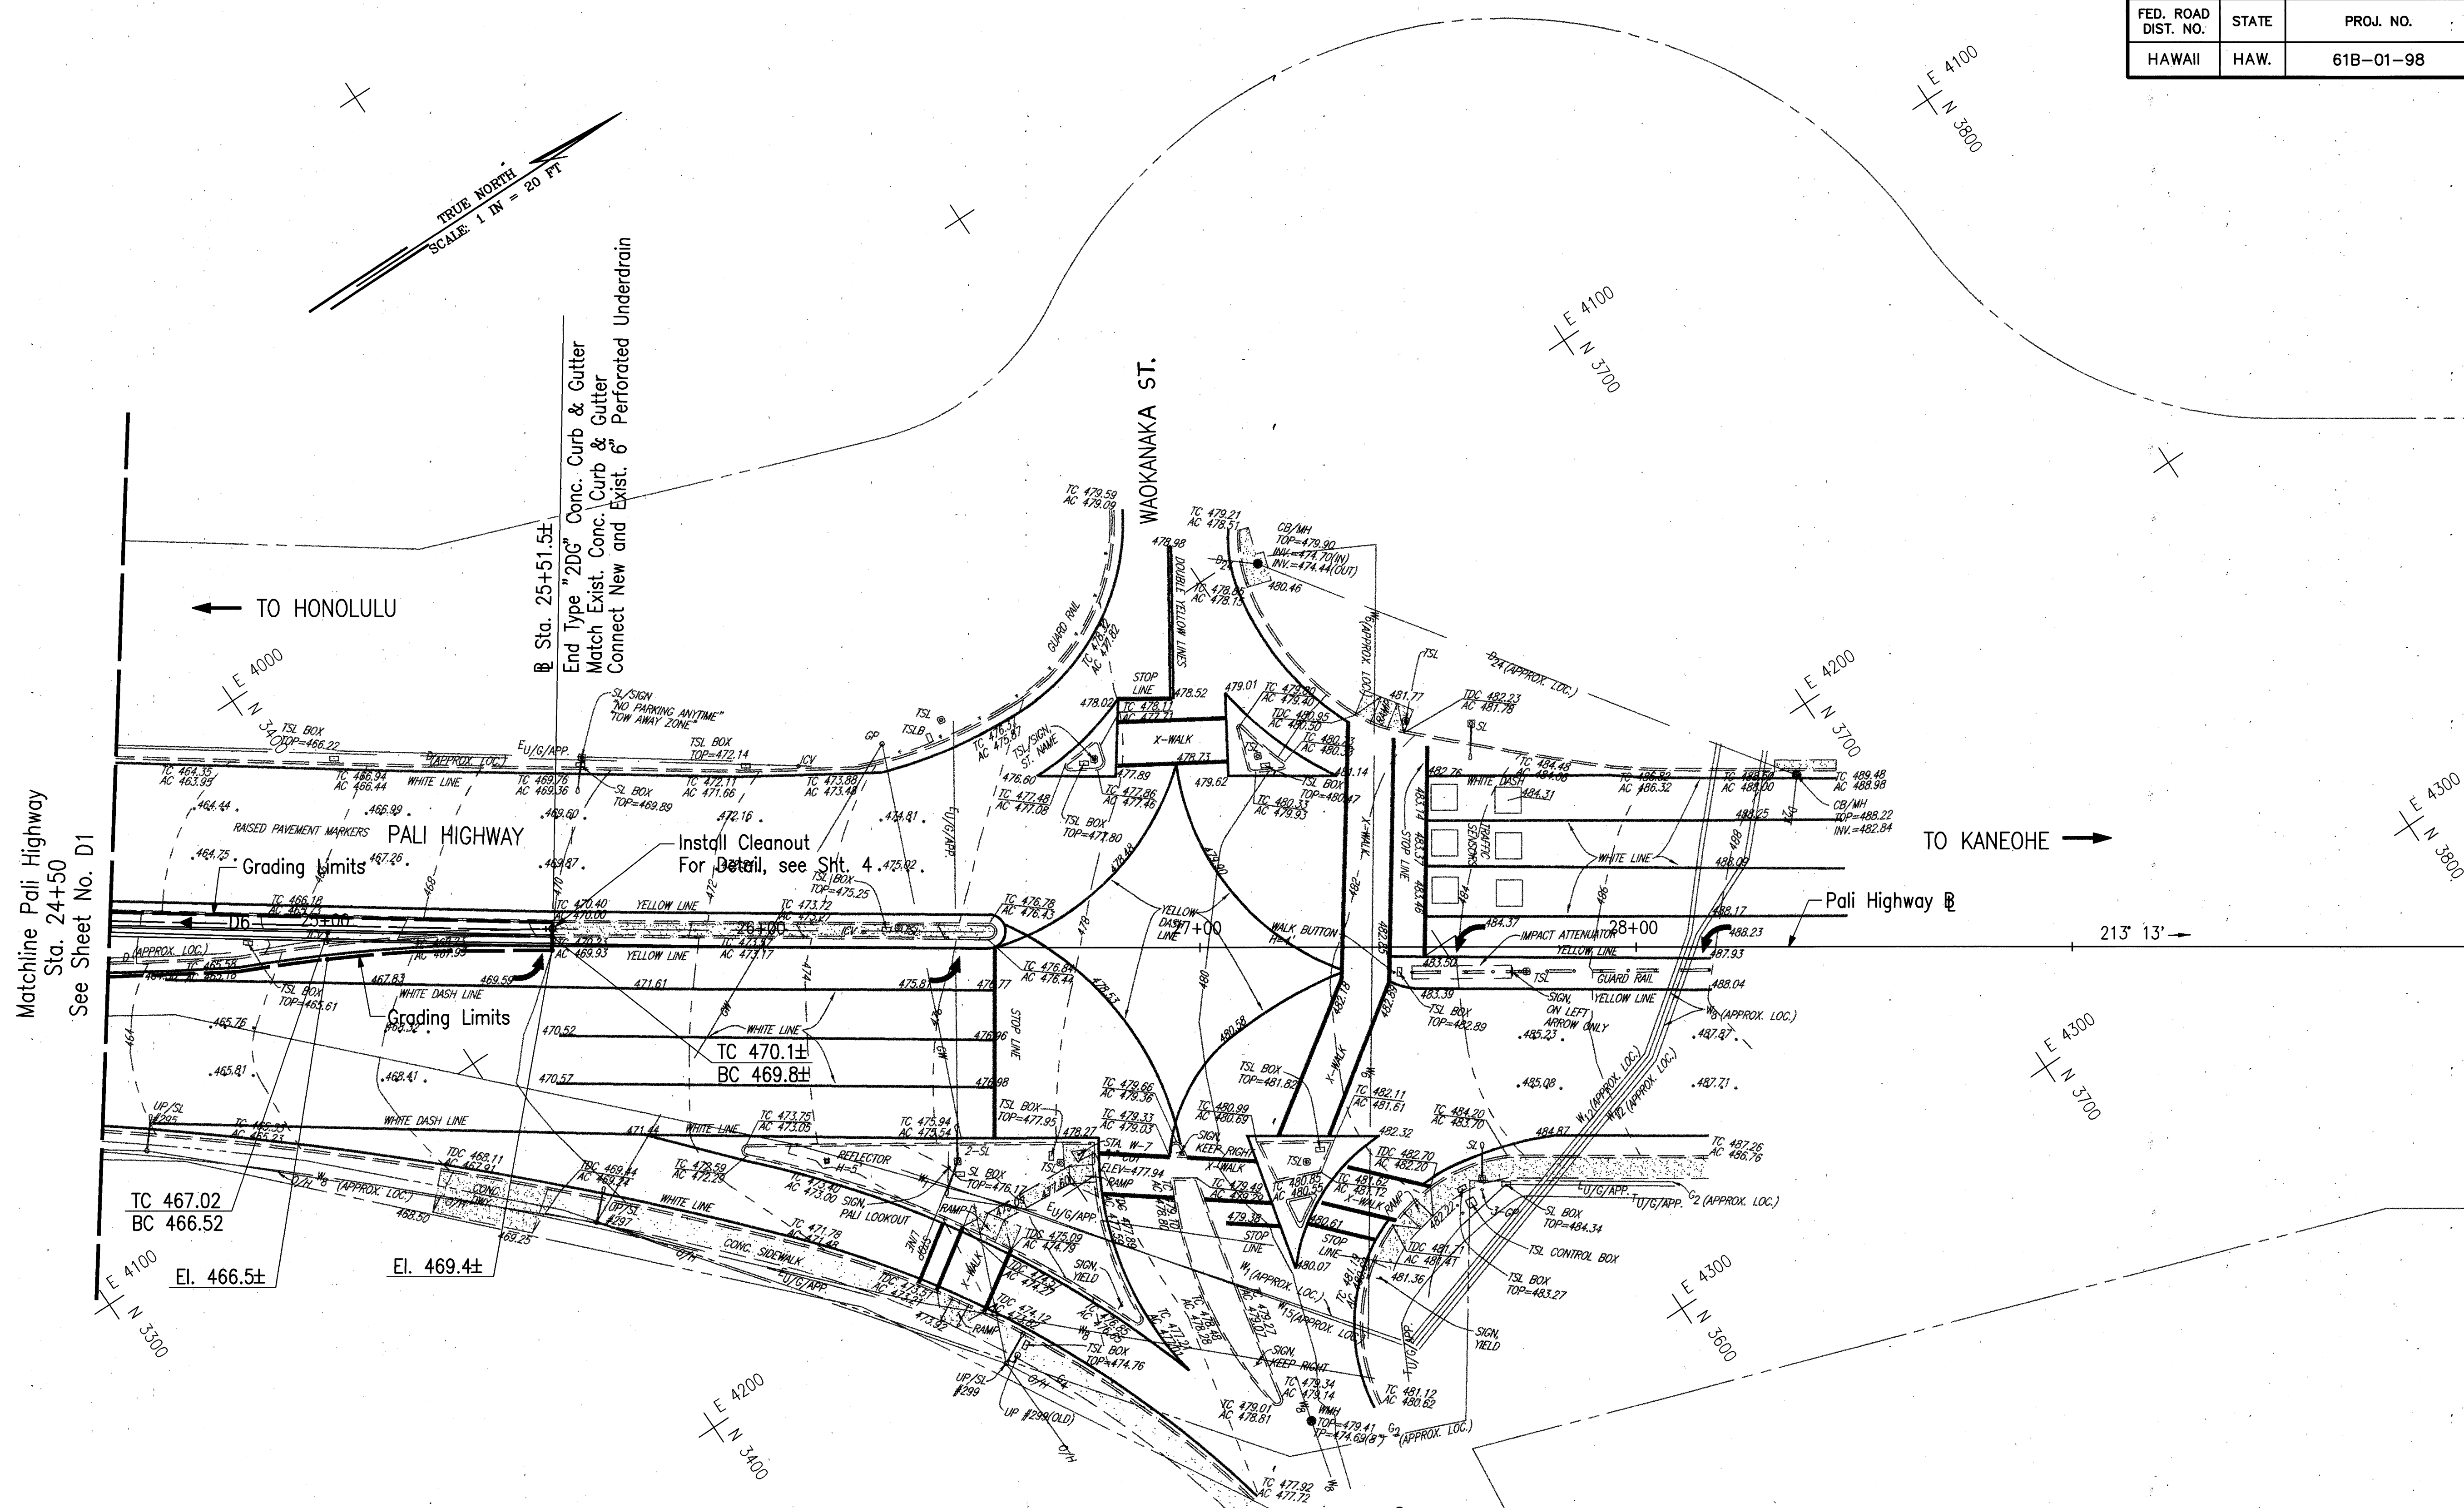

ORIGINAL PLAN	SURVEY PLOTTED BY	DATE
NOTE BOOK	DRAWN BY	*****
QUANTITIES BY	DESIGNED BY	
CHECKED BY		

CAD by J. Minura 55-52

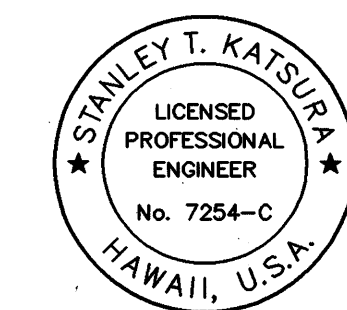

THIS WORK WAS PREPARED BY ME OR UNDER MY SUPERVISION.

Stanley T. Katsura

STATE OF HAWAII
DEPARTMENT OF TRANSPORTATION
HIGHWAYS DIVISION

DRAINAGE & GRADING

**PALI HIGHWAY
EXTEND LEFT-TURN STORAGE LANE
AT WAAKANAKA STREET
PROJECT NO. 61B-01-98**

SCALE: 1" = 20' DATE: JANUARY 1999
SHEET NO. D2 OF 2 SHEETS