


FED. ROAD DIST. NO.	STATE	PROJ. NO.	FISCAL YEAR	SHEET NO.	TOTAL SHEETS
HAWAII	HAW.	61B-01-98	1999	5	18

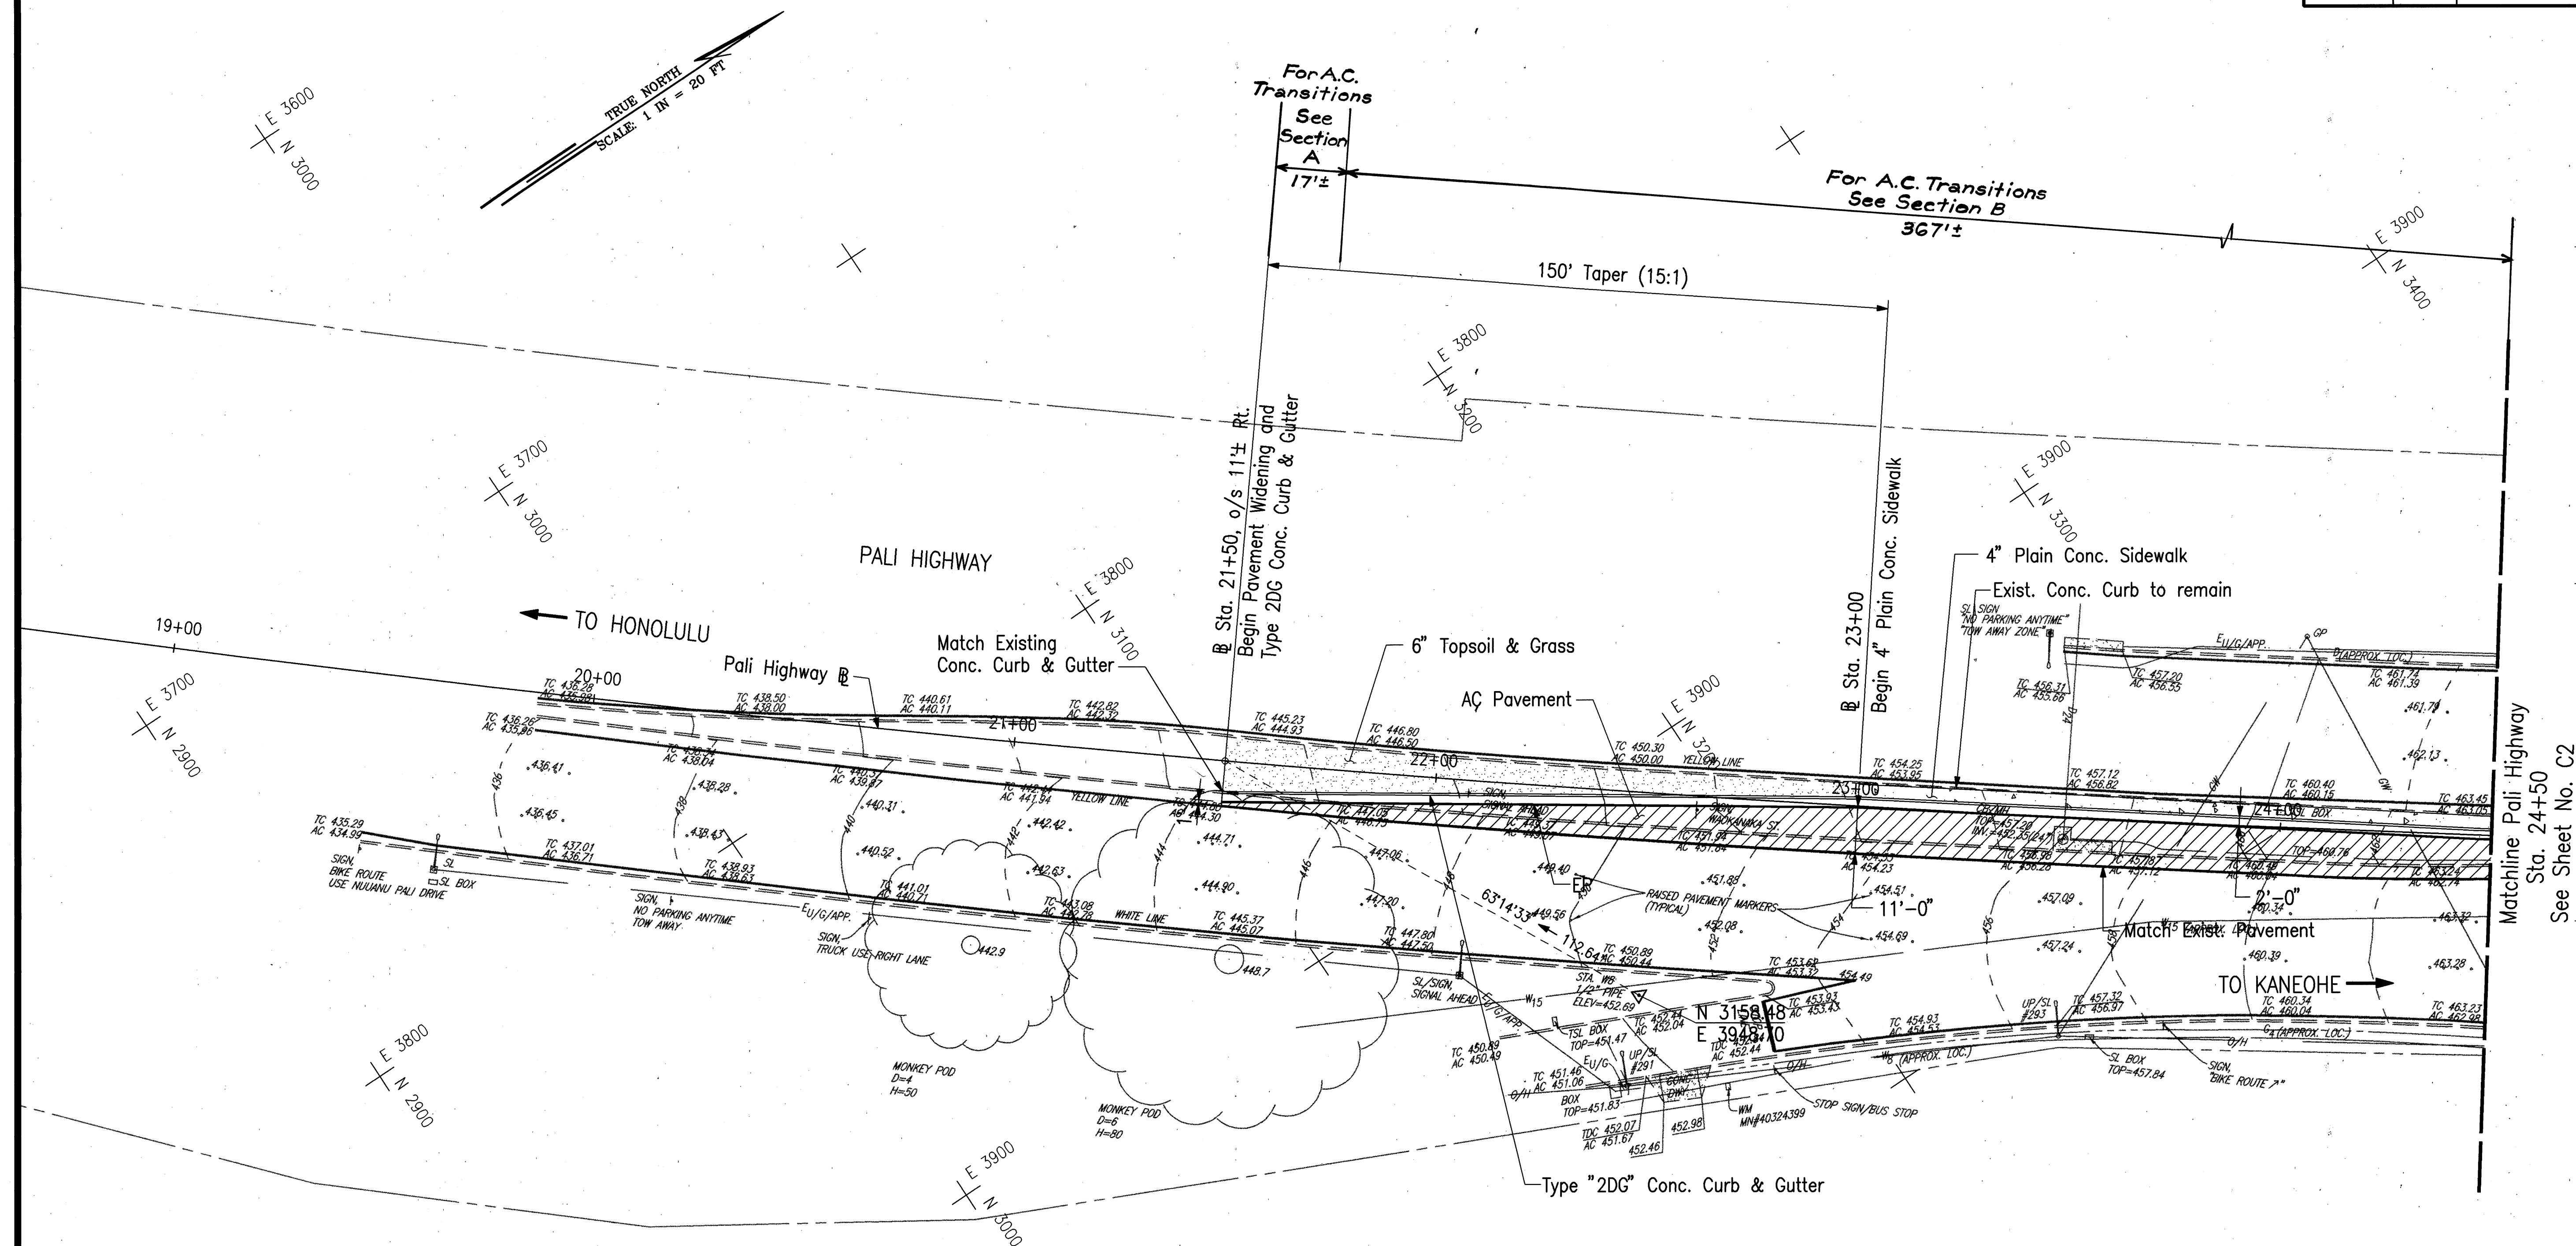

NOTES:

All exposed slopes shall be top soiled & grassed. This work shall be considered incidental to various contract items.

LEGEND:



THIS WORK WAS PREPARED BY ME
OR UNDER MY SUPERVISION.

STATE OF HAWAII
DEPARTMENT OF TRANSPORTATION
HIGHWAYS DIVISION

ROADWAY CONSTRUCTION

PALI HIGHWAY
EXTEND LEFT-TURN STORAGE LANE
AT WAKKANAKA STREET
PROJECT NO. 61B-01-98

SCALE: 1" = 20' DATE: JANUARY 1999


SHEET NO. C1 OF 2 SHEETS

FED. ROAD DIST. NO.	STATE	PROJ. NO.	FISCAL YEAR	SHEET NO.	TOTAL SHEETS
HAWAII	HAW.	61B-01-98	1999	6	18


SURVEY PLOTTED BY	DATE
DRAWN BY	
DESIGNED BY	
NOTED BY	
CHECKED BY	
No.	

CAD by J. Minura, 55-52

Last Saved: J:\KAL-PAU\ROAD\Rc-pd12.dwg 11/10/98 at 09:30

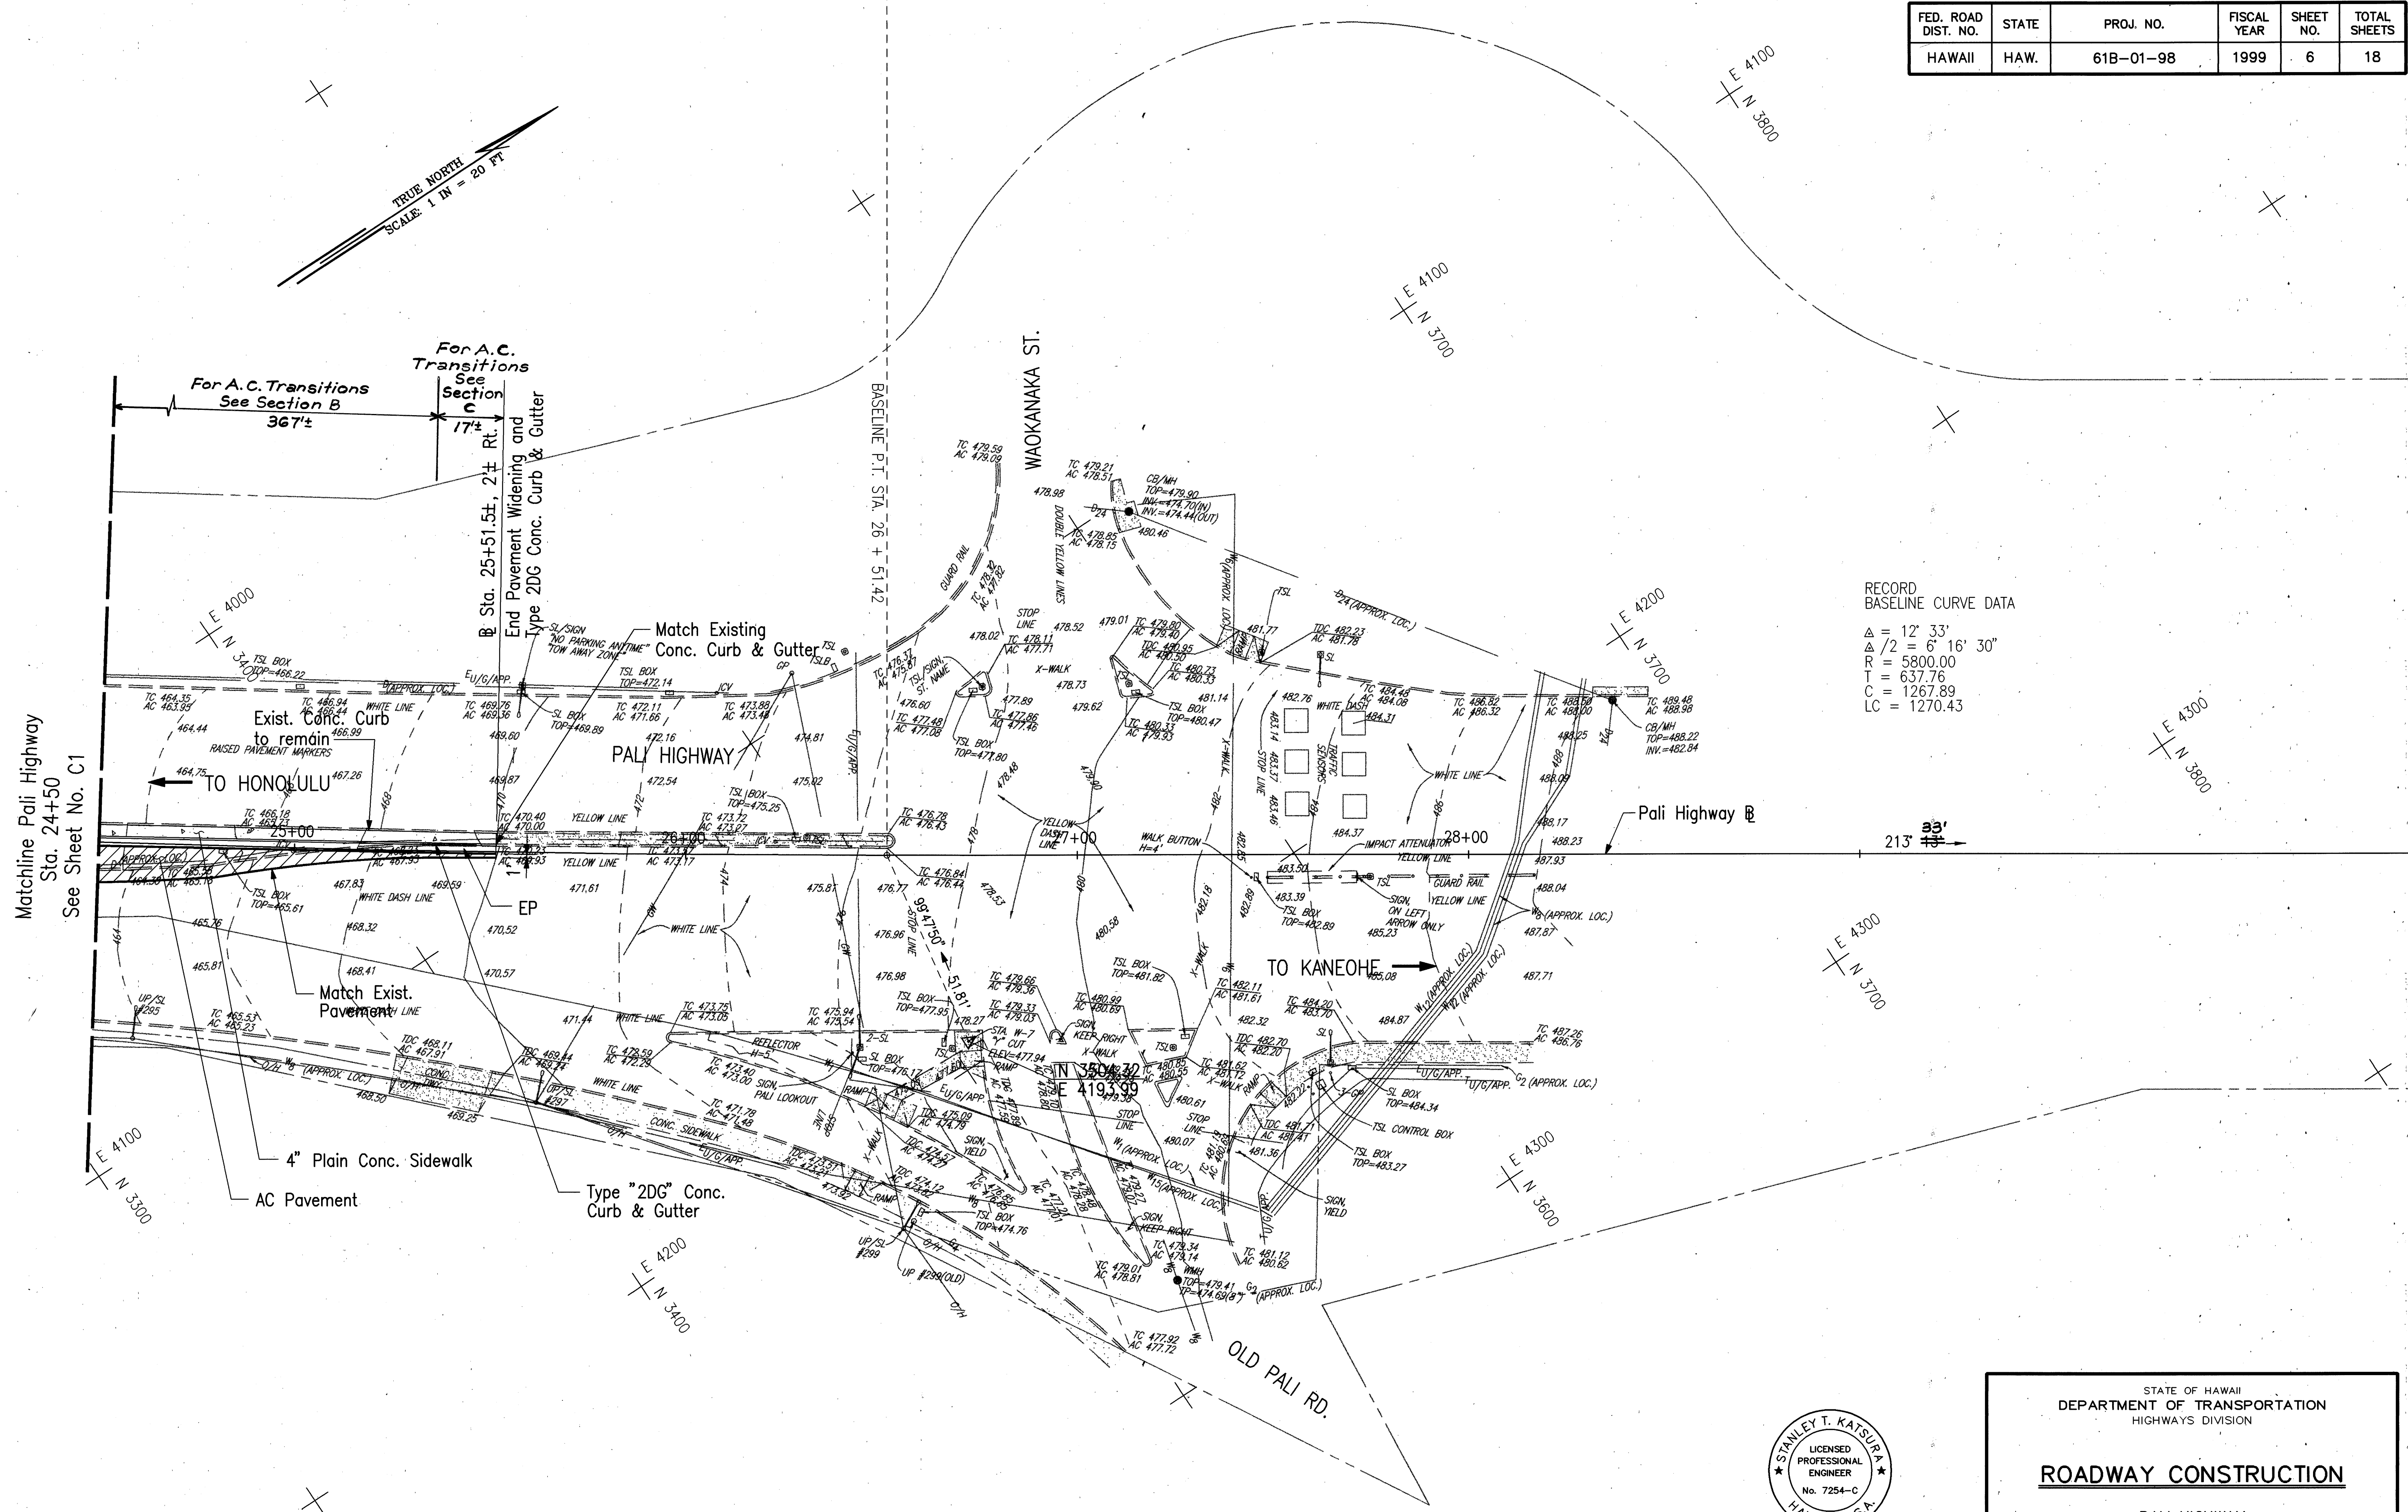

RECORD
BASELINE CURVE DATA
Δ = 12° 33'
Δ/2 = 6° 16' 30"
R = 5800.00
T = 637.76
C = 1267.89
LC = 1270.43

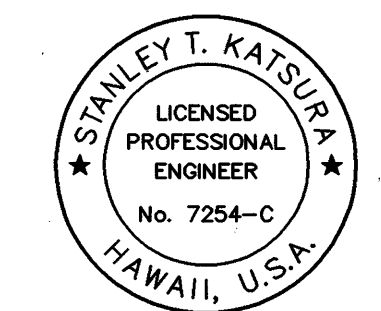

THIS WORK WAS PREPARED BY ME
OR UNDER MY SUPERVISION.

Stanley T. Katsura

STATE OF HAWAII
DEPARTMENT OF TRANSPORTATION
HIGHWAYS DIVISION

ROADWAY CONSTRUCTION

PALI HIGHWAY
EXTEND LEFT-TURN STORAGE LANE
AT WAIKANAKA STREET
PROJECT NO. 61B-01-98

SCALE: 1" = 20' DATE: JANUARY 1999
SHEET NO. C2 OF 2 SHEETS