	INDEX TO DRAWINGS					
SHEET NO.	DESCRIPTION					
1	TITLE SHEET					
2	STANDARD PLAN SUMMARY					
3	GENERAL NOTES AND LEGEND					
1 4	TYPICAL SECTIONS & DETAILS					
5-6	ROADWAY CONSTRUCTION					
7–8	DRAINAGE & GRADING					
9	PAVEMENT MARKINGS, LEGEND,					
	DETAIL & NOTES					
10-11	SIGNING & STRIPING					
12	LOOP DETECTOR DETAILS					
13	PULLBOX & COVER DETAILS					
14–15	TRAFFIC CONTROL					
16	CROSS SECTIONS					
17–18	EXISTING CONDITIONS					
	·					

SHEET NO. 1 45-1 IS A SUPPLEMENTARY SHEET TO THIS PROJECT. TOTAL SHEET COUNT AFTER "ASBUILT" POSTING 19 SHEETS.

STATE OF HAWAII

## DEPARTMENT OF TRANSPORTATION

HIGHWAYS DIVISION

HONOLULU, HAWAII


"AS-BUILT"

PLANS FOR

## PALI HIGHWAY EXTEND LEFT-TURN STORAGE LANE AT WAOKANAKA STREET

PROJECT NO. 61B-01-98


DISTRICT OF HONOLULU ISLAND OF OAHU

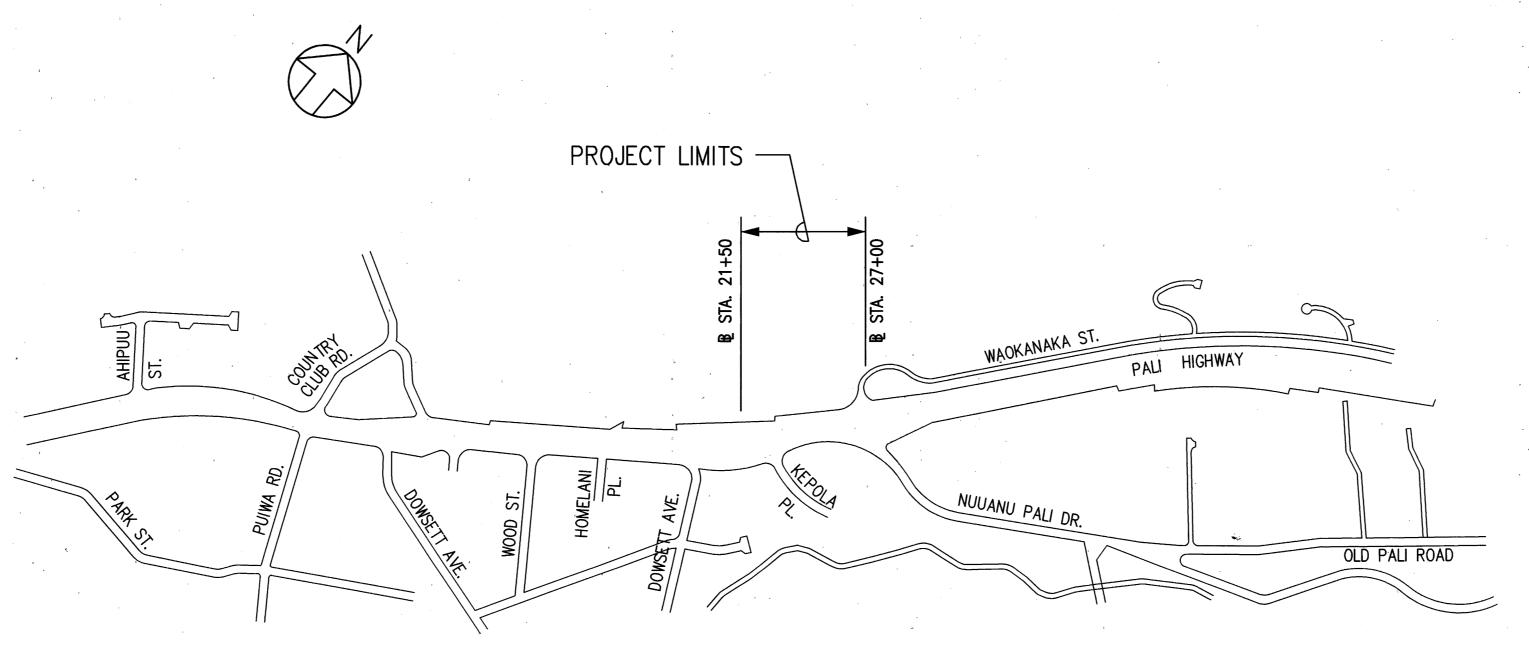

LOCATION PLAN

LENGTH OF PROJECT . . 0.10 MILE

TOTAL SHEETS 61B-01-98

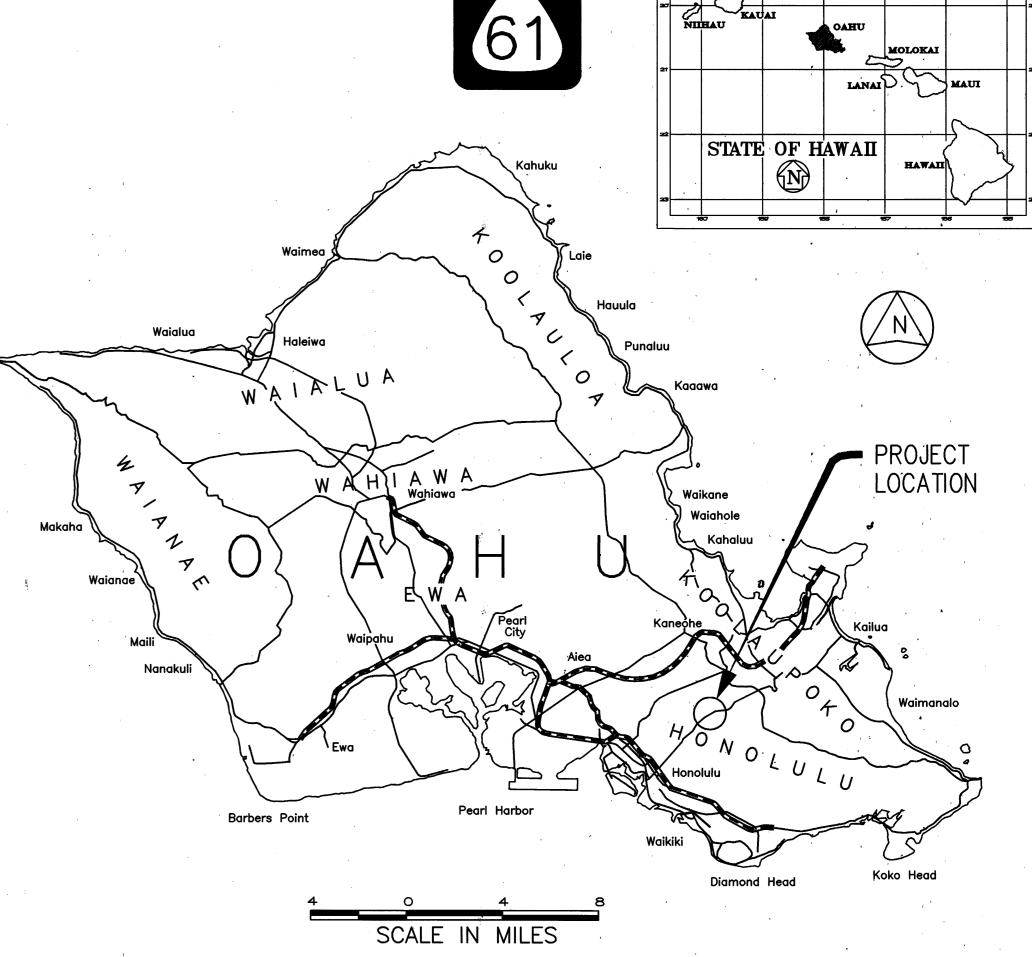

MILEPOST 2.54 TO MILEPOST 2.64

## DESIGN DESIGNATION

CURRI	ENT	ADT	(199	9)	<u>}</u>	. 50,500
DESIG	N A[	)T(2	.019)		. ,•	. 63,200
DHV	•	•	•	•	• ,	. 5,400
D <sub>e</sub>	•	•	•	•	•	. 80/200
T <sub>24</sub>	•	•	•	•		. 2.5%
V	•	•	•	• ,	÷	. 35 MPH

CHANGES MADE DURING CONSTRUCTION HAVE BEEN INCORPORATED ON THESE PLANS EXCEPT CHANGES IN THE ORIGINAL THEORETICAL QUANTITIES. FOR ACTUAL QUANTITIES, REFER TO PROJECT LEDGER AND/OR COMPUTATION BOOK.

RESIDENT ENGINEER

DATE

DEPARTMENT OF TRANSPORTATION STATE OF HAWAII

DIR. OF TRANSPORTATION

Last Saved: J:\KAL-PALI\MISC\Kp-tsh.dwg.dwg 02/22/99 at 13:09