

INDEX TO DRAWINGS	
SHEET NO.	DESCRIPTION
1	TITLE SHEET
2	STANDARD PLANS
3	GENERAL NOTES & LEGEND
① 4-23	TYPICAL SECTIONS & DETAILS
24-27	PLANS
28-34	BWS NOTES & PLANS
35-39	STRUCTURAL NOTES, PLANS, & DETAILS
40-52	DRAINAGE SUMMARY, PLANS, PROFILE & DETAILS
53-58	PAVEMENT MARKING, SIGNING & SUMMARY

SHEET NOS. ① ADD. 75-1 AND ADD. 235-1 THROUGH ADD. 235-3 ARE SUPPLEMENTARY SHEETS TO THIS PROJECT. TOTAL SHEET COUNT AFTER "AS-BUILT" POSTING 62 SHTS.

STATE OF HAWAII

DEPARTMENT OF TRANSPORTATION

HIGHWAYS DIVISION

HONOLULU, HAWAII

"AS-BUILT"

PLANS FOR

KAILUA ROAD

SHOULDER IMPROVEMENTS FOR BICYCLE ROUTE




KALANIANA'OLE HIGHWAY TO KAWAINUI BRIDGE

FEDERAL AID PROJ. NO. STP-061-1(33)

DISTRICT OF KOOLAUPOKO

ISLAND OF OAHU

FED. ROAD DIST. NO.	STATE	FED. AID PROJ. NO.	FISCAL YEAR	SHEET NO.	TOTAL SHEETS
HAWAII	HAW.	STP-061-1(33)	1999	1	58

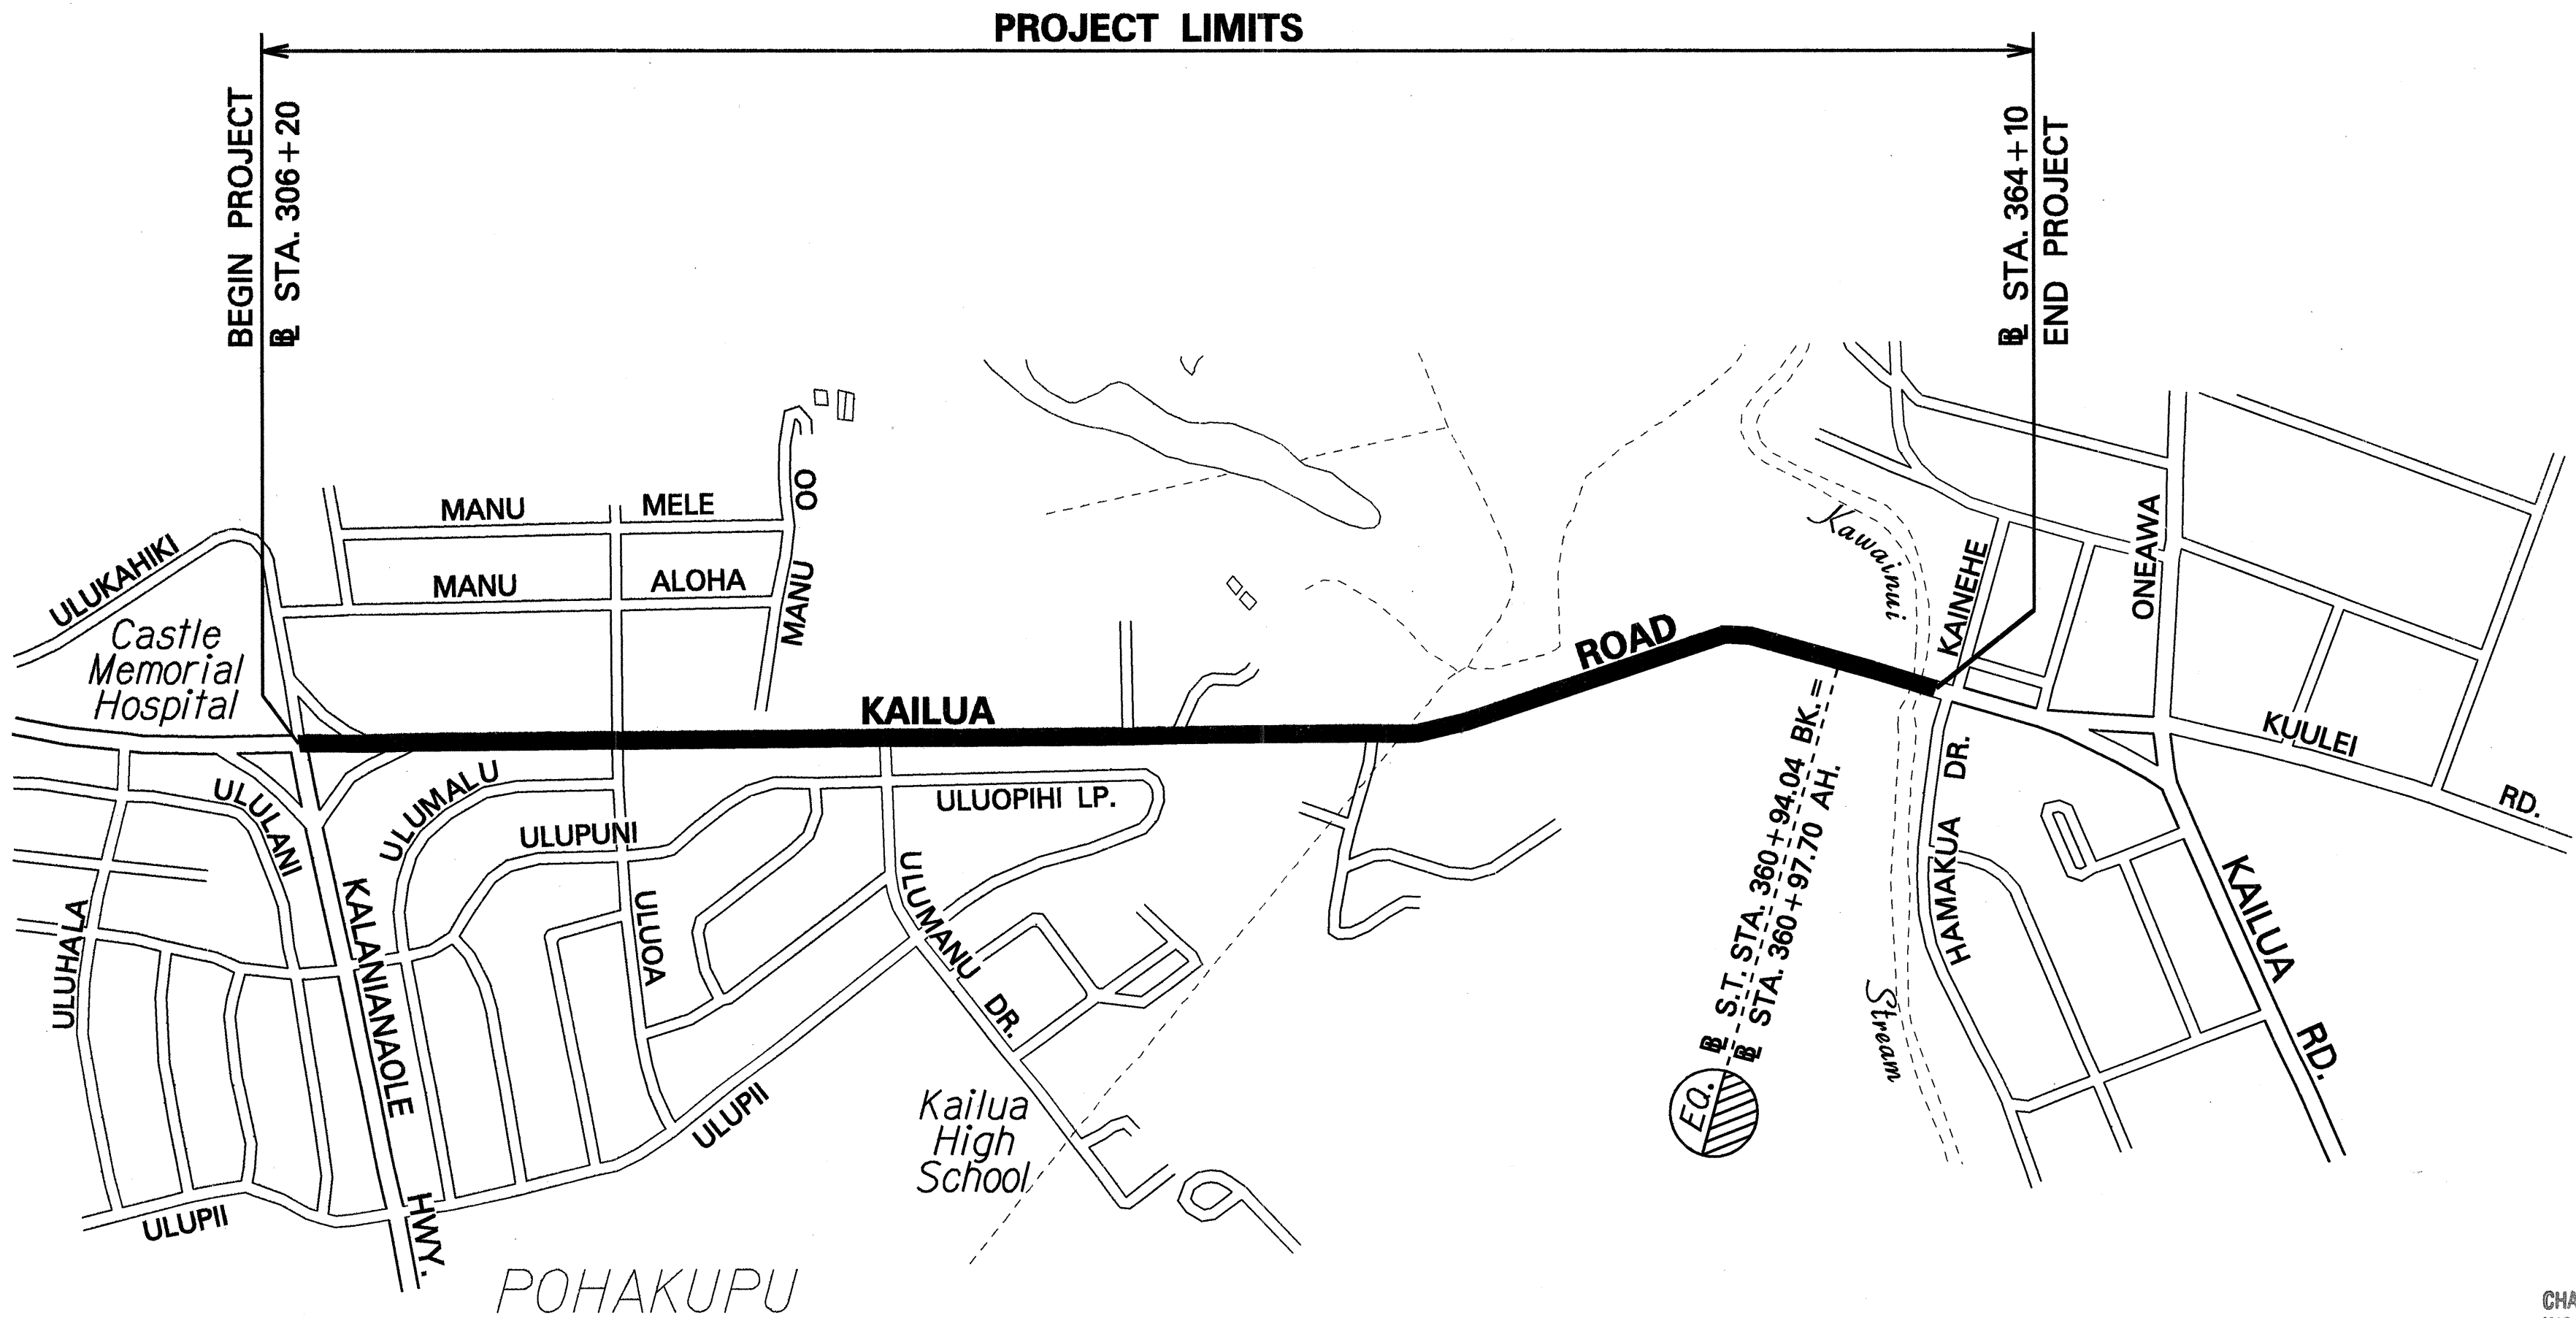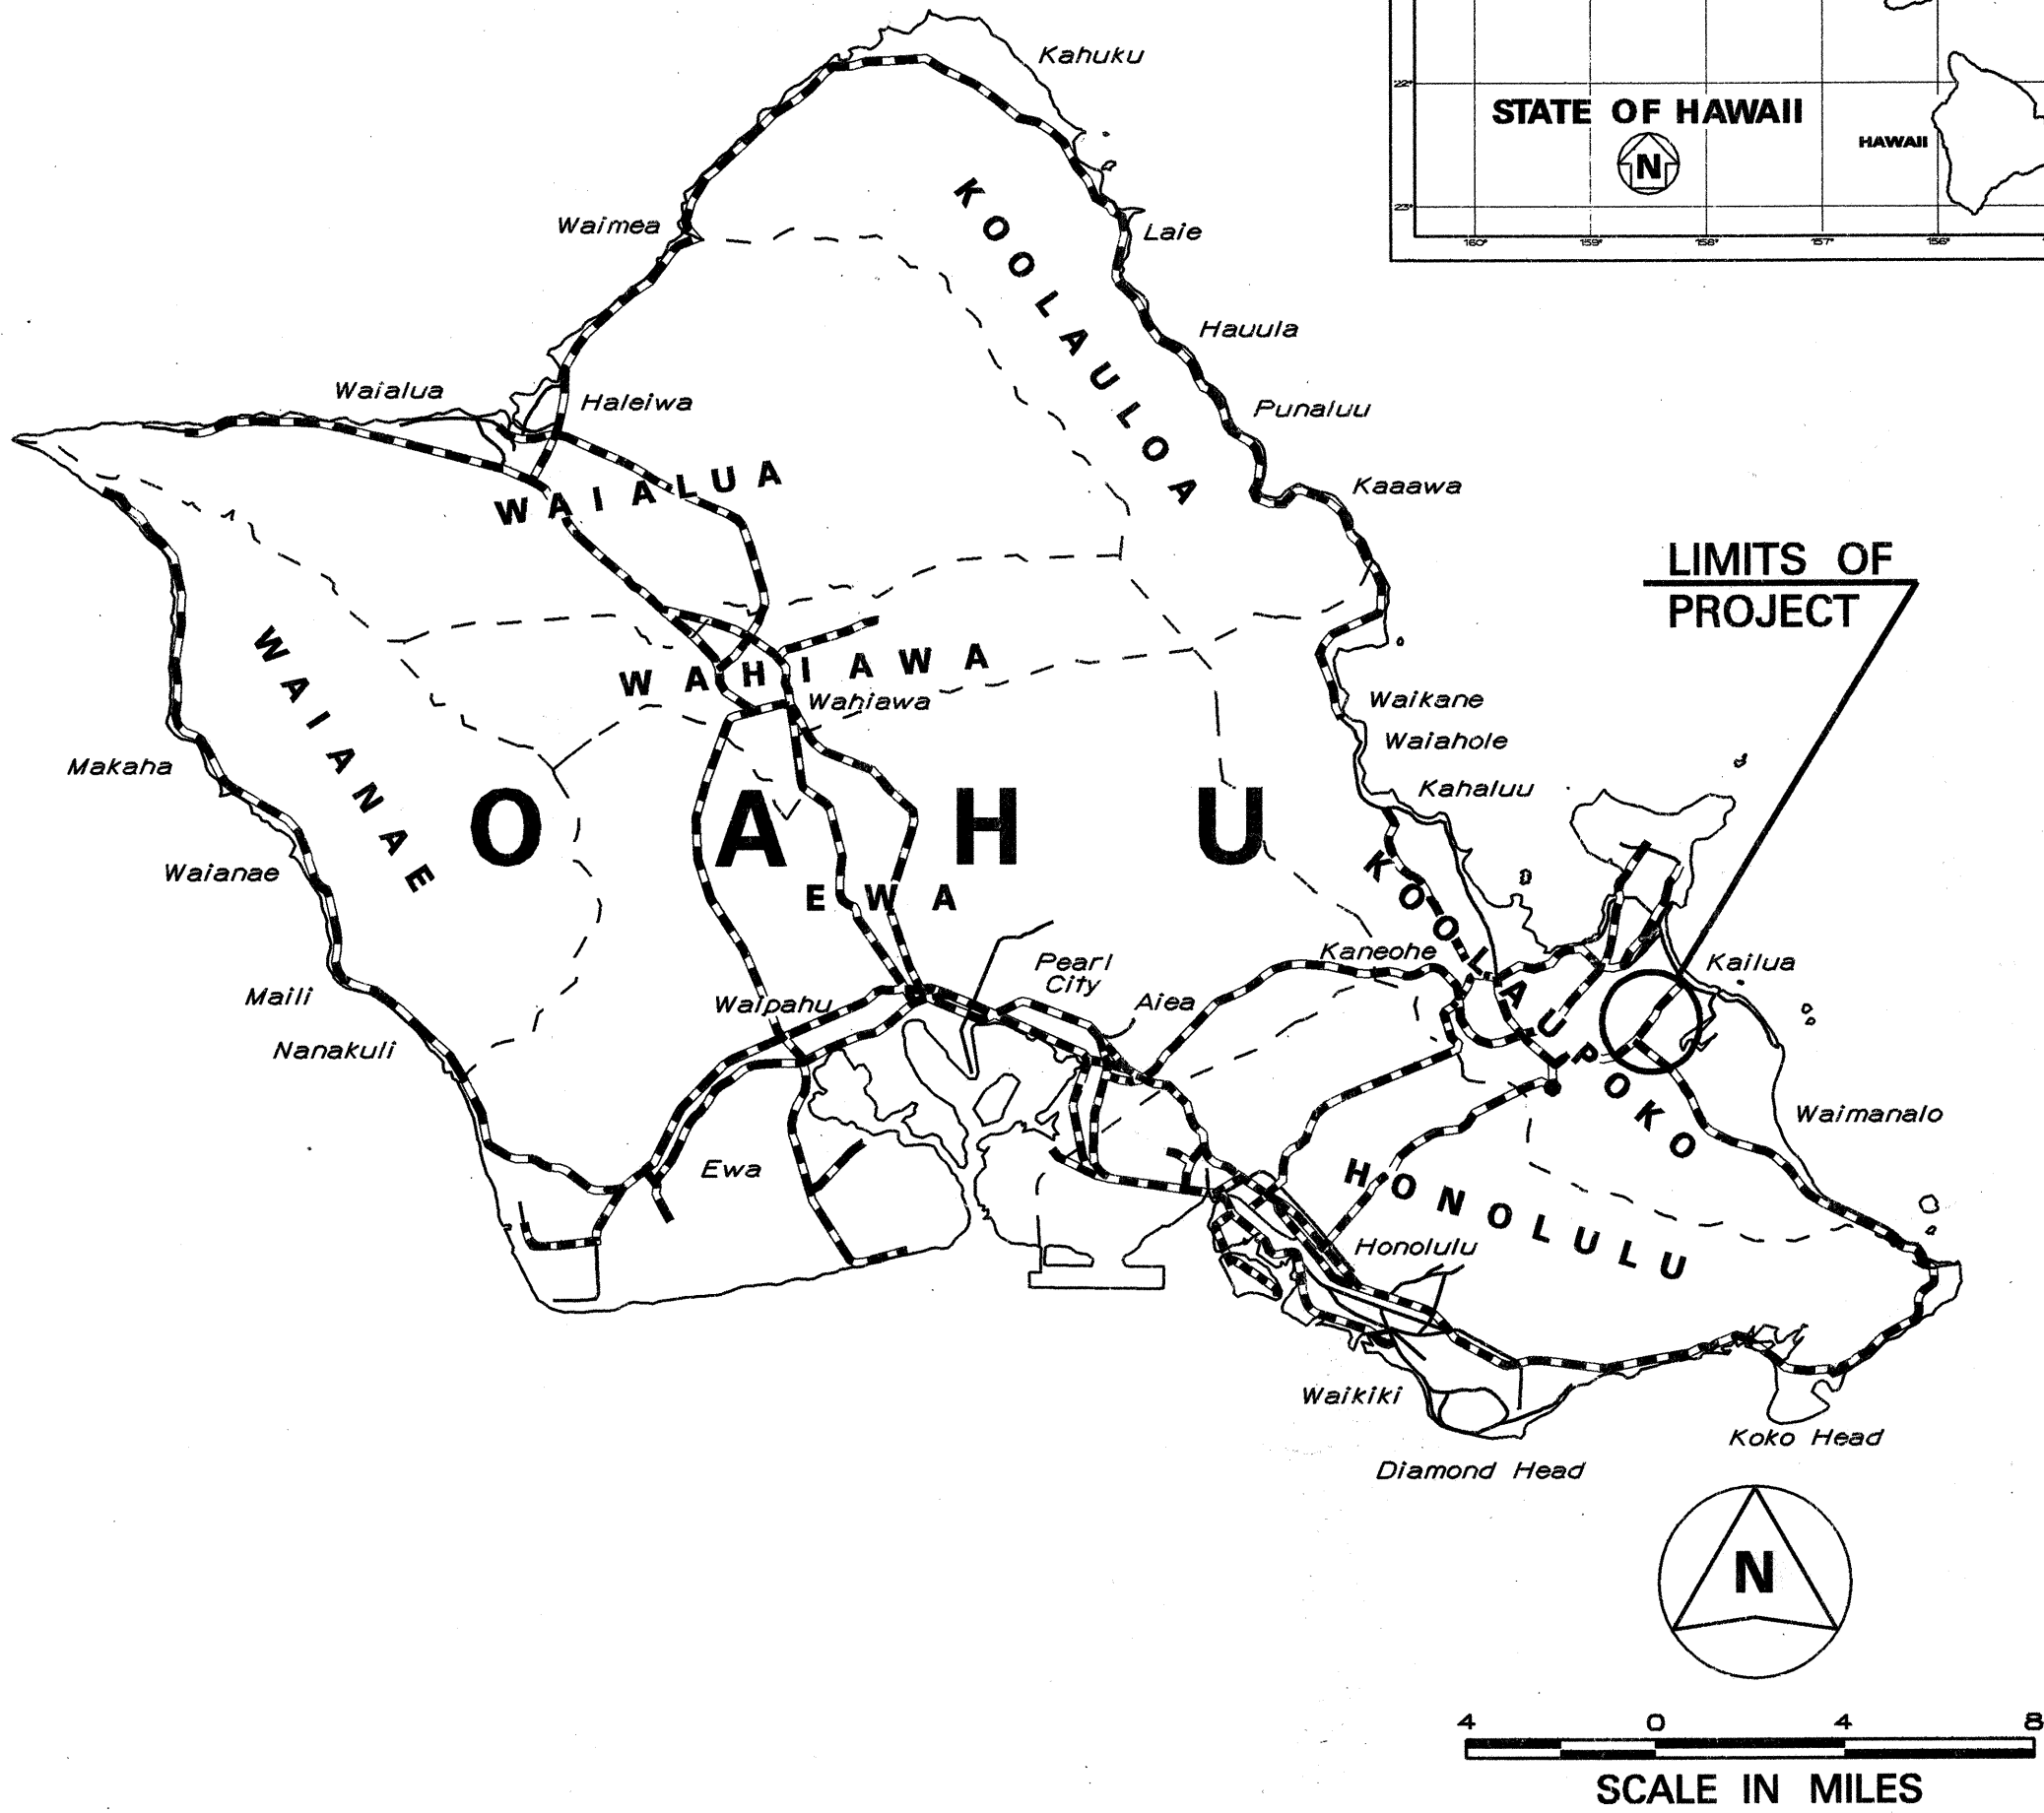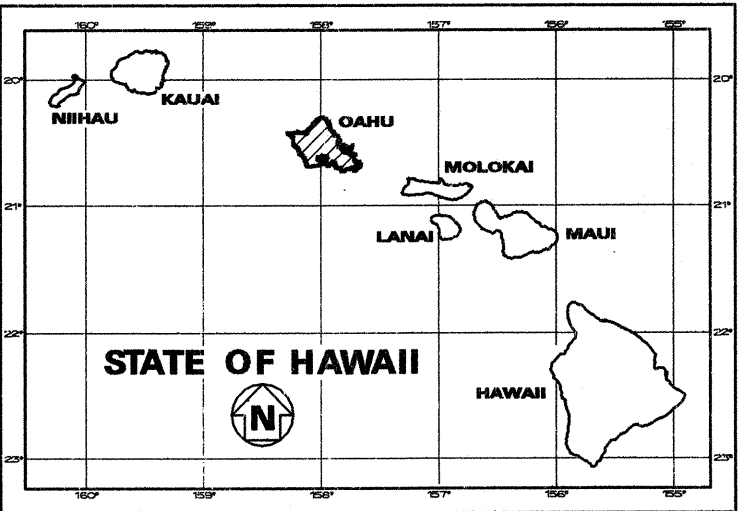


----- FEDERAL AID PROJECTS PREVIOUSLY CONSTRUCTED OR UNDER CONSTRUCTION

MILE POST 9.50 TO MILE POST 10.60

DESIGN DESIGNATION

ADT (1998)	29,200
ADT (2008)	32,200
DHV	2,400
D	60/40
T	2.00%
V	35 M.P.H.


HWY-DD, UNIT "A" DESIGNED BY JULIUS B. FRONDA P.S. & E. BY Jan., 1999 DATE 692-7572 PHONE

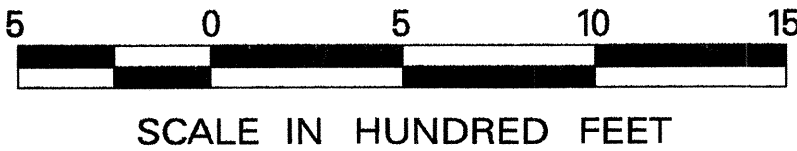

LAYOUT PLAN

GROSS LENGTH OF PROJECT.....1.10 MILES

NET LENGTH OF PROJECT.....1.10 MILES

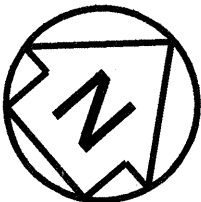

CHANGES MADE DURING CONSTRUCTION HAVE BEEN INCORPORATED ON THESE PLANS EXCEPT CHANGES IN THE ORIGINAL THEORETICAL QUANTITIES. FOR ACTUAL QUANTITIES, REFER TO PROJECT LEDGER AND/OR COMPUTATION BOOK.

RESIDENT ENGINEER DATE

DEPARTMENT OF TRANSPORTATION
STATE OF HAWAII

APPROVED: *[Signature]* 1/26/99
DIR. OF TRANSPORTATION DATE

"AS-BUILT"