
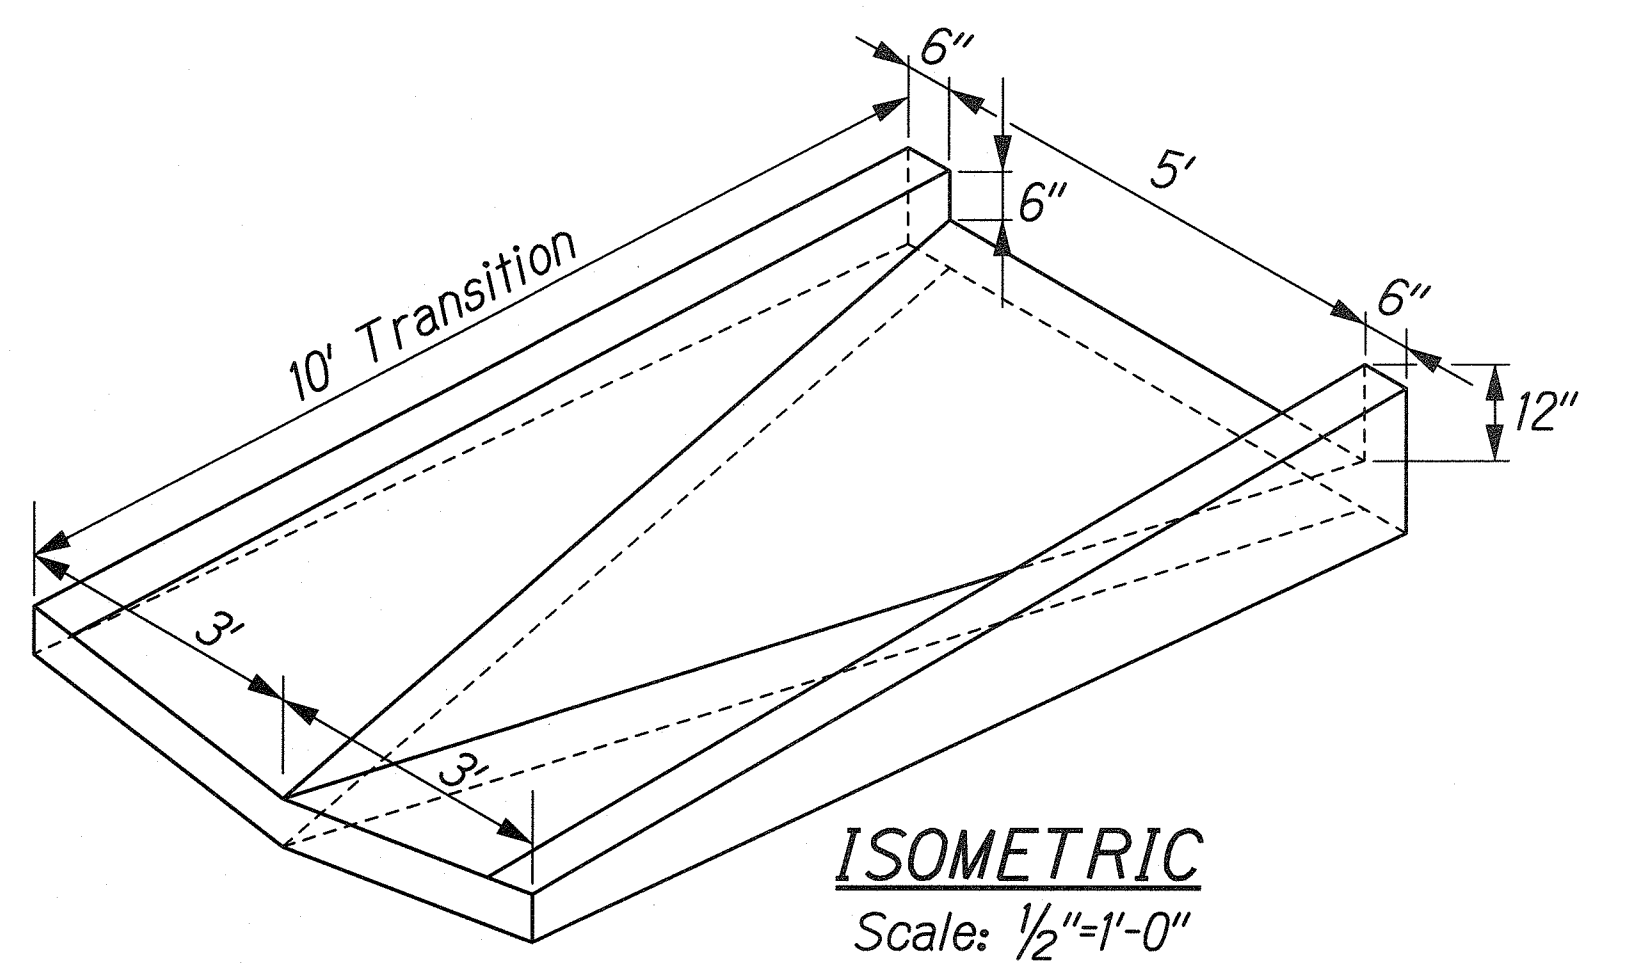
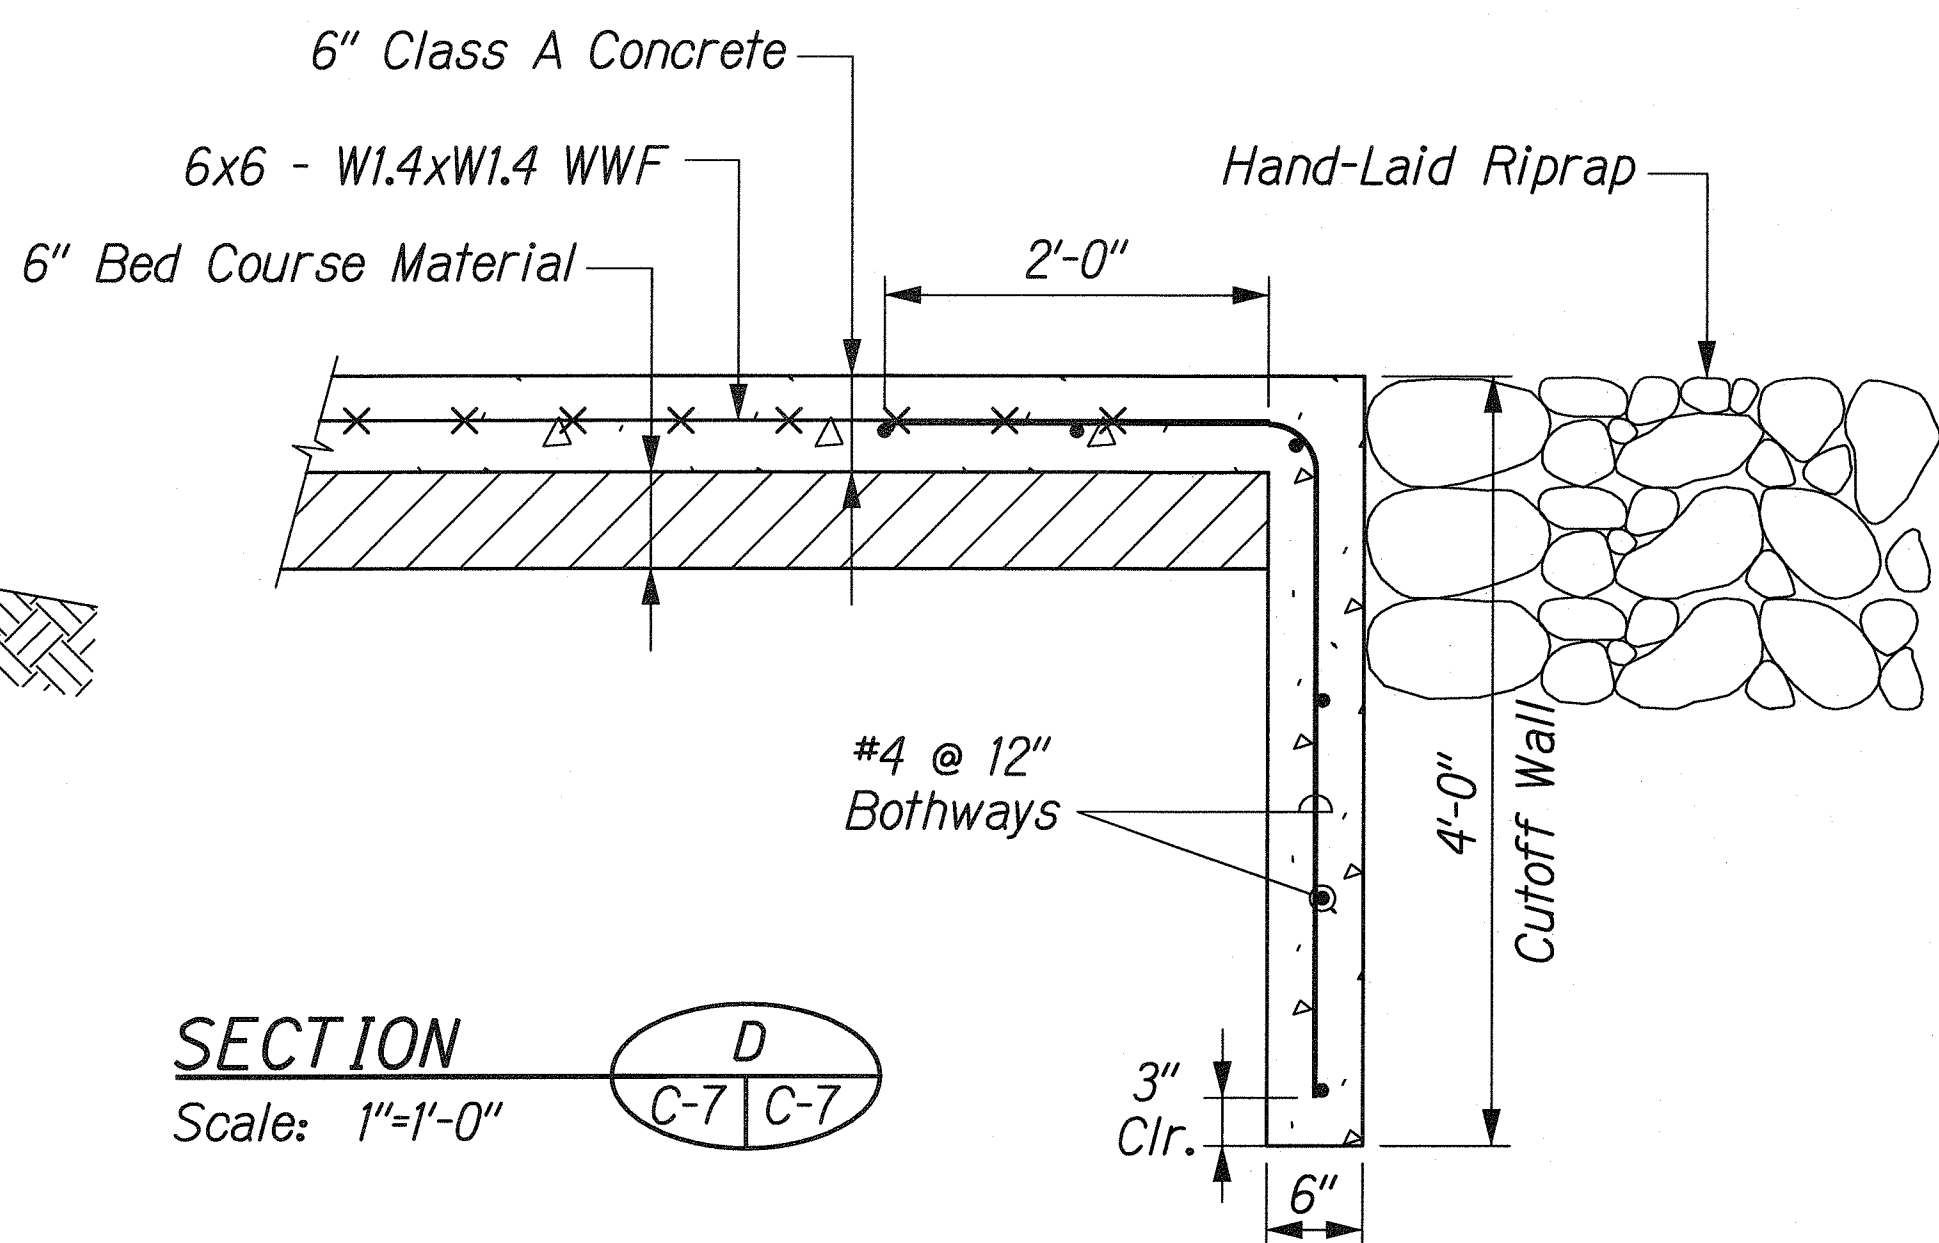
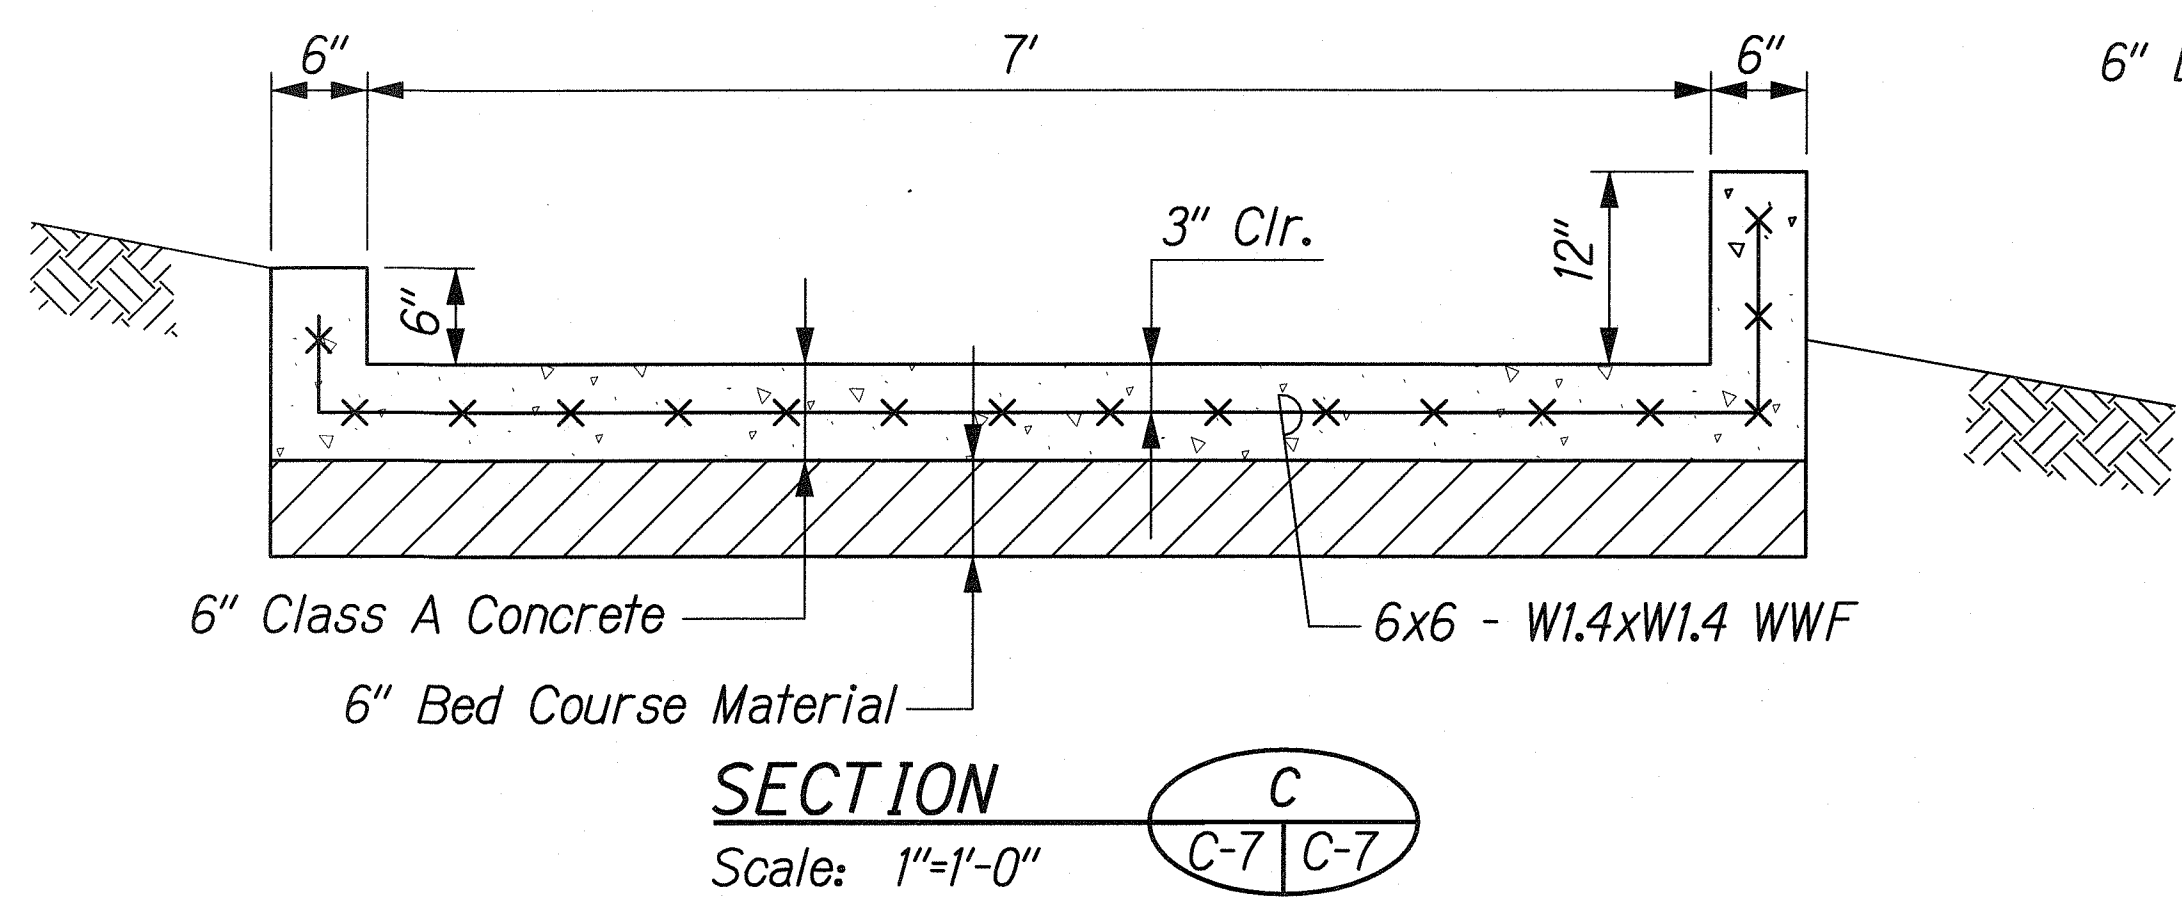
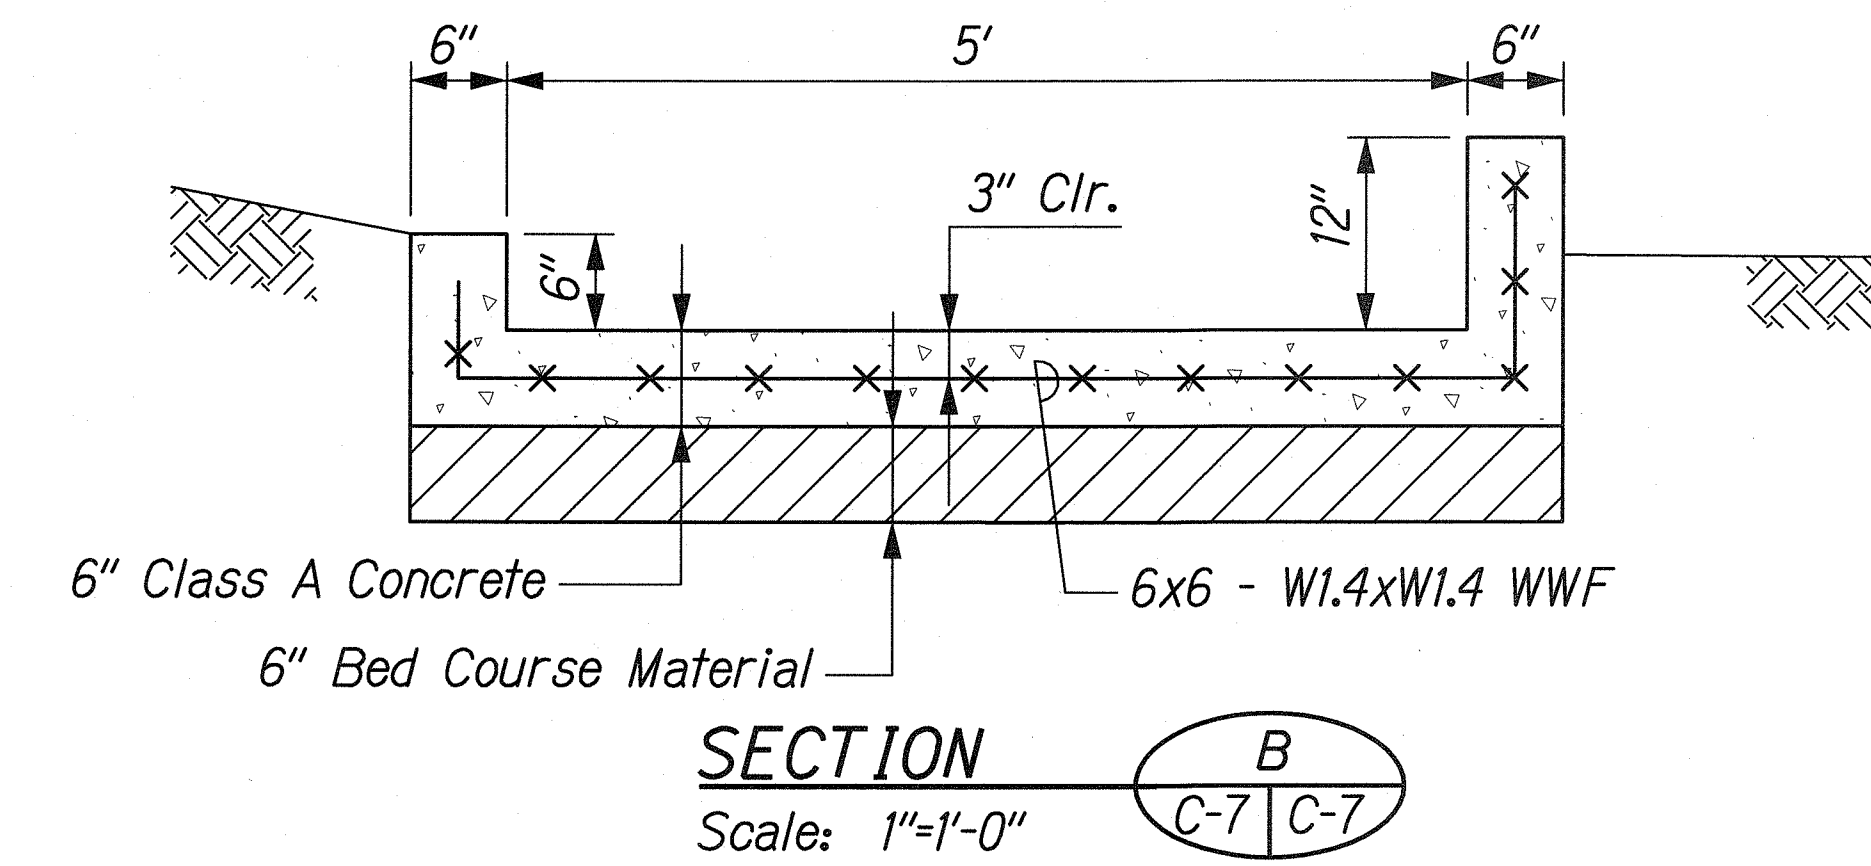
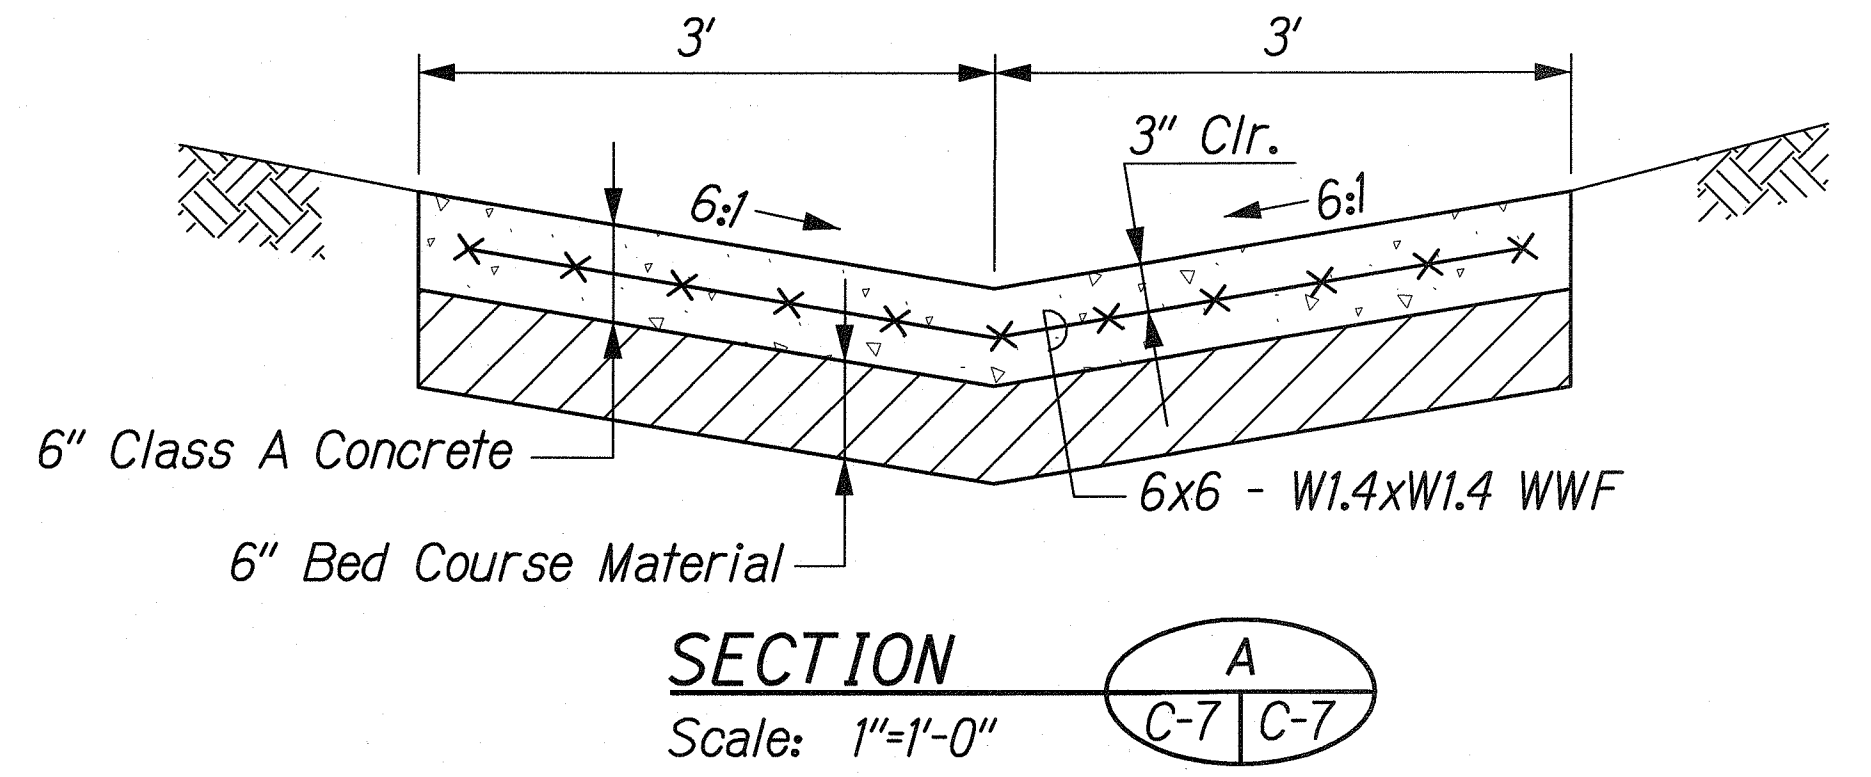


FED. ROAD DIST. NO.	STATE	PROJ. NO.	FISCAL YEAR	SHEET NO.	TOTAL SHEETS
HAWAII	HAW.	61C-01-04#	2004	19	91

02-04

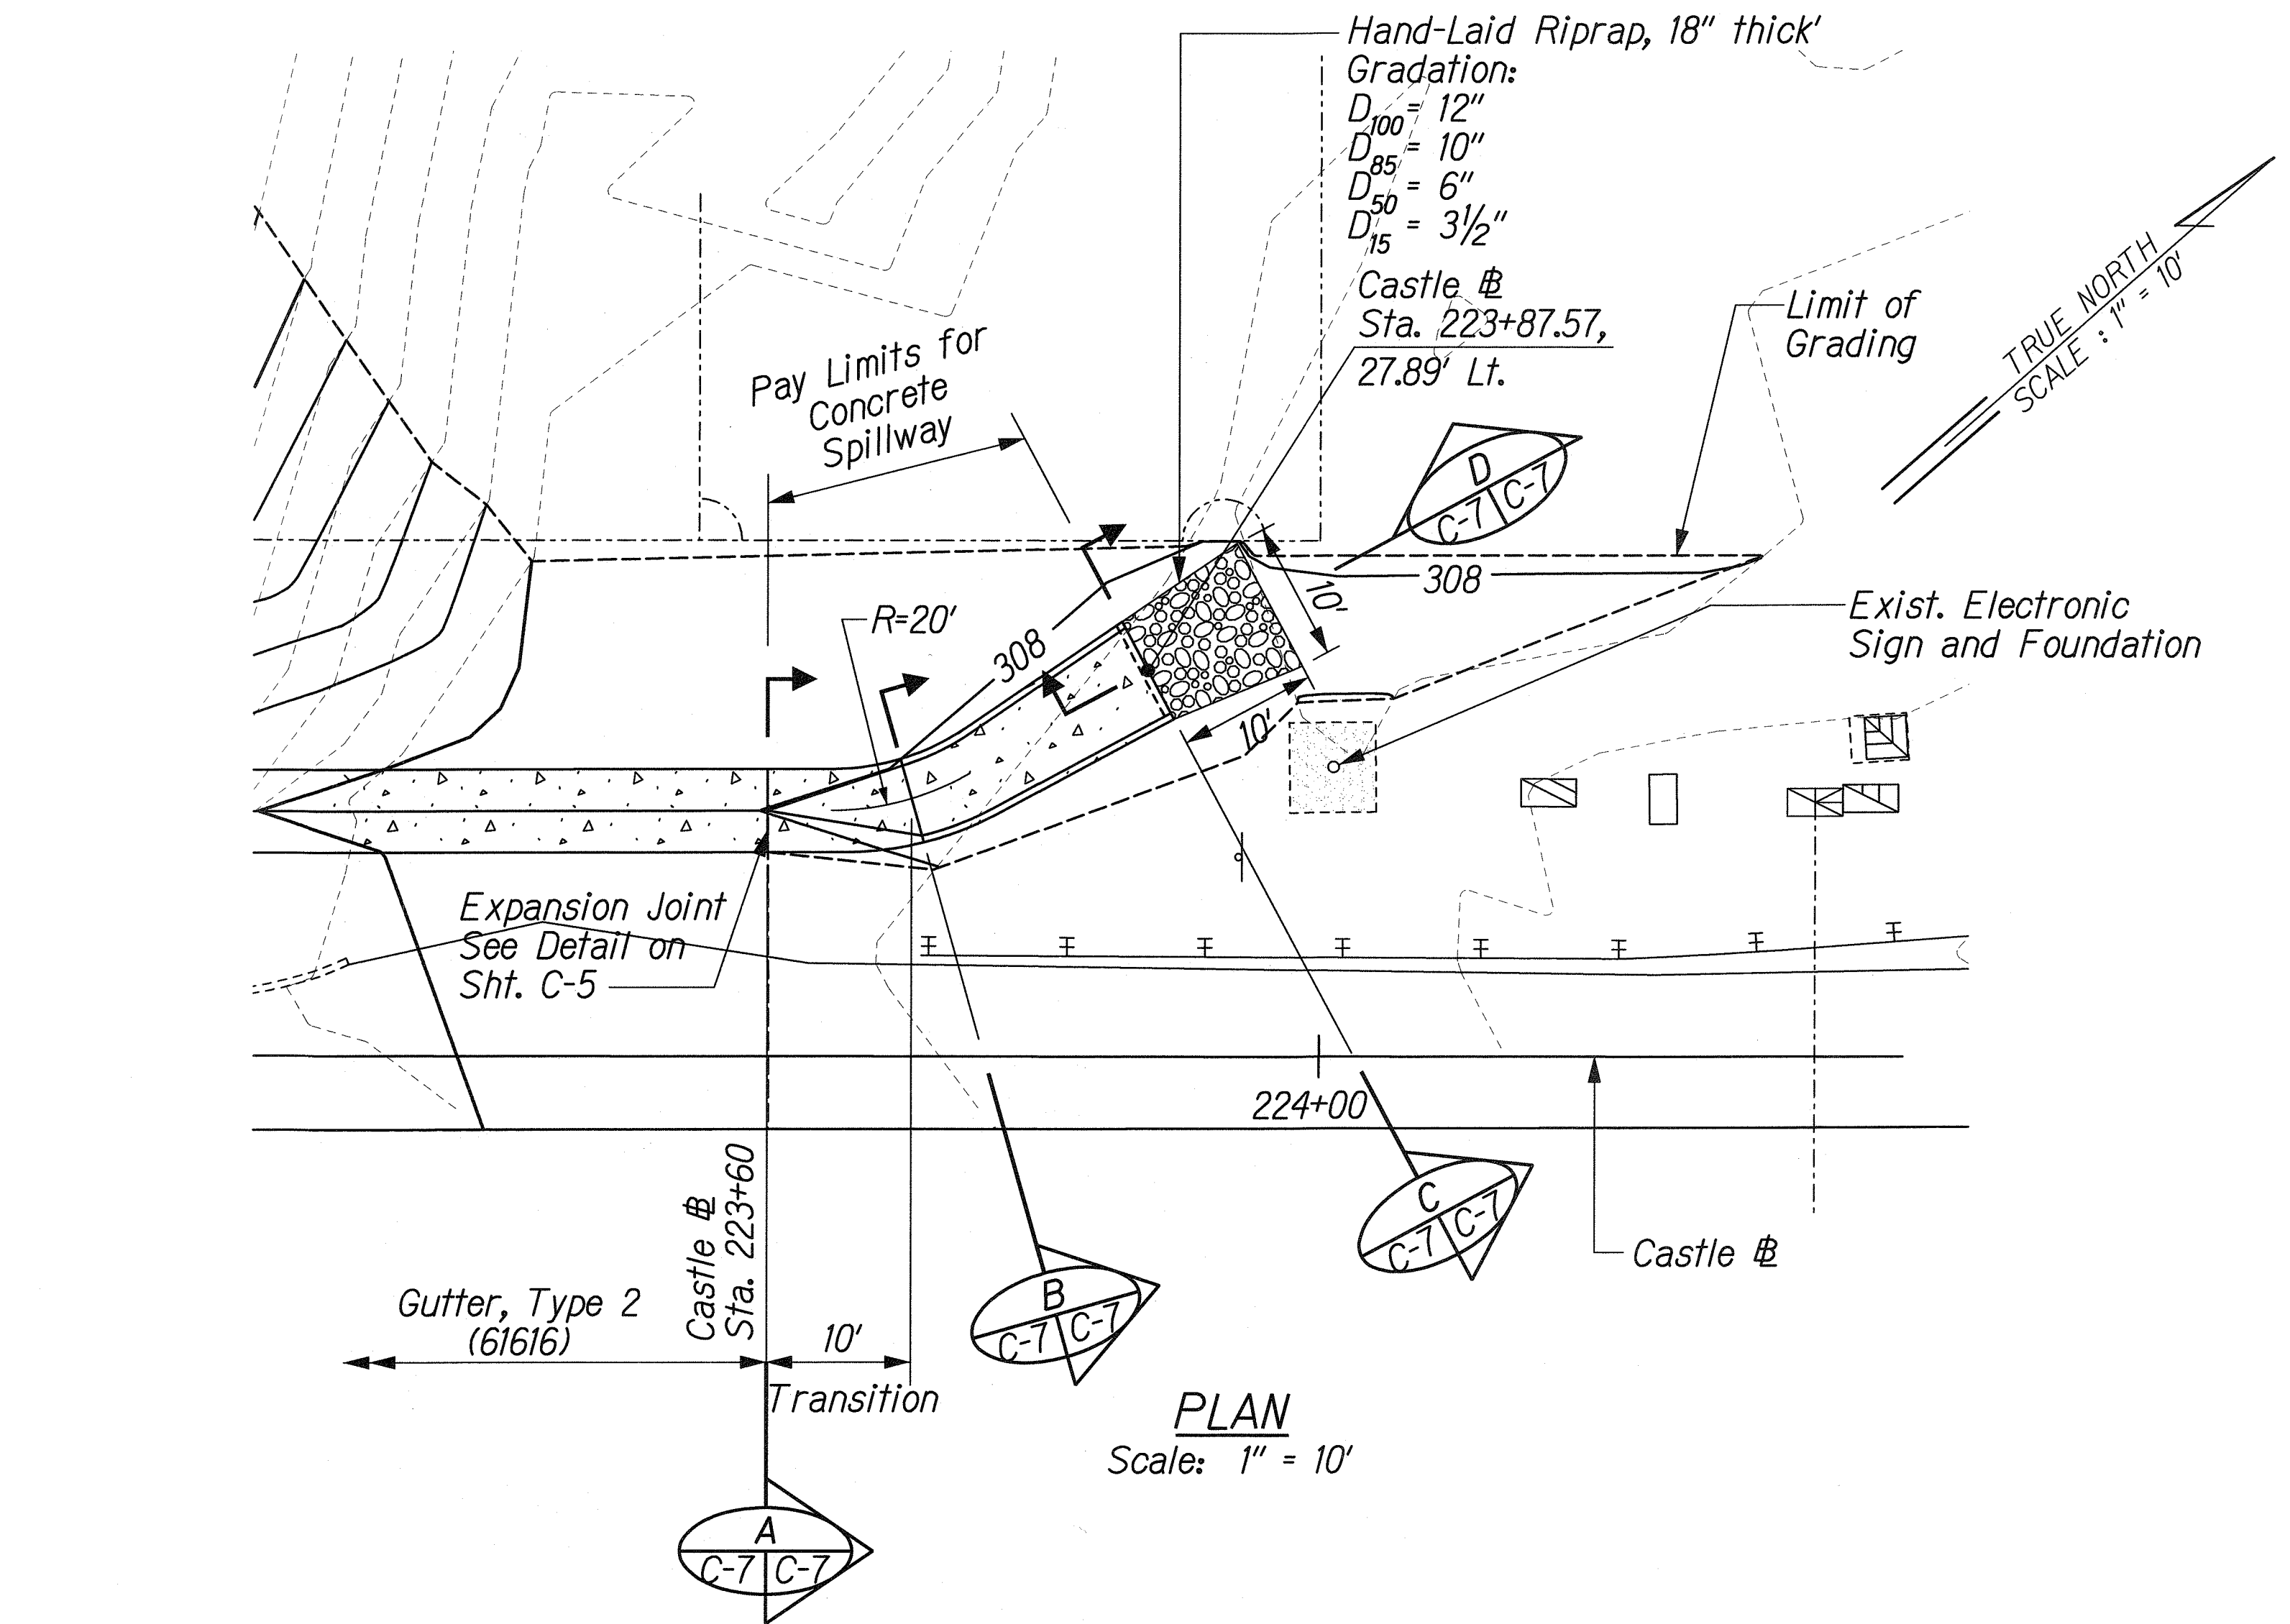

DESIGNED BY	DATE
CHECKED BY	
NOTED BY	
QUANTITIES BY	
REVISIONS	

J:\CASTLE JUNCTION\ROAD\SPILLWAY.dgn

THIS WORK WAS PREPARED BY ME OR UNDER MY SUPERVISION

R. Urasak

STATE OF HAWAII
DEPARTMENT OF TRANSPORTATION
HIGHWAYS DIVISION

CONCRETE SPILLWAY DETAIL

KALANIANA'OLE HIGHWAY
EMERGENCY LANDSLIDE REPAIRS AT CASTLE JUNCTION

PROJECT NO. 61C-01-04# 02-04
Scale: As Shown Date: Sept. 26, 2003

SHEET No. C-7 OF 12 SHEETS

"AS-BUILT"