
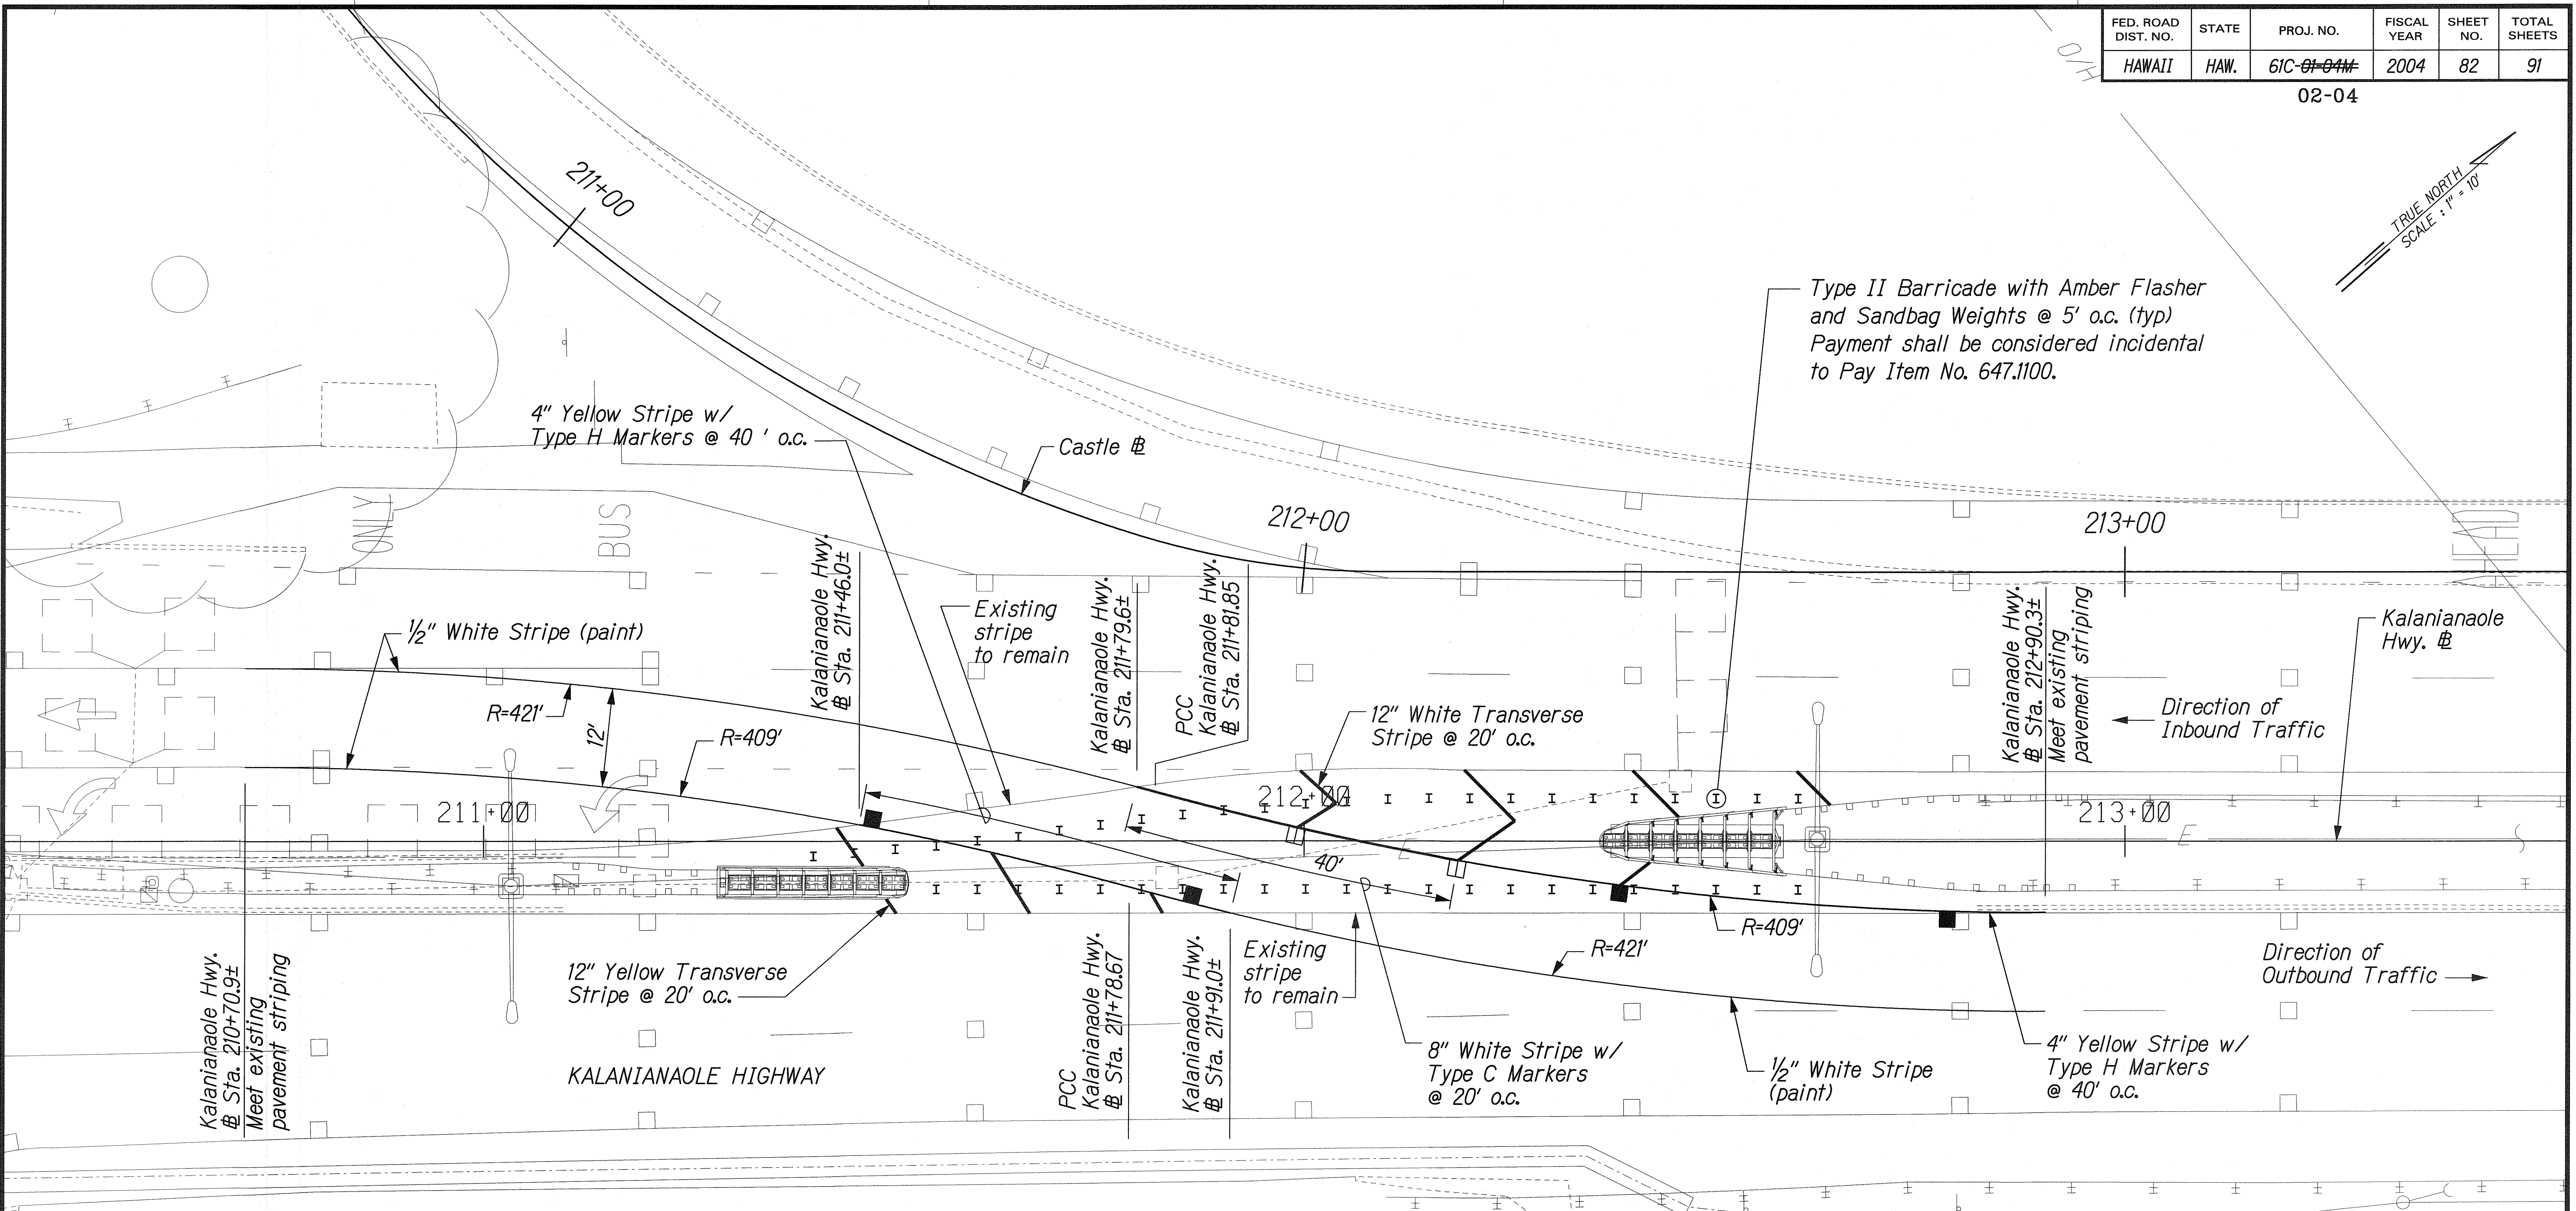


FED. ROAD DIST. NO.	STATE	PROJ. NO.	FISCAL YEAR	SHEET NO.	TOTAL SHEETS
HAWAII	HAW.	61C-01-04#	2004	82	91


02-04

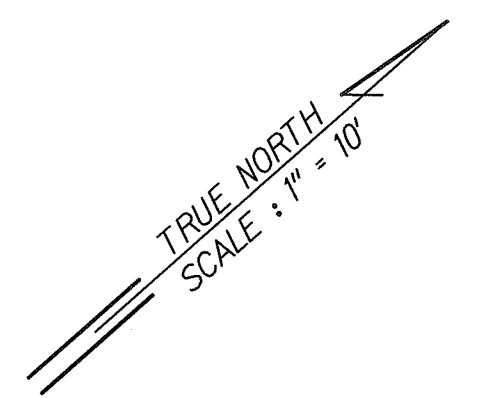

NOTE:


Type II Barricades shall be used to close the Contra-Flow median opening during non-Contra-Flow hours.

LEGEND:

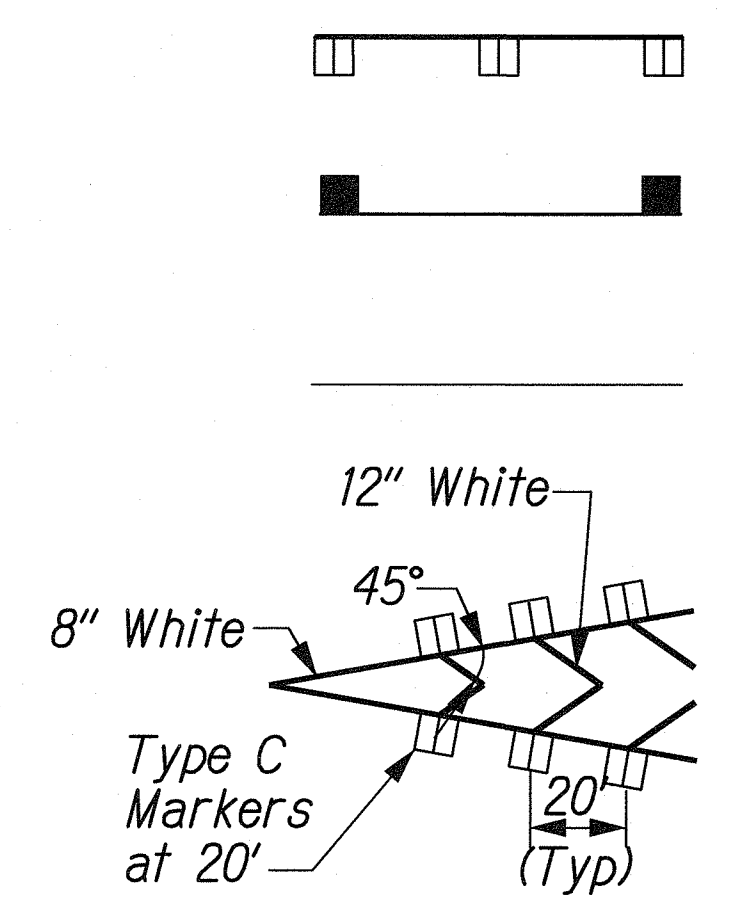

- 8" White Stripe with Type C Markers at 20' o.c.
- 4" Yellow Stripe with Type H Markers at 40' o.c.
- 1/2" White Stripe

Channelizing Island

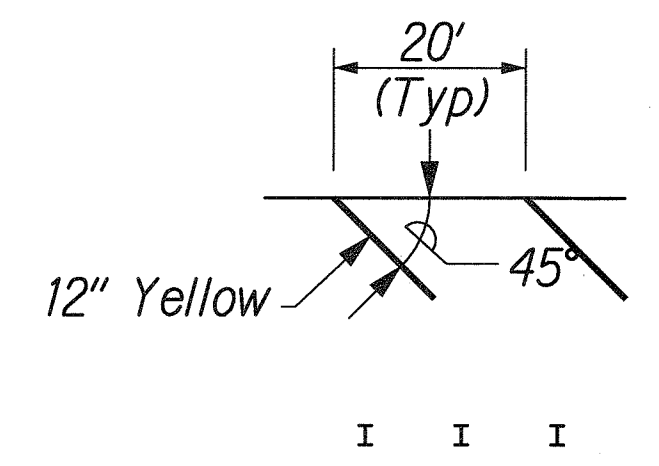

Transverse Stripe

Type II Barricade with Amber Flasher and Sandbag Weights @ 5' o.c.

THIS WORK WAS PREPARED BY ME OR UNDER MY SUPERVISION.

Ru Miller

STATE OF HAWAII
DEPARTMENT OF TRANSPORTATION
HIGHWAYS DIVISION

**CONTRA-FLOW
PAVEMENT MARKING**
KALANIANAʻOLE HIGHWAY

EMERGENCY LANDSLIDE REPAIRS AT CASTLE JUNCTION

PROJECT NO. 61C-01-04# 02-04

Scale: 1" = 10' Date: Sept. 26, 2003

SHEET No. F-11 OF 20 SHEETS

ORIGINAL PLAN	DATE
SERIAL PLOTTED BY	
DESIGNED BY	
NOTED BY	
CHECKED BY	
DATE	

1/2 CASTLE JUNCTION CONTRA-FLOW/CF-03.dgn

"AS-BUILT"