
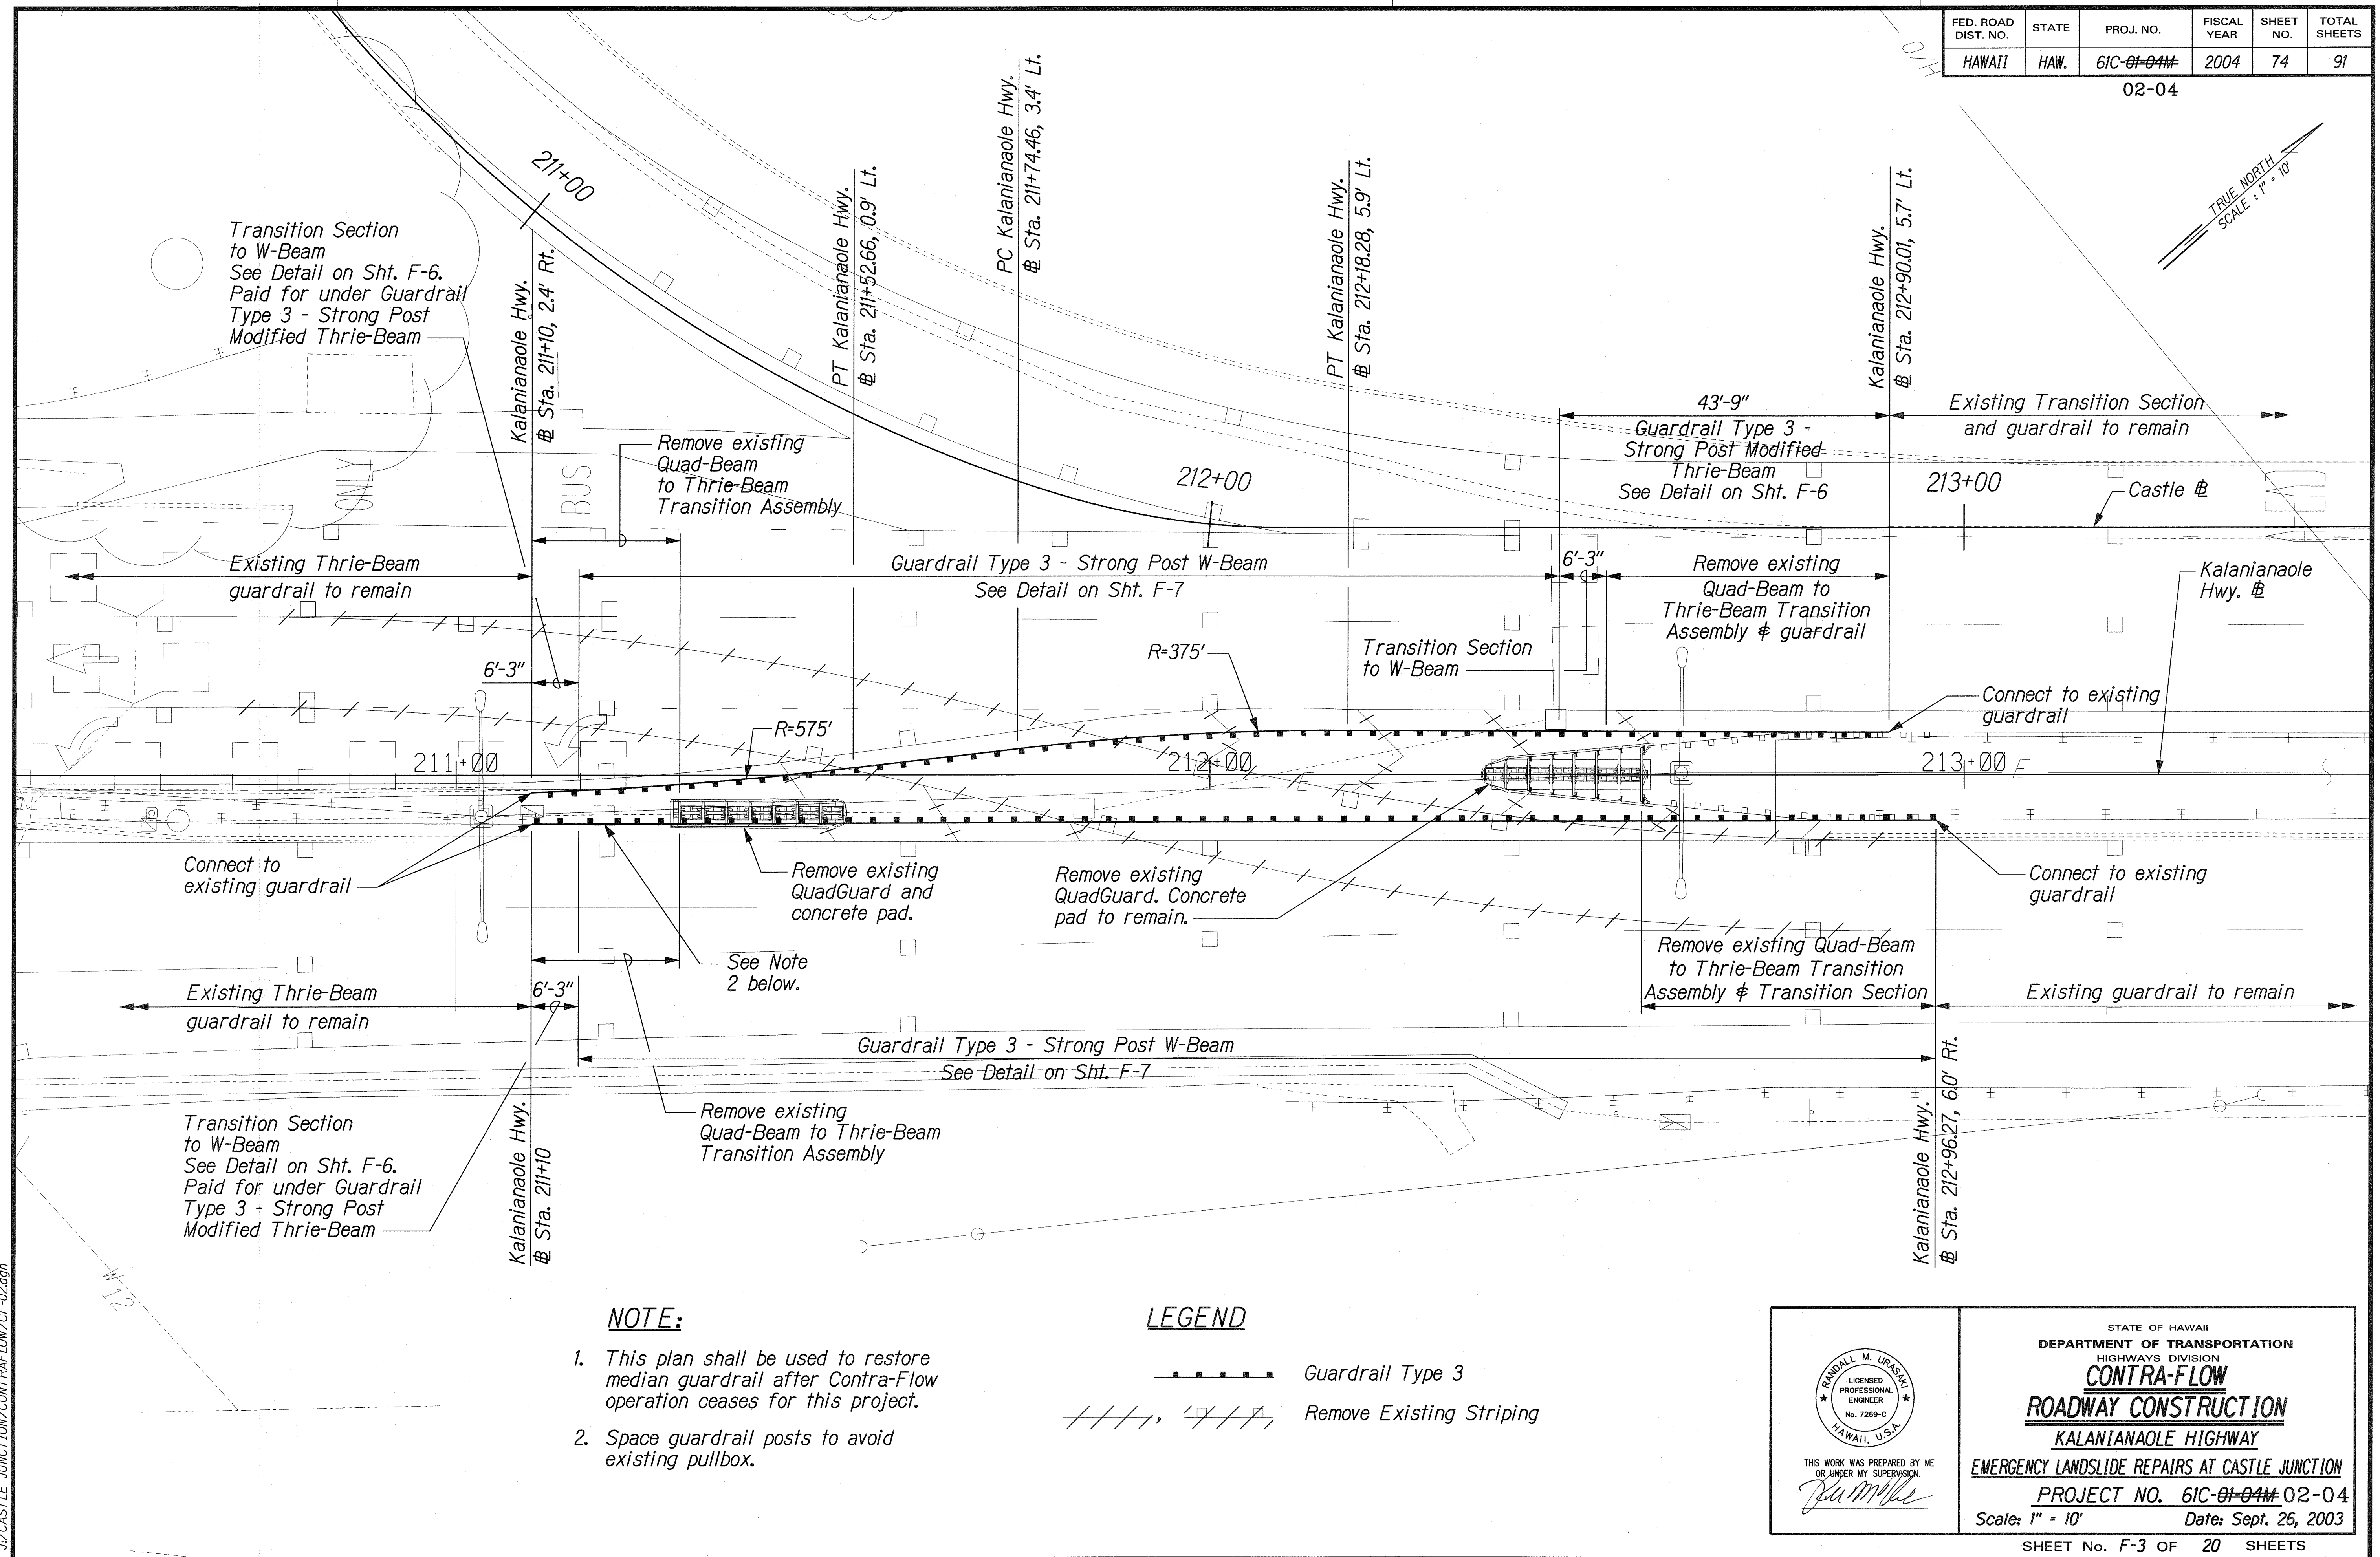


FED. ROAD DIST. NO.	STATE	PROJ. NO.	FISCAL YEAR	SHEET NO.	TOTAL SHEETS
HAWAII	HAW.	61C-01-04#	2004	74	91

02-04

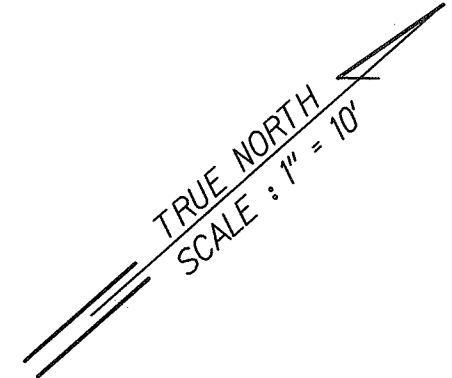

NOTE:

1. This plan shall be used to restore median guardrail after Contra-Flow operation ceases for this project.
2. Space guardrail posts to avoid existing pullbox.

LEGEND

- — — — — Guardrail Type 3
- ///, //, / Remove Existing Striping

ORIGINAL PLAN	DATE
DESIGNED BY	
DRAWN BY	
CHECKED BY	
NOTED BY	
QUANTITIES BY	
DATE	

J:\CASTLE JUNCTION\CONTRA-FLOW\CF-02.dgn

THIS WORK WAS PREPARED BY ME OR UNDER MY SUPERVISION.

Ru Miller

STATE OF HAWAII
DEPARTMENT OF TRANSPORTATION
HIGHWAYS DIVISION
CONTRA-FLOW
ROADWAY CONSTRUCTION
KALANIANAʻOLE HIGHWAY
EMERGENCY LANDSLIDE REPAIRS AT CASTLE JUNCTION
PROJECT NO. 61C-01-04# 02-04
Scale: 1" = 10' Date: Sept. 26, 2003
SHEET No. F-3 OF 20 SHEETS

"AS-BUILT"