
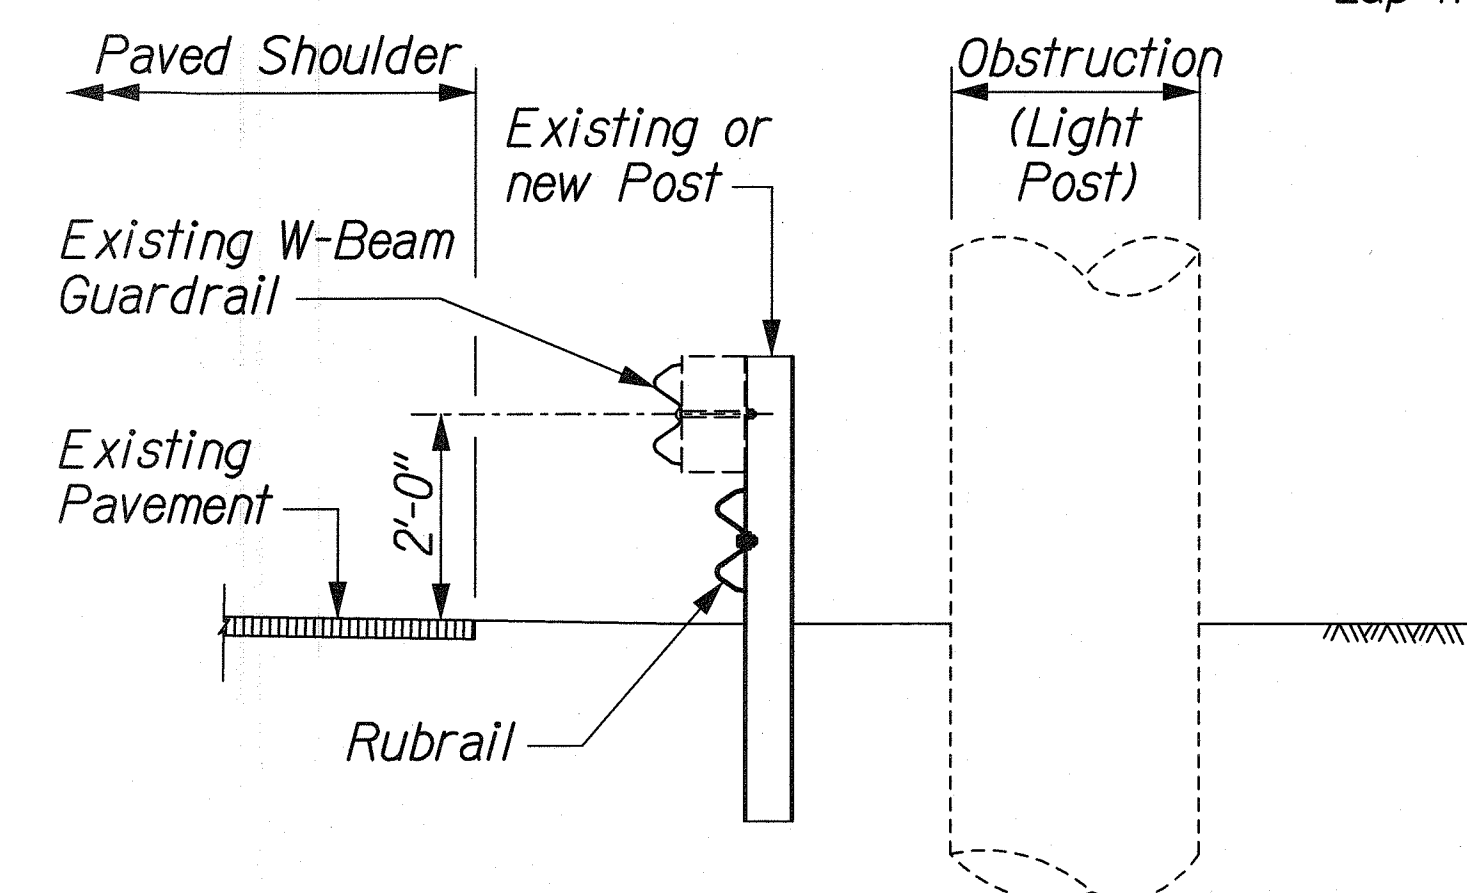
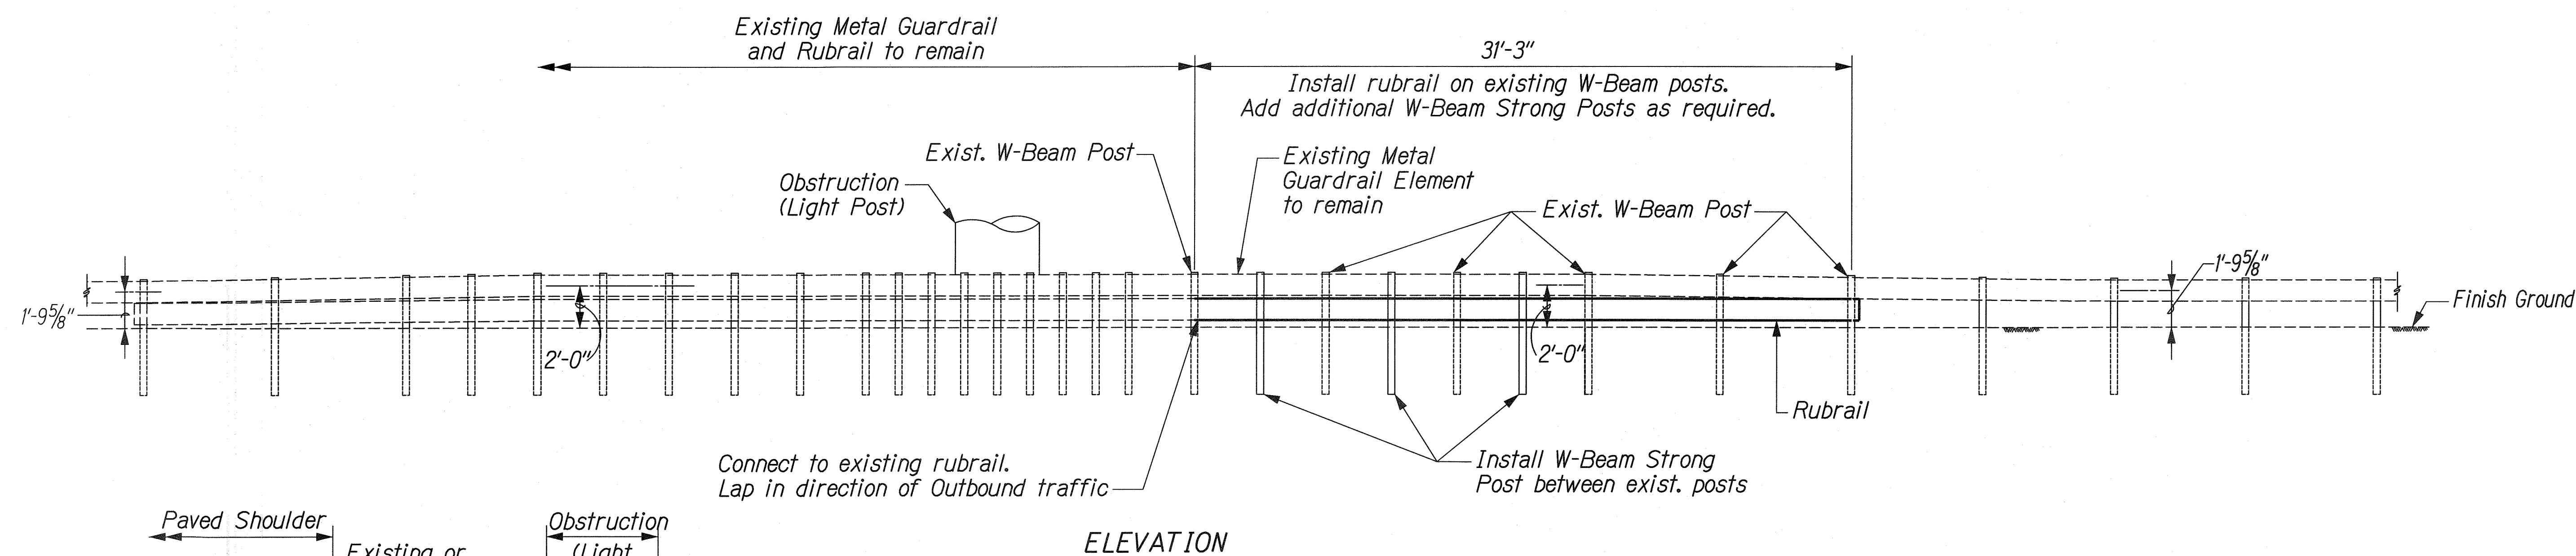


FED. ROAD DIST. NO.	STATE	PROJ. NO.	FISCAL YEAR	SHEET NO.	TOTAL SHEETS
HAWAII	HAW.	61C-01-04#	2004	76	91

02-04

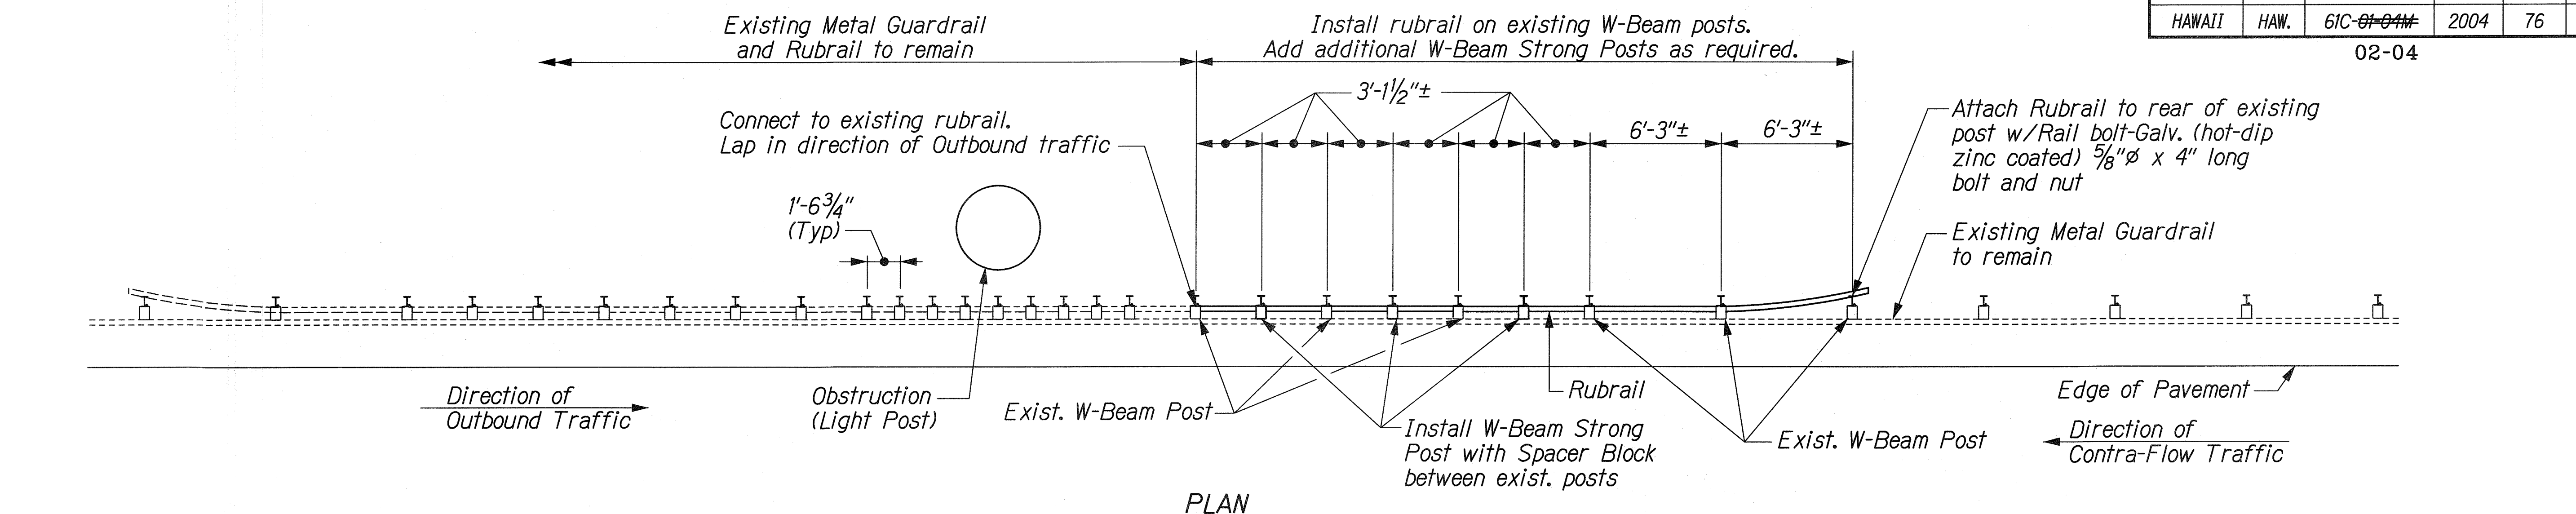

# DETAIL OF RUBRAIL INSTALLATION AT OBSTRUCTION (LIGHT POST)

ORIGINAL PLAN	DATE
SURVEY PLOTTED BY	
DRAWN BY	
DESIGNED BY	
CHECKED BY	
NOTED BY	
DATE	

J:\CASTLE JUNCTION\CONTRA-FLOW\TES4REV.dgn

<p>THIS WORK WAS PREPARED BY ME OR UNDER MY SUPERVISION.</p> <p><i>R. M. Ura</i></p>	STATE OF HAWAII DEPARTMENT OF TRANSPORTATION HIGHWAYS DIVISION <b>CONTRA-FLOW</b> <b>RUBRAIL DETAILS</b> KALANIANA'OLE HIGHWAY EMERGENCY LANDSLIDE REPAIRS AT CASTLE JUNCTION PROJECT NO. 61C-01-04# 02-04 Scale: NTS Date: Sept. 26, 2003
	SHEET No. F-5 OF 20 SHEETS
	76
	"AS-BUILT"
	02-04