
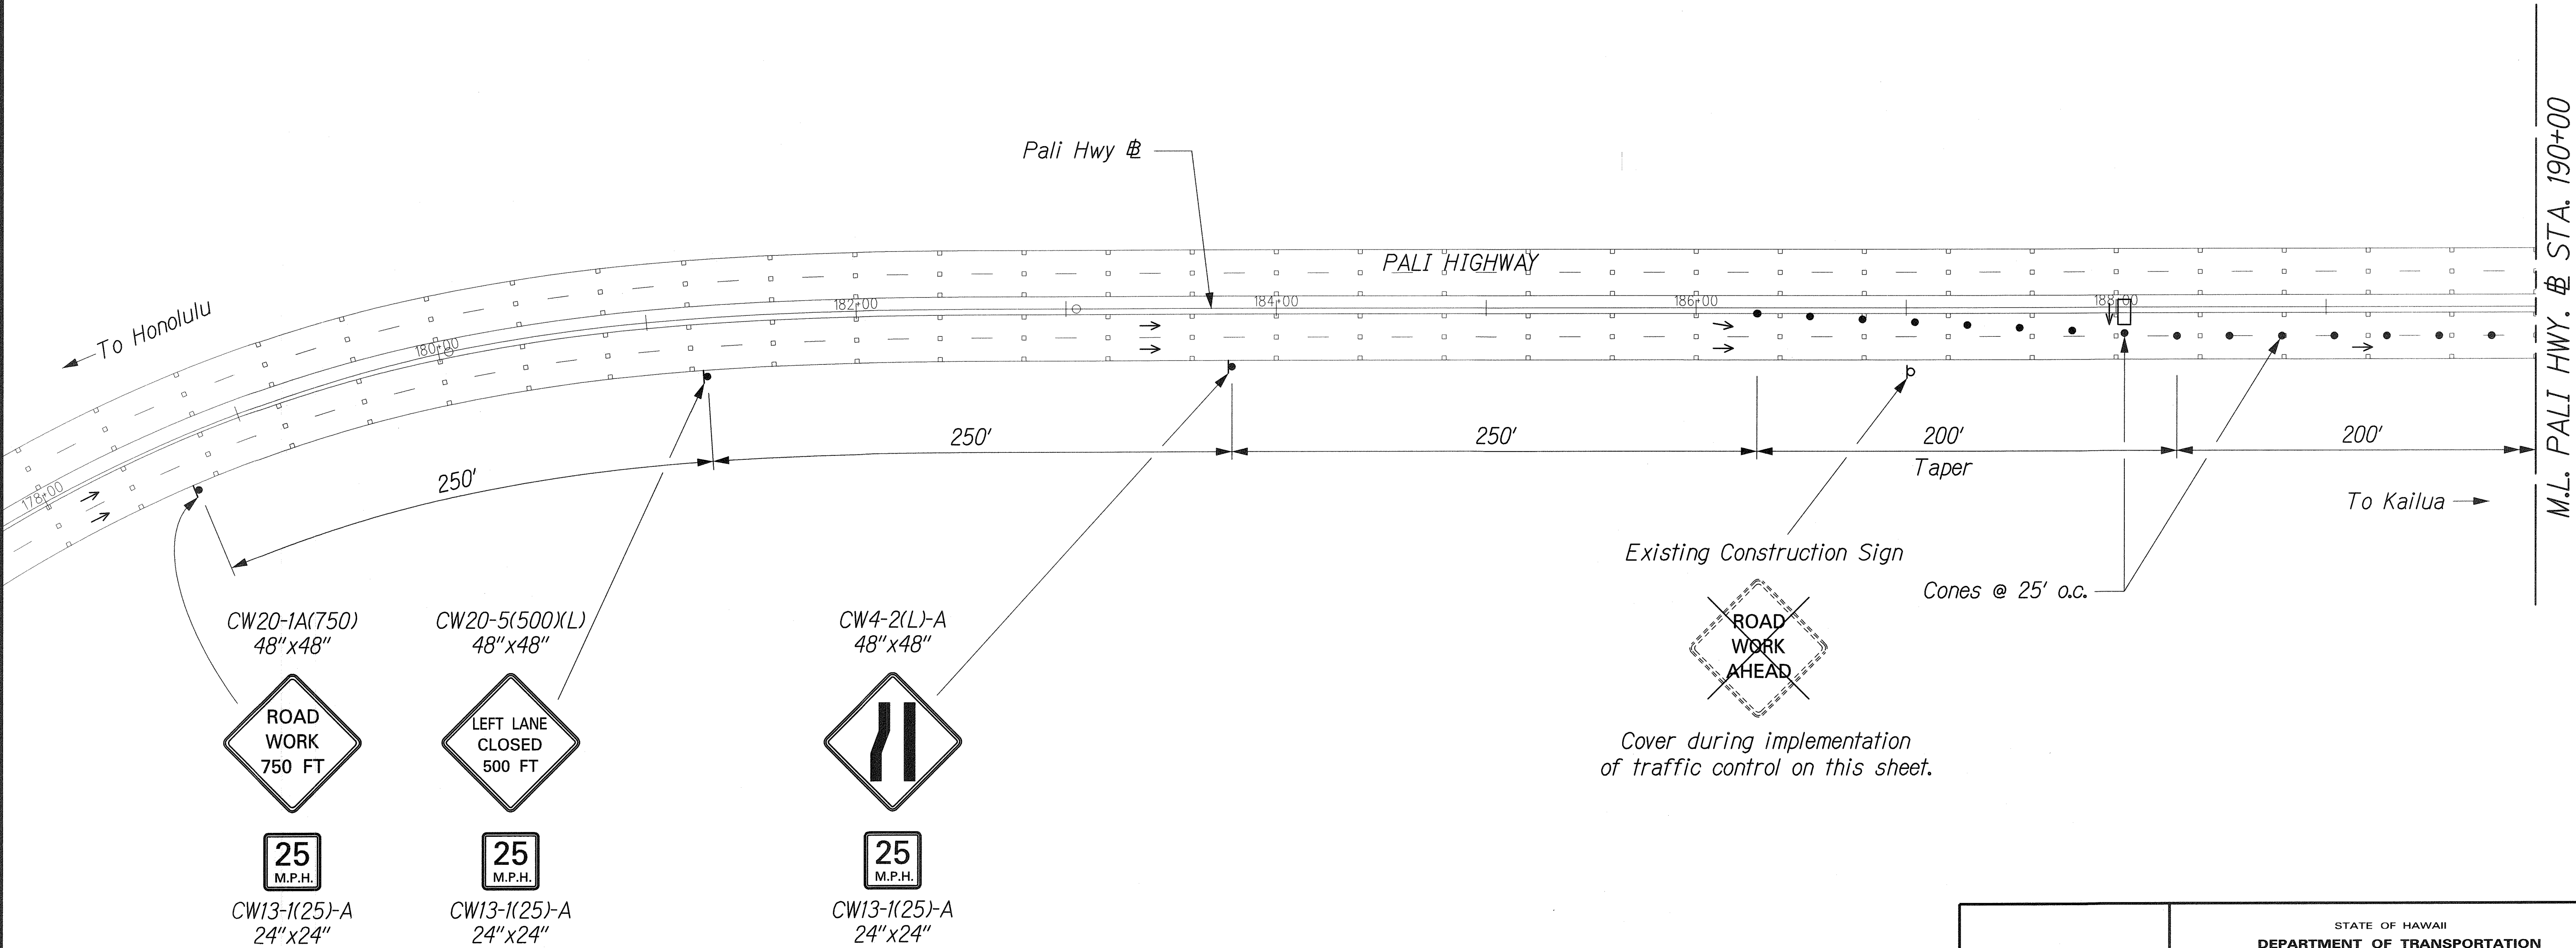


FED. ROAD DIST. NO.	STATE	PROJ. NO.	FISCAL YEAR	SHEET NO.	TOTAL SHEETS
HAWAII	HAW.	61C-01-04#	2004	88	91

02-04

CONTRA-FLOW TRAFFIC CONTROL NOTES:

1. See Sht. D-1 for Traffic Control Notes and Legend.
2. For placement of existing Construction Signs, see Sht. S-2.

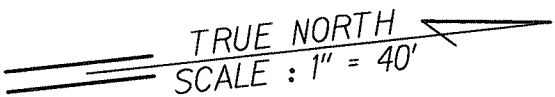

SURVEY PLOTTED BY	DATE
DRAWN BY	
TRACED BY	
CHECKED BY	
QUANTITIES BY	
NOTES BY	
CHECKED BY	
DATE	

J:\CASTLE JUNCTION\TCF\TCF-00.dgn


THIS WORK WAS PREPARED BY ME OR UNDER MY SUPERVISION.

R. Urashima

STATE OF HAWAII
DEPARTMENT OF TRANSPORTATION
HIGHWAYS DIVISION
**CONTRA-FLOW
TRAFFIC CONTROL PLAN**
KALANIANA'OLE HIGHWAY
EMERGENCY LANDSLIDE REPAIRS AT CASTLE JUNCTION
PROJECT NO. 61C-01-04# 02-04
Scale: 1" = 40' Date: Sept. 26, 2003

FED. ROAD DIST. NO.	STATE	PROJ. NO.	FISCAL YEAR	SHEET NO.	TOTAL SHEETS
HAWAII	HAW.	61C-01-04#	2004	89	91

02-04

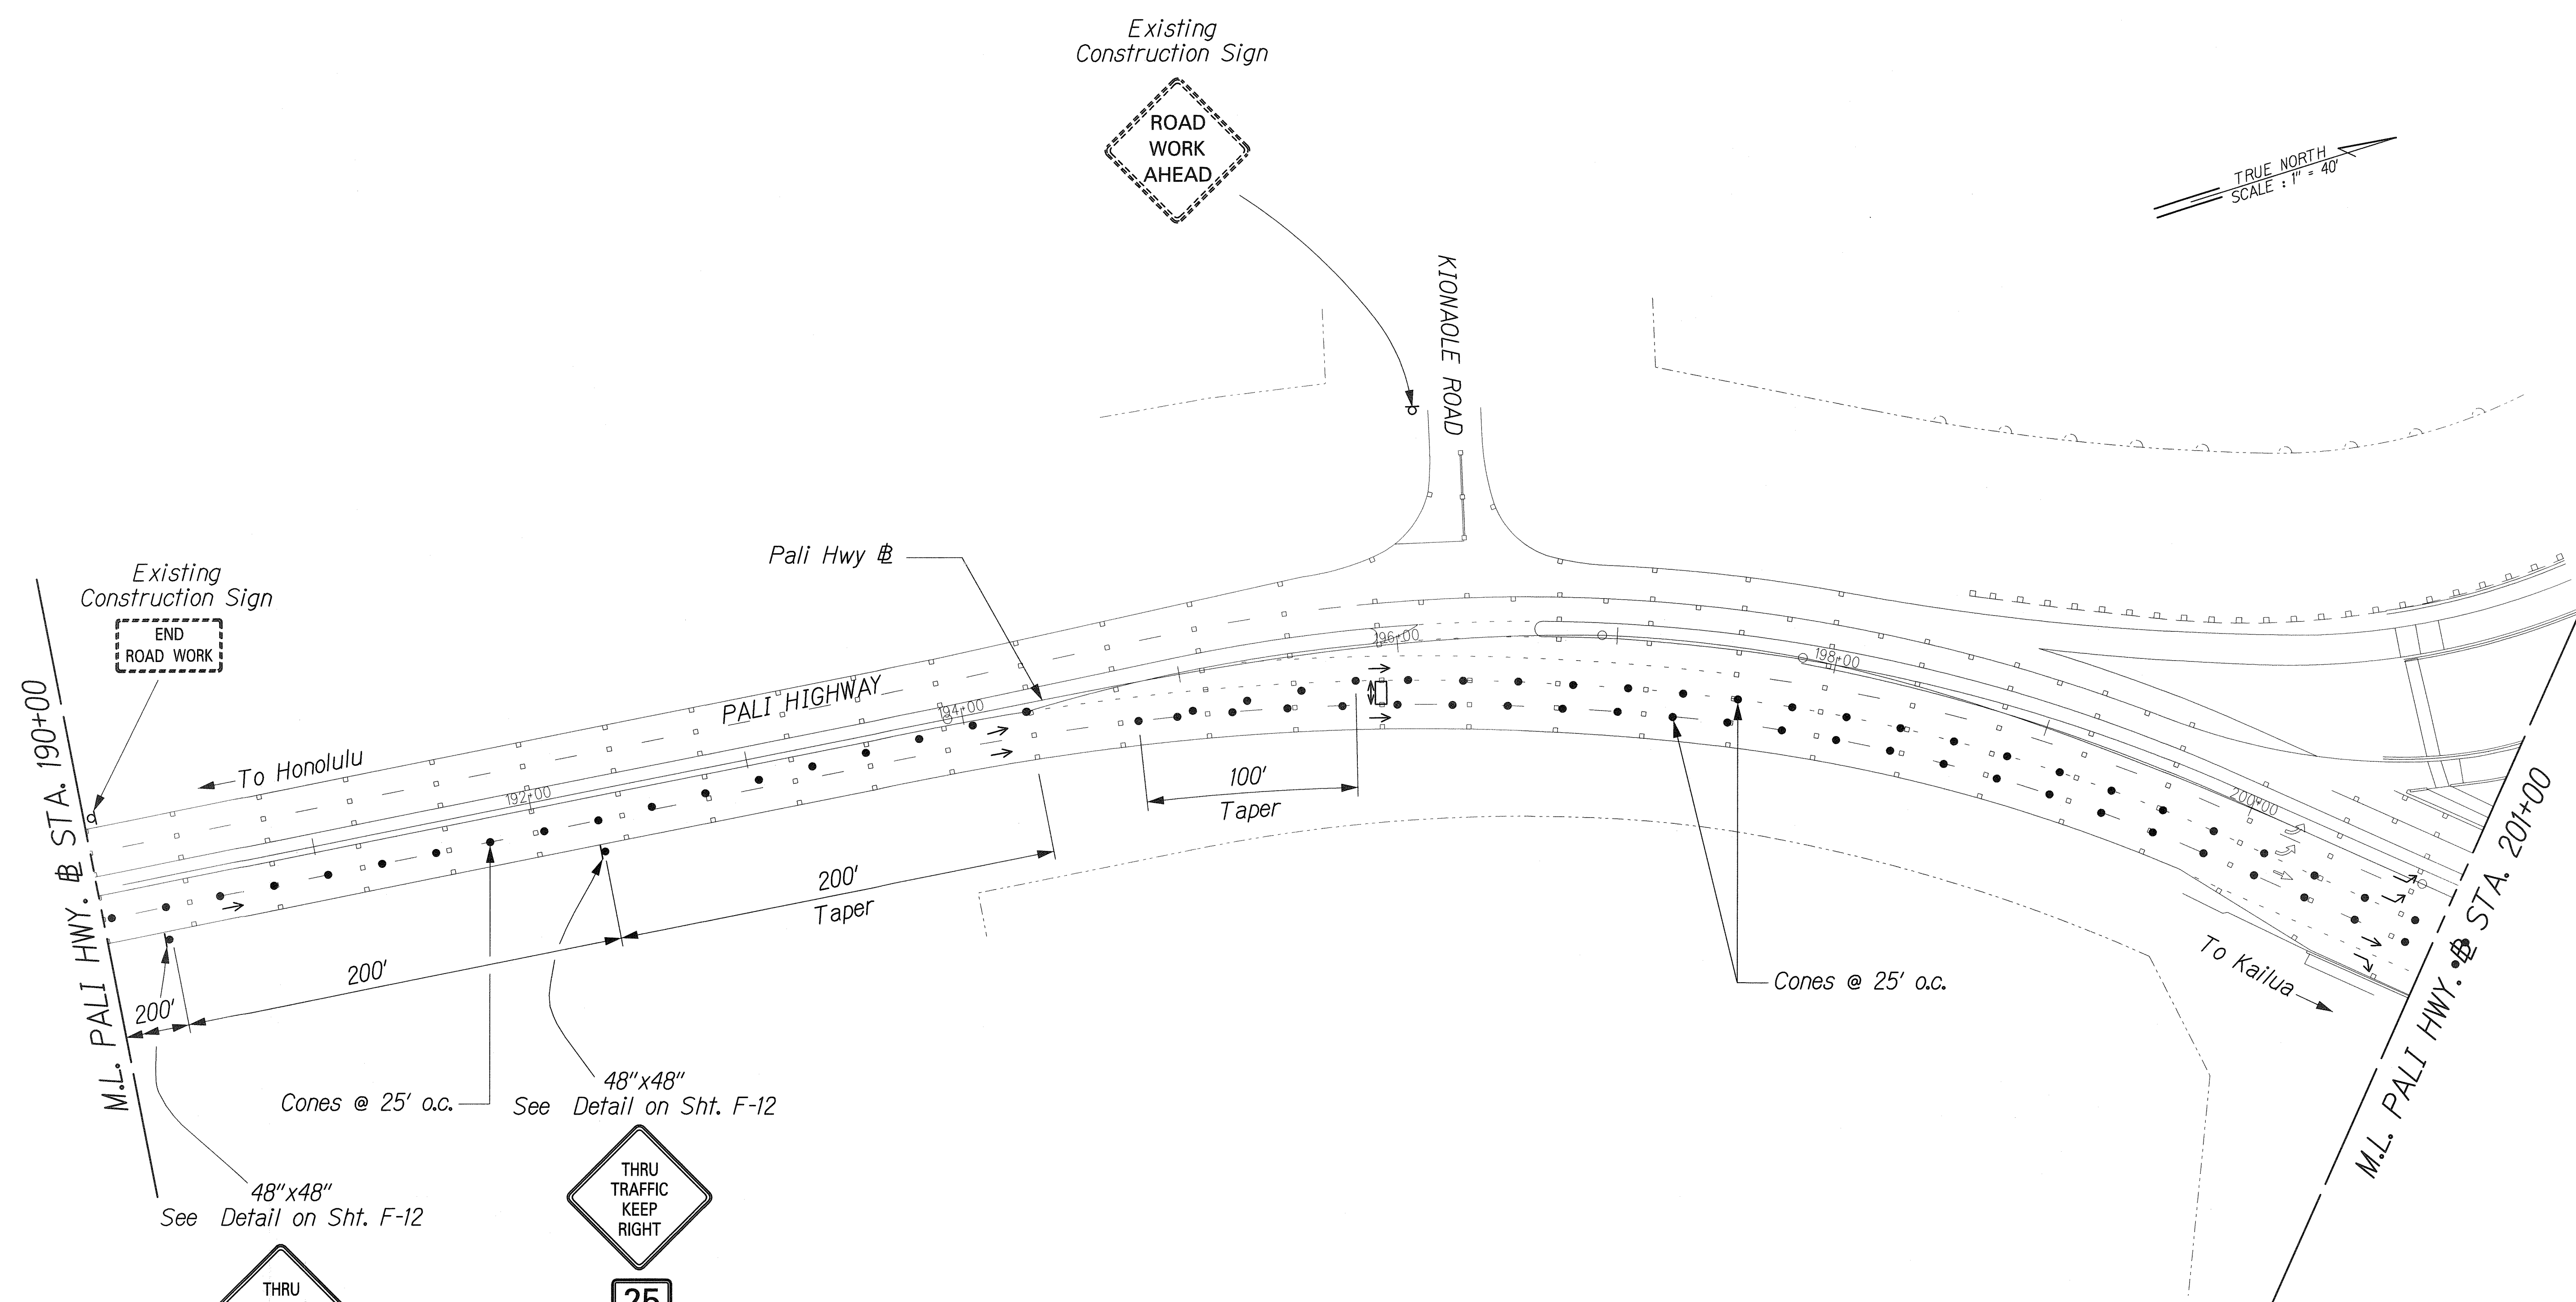

TRUE NORTH
SCALE: 1" = 40'

ORIGINAL PLAN	SURVEY PLOTTED BY	DATE
NOTE BOOK	DRAWN BY	
	DESIGNED BY	
	CHECKED BY	

36 CASTLE JUNCTION/TCP/CF-TCP-Oldgn

48"x48"
See Detail on Sht. F-12

48"x48"
See Detail on Sht. F-12

THRU TRAFFIC KEEP RIGHT

25 M.P.H.

CW13-1(25)-A
24"x24"

THIS WORK WAS PREPARED BY ME OR UNDER MY SUPERVISION.

Randall M. Urakami

STATE OF HAWAII
DEPARTMENT OF TRANSPORTATION
HIGHWAYS DIVISION

CONTRA-FLOW
TRAFFIC CONTROL PLAN
KALANIANA'OLE HIGHWAY

EMERGENCY LANDSLIDE REPAIRS AT CASTLE JUNCTION

PROJECT NO. 61C-01-04# 02-04



Scale: 1" = 40' Date: Sept. 26, 2003

"AS-BUILT"

SHEET No. F-18 OF 20 SHEETS

FED. ROAD DIST. NO.	STATE	PROJ. NO.	FISCAL YEAR	SHEET NO.	TOTAL SHEETS
HAWAII	HAW.	61C-01-04#	2004	90	91

02-04

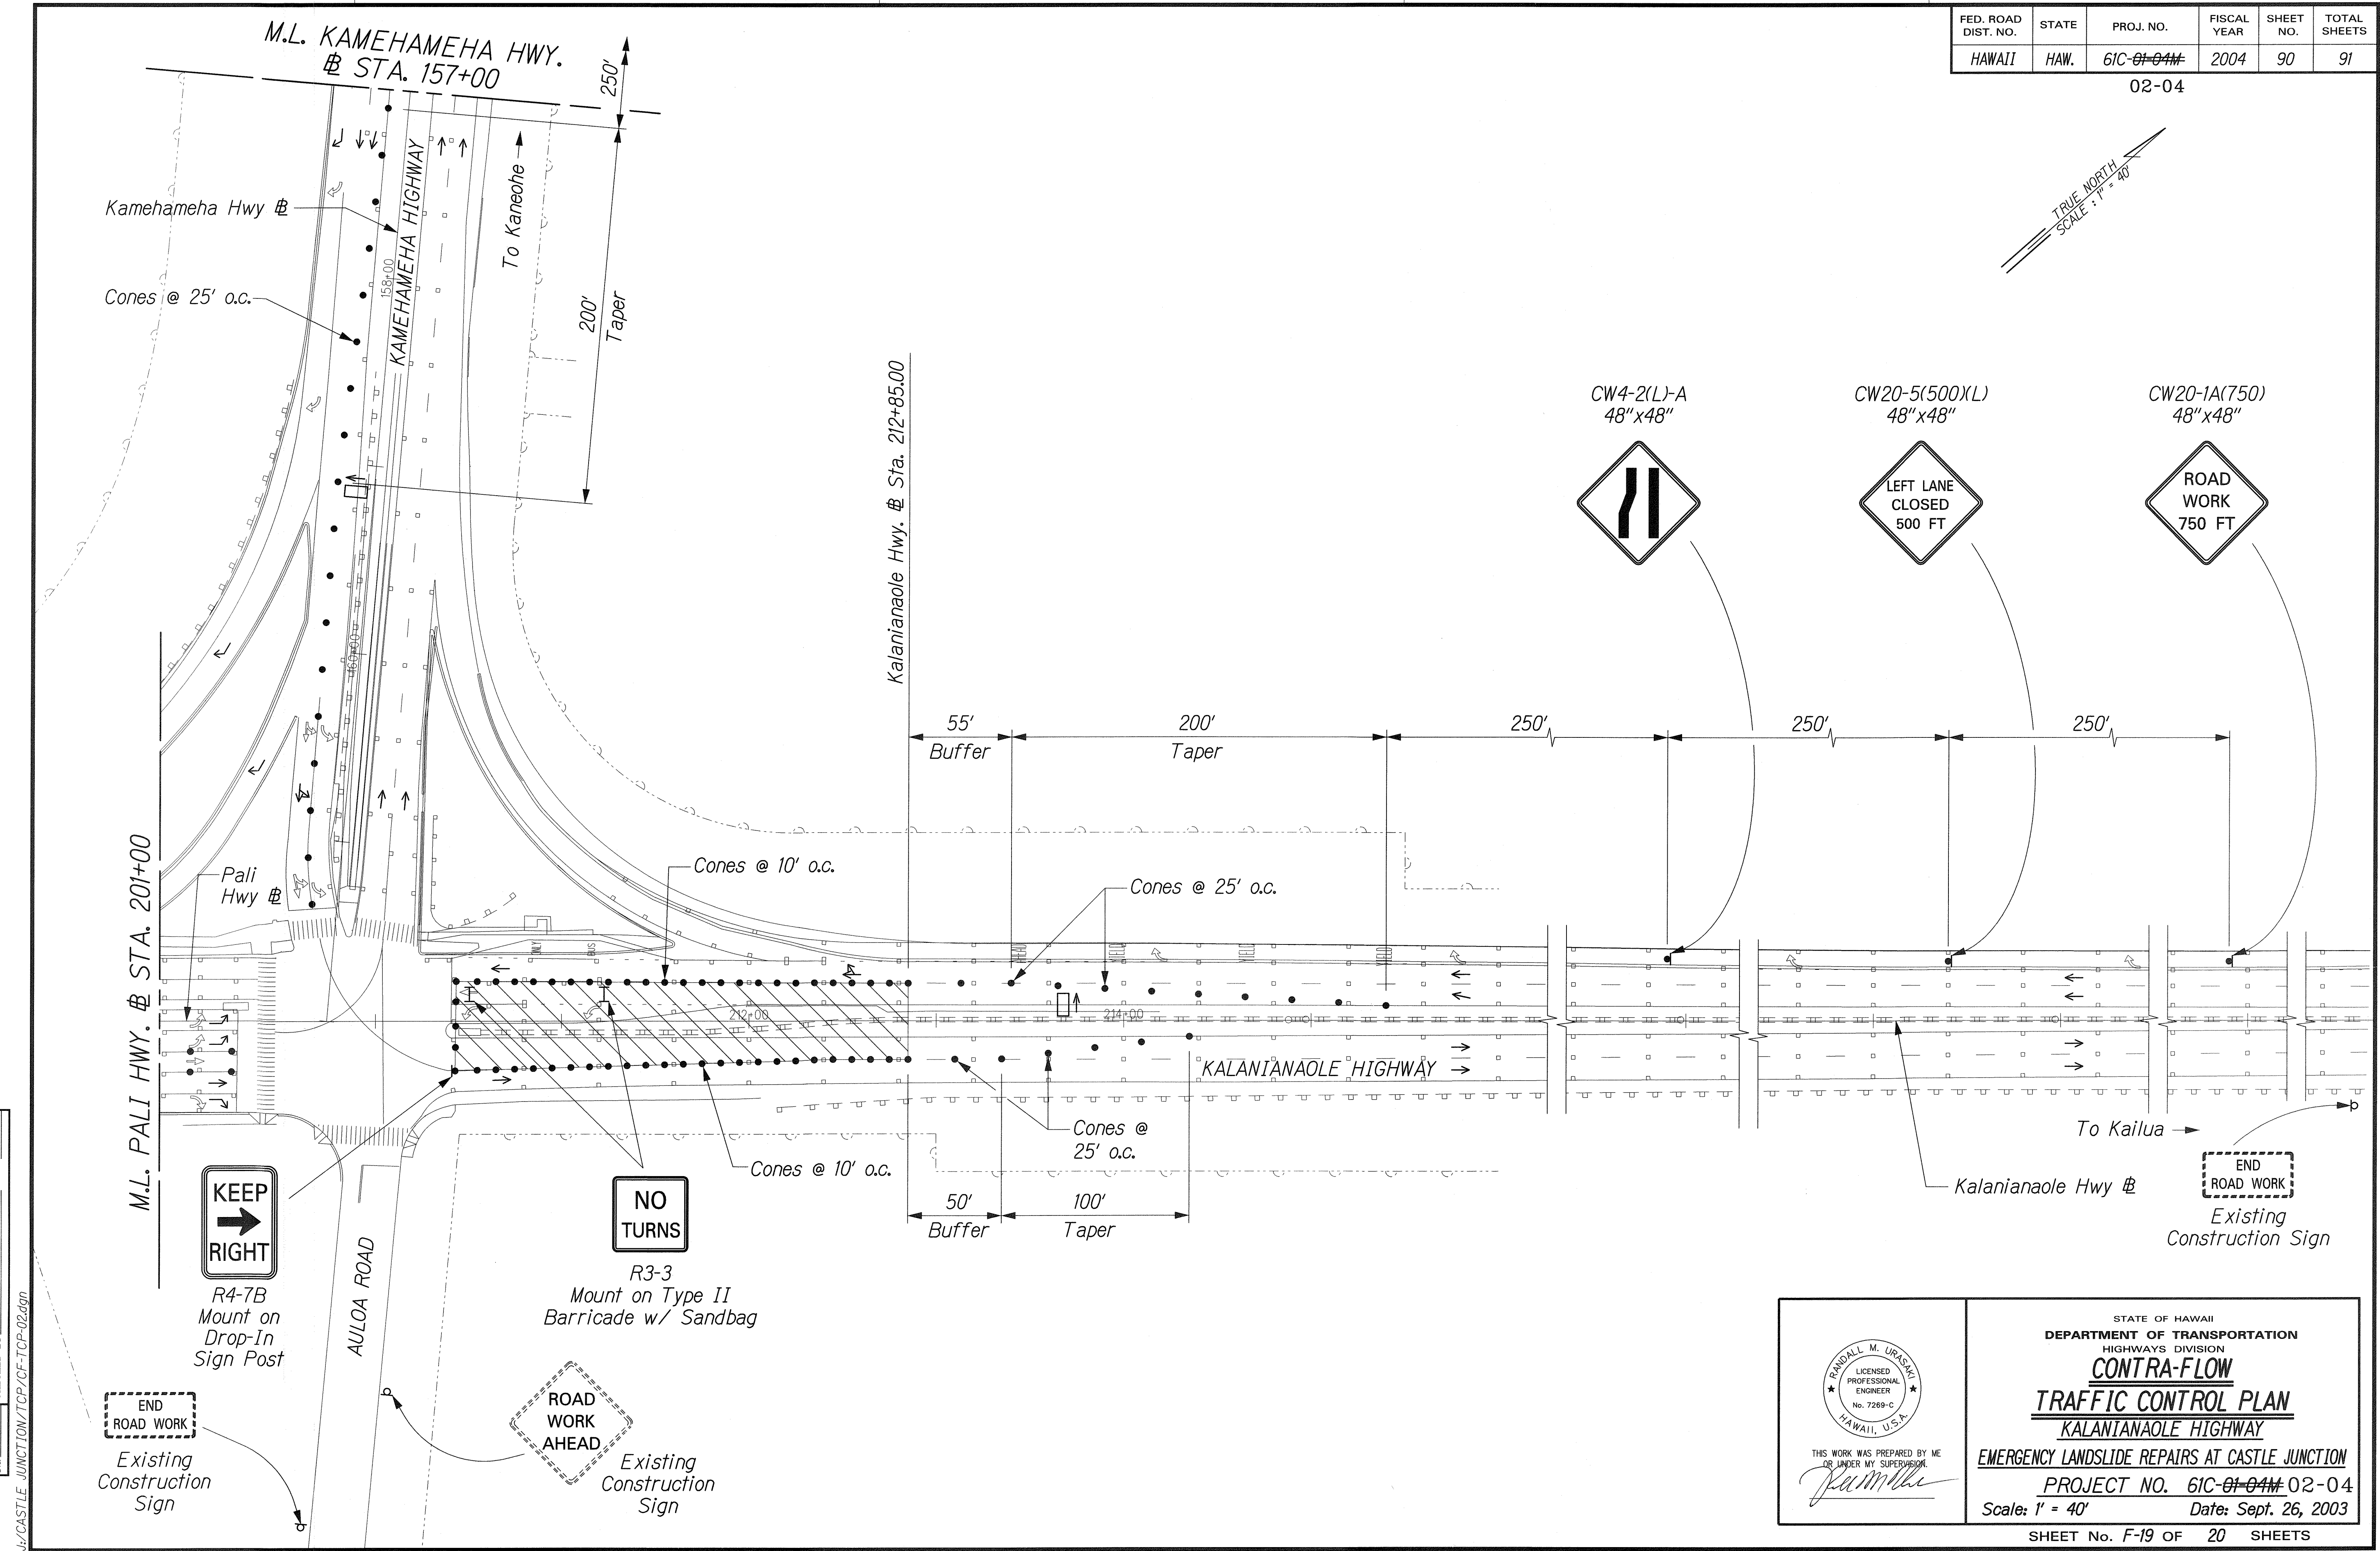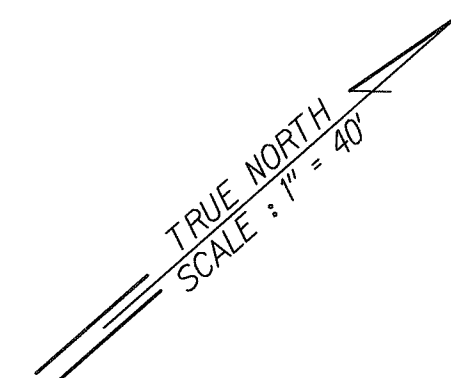

ORIGINAL PLAN	SURVEY PLOTTED BY	DATE
NOTE BOOK	DRAWN BY	
	DESIGNED BY	
	CHECKED BY	

1/4 CASTLE JUNCTION/TCP/02-04

THIS WORK WAS PREPARED BY ME OR UNDER MY SUPERVISION.

R. Urashima

STATE OF HAWAII
DEPARTMENT OF TRANSPORTATION
HIGHWAYS DIVISION

CONTRA-FLOW
TRAFFIC CONTROL PLAN
KALANIANA'OLE HIGHWAY



EMERGENCY LANDSLIDE REPAIRS AT CASTLE JUNCTION

PROJECT NO. 61C-01-04# 02-04

Scale: 1" = 40' Date: Sept. 26, 2003

FED. ROAD DIST. NO.	STATE	PROJ. NO.	FISCAL YEAR	SHEET NO.	TOTAL SHEETS
HAWAII	HAW.	61C-01-04#	2004	91	91

02-04

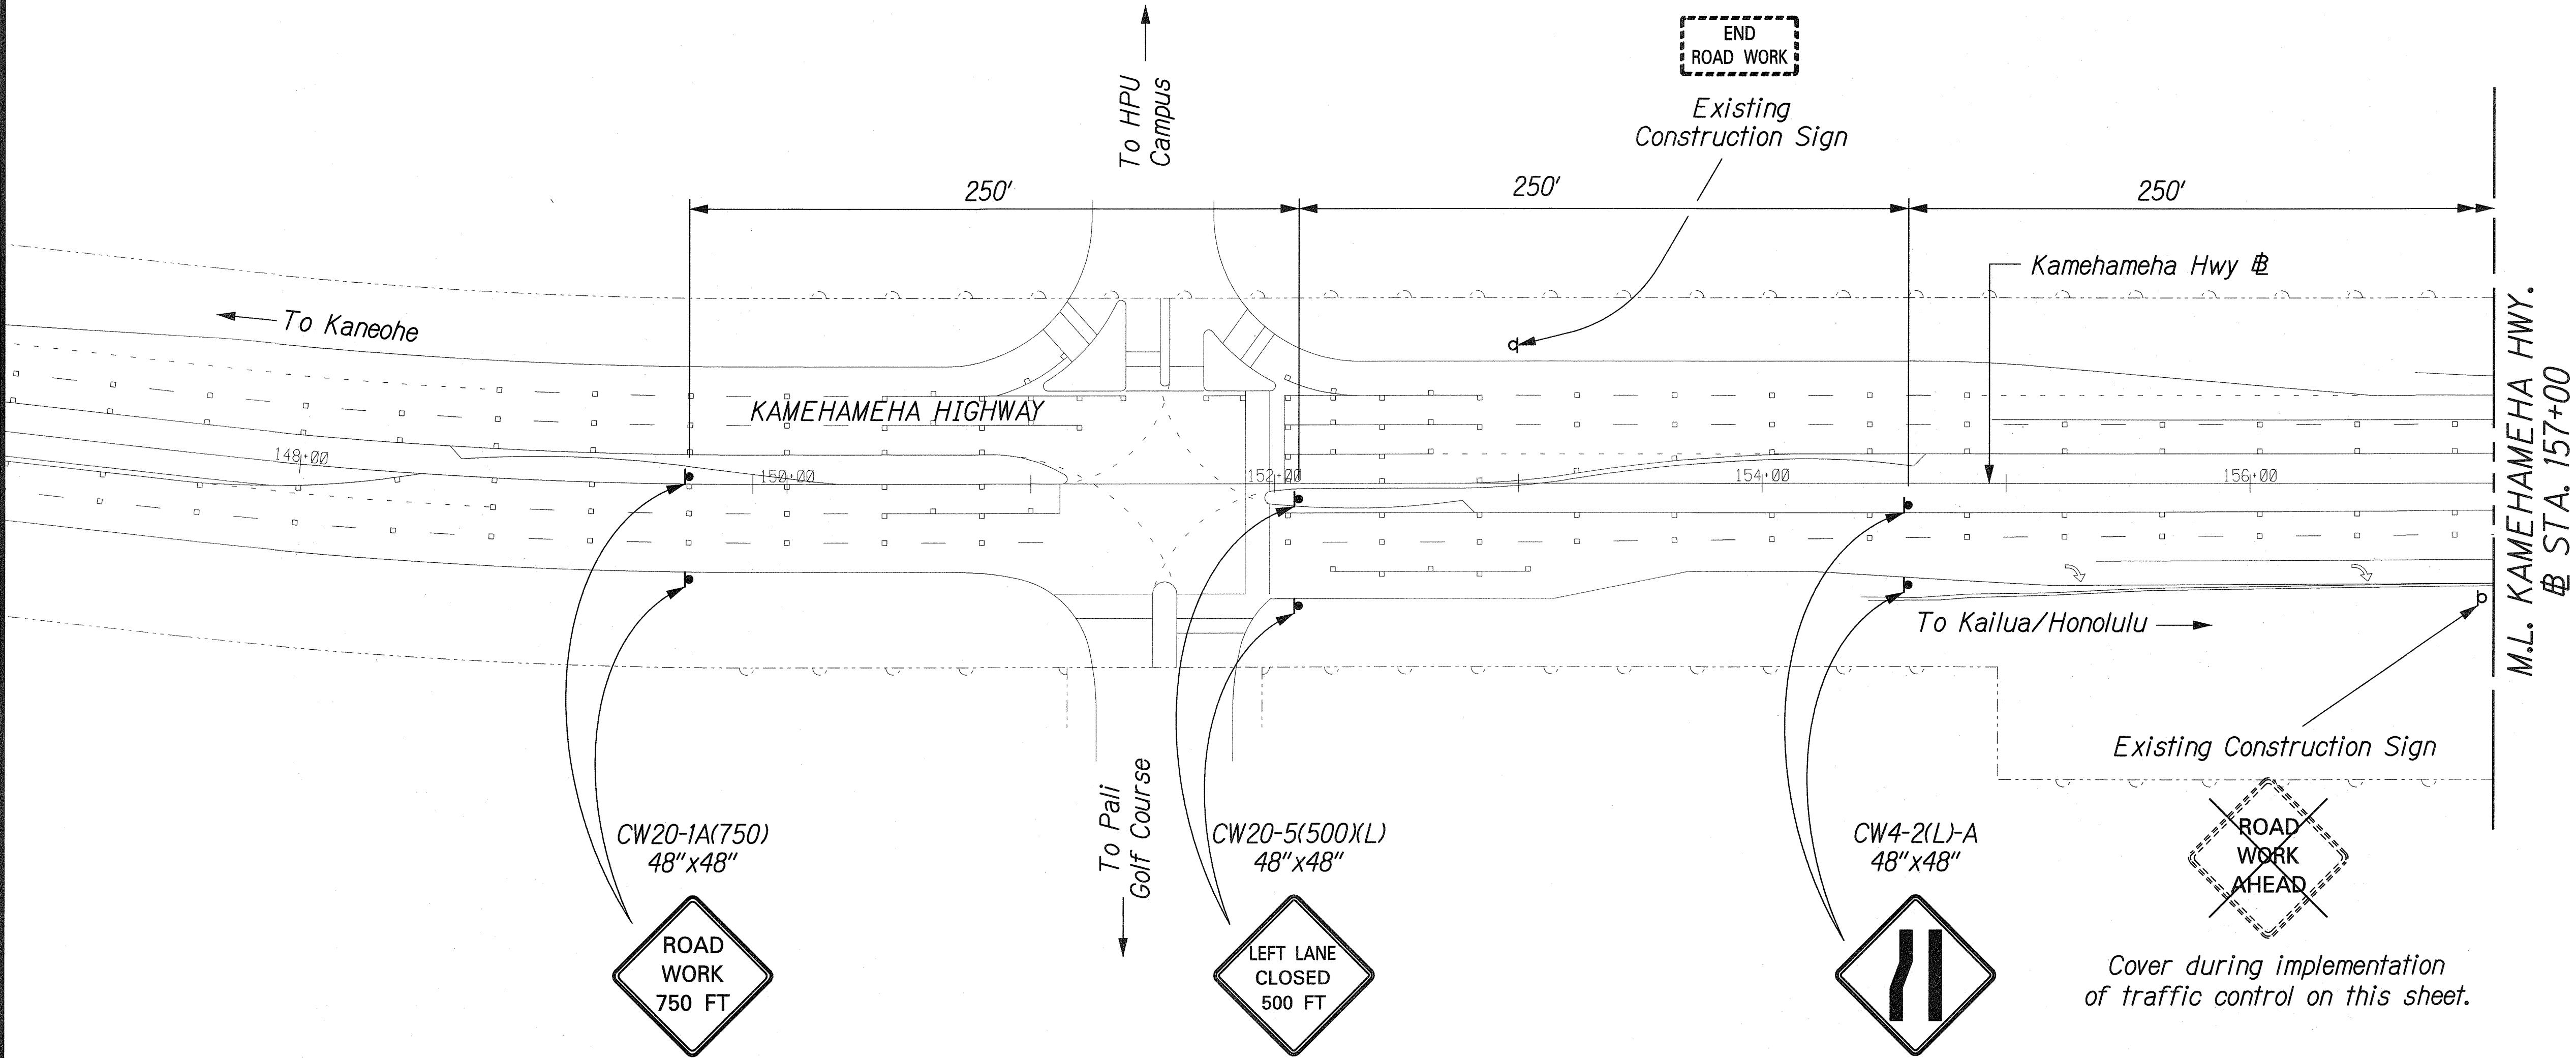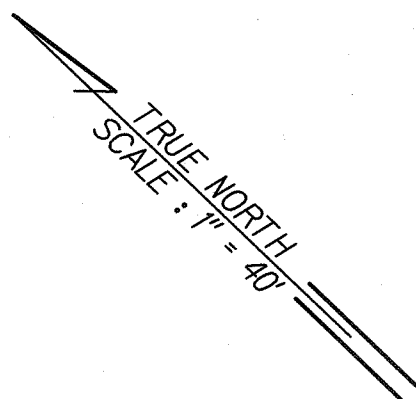

ORIGINAL PLAN	SURVEY PLOTTED BY	DATE
NOTE BOOK	DRAWN BY	
	DESIGNED BY	
	CHECKED BY	

1/2 CASTLE JUNCTION/TCP/CF-TCP-03.dgn

THIS WORK WAS PREPARED BY ME OR UNDER MY SUPERVISION.
Rum Urasaku

STATE OF HAWAII
DEPARTMENT OF TRANSPORTATION
HIGHWAYS DIVISION
CONTRA-FLOW
TRAFFIC CONTROL PLAN
KALANIANA'OLE HIGHWAY
EMERGENCY LANDSLIDE REPAIRS AT CASTLE JUNCTION
PROJECT NO. 61C-01-04# 02-04
Scale: 1" = 40' Date: Sept. 26, 2003