


FED. ROAD DIST. NO.	STATE	PROJ. NO.	FISCAL YEAR	SHEET NO.	TOTAL SHEETS
HAWAII	HAW.	61C- <del>01-04</del>	2004	72	91

02-04

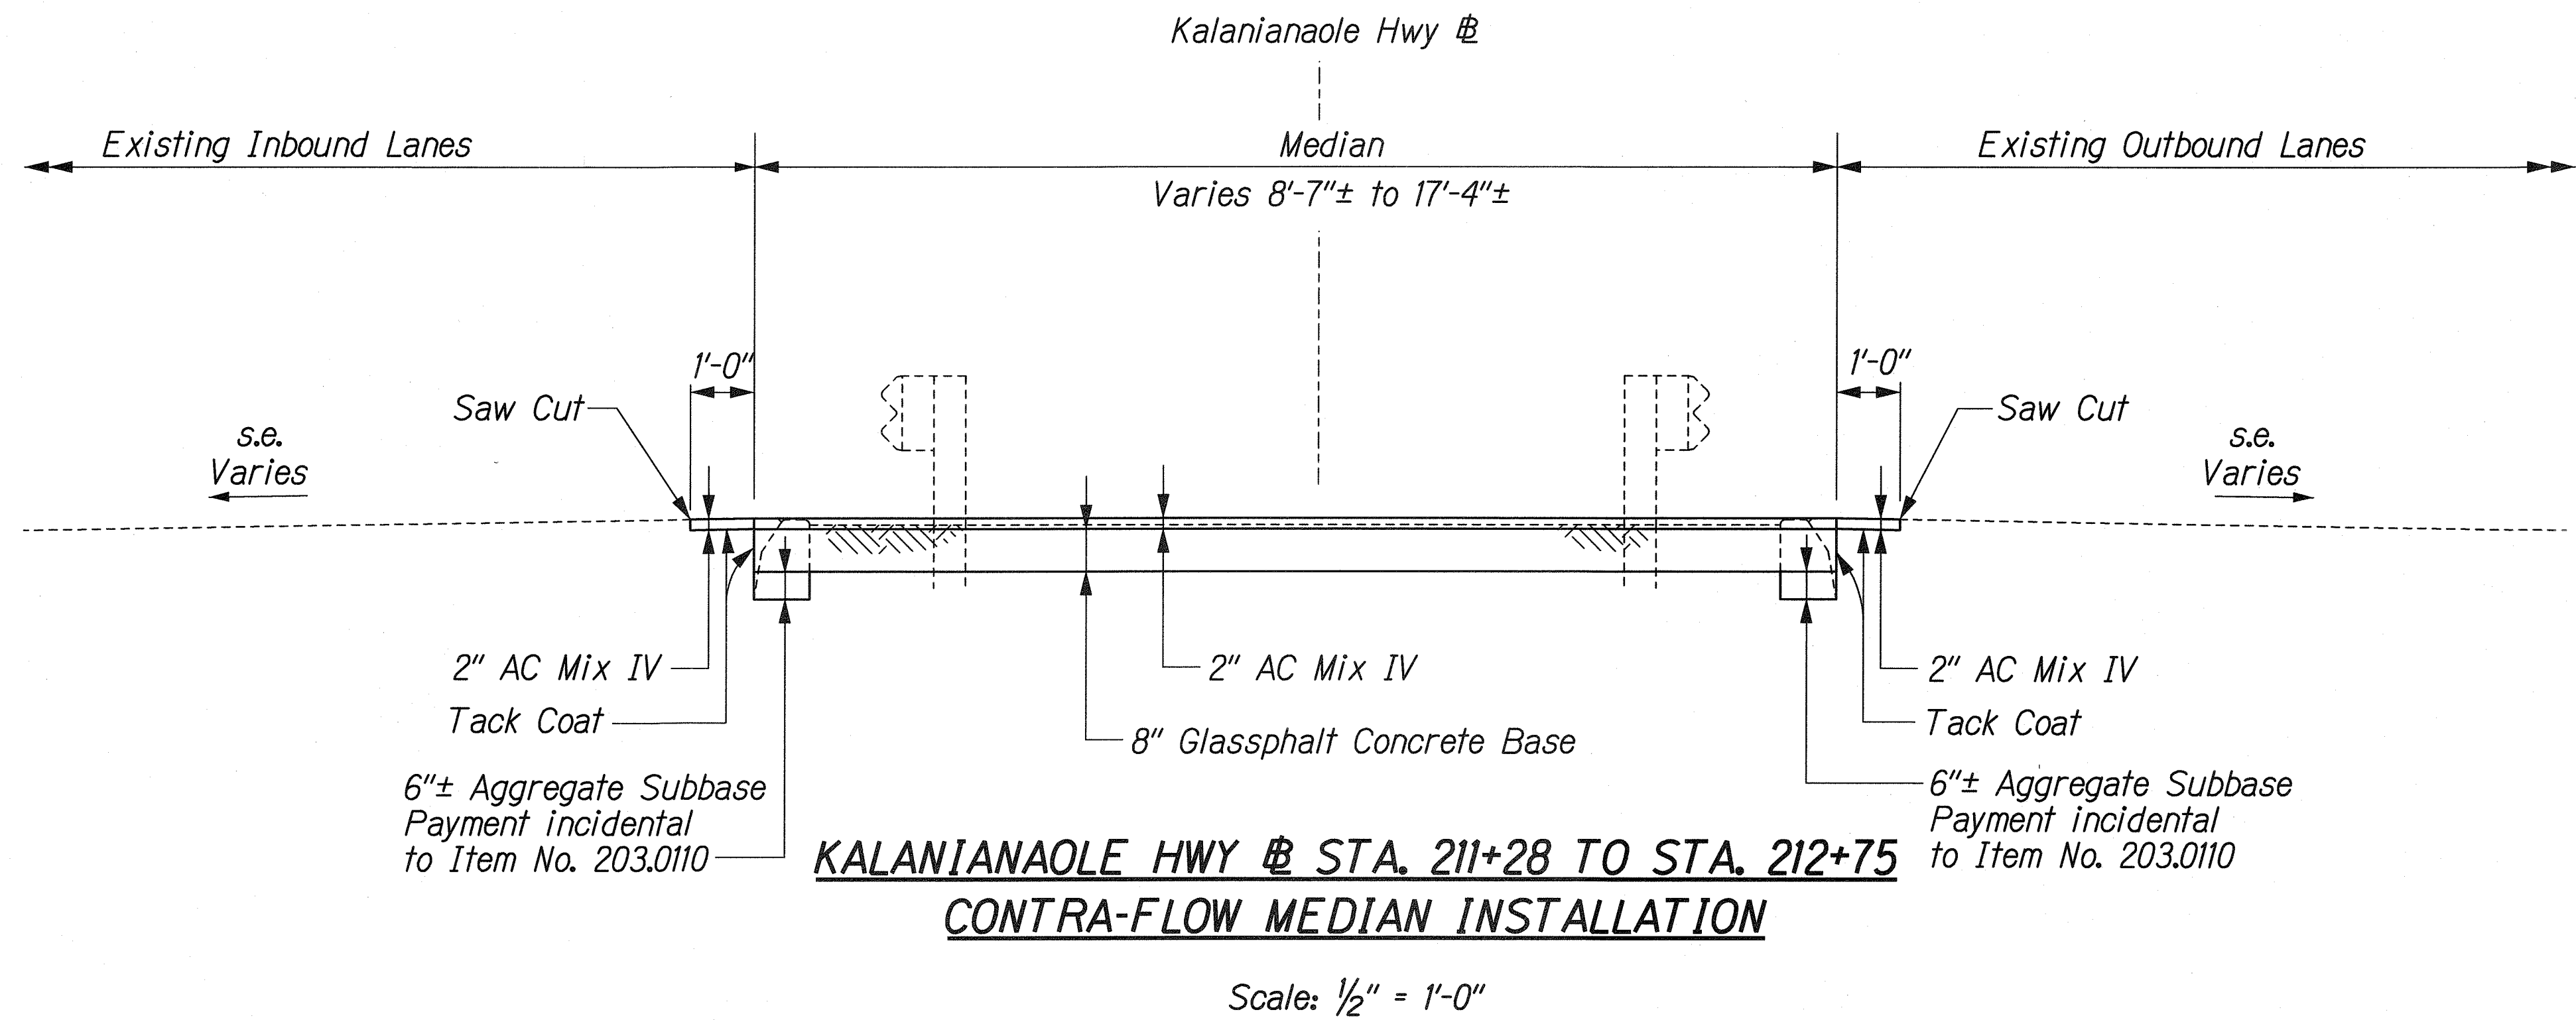

ORIGINAL PLAN	SURVEY PLOTTED BY	DATE
NOTE BOOK	DRAWN BY	
	DESIGNED BY	
	CHECKED BY	

J:\CASTLE JUNCTION\CONTRA-FLOW\TYPSEC.dgn

THIS WORK WAS PREPARED BY ME  
OR UNDER MY SUPERVISION.

*R. Urakami*

STATE OF HAWAII  
DEPARTMENT OF TRANSPORTATION  
HIGHWAYS DIVISION

**CONTRA-FLOW  
TYPICAL SECTIONS**

**KALANIANA'OLE HIGHWAY**

**EMERGENCY LANDSLIDE REPAIRS AT CASTLE JUNCTION**

PROJECT NO. 61C-~~01-04~~ 02-04

Scale: 1/2" = 1'-0" Date: Sept. 26, 2003

SHEET No. F-1 OF 20 SHEETS

"AS-BUILT"