


FED. ROAD DIST. NO.	STATE	PROJ. NO.	FISCAL YEAR	SHEET NO.	TOTAL SHEETS
HAWAII	HAW.	61C- 01-04	2004	55	91

02-04

TRUE NORTH
SCALE: 1" = 40'

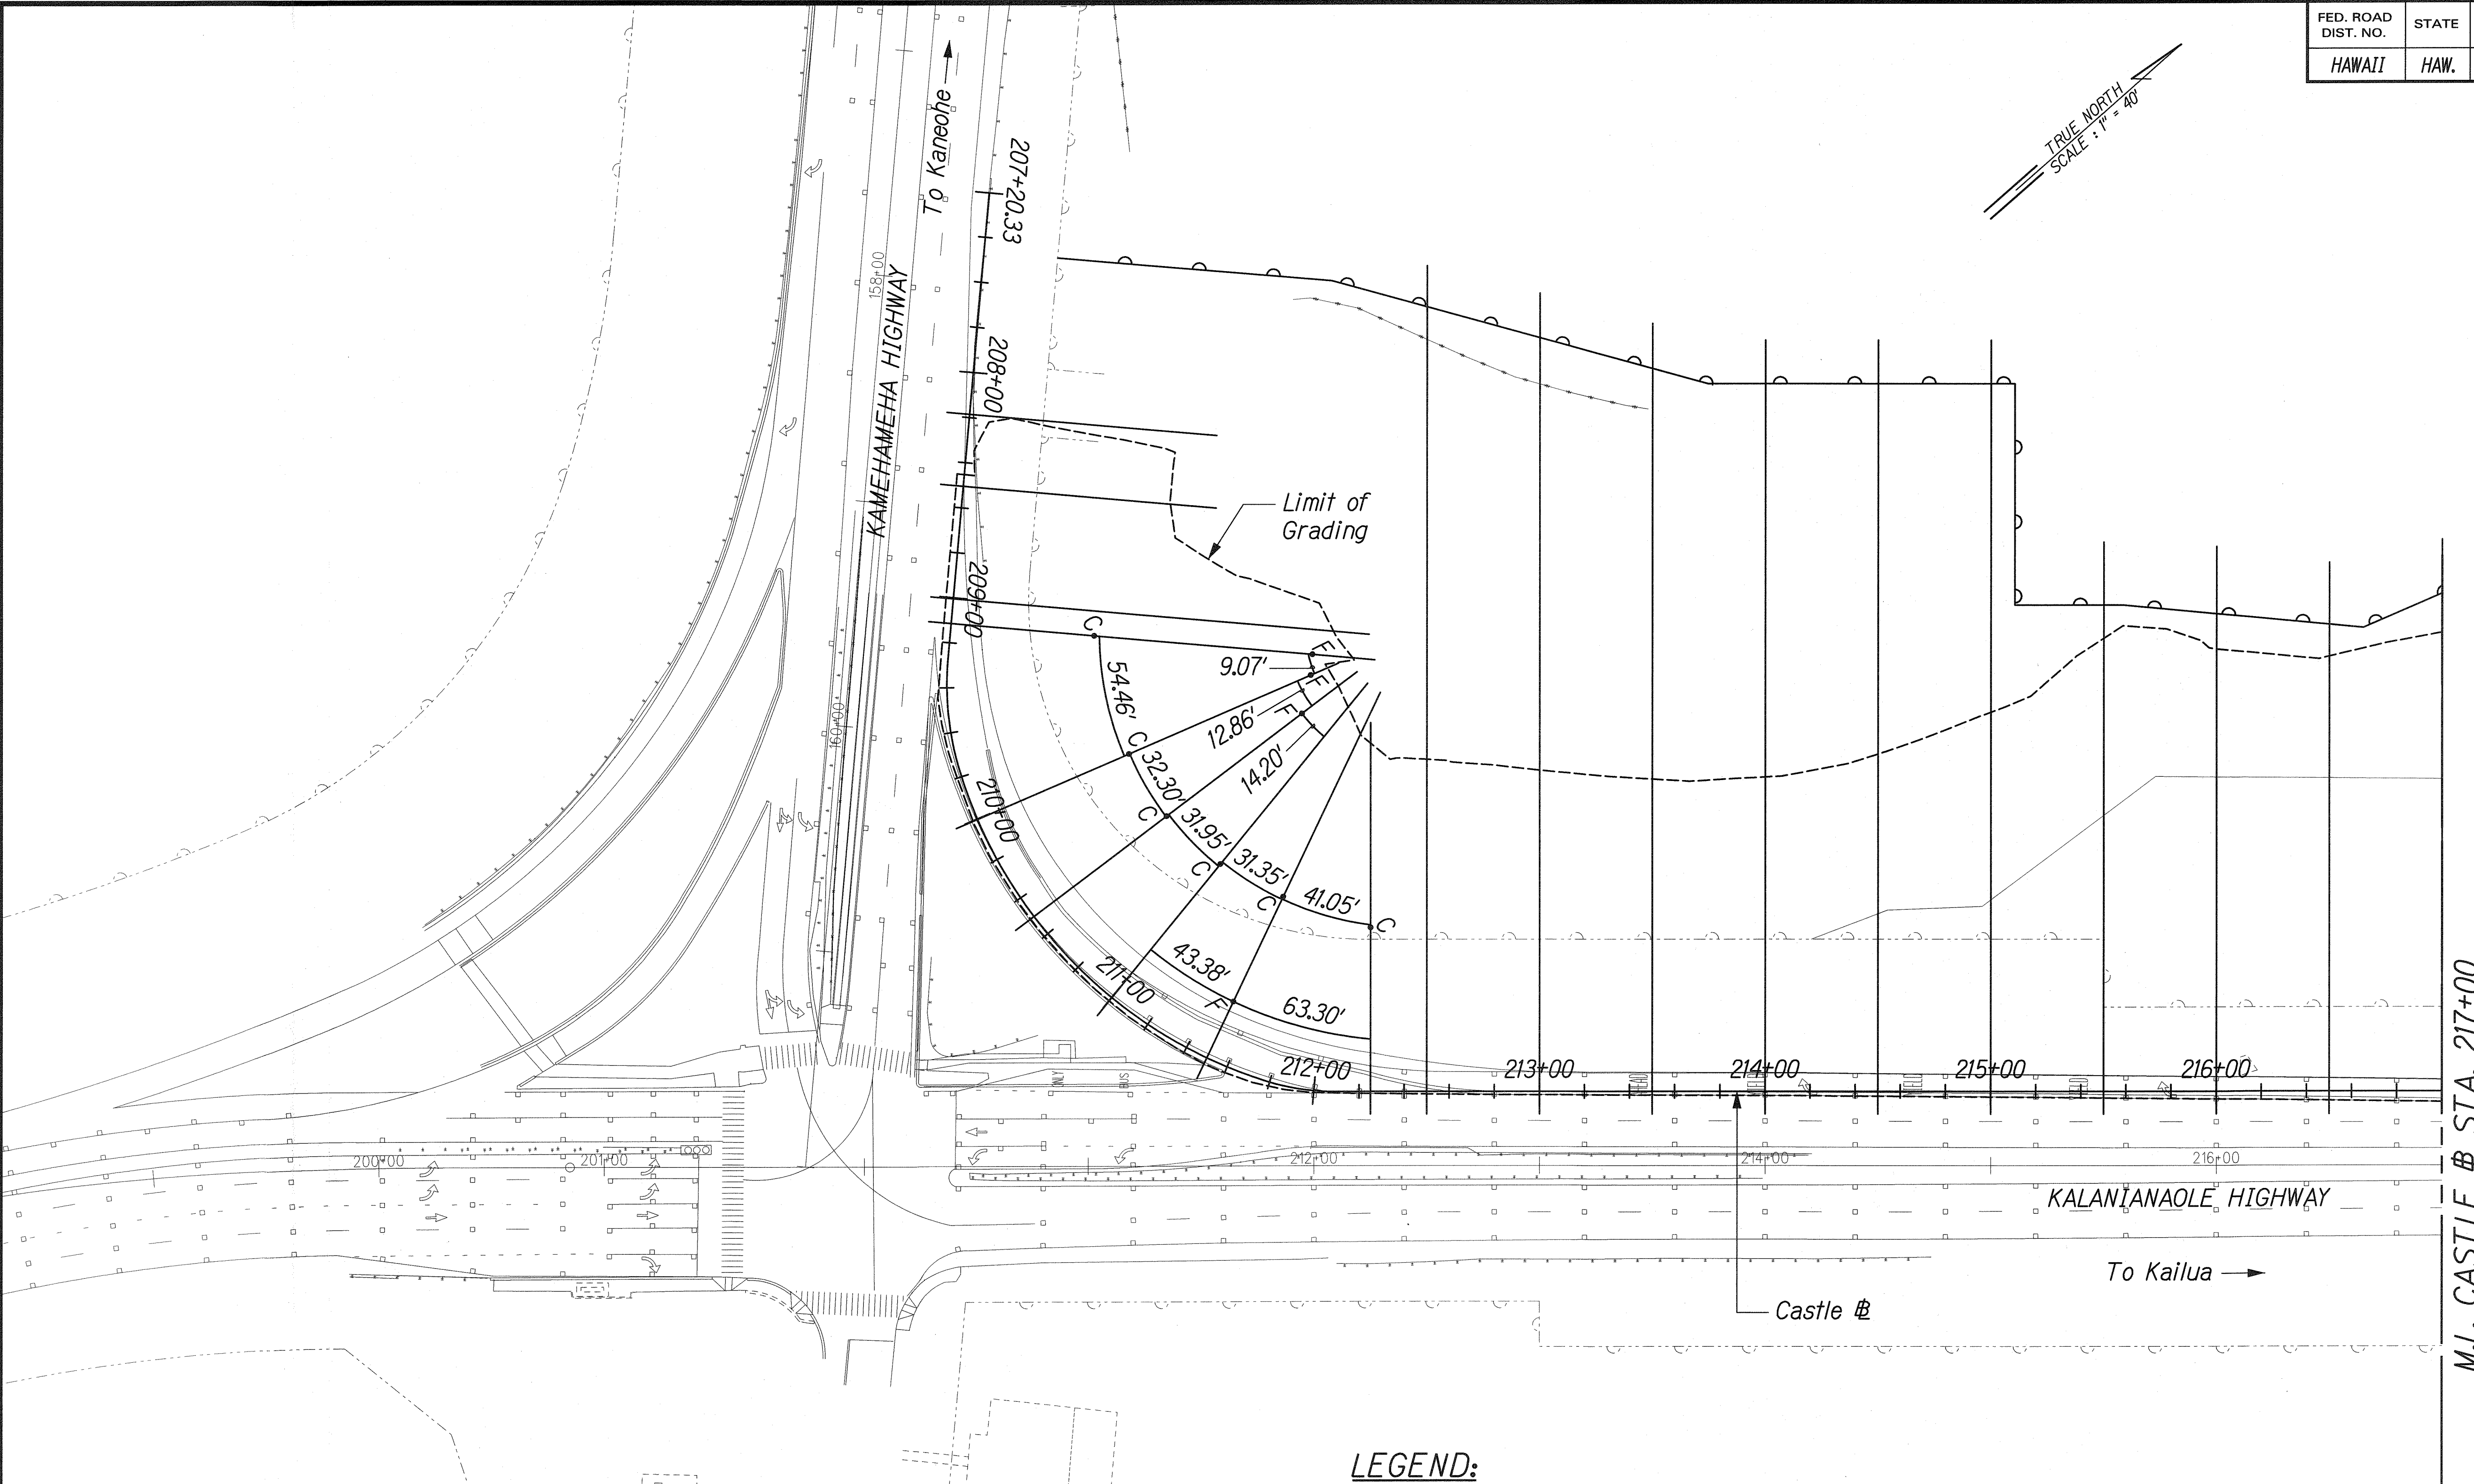

LEGEND:

- C Centroid of Cut Area
- F Centroid of Fill Area

DESIGNED BY	DATE
DRAWN BY	
CHECKED BY	
NOTED BY	
QUANTITIES BY	
DATE	

JK CASTLE JUNCTION/MISC/XKEY-01.dgn

THIS WORK WAS PREPARED BY ME OR UNDER MY SUPERVISION.

R. M. Urasak

STATE OF HAWAII
DEPARTMENT OF TRANSPORTATION
HIGHWAYS DIVISION

CROSS SECTION KEY PLAN

KALANIANA'OLE HIGHWAY
EMERGENCY LANDSLIDE REPAIRS AT CASTLE JUNCTION

PROJECT NO. 61C-~~01-04~~ 02-04
Scale: 1" = 40' Date: Sept. 26, 2003


SHEET No. X-1 OF 17 SHEETS

"AS-BUILT"

FED. ROAD DIST. NO.	STATE	PROJ. NO.	FISCAL YEAR	SHEET NO.	TOTAL SHEETS
HAWAII	HAW.	61C-01-04#	2004	56	91

02-04

TRUE NORTH
SCALE: 1" = 40'

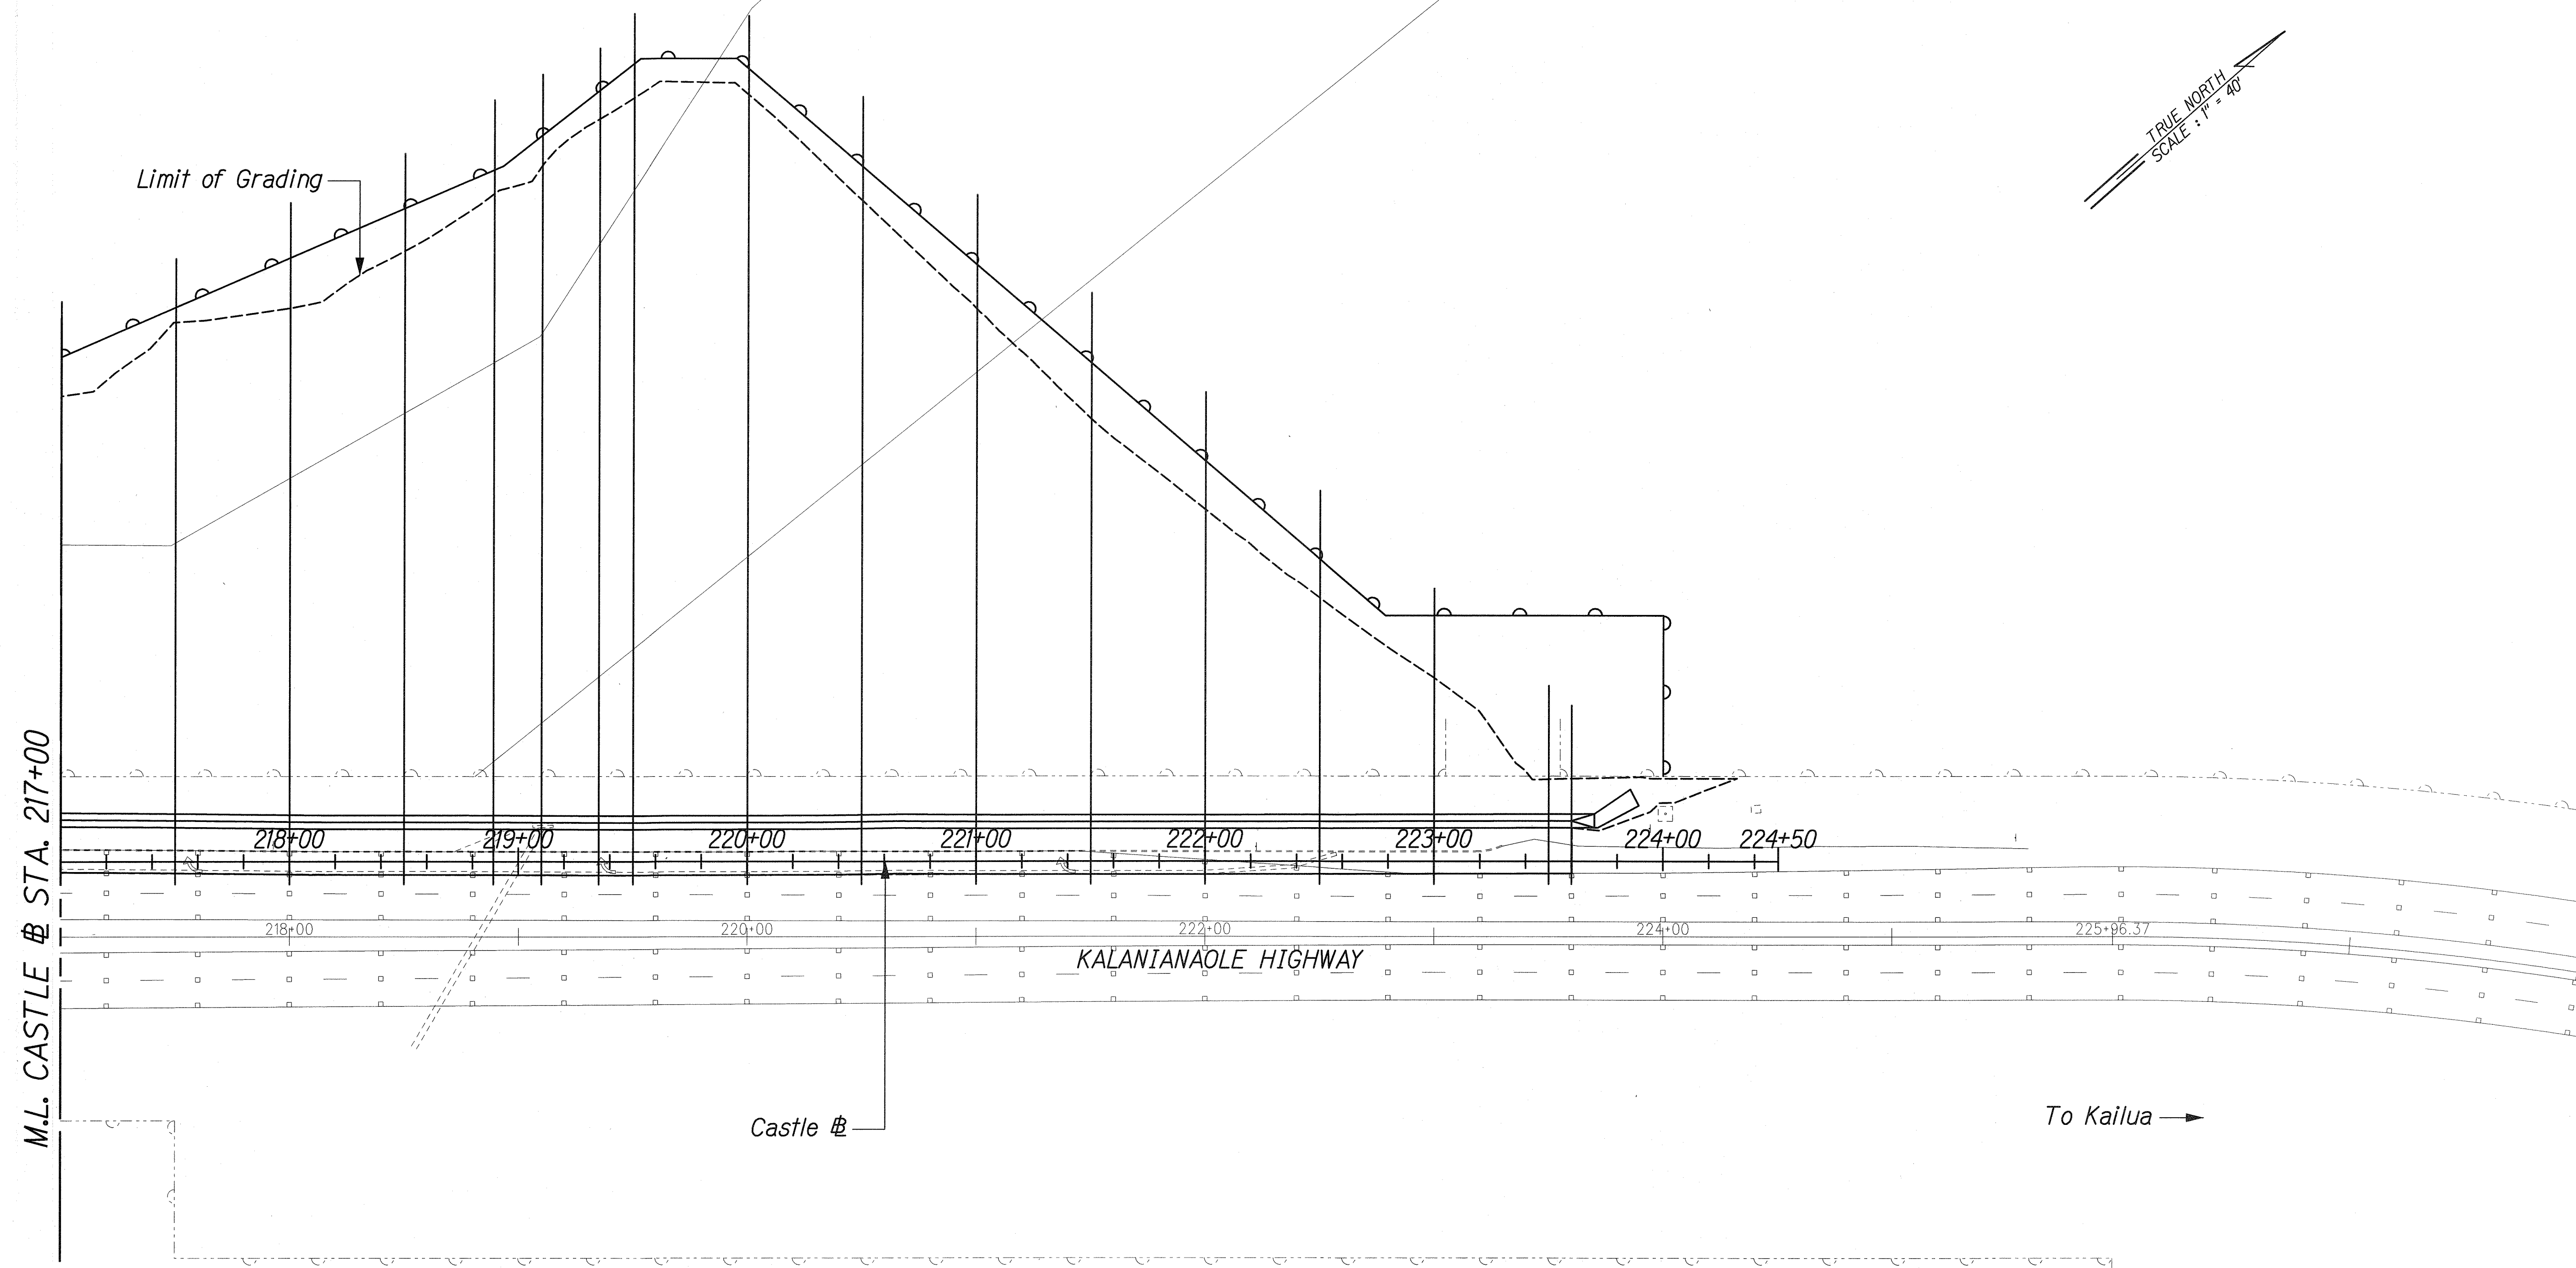

ORIGINAL PLAN	SURVEY PLOTTED BY	DATE
NOTE BOOK	DRAWN BY	
	DESIGNED BY	
	CHECKED BY	

J:\CASTLE JUNCTION\MISC\KEY-02.dgn

THIS WORK WAS PREPARED BY ME OR UNDER MY SUPERVISION.

R. Urayama

STATE OF HAWAII
DEPARTMENT OF TRANSPORTATION
HIGHWAYS DIVISION

CROSS SECTION KEY PLAN

KALANIANA'OLE HIGHWAY
EMERGENCY LANDSLIDE REPAIRS AT CASTLE JUNCTION

PROJECT NO. 61C-01-04# 02-04
Date: Sept. 26, 2003

Scale: 1" = 40'

SHEET No. X-2 OF 17 SHEETS

"AS-BUILT"