


FED. ROAD DIST. NO.	STATE	PROJ. NO.	FISCAL YEAR	SHEET NO.	TOTAL SHEETS
HAWAII	HAW.	61C- 01-04 02-04	2004	27	91


02-04

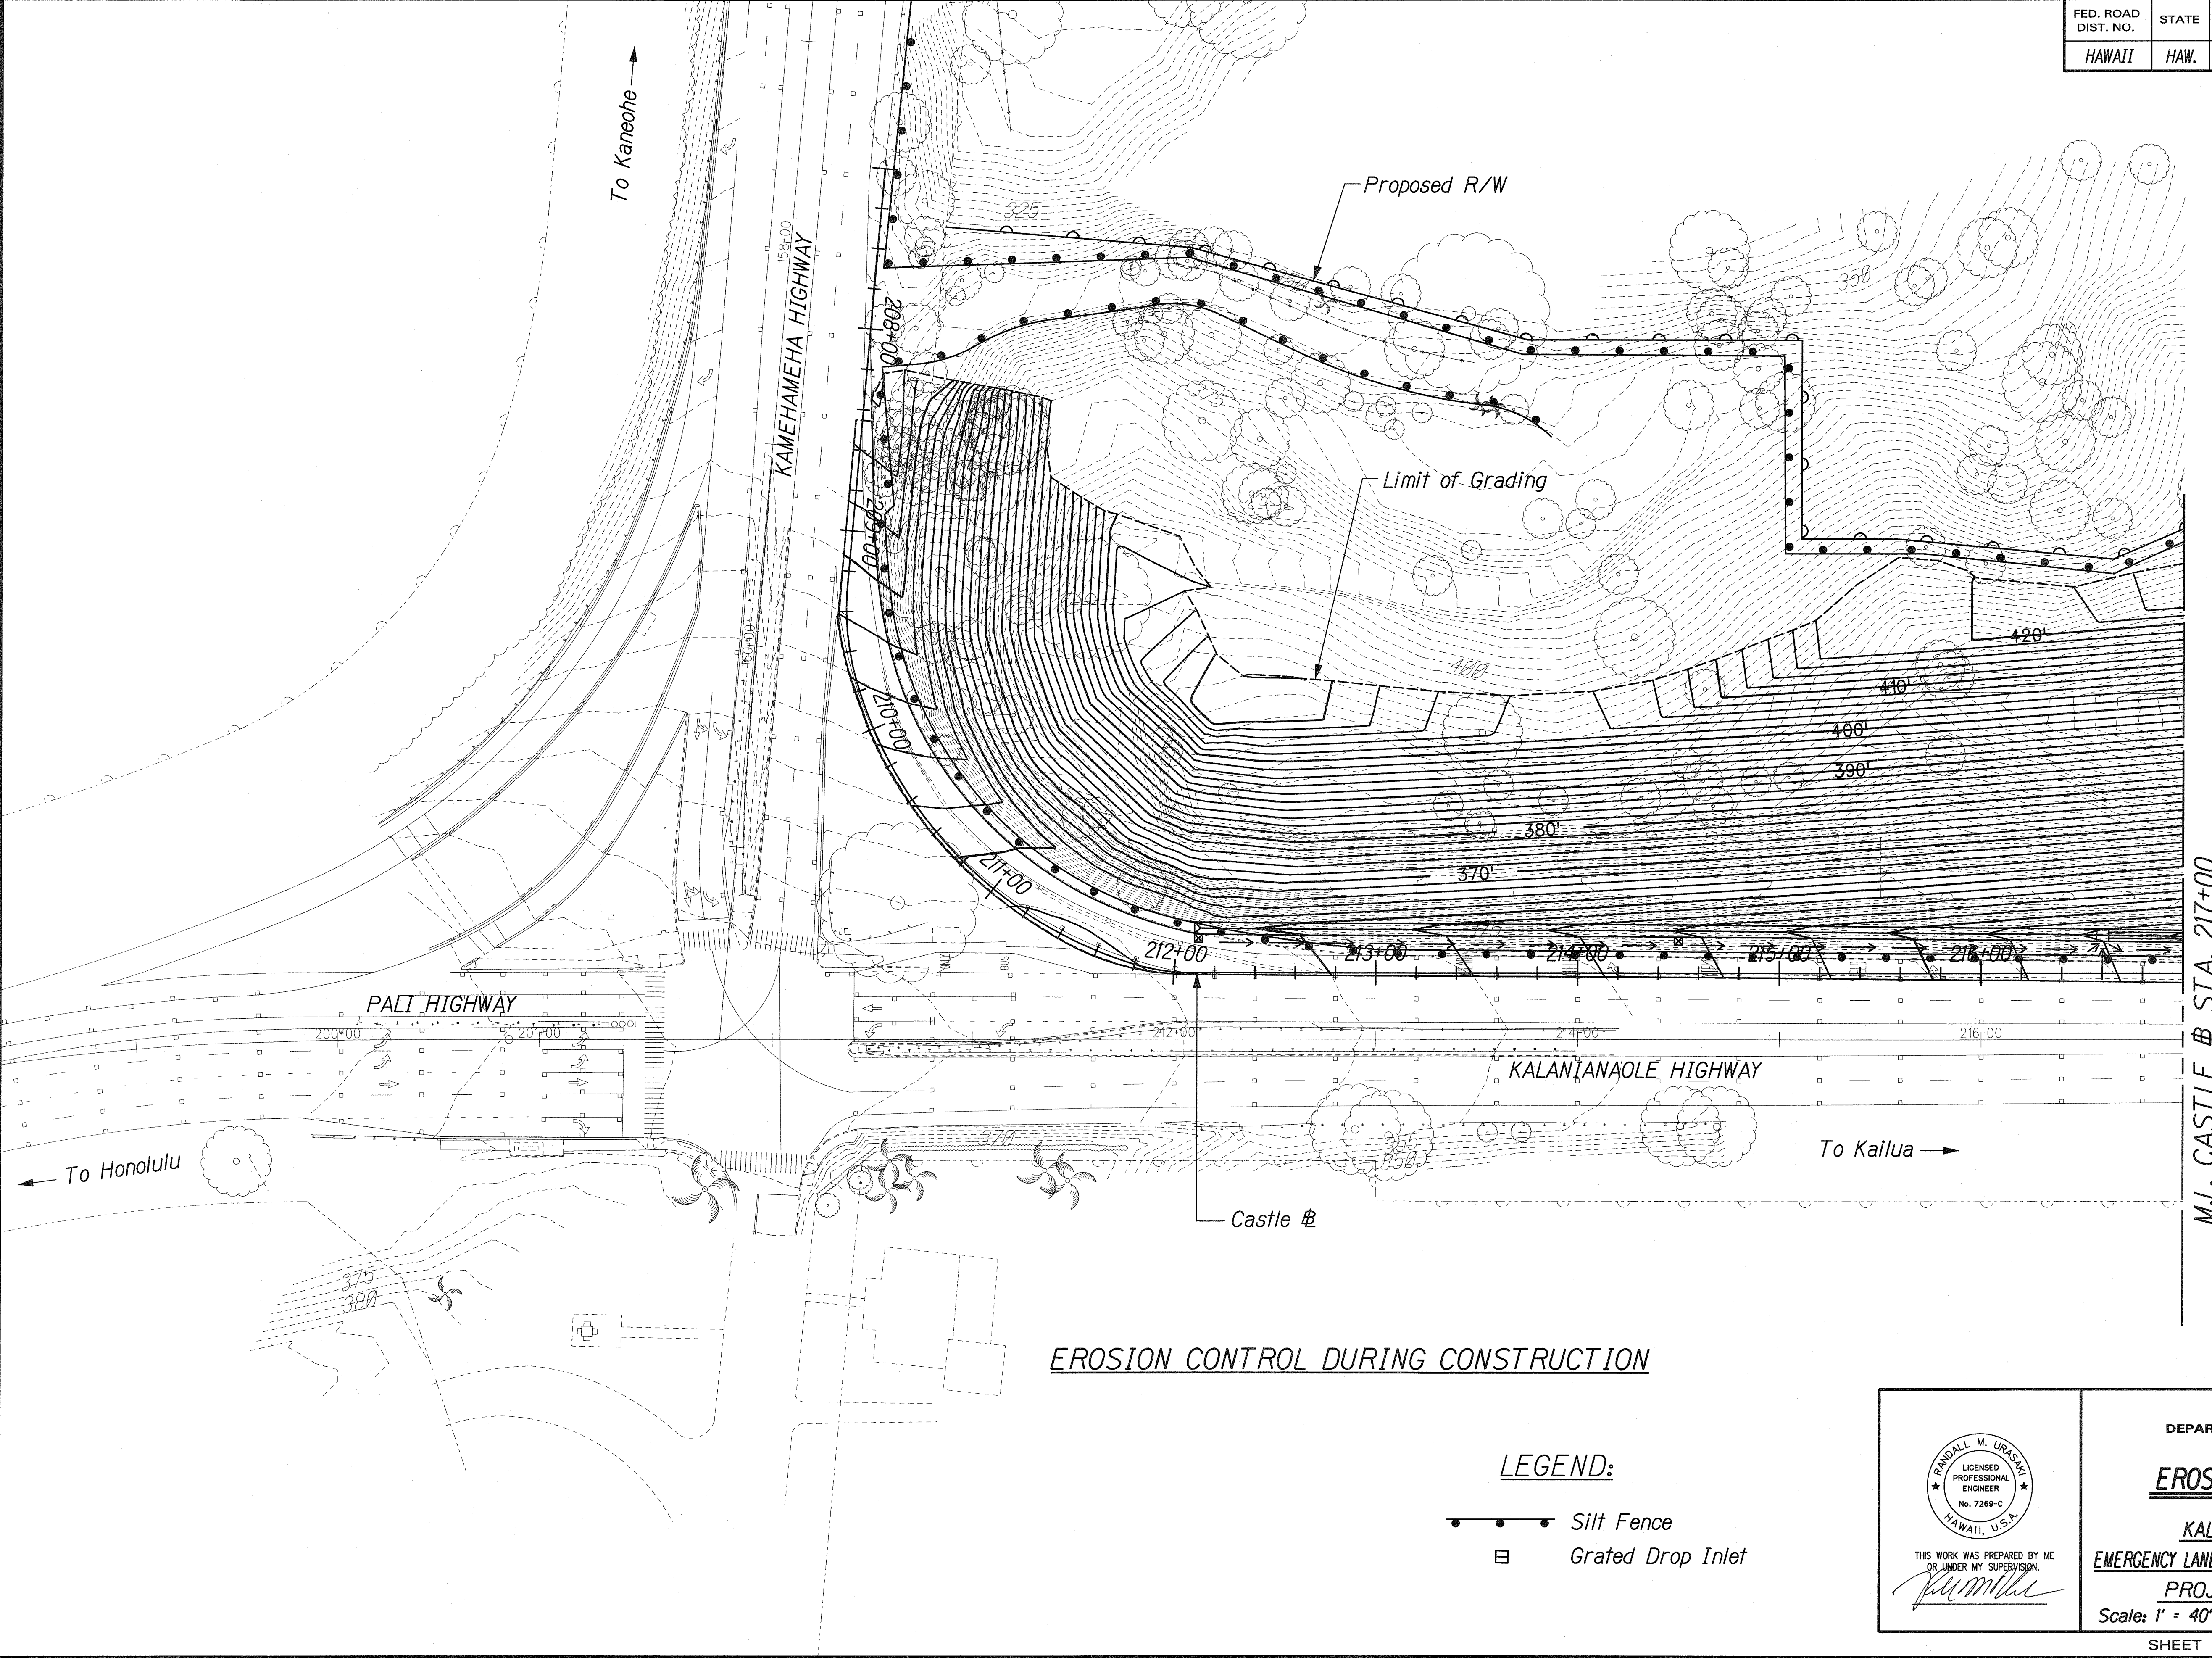

EROSION CONTROL DURING CONSTRUCTION

LEGEND:

- Silt Fence
- Grated Drop Inlet

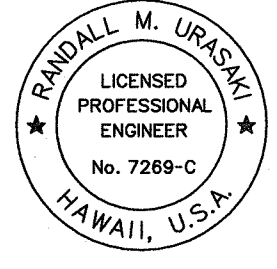

THIS WORK WAS PREPARED BY ME
OR UNDER MY SUPERVISION.

R. Urasaki

STATE OF HAWAII
DEPARTMENT OF TRANSPORTATION
HIGHWAYS DIVISION

EROSION CONTROL PLAN

KALANIANAʻOLE HIGHWAY
EMERGENCY LANDSLIDE REPAIRS AT CASTLE JUNCTION

PROJECT NO. 61C-~~01-04~~ 02-04
Scale: 1" = 40' Date: Sept. 26, 2003

SHEET No. P-3 OF 6 SHEETS


ORIGINAL PLAN	SURVEY PLOTTED BY	DATE
NOTE BOOK	DRAWN BY	
	DESIGNED BY	
	CHECKED BY	

J:\CASTLE JUNCTION\EC\EC-01.dgn

"AS-BUILT"

FED. ROAD DIST. NO.	STATE	PROJ. NO.	FISCAL YEAR	SHEET NO.	TOTAL SHEETS
HAWAII	HAW.	61C-01-04#	2004	28	91


02-04

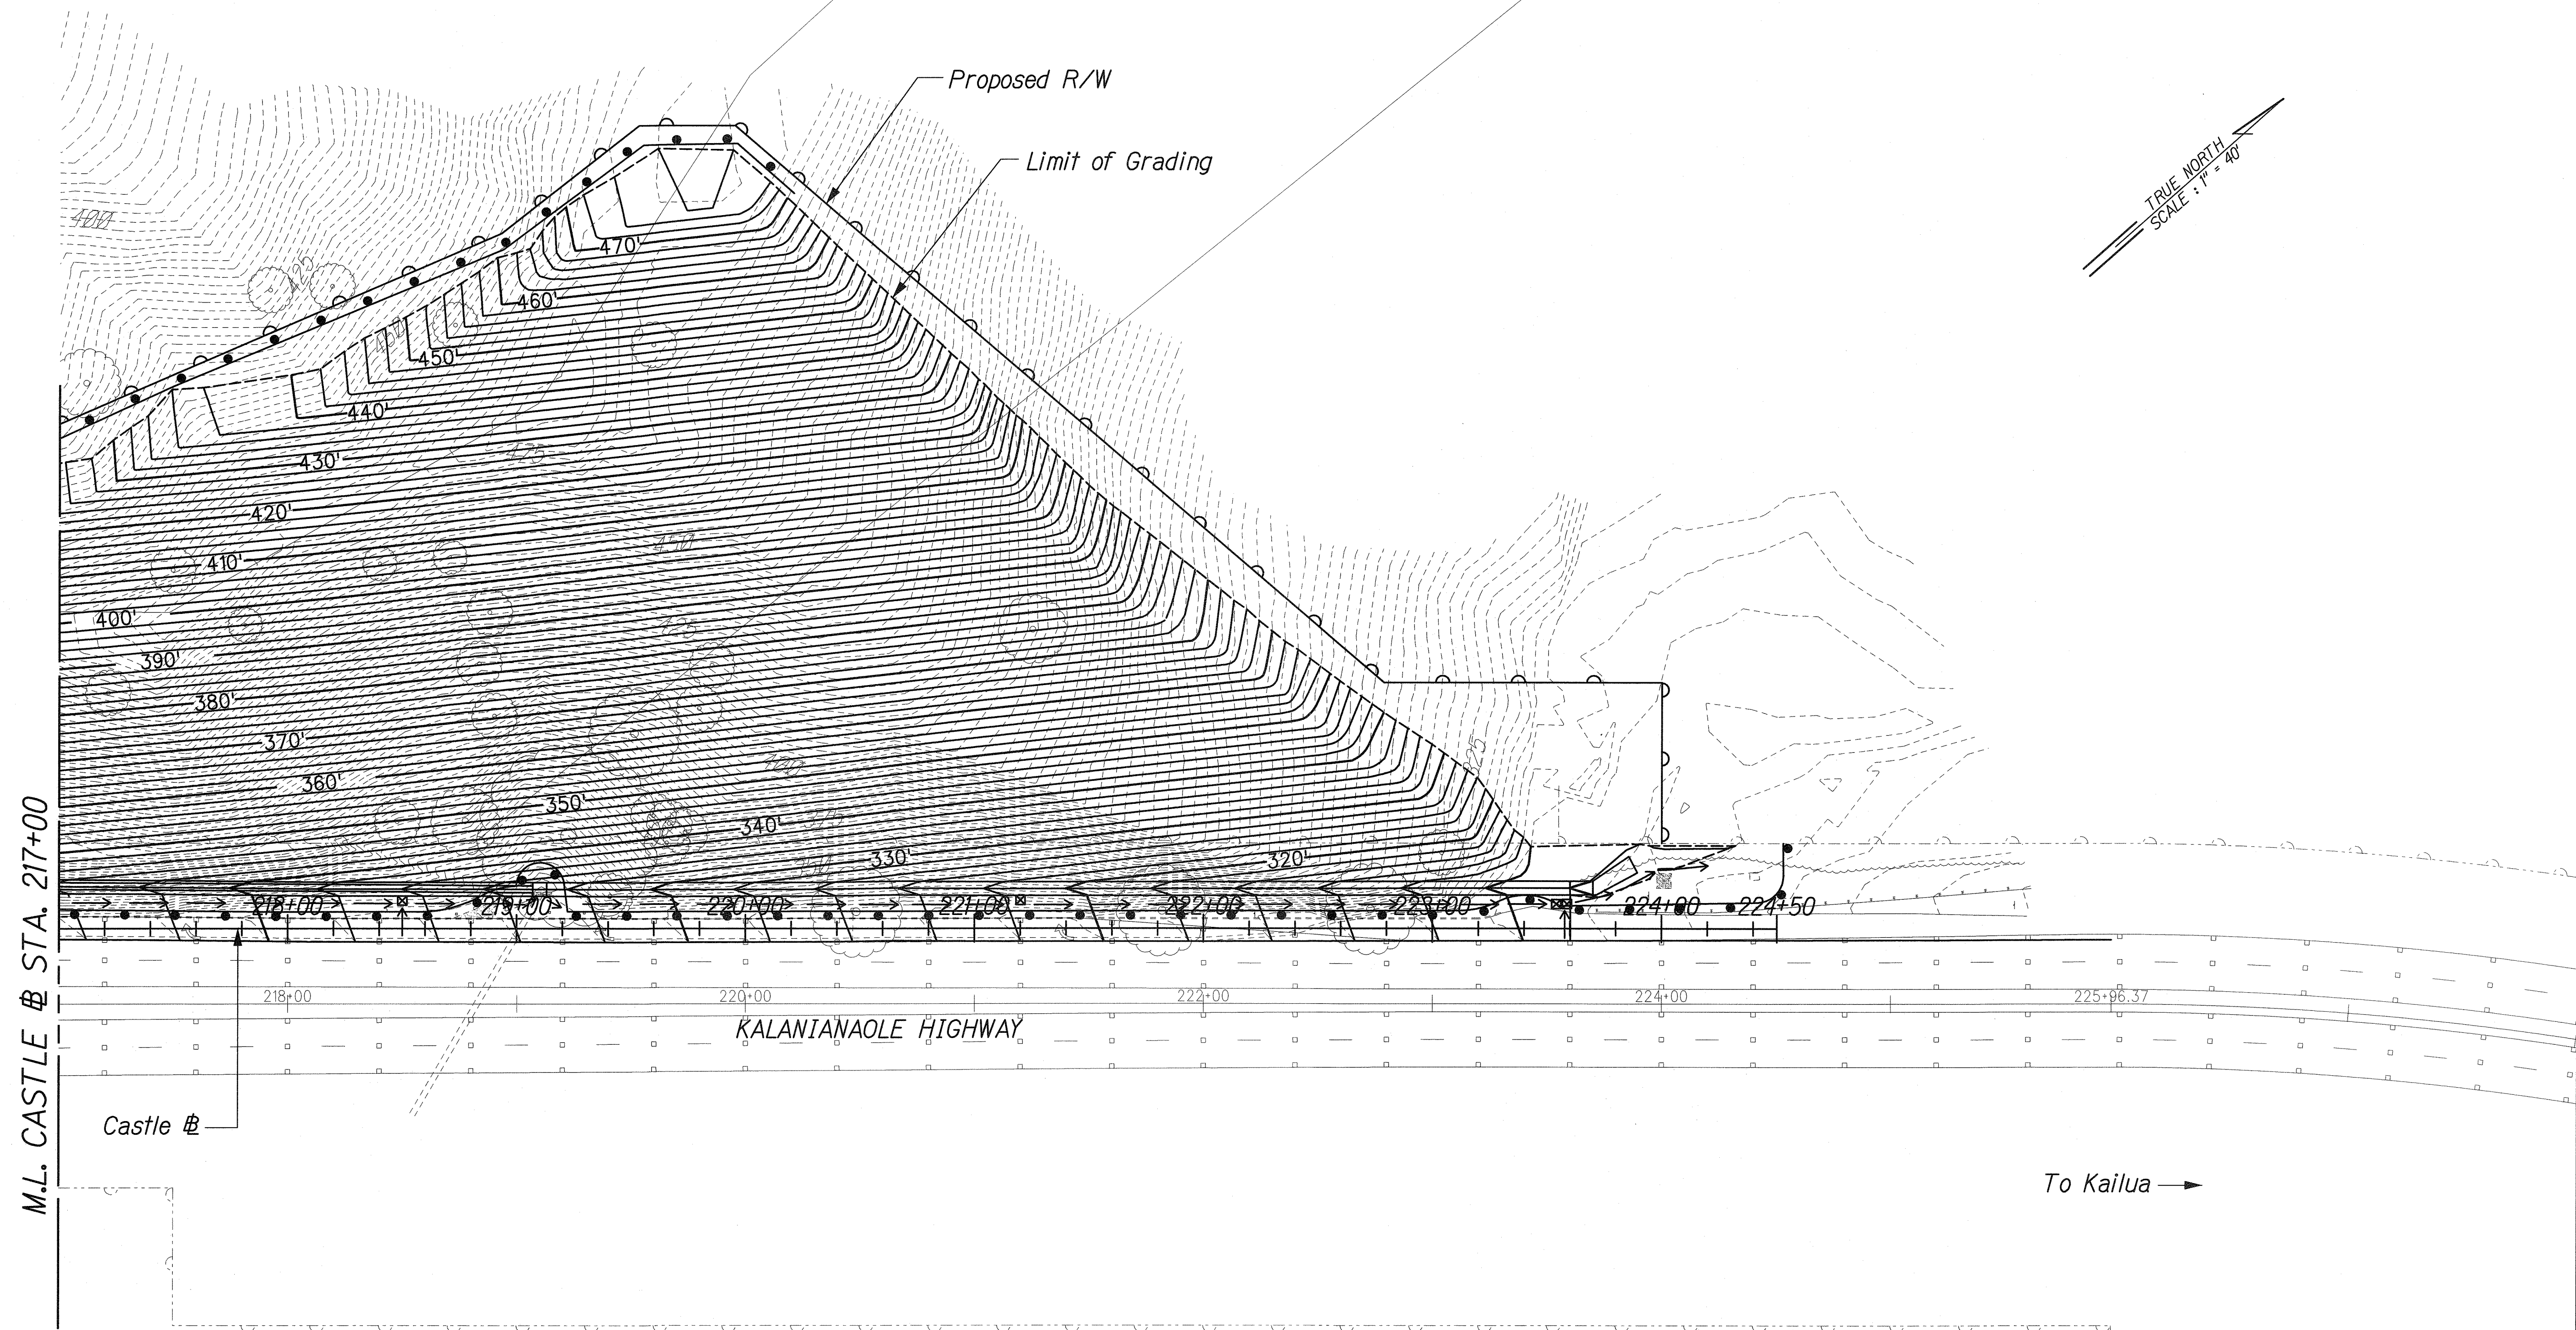

EROSION CONTROL DURING CONSTRUCTION

LEGEND:

- Silt Fence
- Grated Drop Inlet


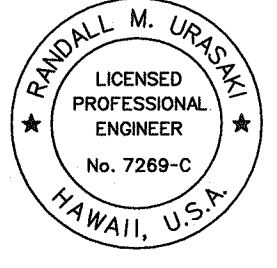
 THIS WORK WAS PREPARED BY ME OR UNDER MY SUPERVISION. <i>R. M. Urakami</i>	STATE OF HAWAII DEPARTMENT OF TRANSPORTATION HIGHWAYS DIVISION <u>EROSION CONTROL PLAN</u> <u>KALANIANAʻOLE HIGHWAY</u> <u>EMERGENCY LANDSLIDE REPAIRS AT CASTLE JUNCTION</u> PROJECT NO. <u>61C-01-04#</u> 02-04 Scale: 1" = 40' Date: <u>Sept. 26, 2003</u>
	SHEET No. <u>P-4</u> OF <u>6</u> SHEETS
	"AS-BUILT"
	28

ORIGINAL PLAN	SURVEY PLOTTED BY	DATE
NOTE BOOK	DRAWN BY	
	DESIGNED BY	
	CHECKED BY	

J:\CASTLE JUNCTION\EC-P\EC-02.dgn

FED. ROAD DIST. NO.	STATE	PROJ. NO.	FISCAL YEAR	SHEET NO.	TOTAL SHEETS
HAWAII	HAW.	61C-01-04#	2004	29	91

02-04

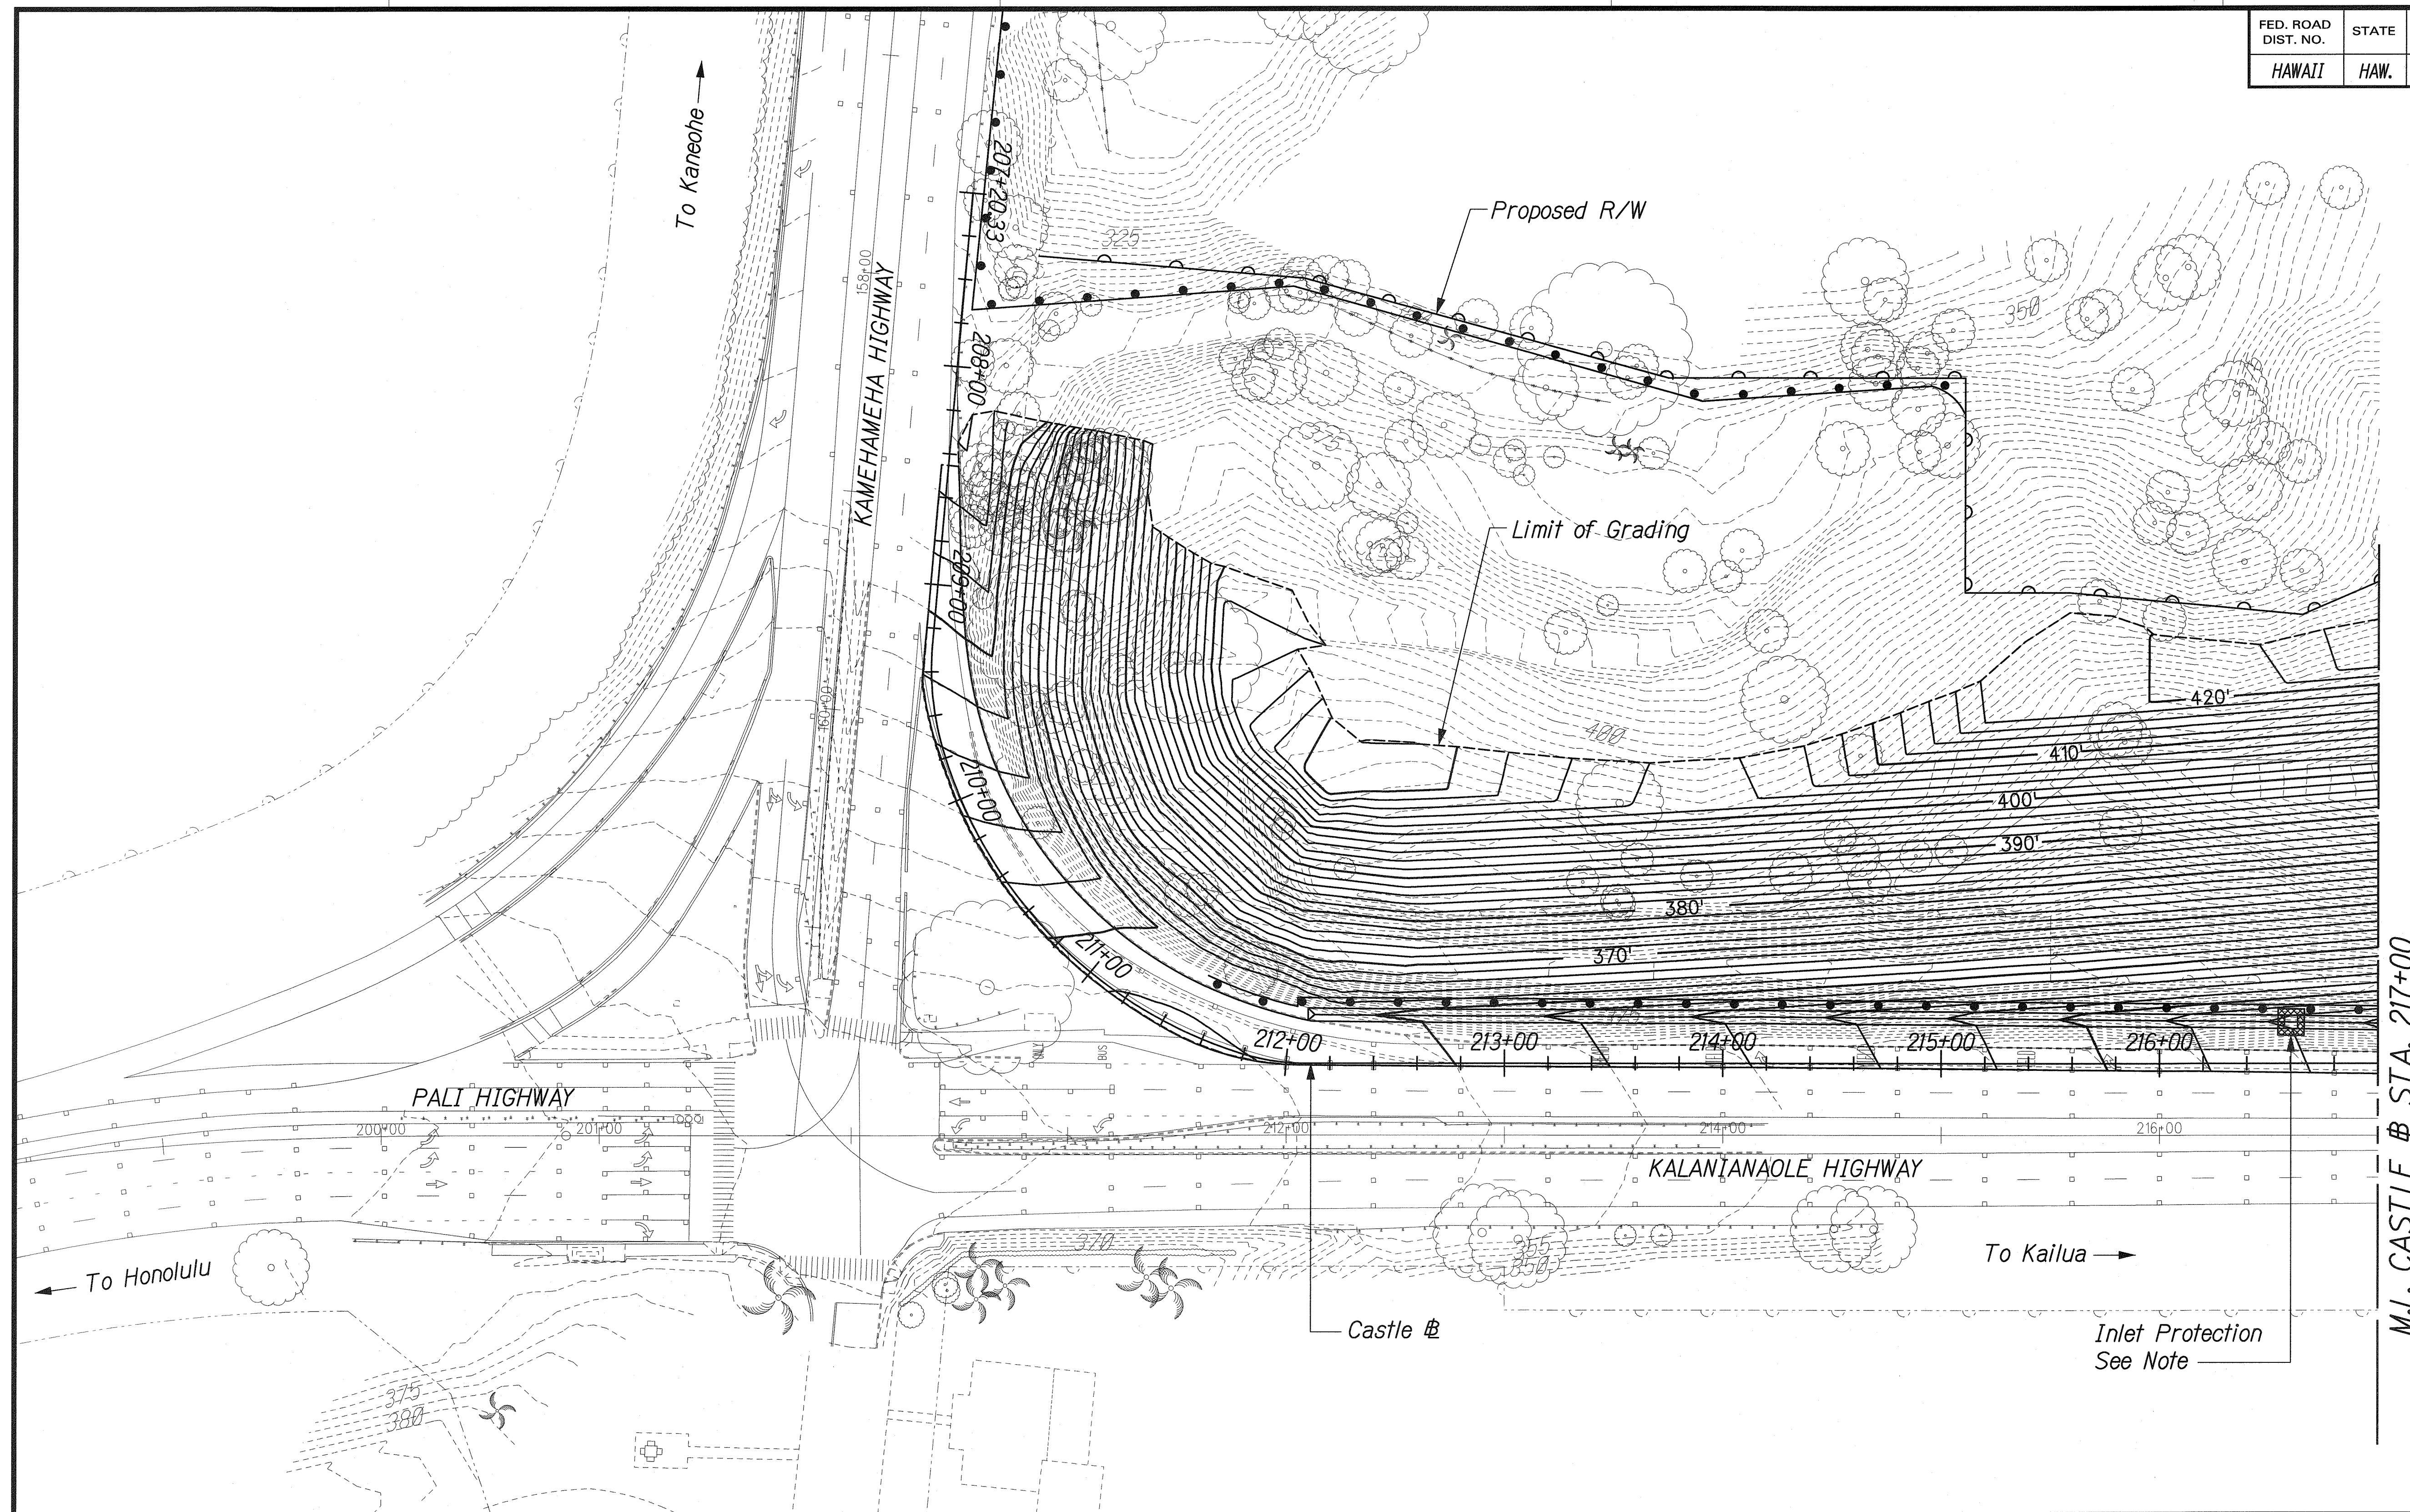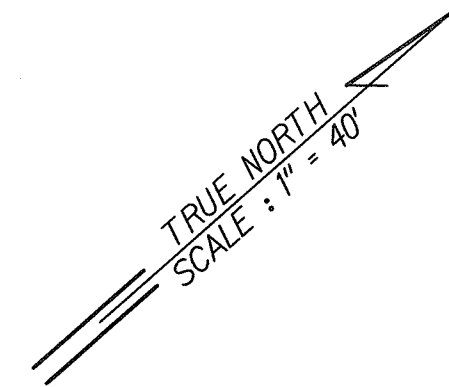

NOTE:
The silt fence and inlet protection shall remain for the duration of the plant establishment period. The Contractor shall be responsible for removing the silt fence and inlet protection at the end of the plant establishment period or as directed by the Engineer. Removal of the erosion control items shall be considered incidental to the various contract items.

EROSION CONTROL AFTER CONSTRUCTION

LEGEND:

—•—•— Silt Fence

ORIGINAL PLAN	SURVEY PLOTTED BY	DATE
NOTE BOOK	DRAWN BY	
	DESIGNED BY	
	CHECKED BY	

J:\CASTLE JUNCTION\ECP\EC-03.dgn

THIS WORK WAS PREPARED BY ME OR UNDER MY SUPERVISION

R. M. Urasaki

STATE OF HAWAII
DEPARTMENT OF TRANSPORTATION
HIGHWAYS DIVISION

EROSION CONTROL PLAN

KALANIANA'OLE HIGHWAY
EMERGENCY LANDSLIDE REPAIRS AT CASTLE JUNCTION


PROJECT NO. 61C-01-04# 02-04
Scale: 1" = 40' Date: Sept. 26, 2003

SHEET No. P-5 OF 6 SHEETS


"AS-BUILT"

FED. ROAD DIST. NO.	STATE	PROJ. NO.	FISCAL YEAR	SHEET NO.	TOTAL SHEETS
HAWAII	HAW.	61C-01-04#	2004	30	91

02-04

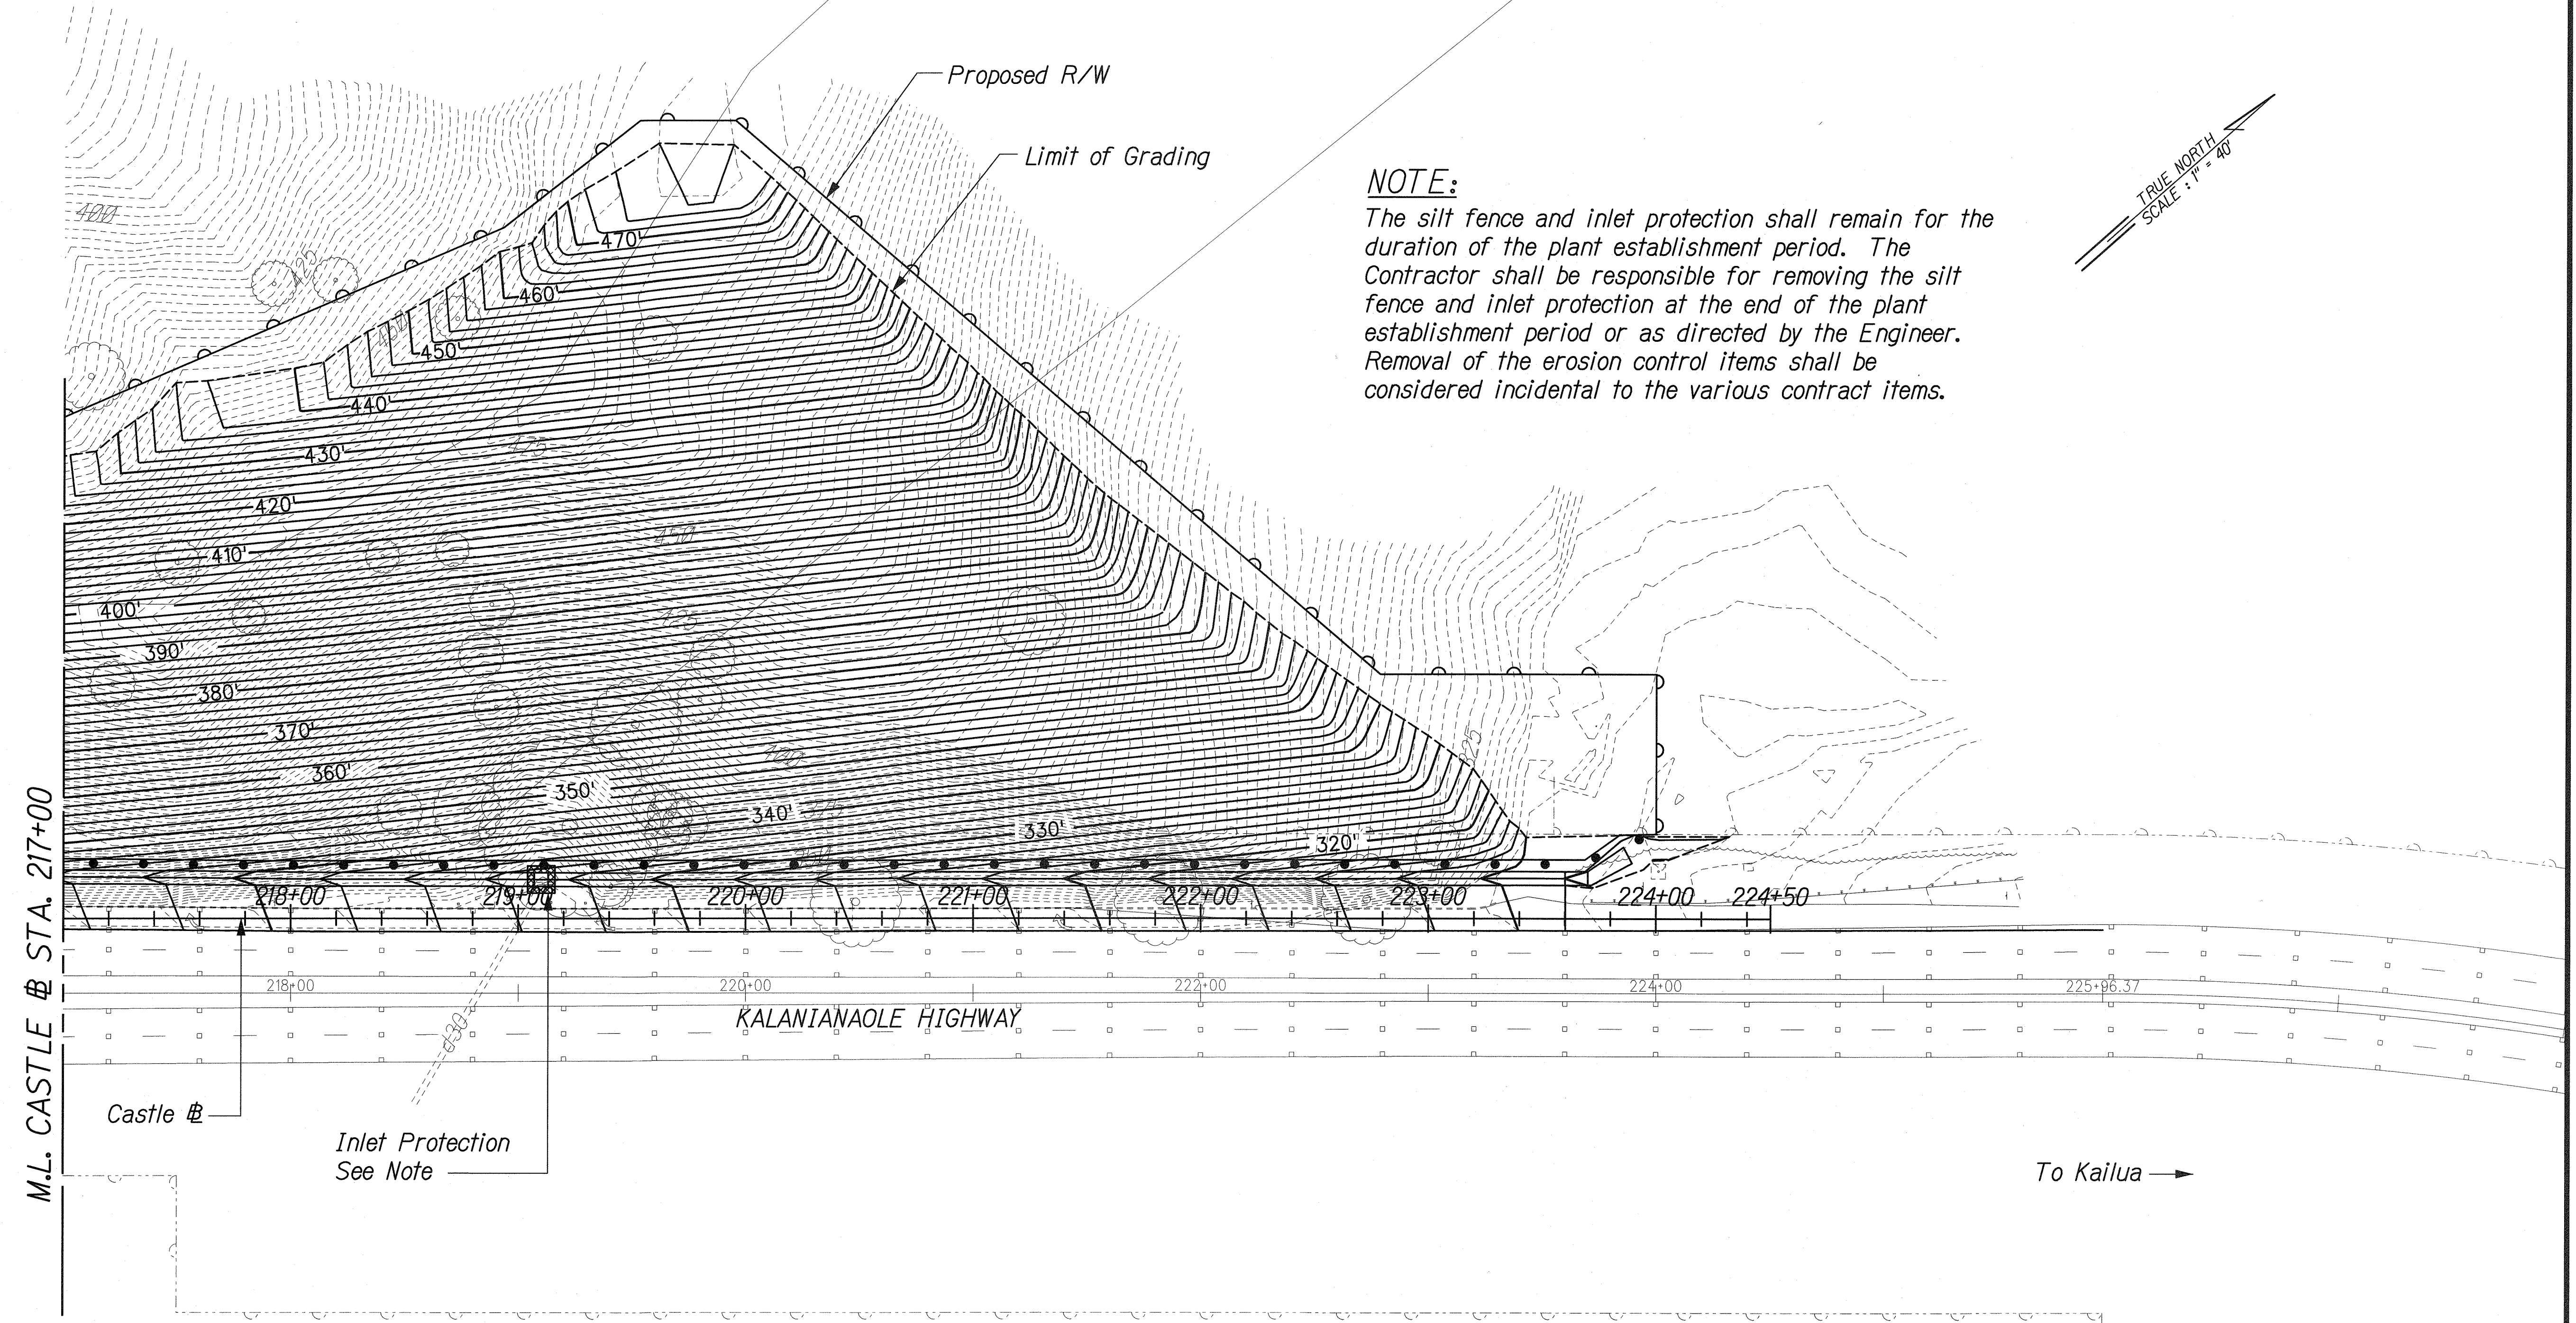

NOTE:
 The silt fence and inlet protection shall remain for the duration of the plant establishment period. The Contractor shall be responsible for removing the silt fence and inlet protection at the end of the plant establishment period or as directed by the Engineer. Removal of the erosion control items shall be considered incidental to the various contract items.

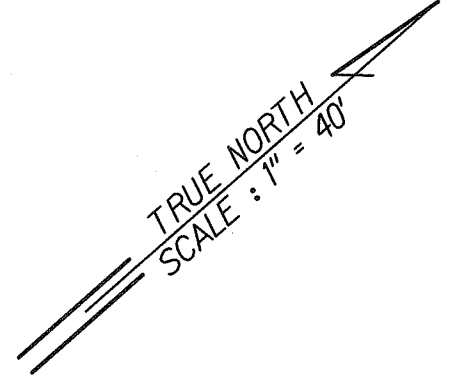

M.L. CASTLE # STA. 217+00

Castle #
 Inlet Protection
 See Note

To Kailua →

EROSION CONTROL AFTER CONSTRUCTION

LEGEND:

●●● Silt Fence

DESIGNED BY	DATE
TRACED BY	
NOTED BY	
CHECKED BY	

J:\CASTLE JUNCTION\EC\EC-04.dgn

THIS WORK WAS PREPARED BY ME OR UNDER MY SUPERVISION

Ru mll

STATE OF HAWAII
 DEPARTMENT OF TRANSPORTATION
 HIGHWAYS DIVISION

EROSION CONTROL PLAN

KALANIANA'OLE HIGHWAY
 EMERGENCY LANDSLIDE REPAIRS AT CASTLE JUNCTION

PROJECT NO. 61C-01-04# 02-04
 Scale: 1" = 40' Date: Sept. 26, 2003

SHEET No. P-6 OF 6 SHEETS

"AS-BUILT"