


FED. ROAD DIST. NO.	STATE	PROJ. NO.	FISCAL YEAR	SHEET NO.	TOTAL SHEETS
HAWAII	HAW.	61C-01-04#	2004	12	91

02-04

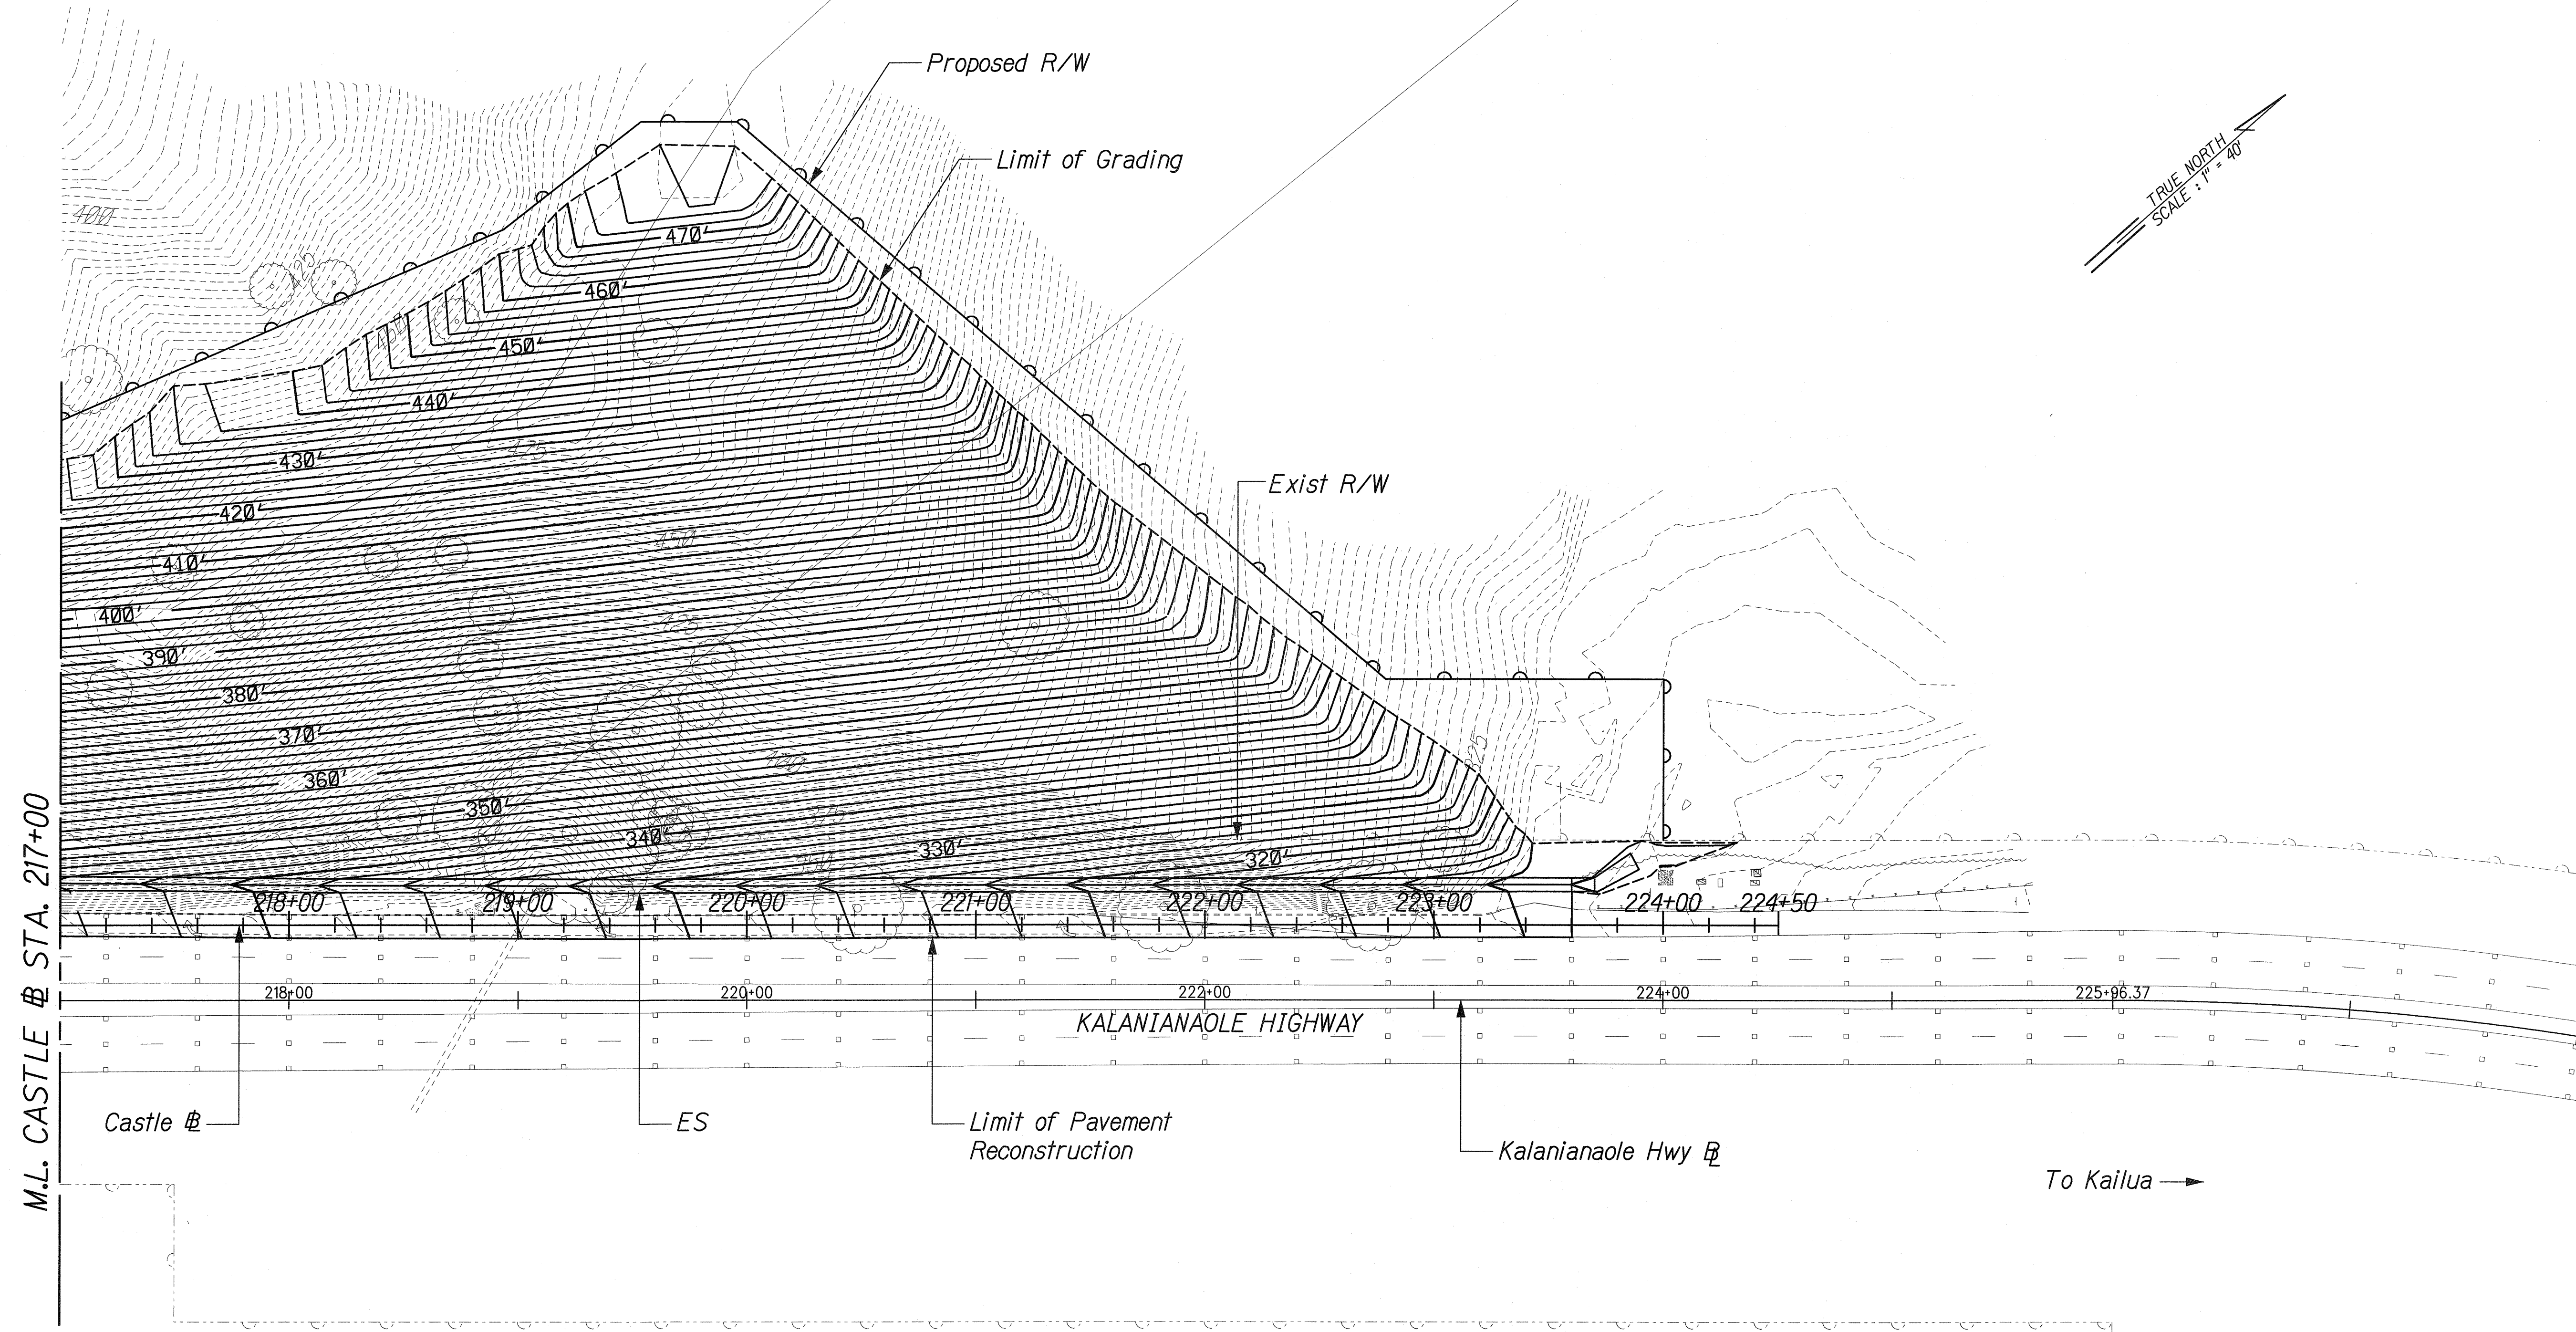

ORIGINAL PLAN	SURVEY PLOTTED BY	DATE
NOTE BOOK	DRAWN BY	
	DESIGNED BY	
	CHECKED BY	

J:\CASTLE JUNCTION\ALIGN\GRD-02.dgn

THIS WORK WAS PREPARED BY ME OR UNDER MY SUPERVISION

Rumla

STATE OF HAWAII
DEPARTMENT OF TRANSPORTATION
HIGHWAYS DIVISION

GRADING PLAN

KALANIANA'OLE HIGHWAY
EMERGENCY LANDSLIDE REPAIRS AT CASTLE JUNCTION

PROJECT NO. 61C-01-04# 02-04
Scale: 1" = 40' Date: Sept. 26, 2003

SHEET No. G-2 OF 2 SHEETS

"AS-BUILT"