


FED. ROAD DIST. NO.	STATE	PROJ. NO.	FISCAL YEAR	SHEET NO.	TOTAL SHEETS
HAWAII	HAW.	61C-01-04#	2004	32	91

02-04

NOTES:

1. Toning and probing shall be done prior to slope and roadway excavation along Signal Corps Cable alignment.
2. For toning of underground lines, the Contractor shall contact Marion F "Budd" Robinson, Jr. at 438-8071 or 295-1953 a minimum of seven (7) calendar days in advance.
3. For probing of underground lines, the Contractor shall contact Marion F "Budd" Robinson, Jr. at 438-8071 or 295-1953 a minimum of 48 hours in advance.
4. Contractor shall probe carefully to prevent damage to the existing Signal Corps Cable. Contractor shall be responsible for any damage to active Signal Corps Cable during probing.

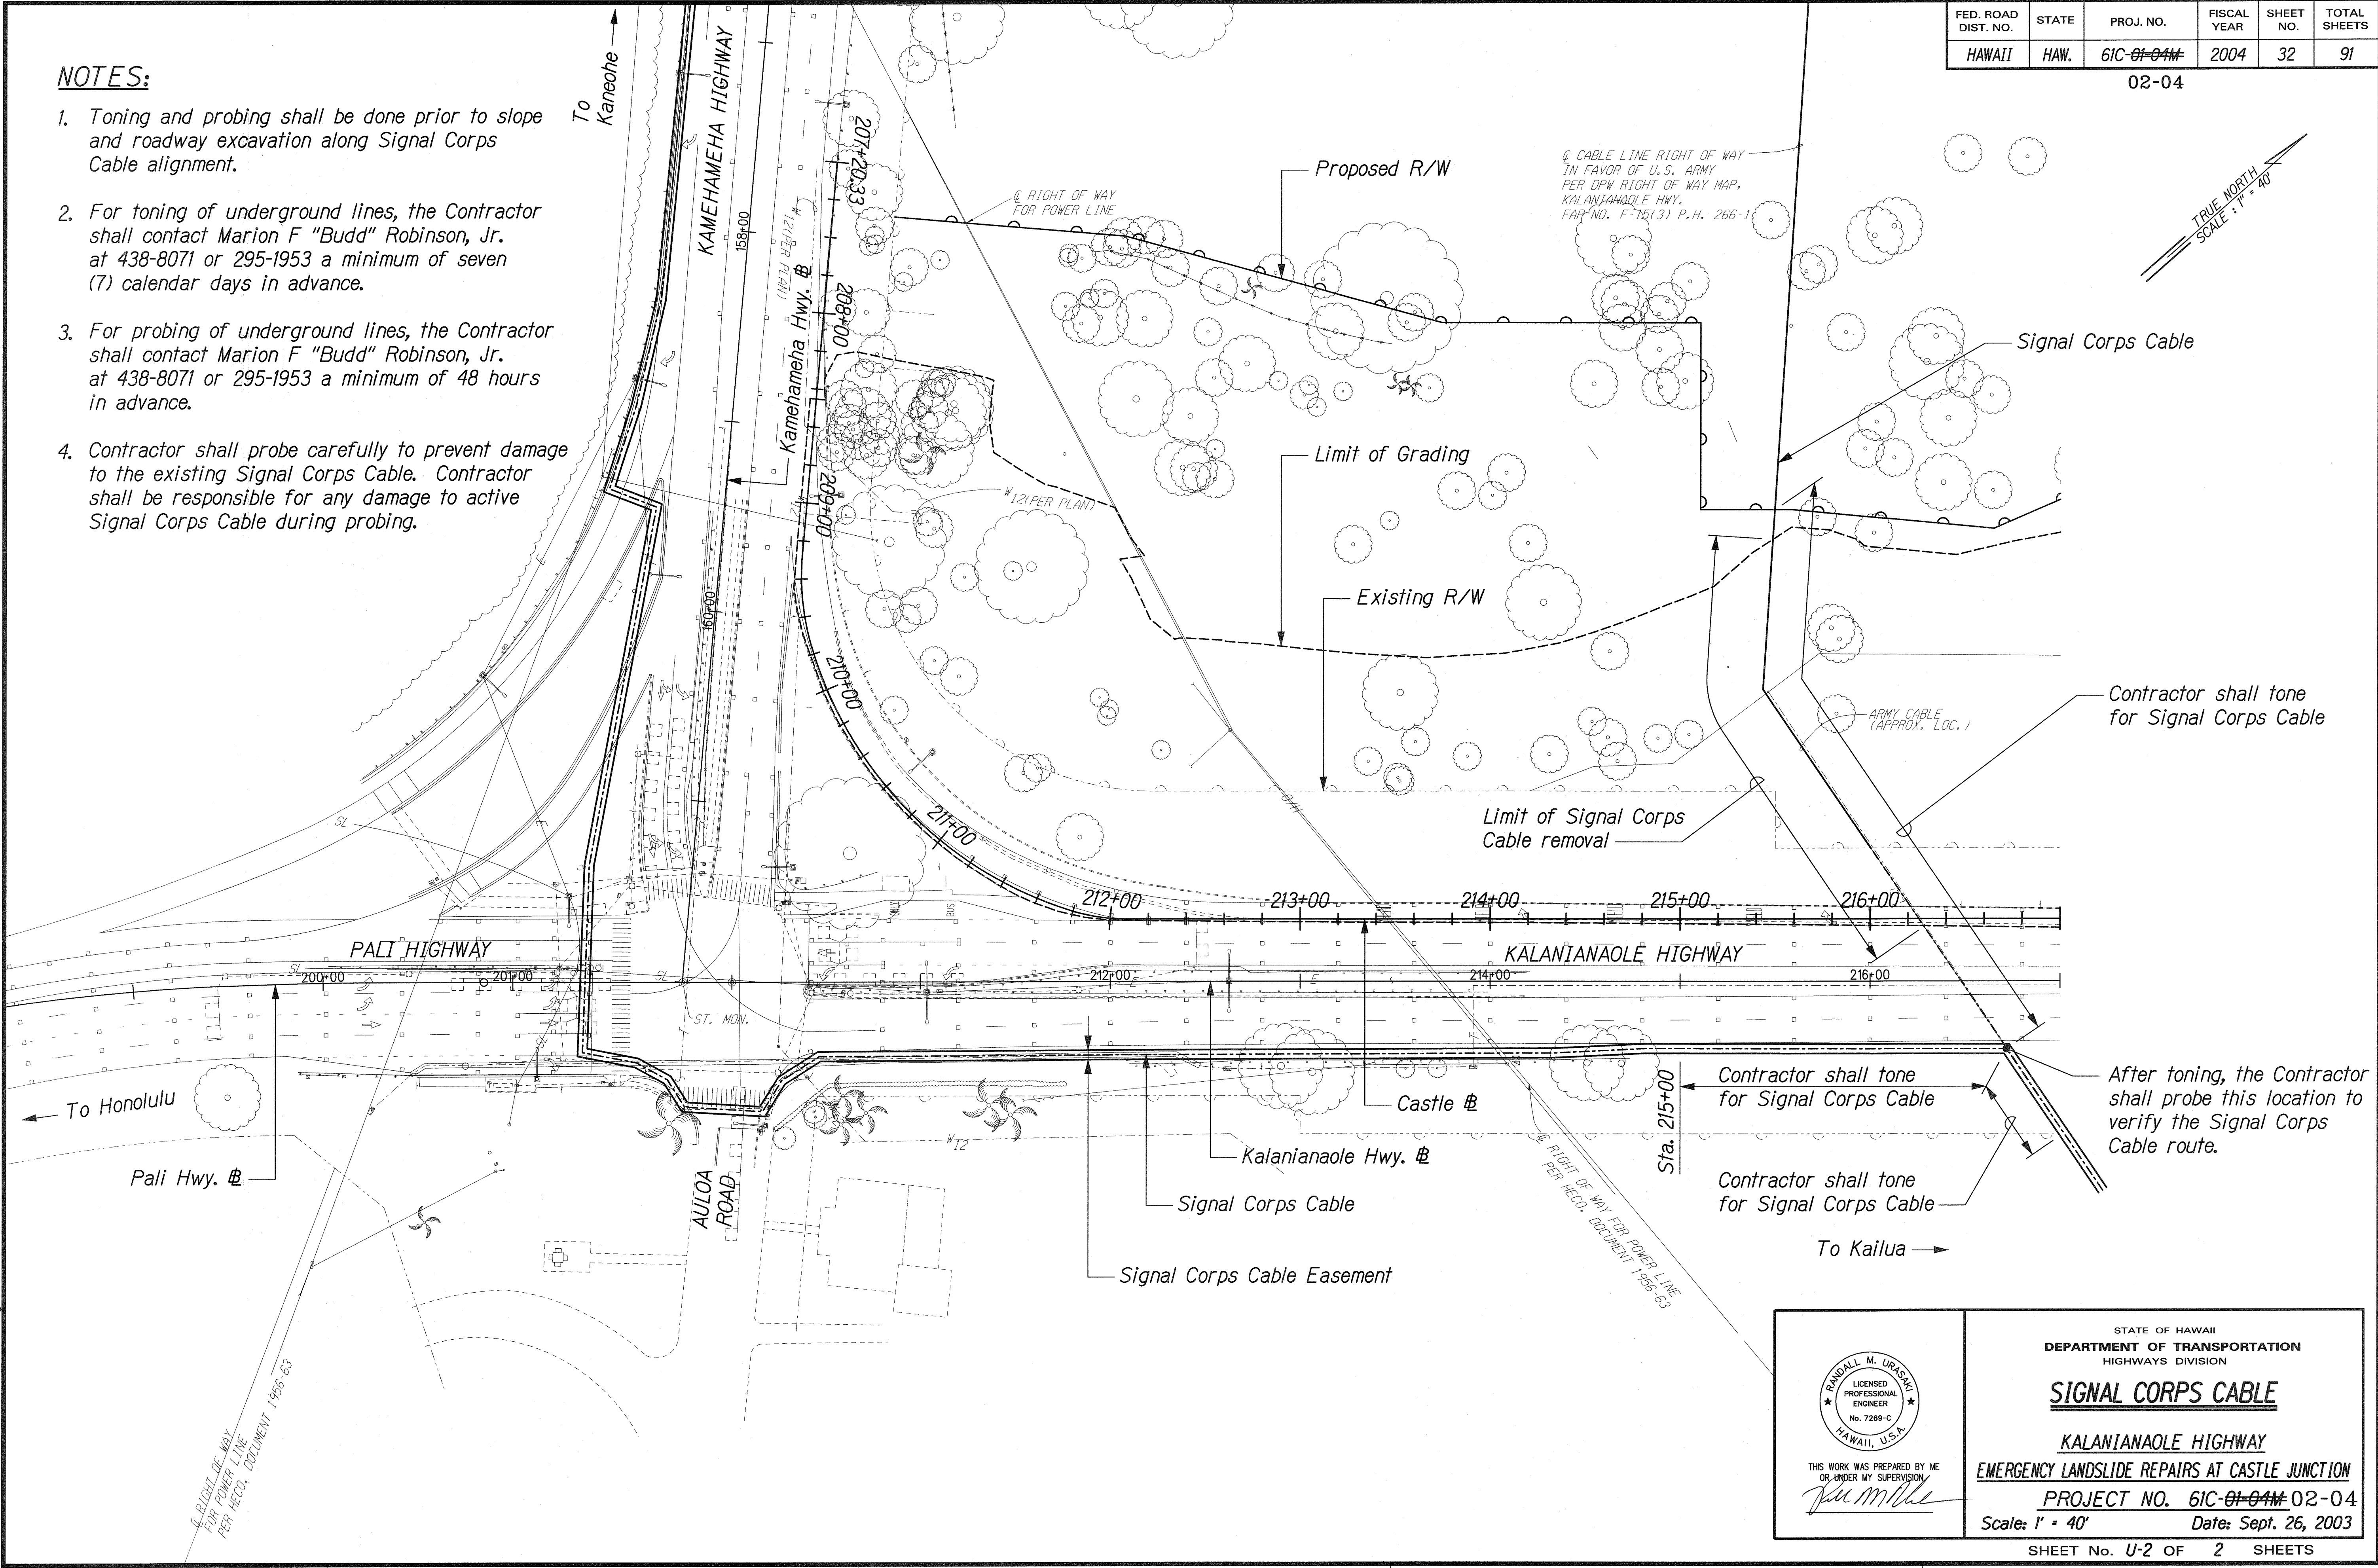

DESIGNED BY	DATE
CHECKED BY	
NOTED BY	
QUANTITIES BY	
ORIGINAL PLAN	

CASTLE JUNCTION ALIGN SIG-CORP.dgn

RIGHT OF WAY FOR POWER LINE PER HECO. DOCUMENT 1986-63

THIS WORK WAS PREPARED BY ME OR UNDER MY SUPERVISION

R. M. Urasak

STATE OF HAWAII
DEPARTMENT OF TRANSPORTATION
HIGHWAYS DIVISION

SIGNAL CORPS CABLE

KALANIANA'OLE HIGHWAY

EMERGENCY LANDSLIDE REPAIRS AT CASTLE JUNCTION

PROJECT NO. 61C-01-04# 02-04

Scale: 1" = 40' Date: Sept. 26, 2003

SHEET No. U-2 OF 2 SHEETS

"AS-BUILT"