



FED. ROAD DIST. NO.	STATE	PROJ. NO.	FISCAL YEAR	SHEET NO.	TOTAL SHEETS
HAWAII	HAW.	61C-01-04#	2004	7	91

02-04

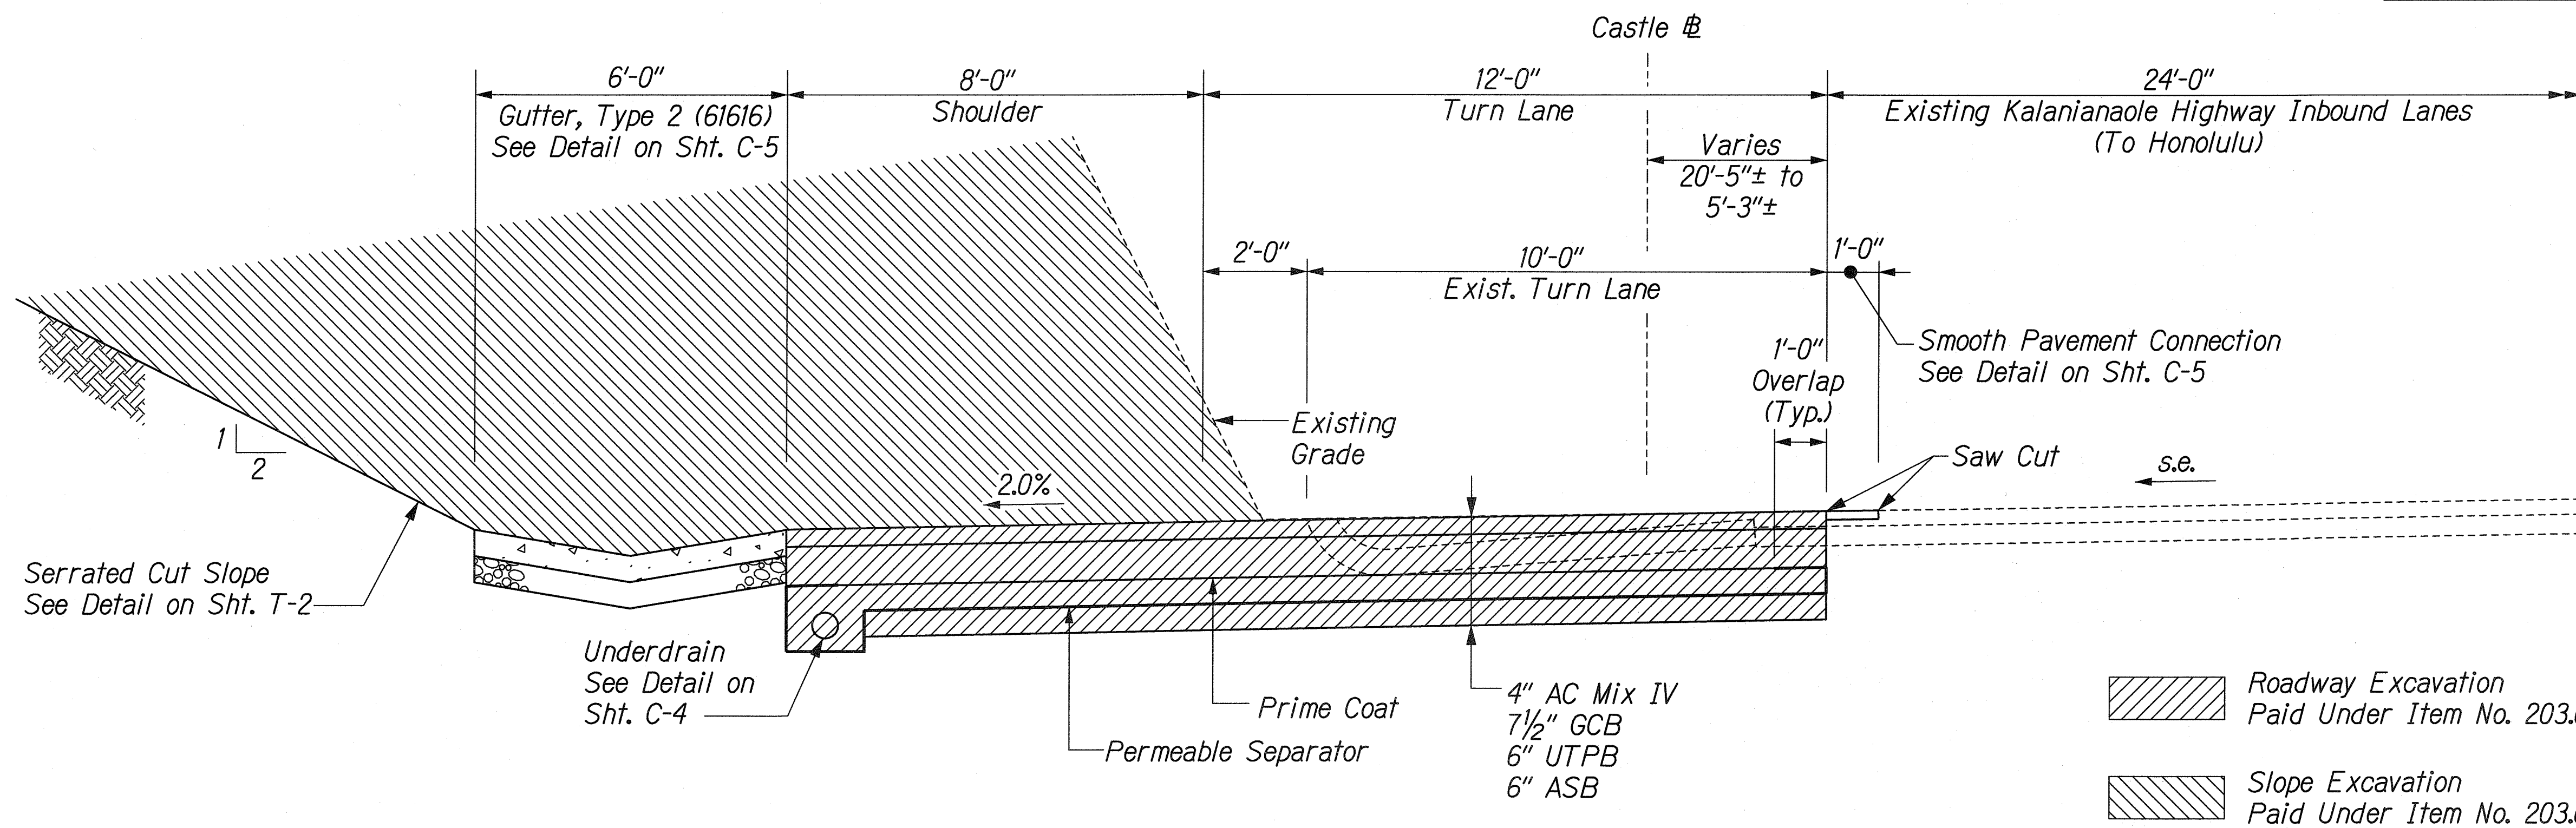

TYPICAL SECTION CASTLE # STA. 212+10 TO STA. 223+60

Scale: 1/2" = 1'-0"

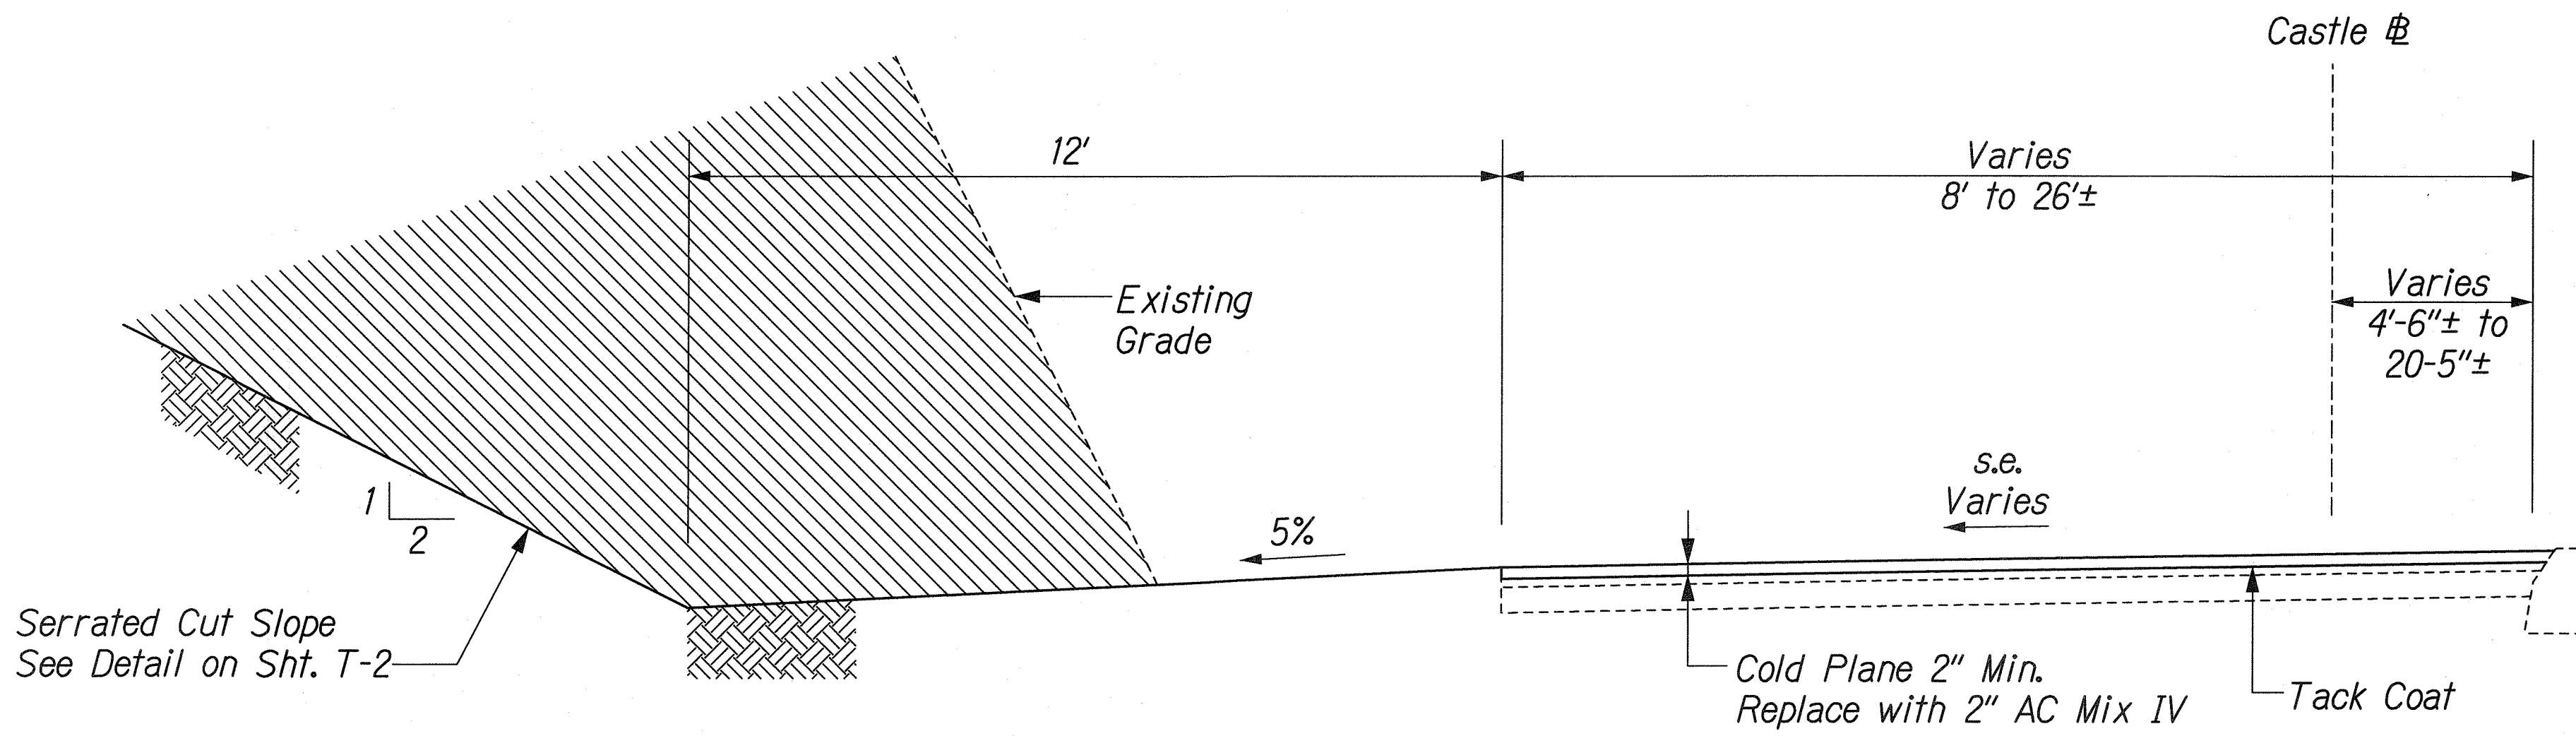

TYPICAL SECTION CASTLE # STA. 208+45 TO STA. 212+10

Scale: 1/2" = 1'-0"

DATE	_____
SURVEY PLOTTED BY	_____
DRAWN BY	_____
DESIGNED BY	_____
CHECKED BY	_____
ORIGINAL PLAN	_____
NOTE BOOK	_____
No.	_____

J:\CASTLE JUNCTION\MISC\TYPSEC1.dgn

THIS WORK WAS PREPARED BY ME OR UNDER MY SUPERVISION

Rumike

STATE OF HAWAII
DEPARTMENT OF TRANSPORTATION
HIGHWAYS DIVISION

TYPICAL SECTIONS

KALANIANA'OLE HIGHWAY

EMERGENCY LANDSLIDE REPAIRS AT CASTLE JUNCTION

PROJECT NO. 61C-01-04# 02-04


Scale: 1/2" = 1'-0" Date: Sept. 26, 2003

SHEET No. 7-1 OF 2 SHEETS

"AS-BUILT"

FED. ROAD DIST. NO.	STATE	PROJ. NO.	FISCAL YEAR	SHEET NO.	TOTAL SHEETS
HAWAII	HAW.	61C-01-04#	2004	8	91

02-04

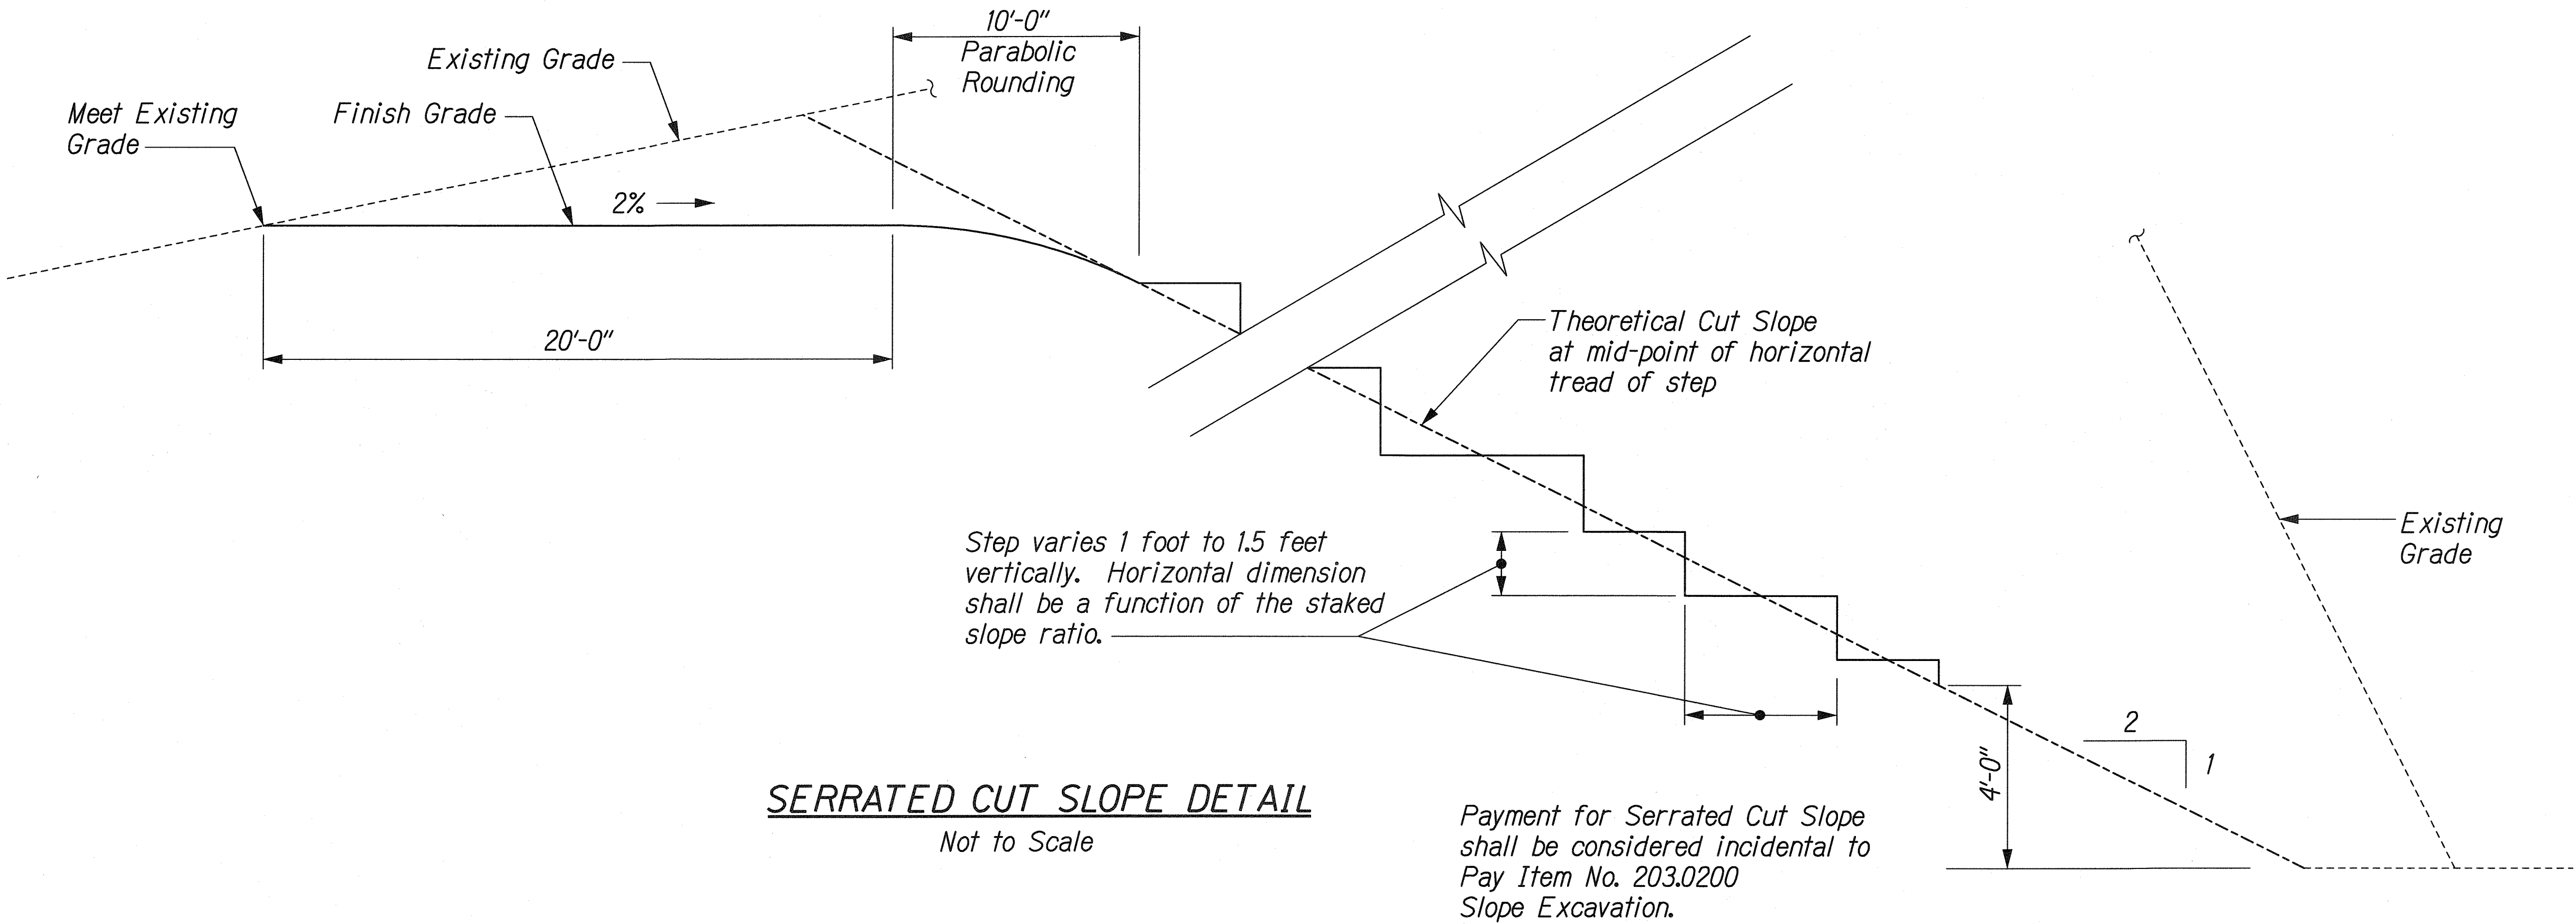

ORIGINAL PLAN	SURVEY PLOTTED BY	DATE
NOTE BOOK	DRAWN BY	
	DESIGNED BY	
	QUANTITIES BY	
	CHECKED BY	

J:\CASTLE JUNCTION\MISC\TYPSEC2.dgn

THIS WORK WAS PREPARED BY ME OR UNDER MY SUPERVISION

[Signature]

STATE OF HAWAII
DEPARTMENT OF TRANSPORTATION
HIGHWAYS DIVISION

TYPICAL SECTIONS

KALANIANA'OLE HIGHWAY

EMERGENCY LANDSLIDE REPAIRS AT CASTLE JUNCTION

PROJECT NO. 61C-01-04# 02-04

Scale: None Date: Sept. 26, 2003

SHEET No. T-2 OF 2 SHEETS

"AS-BUILT"