

STATE OF HAWAII DEPARTMENT OF TRANSPORTATION

HIGHWAYS DIVISION HONOLULU, HAWAII

"AS-BUILT"
PLANS FOR


KAILUA ROAD TEMPORARY LANE FOR ROCKFALL AND LANDSLIDE

PROJECT NO. 61D-01-06M

DISTRICT OF KOOLAUPOKO ISLAND OF OAHU

LOCATION PLAN

NOT TO SCALE

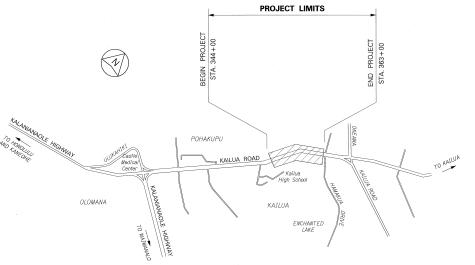




FED. ROAD STATE PROJ. NO.

HAWAII HAW. 61D-01-06M

2006

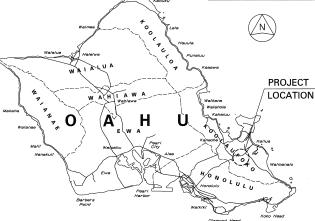

WORK AREA: 0.9 ACRES

MILEPOST 10.24 TO MILEPOST 10.60

LENGTH OF PROJECT: 0.36 Miles

CHANGES MADE DURING CONSTRUCTION HAVE BEEN INCORPORATED ON THESE PLANS.

GERALD PANG

3/15/07

PM: OPER:

DATE: SCALE: 1 = 1 FILE.

JA ROAD/MISC/TS.dgn

1