



FED. ROAD DIST. NO.	STATE	PROJ. NO.	FISCAL YEAR	SHEET NO.	TOTAL SHEETS
OAHU	HAWAII	61D-02-06	2006	9	57

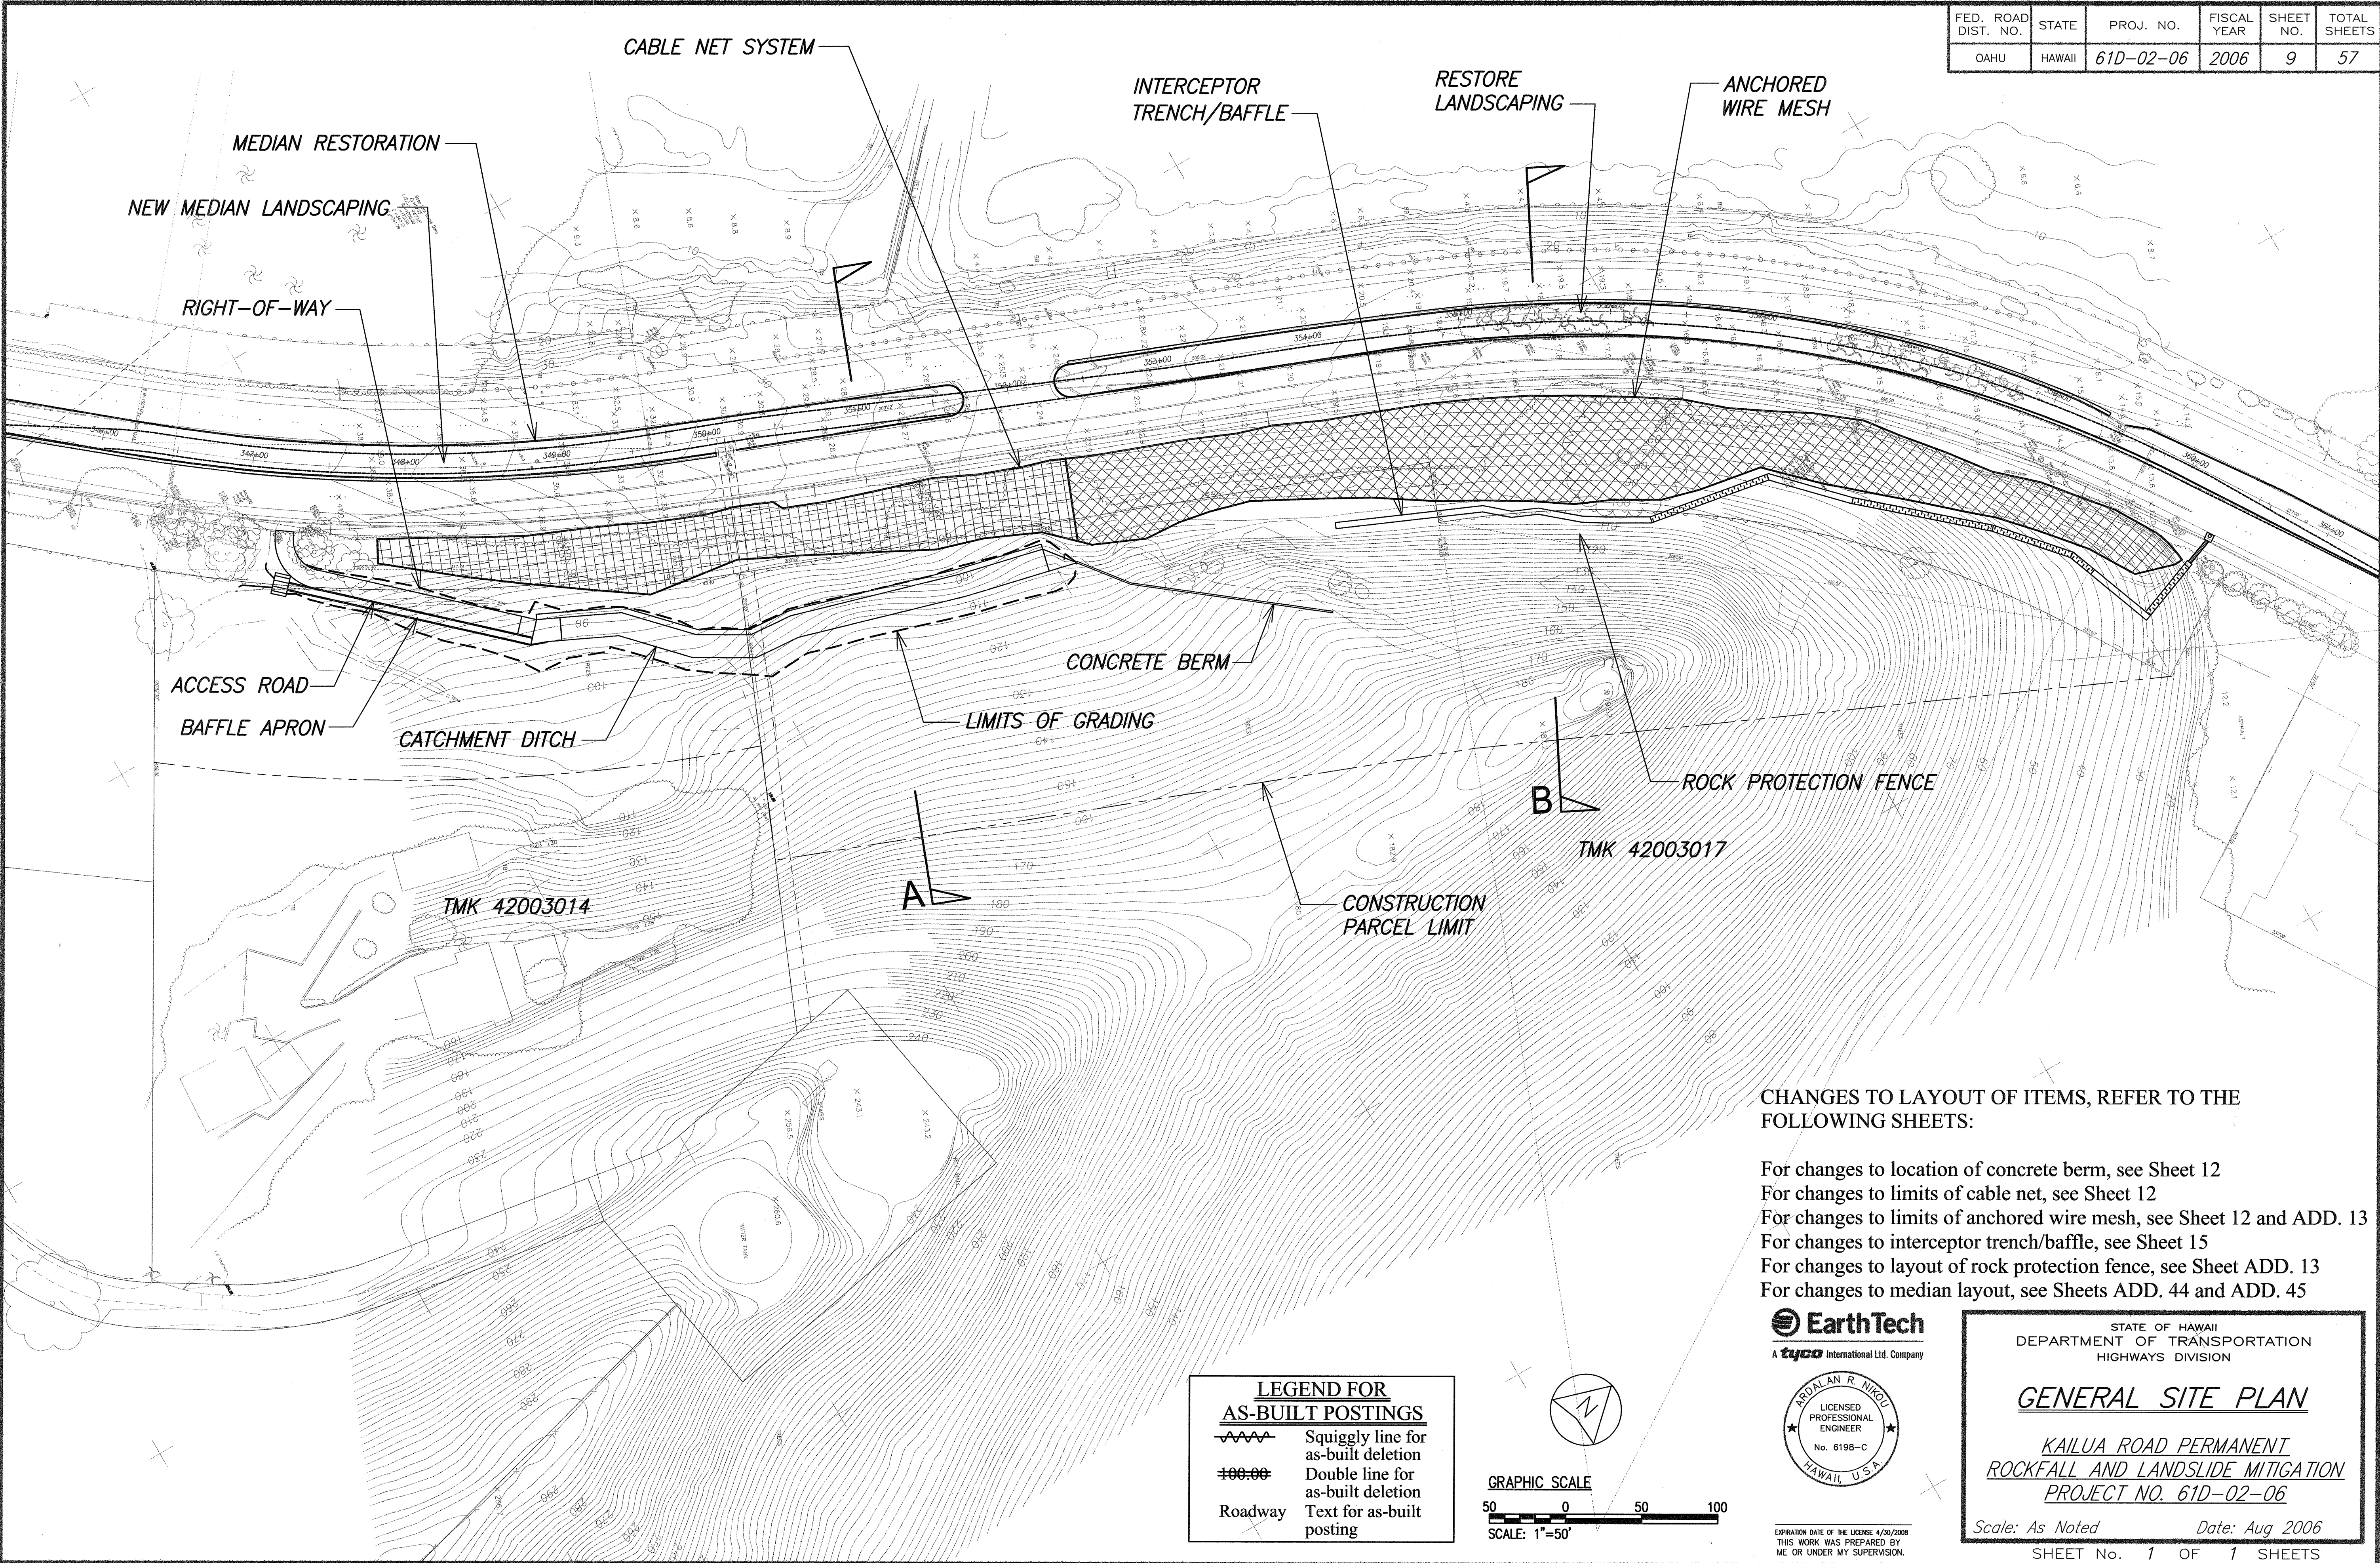

CHANGES TO LAYOUT OF ITEMS, REFER TO THE FOLLOWING SHEETS:

- For changes to location of concrete berm, see Sheet 12
- For changes to limits of cable net, see Sheet 12
- For changes to limits of anchored wire mesh, see Sheet 12 and ADD. 13
- For changes to interceptor trench/baffle, see Sheet 15
- For changes to layout of rock protection fence, see Sheet ADD. 13
- For changes to median layout, see Sheets ADD. 44 and ADD. 45

EarthTech
A tyco International Ltd. Company

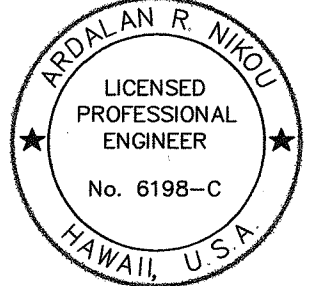

STATE OF HAWAII
DEPARTMENT OF TRANSPORTATION
HIGHWAYS DIVISION

GENERAL SITE PLAN

KAILUA ROAD PERMANENT
ROCKFALL AND LANDSLIDE MITIGATION
PROJECT NO. 61D-02-06


Scale: As Noted Date: Aug 2006

SHEET No. 1 OF 1 SHEETS

ORIGINAL PLAN	DATE
SURVEY PLOTTED BY	
DRAWN BY	
TRACED BY	
DESIGNED BY	
QUANTITIES BY	
CHECKED BY	
No.	

LEGEND FOR AS-BUILT POSTINGS

- Squiggly line for as-built deletion
- Double line for as-built deletion
- Text for as-built posting

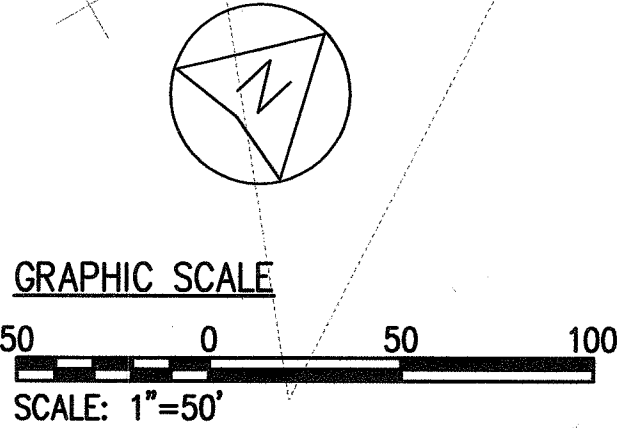

"AS-BUILT"