

INDEX TO DRAWINGS	
SHEET NO.	DESCRIPTION
1	TITLE SHEET
2	STANDARD PLANS SUMMARY
3 - 5	GENERAL NOTES, UTILITY NOTES
6 - 8	WATER POLLUTION AND EROSION CONTROL
9	GENERAL SITE PLAN
10	TYPICAL CROSS SECTION
11	DEMOLITION PLAN
12 - 13	SITE PLAN
14 - 15	DRAINAGE PLAN
16	PROFILES
17 - 20	CROSS SECTIONS
21	CATCHMENT DITCH DETAILS
22	SLOPE SMOOTHING ALONG CABLE NET SYSTEM
23 - 28	BOULDER MITIGATION
29	ROCK BOLT ANCHOR
30	ROCK STRAPING
31 - 33	ANCHORED WIRE MESH
34	CABLE NET SYSTEM
35	ROCK PROTECTION FENCE ① ② ③ ④ ⑤
36 - 37	STRUCTURAL NOTES AND TYPICAL DETAILS
38 - 41	INTERCEPTOR TRENCH BAFFLE APRON DETAILS
42 - 43	SOUTH BAFFLE APRON DETAILS ⑥ ⑦
44 - 46	MEDIAN RESTORATION
47 - 52	LANDSCAPE AND IRRIGATION PLANS ⑧ ⑨ ⑩ ⑪
53 - 57	TRAFFIC CONTROL PLAN ⑫ ⑬ ⑭

SUPPLEMENTARY SHEETS TO THIS PROJECT ARE PLAN SHEET NOS. :
① C.O. 355-1, ② C.O. 355-2, ③ C.O. 355-3, ④ C.O. 355-4, ⑤ C.O. 355-5, ⑥ C.O. 435-1,
⑦ C.O. 435-2, ⑧ C.O. ADD 505-1, ⑨ C.O. ADD 505-2, ⑩ C.O. ADD 505-3, ⑪ C.O. ADD 505-4,
⑫ C.O. 575-1, ⑬ C.O. 575-2, ⑭ C.O. 575-3
TOTAL SHEET COUNT AFTER "AS-BUILT" POSTINGS: 71

Aug 2006
DATE

(808) 682-7581
PHONE





HWY-DD/UNIT E
P.S. & E. BY

EARTH TECH
DESIGNED BY

STATE OF HAWAII
DEPARTMENT OF TRANSPORTATION
HIGHWAYS DIVISION
HONOLULU, HAWAII
"AS-BUILT"

PLANS FOR
KAILUA ROAD PERMANENT ROCKFALL
AND LANDSLIDE MITIGATION
PROJECT NO. 61D-02-06
DISTRICT OF KOOLAUPOKO
ISLAND OF OAHU


FED. ROAD DIST. NO.	STATE	PROJ. NO.	FISCAL YEAR	SHEET NO.	TOTAL SHEETS
OAHU	HAWAII	61D-02-06	2006	1	57

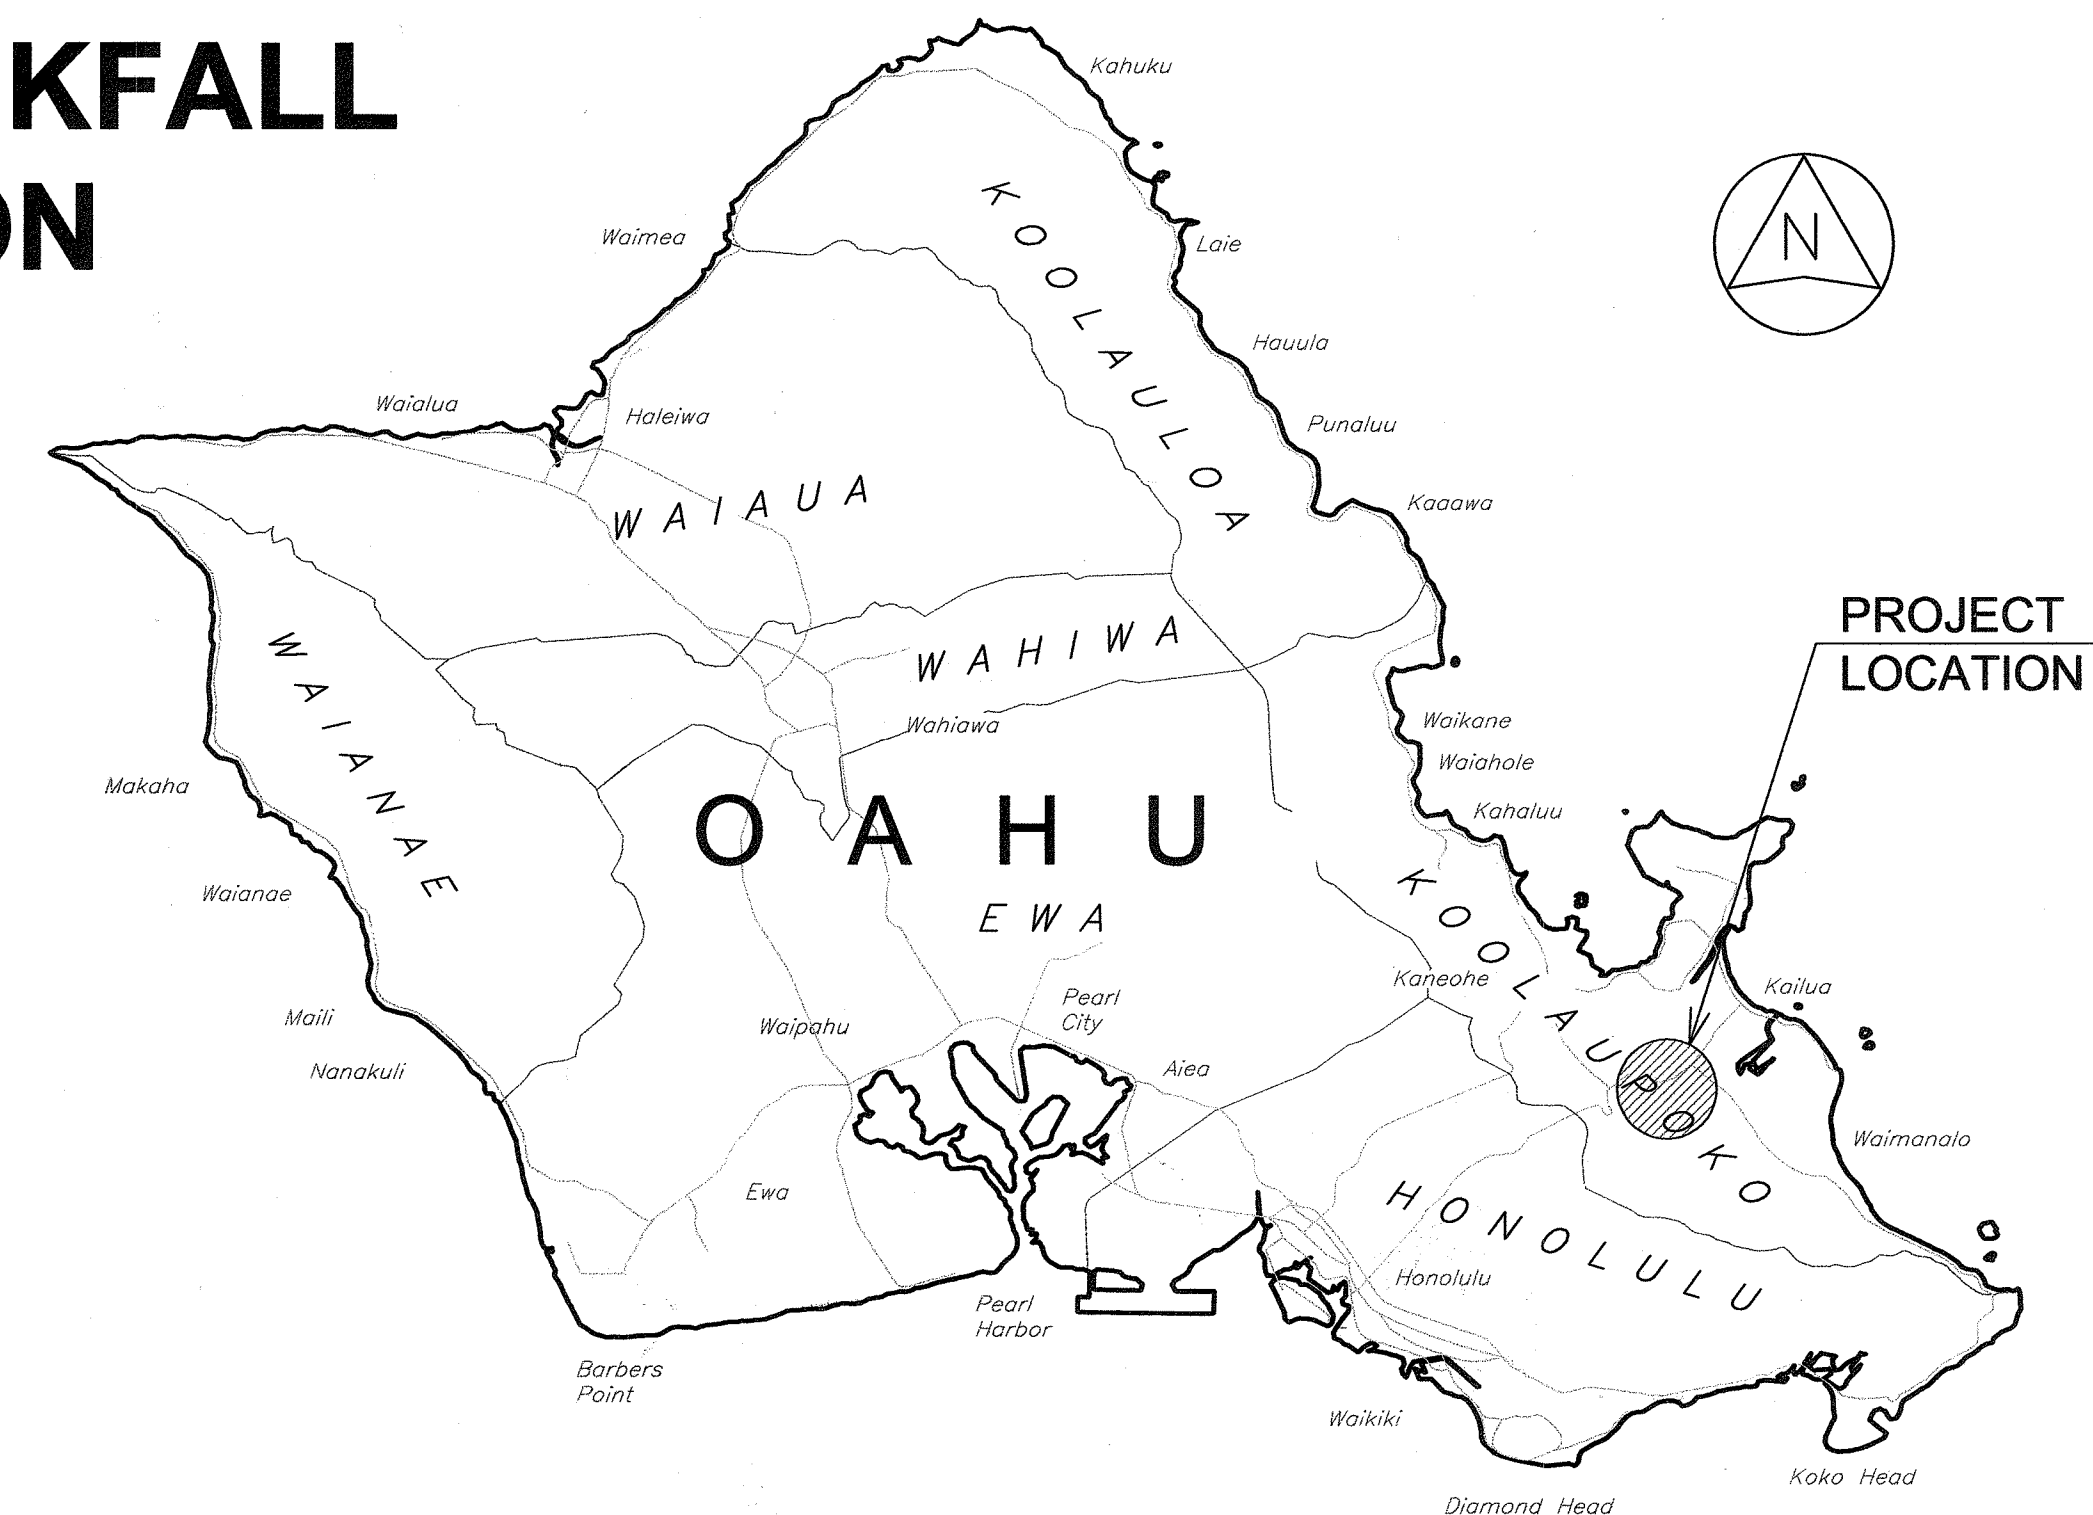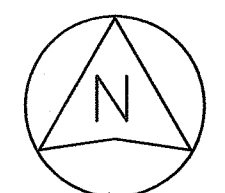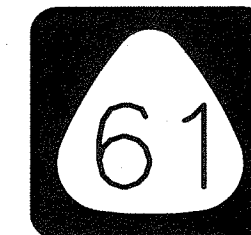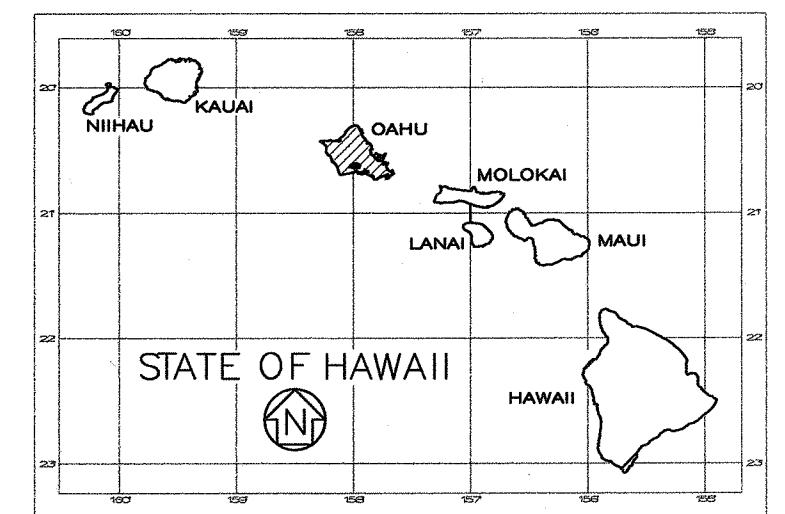

PROJECT
LOCATION

5 0 5 10 15
SCALE IN MILES

WORK AREA: 5.5 ACRES
MILEPOST 10.24 TO MILEPOST 10.60
LENGTH OF PROJECT: 0.36 Miles

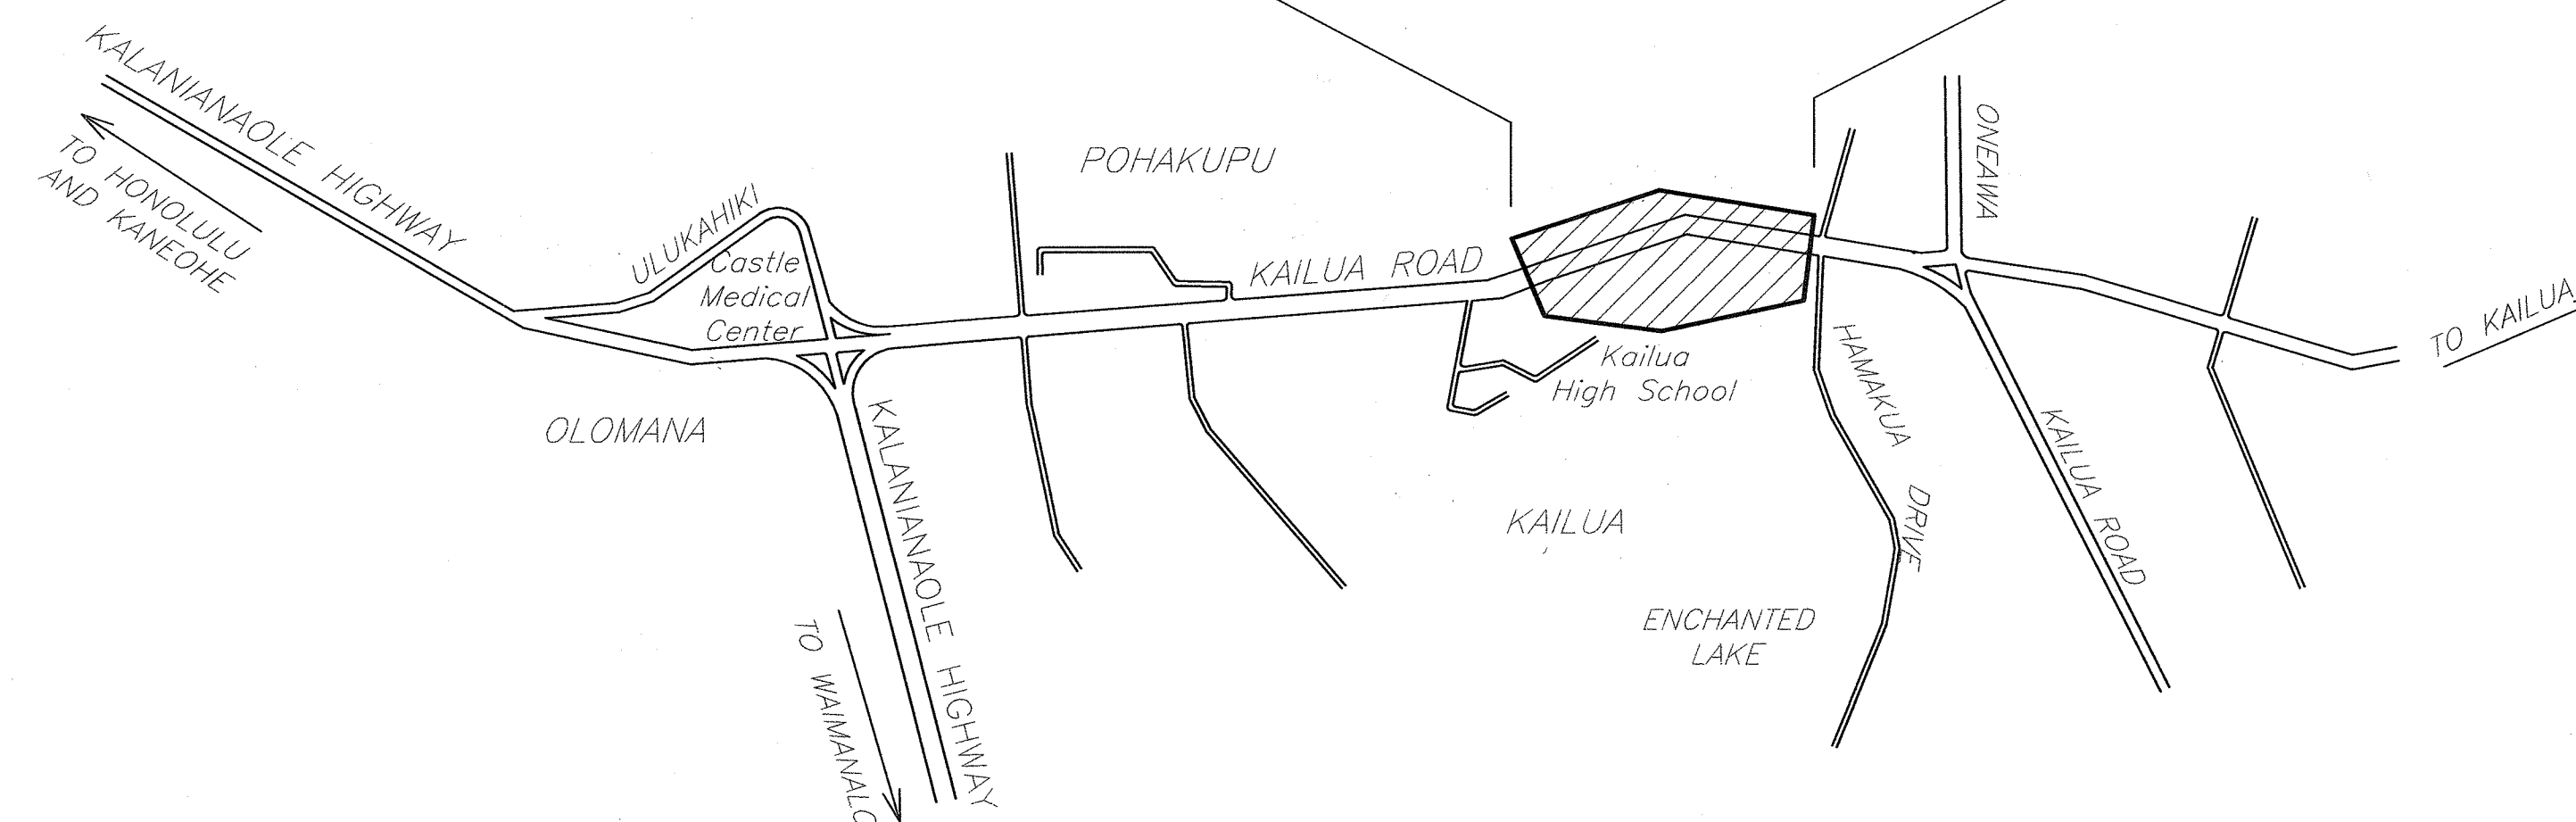

LOCATION PLAN

0 2000 4000 6000 8000
SCALE IN FEET

NO SIGNIFICANT CHANGES WERE MADE DURING
CONSTRUCTION ON THESE PLANS EXCEPT CHANGES
IN THE ORIGINAL THEORETICAL QUANTITIES. FOR
ACTUAL QUANTITIES, REFER TO PROJECT LEDGER
AND/OR COMPUTATION BOOK.

RESIDENT ENGINEER
DATE

DEPARTMENT OF TRANSPORTATION
STATE OF HAWAII
APPROVED:
8-30-06
DIR. OF TRANSPORTATION DATE