



FED. ROAD DIST. NO.	STATE	PROJ. NO.	FISCAL YEAR	SHEET NO.	TOTAL SHEETS
OAHU	HAWAII	61D-02-06	2006	10	57

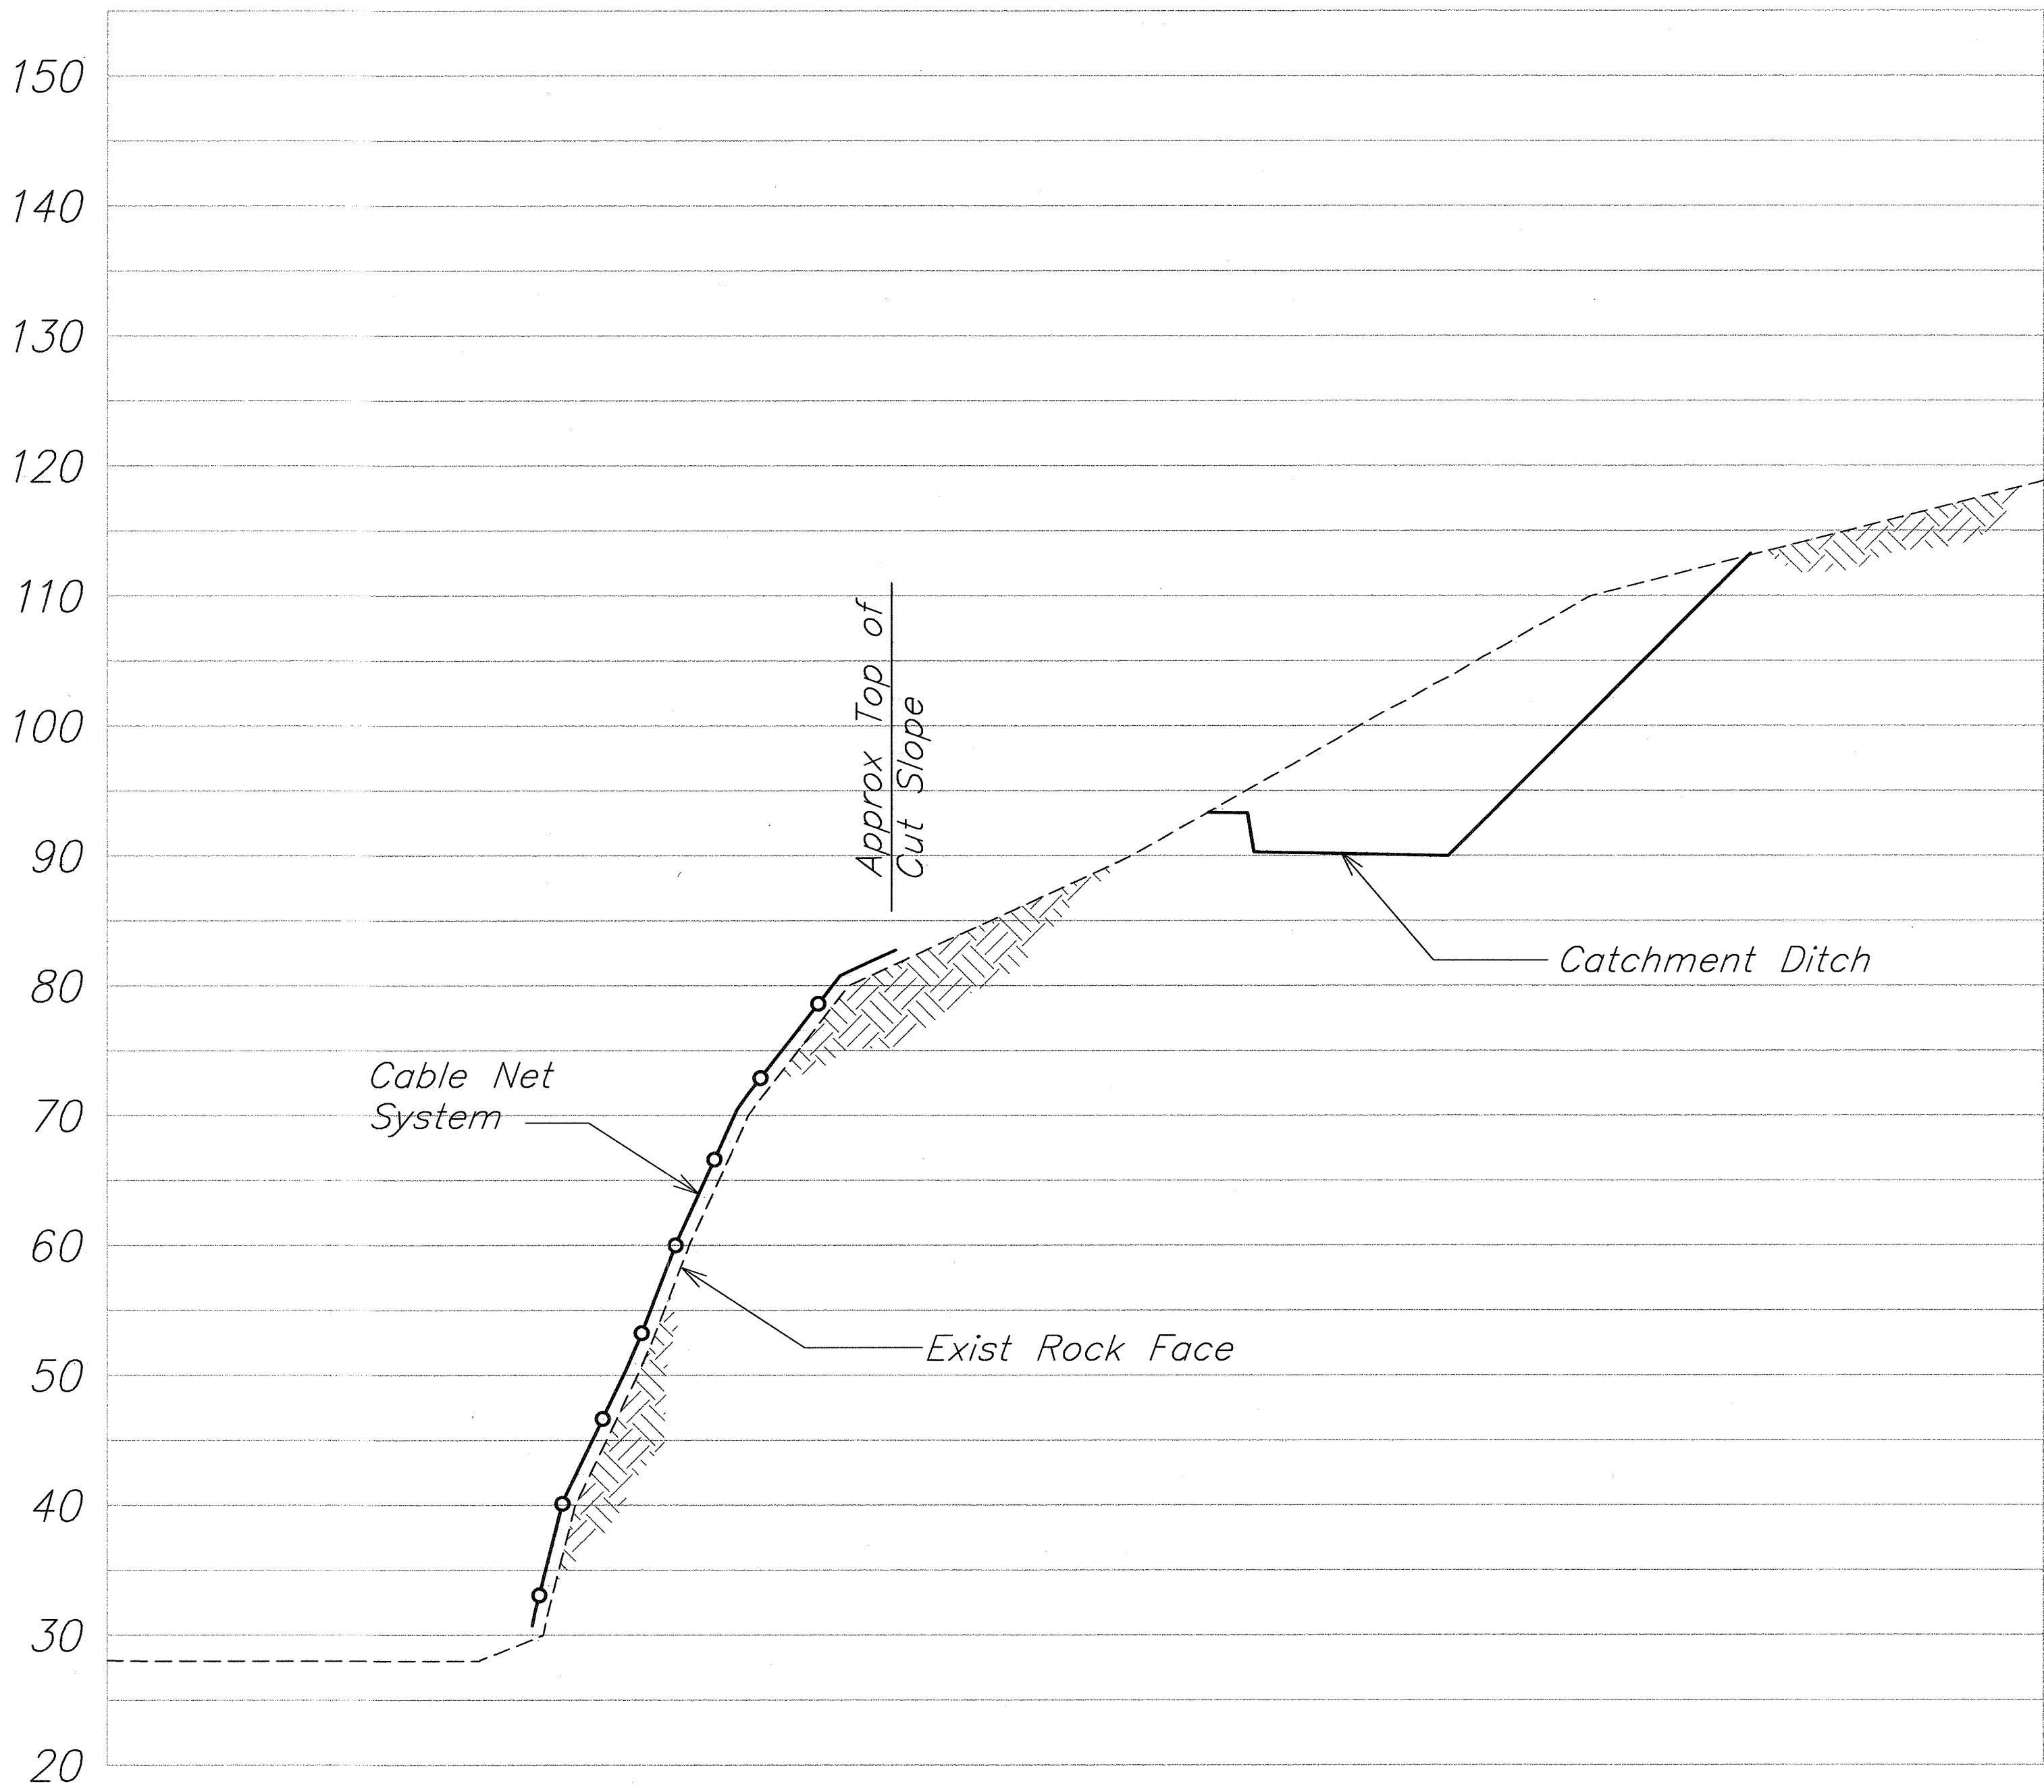


**A** **TYPICAL SECTION**  
 10 (STA 348+80± to STA ~~352+00±~~ 353+00)  
 SCALE: 1" = 10'

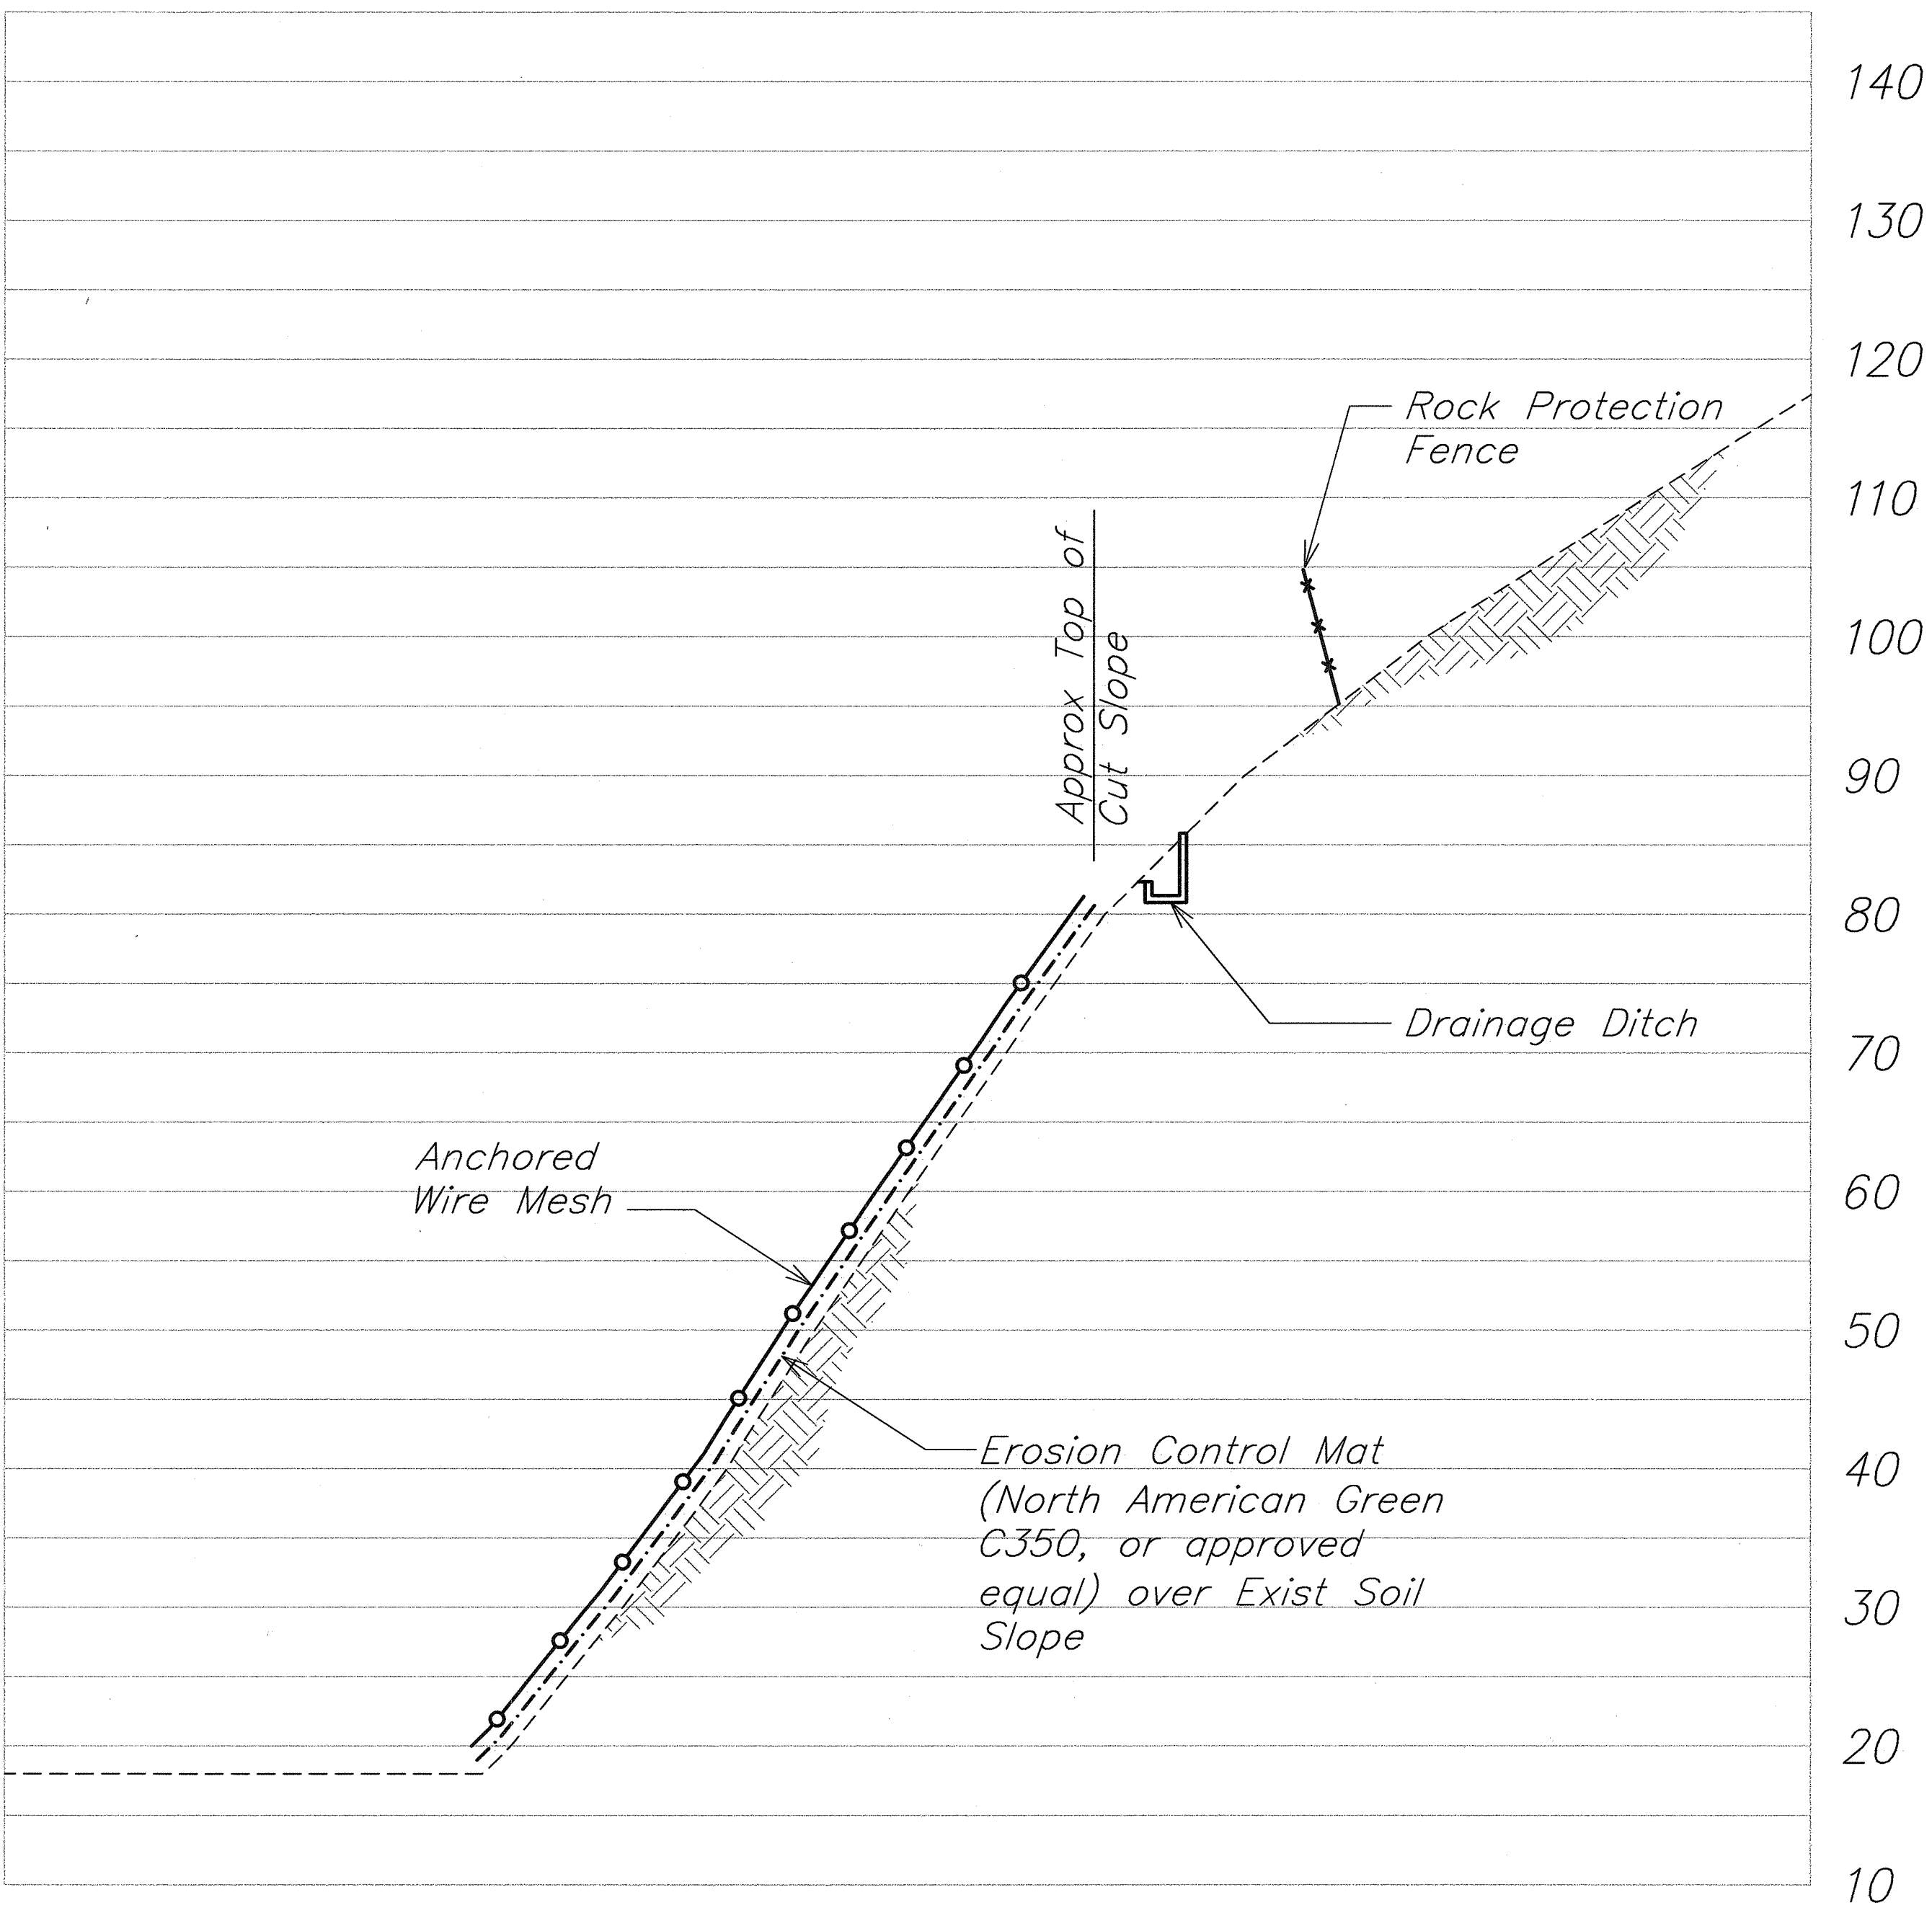

**B** **TYPICAL SECTION**  
 10 (STA ~~353+00±~~ to STA 360+19±) 352+87  
 SCALE: 1" = 10'

LEGEND FOR AS-BUILT POSTINGS	
	Squiggly line for as-built deletion
	Double line for as-built deletion
Roadway	Text for as-built posting

**EarthTech**  
 A tyco International Ltd. Company

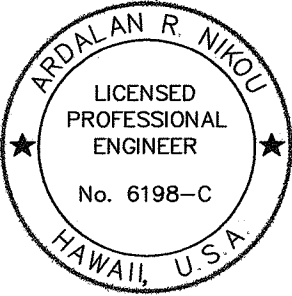

EXPIRATION DATE OF THE LICENSE: 4/30/2008  
 THIS WORK WAS PREPARED BY ME OR UNDER MY SUPERVISION.

STATE OF HAWAII  
DEPARTMENT OF TRANSPORTATION  
HIGHWAYS DIVISION

**TYPICAL CROSS SECTIONS**  
  
KAILUA ROAD PERMANENT  
ROCKFALL AND LANDSLIDE MITIGATION  
PROJECT NO. 61D-02-06  
  
Scale: As Noted      Date: Aug 2006  
SHEET No. 1 OF 1 SHEETS

"AS-BUILT"