

INDEX TO DRAWINGS	
SHEET NO.	DESCRIPTION
1	TITLE SHEET
2	STANDARD PLANS SUMMARY
3	GENERAL NOTES & LEGEND
4-5	WATER POLLUTION & EROSION CONTROL NOTES
6-7	EROSION CONTROL MAT DETAILS
8	SITE PLAN
9-11	ROADWAY PLANS
12	WORK ZONE SIGNING, PLAN, NOTES & DETAILS
13-15	DETOUR PLAN

STATE OF HAWAII

DEPARTMENT OF TRANSPORTATION

HIGHWAYS DIVISION

HONOLULU, HAWAII

"AS-BUILT"

PLANS FOR



PALI HIGHWAY SLOPE STABILIZATION

VICINITY OF FIRST PALI TUNNEL

PROJECT NO. 61A-01-07M

DISTRICT OF HONOLULU

ISLAND OF OAHU

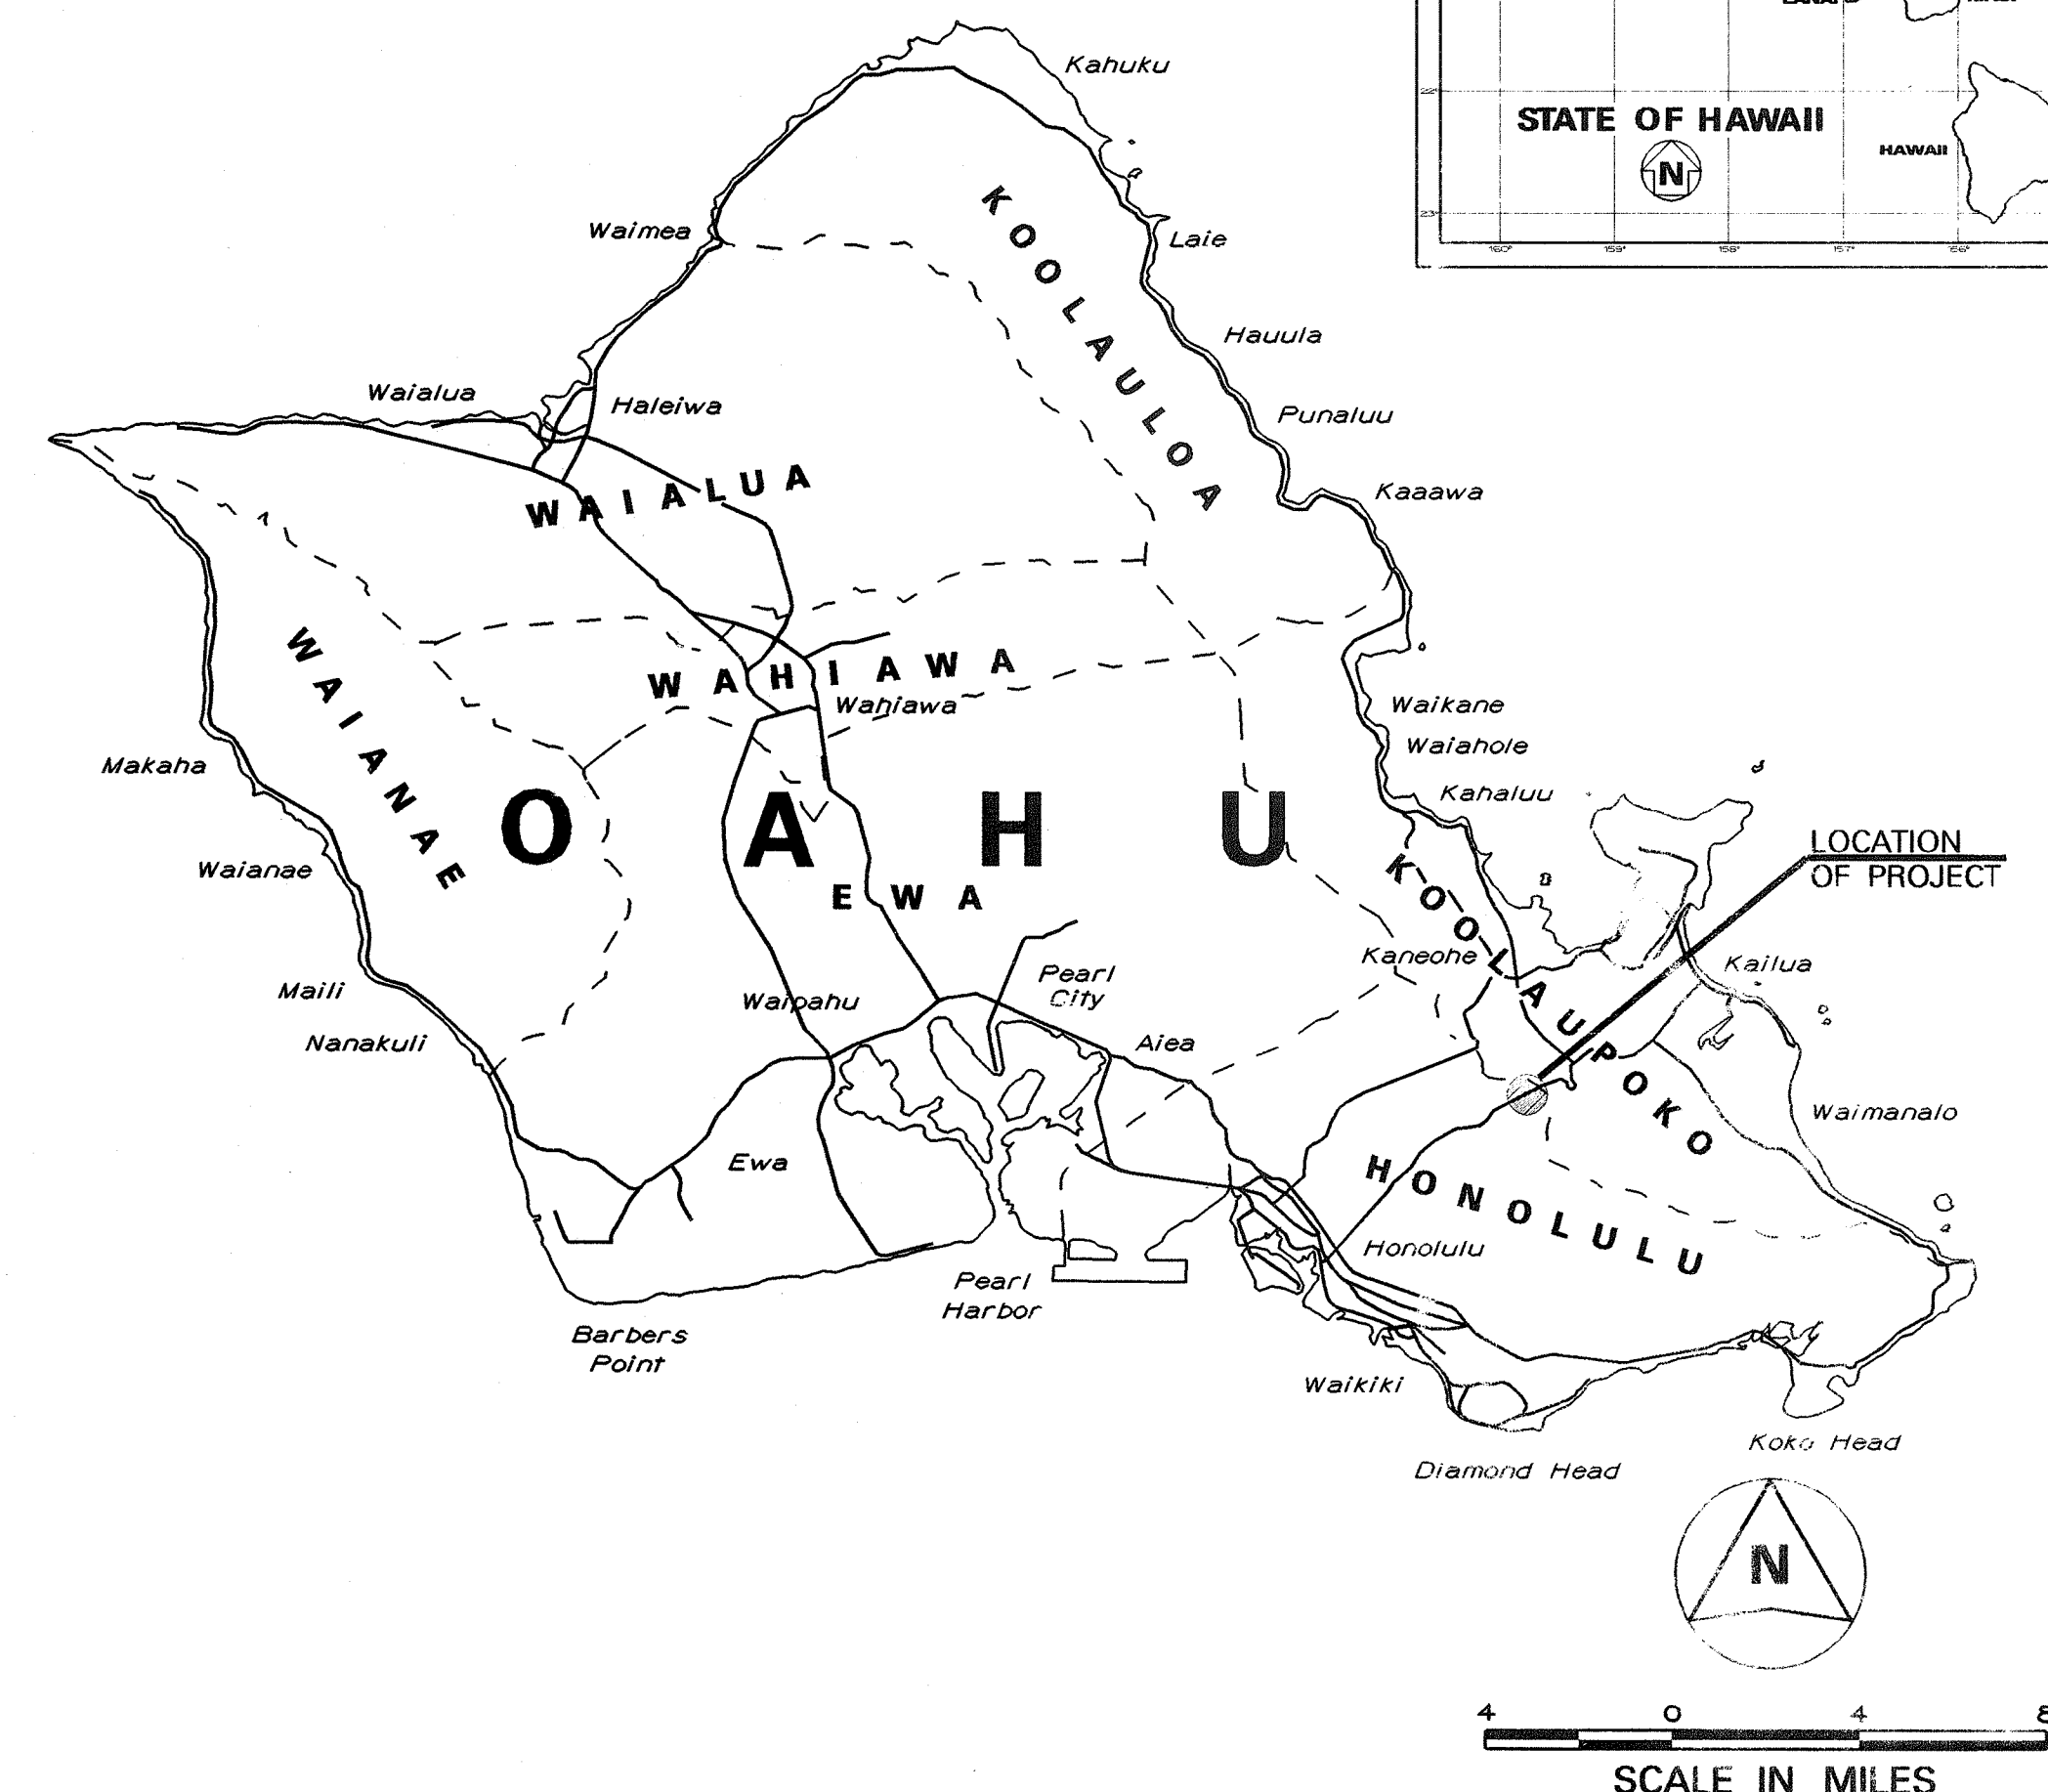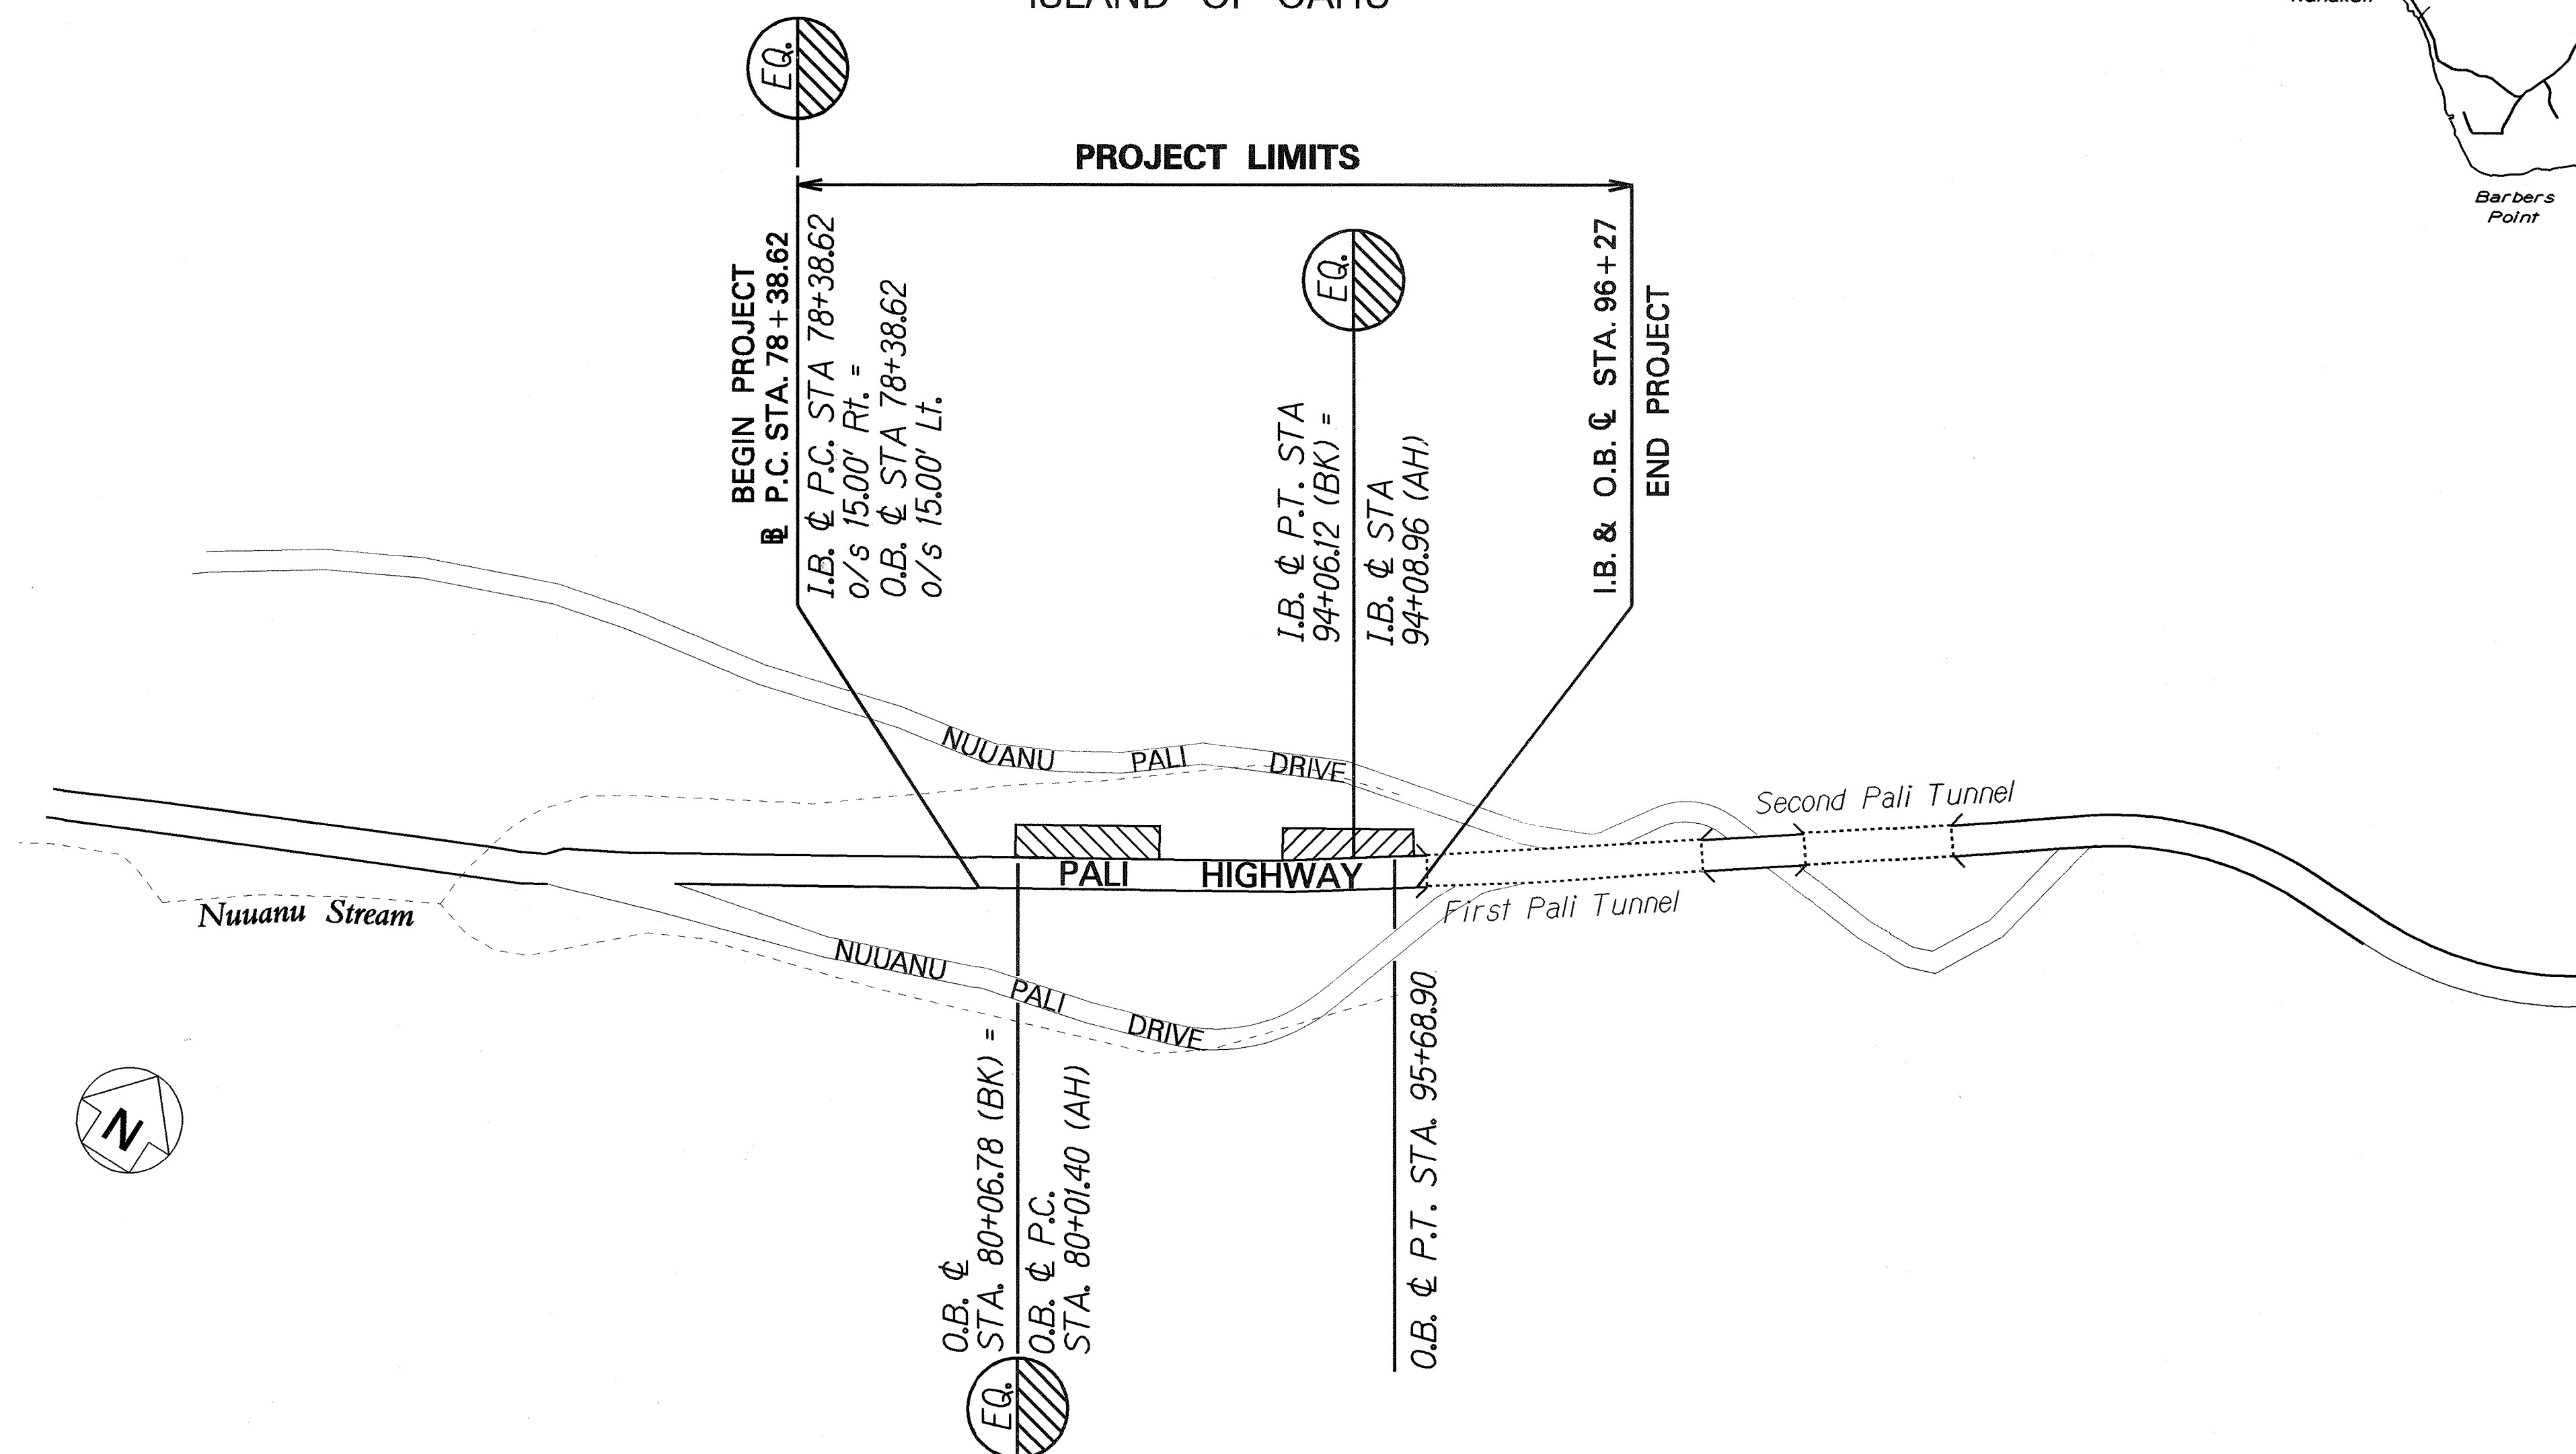

MILE POST 5.43 TO MILE POST 5.44

MILE POST 5.67 TO MILE POST 5.69

CHANGES MADE DURING CONSTRUCTION HAVE BEEN INCORPORATED ON THESE PLANS EXCEPT CHANGES IN THE ORIGINAL THEORETICAL QUANTITIES. FOR ACTUAL QUANTITIES, REFER TO PROJECT LEDGER AND/OR COMPUTATION BOOK.

3-12-2013

DATE

DEPARTMENT OF TRANSPORTATION

STATE OF HAWAII

APPROVED:

2-15-08

DATE

HWY-DD DESIGNED BY

HWY-DD MANAGED BY

692-7570 PHONE

8/07 DATE

