


FED. ROAD DIST. NO.	STATE	PROJ. NO.	FISCAL YEAR	SHEET NO.	TOTAL SHEETS
HAWAII	HAW.	61A-01-10M	2010	ADD.7	9

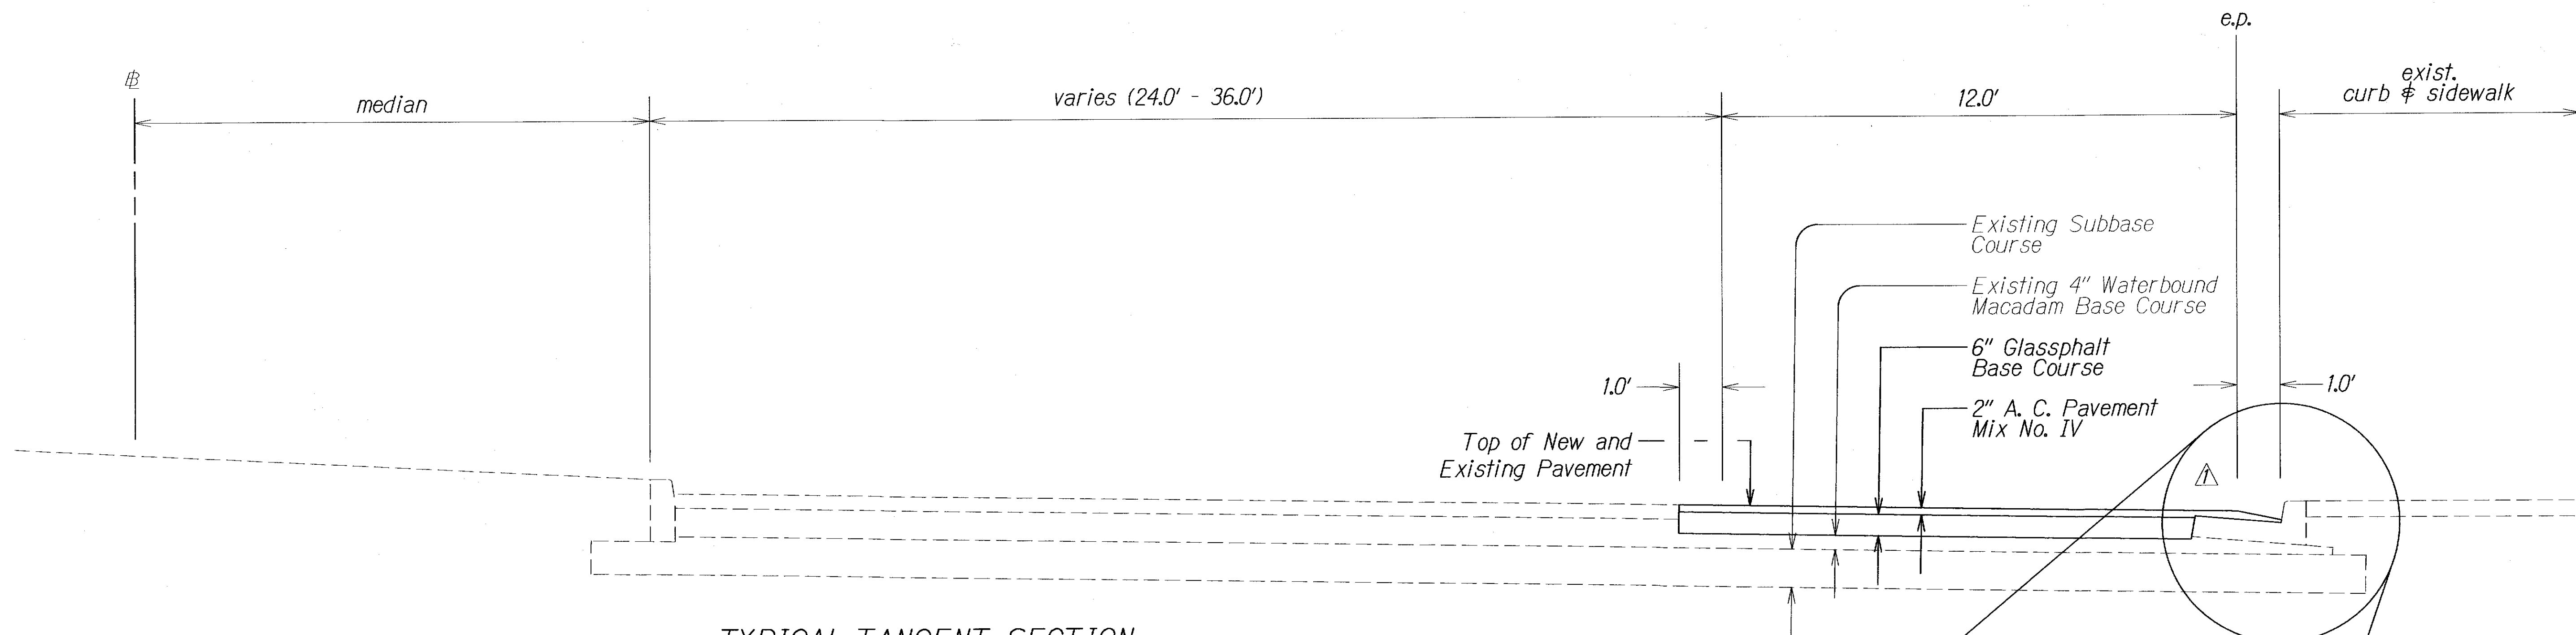


TYPICAL TANGENT SECTION

Scale: 1/2" = 1'

Notes: If aggregate in the existing waterbound macadam base course are loose and cannot be locked together through extensive rolling, remove the 4" WBM Base Course layer to the top of the existing subbase course and replace with Glassphalt Base Course. Removal and replacement of WBM course layer to be paid under Item No. 202.1000 Removal of Existing Water bound Macadam Base Course.

Post Construction Notes:  
Aggregate in the existing waterbound macadam base course were not loose. Rolling, removal, and/or replacement were not necessary.

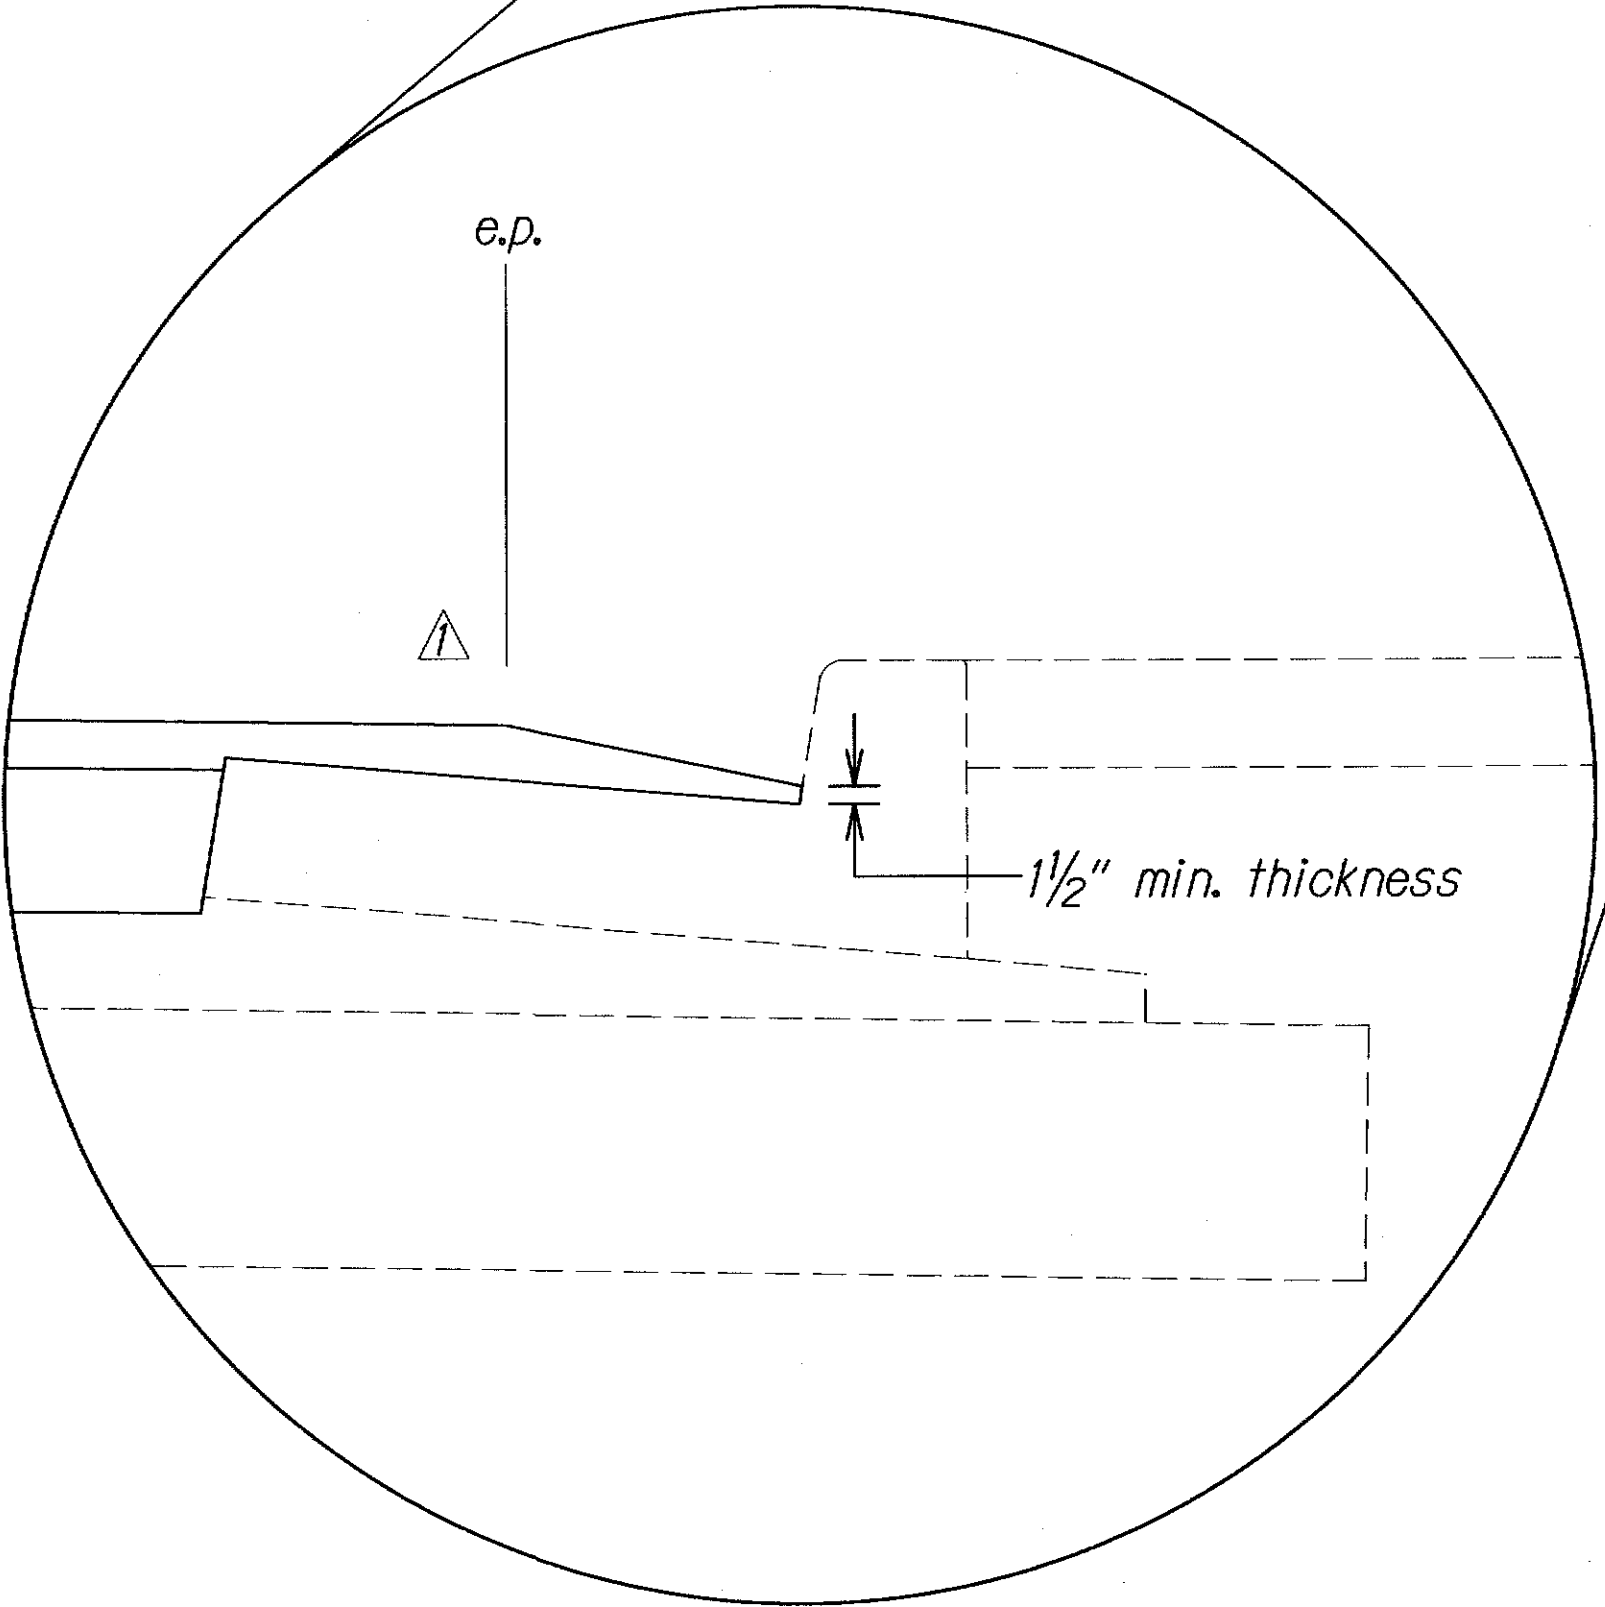

LEGEND FOR AS-BUILT POSTINGS	
	Squiggly line for as-built deletion
	Double line for as-built deletion
Roadway	Text for as-built posting

6/23/10	Revised Typical Tangent Section Detail
DATE	REVISION
STATE OF HAWAII DEPARTMENT OF TRANSPORTATION HIGHWAYS DIVISION	
<u>TYPICAL SECTION</u>	
PALI HIGHWAY PAVEMENT REPAIRS Vicinity of Laimi Road towards Puiwa Road Project No. 61A-01-10M	
Scale: As Shown	Date: April, 2010
SHEET No. 1 OF 1 SHEETS	

SURVEY PLOTTED BY	DATE
DRAWN BY	
DESIGNED BY	
QUANTITIES BY	
CHECKED BY	
ORIGINAL PLAN	
NOTE BOOK	
6/23/10	
N. J. J. J.	

"AS-BUILT"

ADD.7