
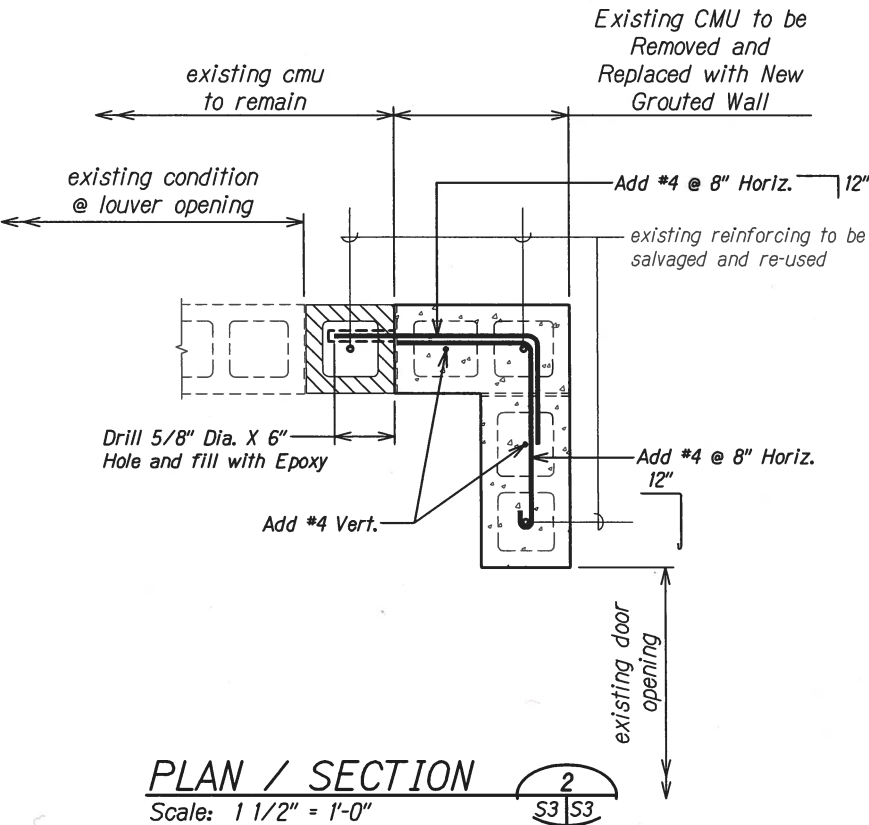


FED. ROAD DIST. NO.	STATE	FEDERAL AID PROJ. NO.	FISCAL YEAR	SHEET NO.	TOTAL SHEETS
HAWAII	HAW.	ER-22(001)	2019	00	--

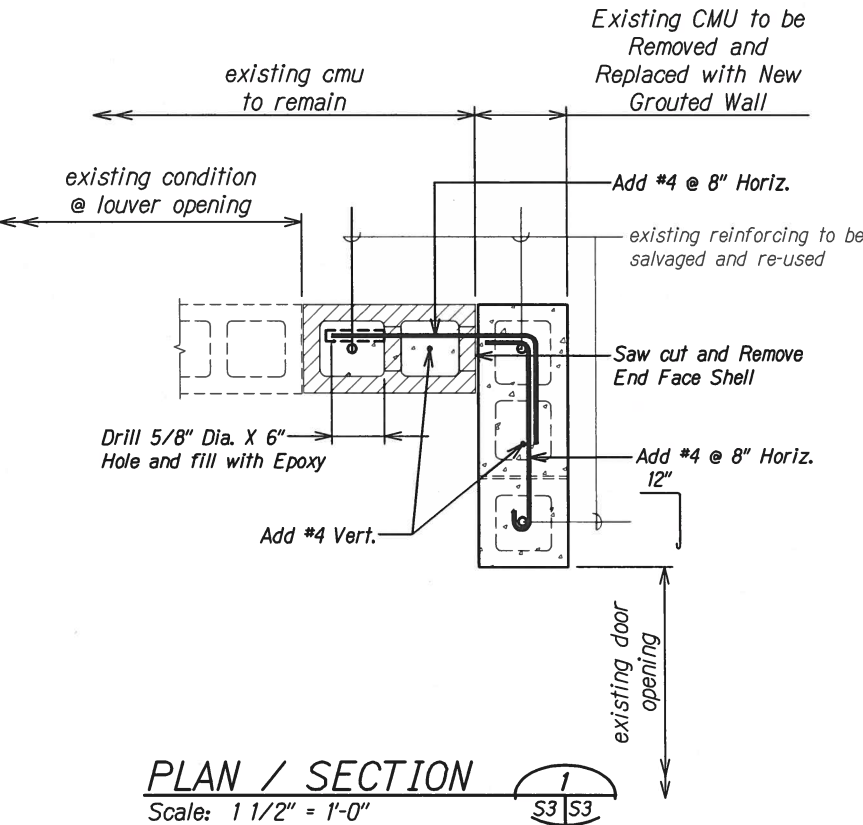

ORIGINAL PLAN	SURVEY PLOTTED BY	DATE
NOTE BOOK	DRAWN BY	
No. _____	TRACED BY	
	CHECKED BY	
	QUANTITIES BY	
	CHECKED BY	

DRAWING NAME: Z:\00 ONGOING\00 CB PROJECTS\19-000-PALI TUNNEL-WSP\01 CAD\04-22-19 ELEC BLDG\PEB-S001 ELEC BLDG.DWG PLOT TIME: 04-19-19, 9:00 AM

STATE OF HAWAII
DEPARTMENT OF TRANSPORTATION
HIGHWAYS DIVISION

REPAIR DETAILS

PALI HIGHWAY DEBRIS REMOVAL AND
EMERGENCY SLOPE STABILIZATION PROJECT
FAP Proj. No. ER-22(001)
Scale: As Noted Date: April 19, 2019
SHEET No. S3 OF 00 SHEETS

"AS-BUILT"