



FED. ROAD DIST. NO.	STATE	FEDERAL AID PROJ. NO.	FISCAL YEAR	SHEET NO.	TOTAL SHEETS
HAWAII	HAW.	ER-22(001)	2019	00	--

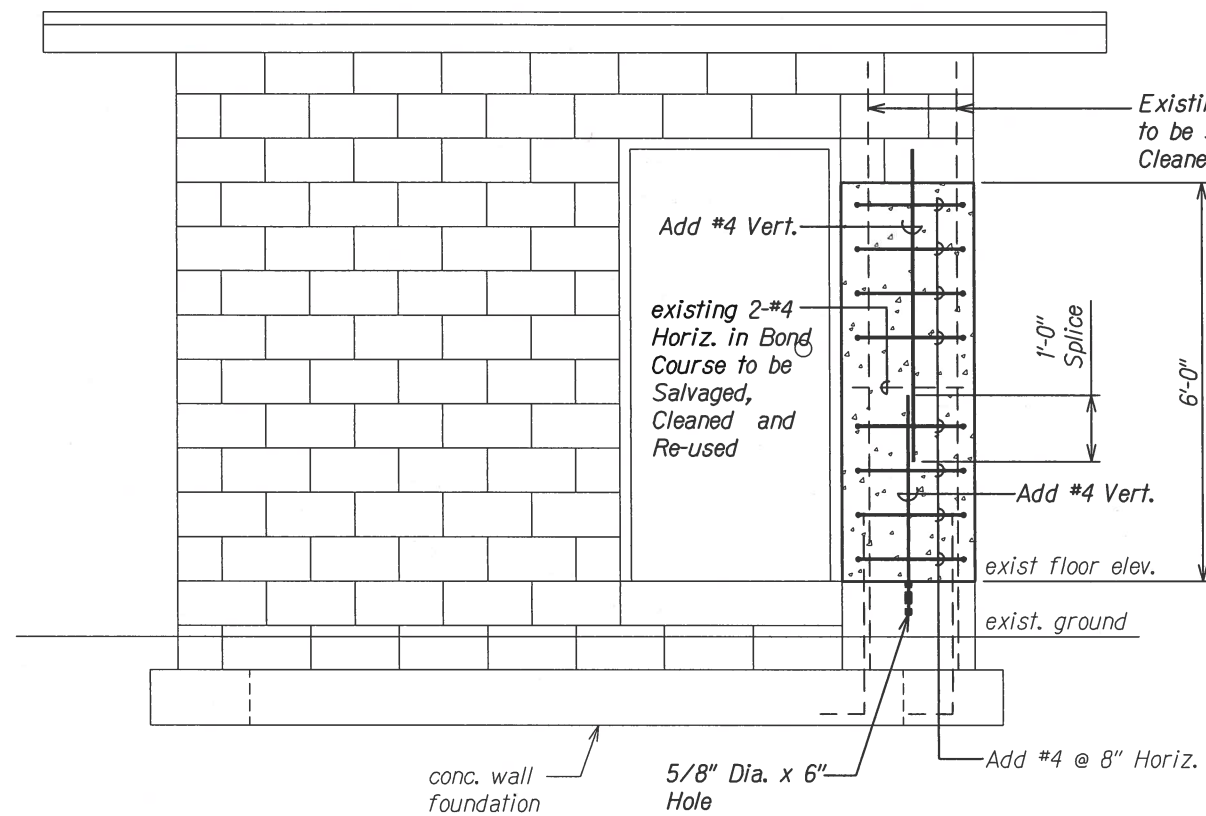

REPAIR ELEVATION A
Scale: 3/8" = 1'-0"

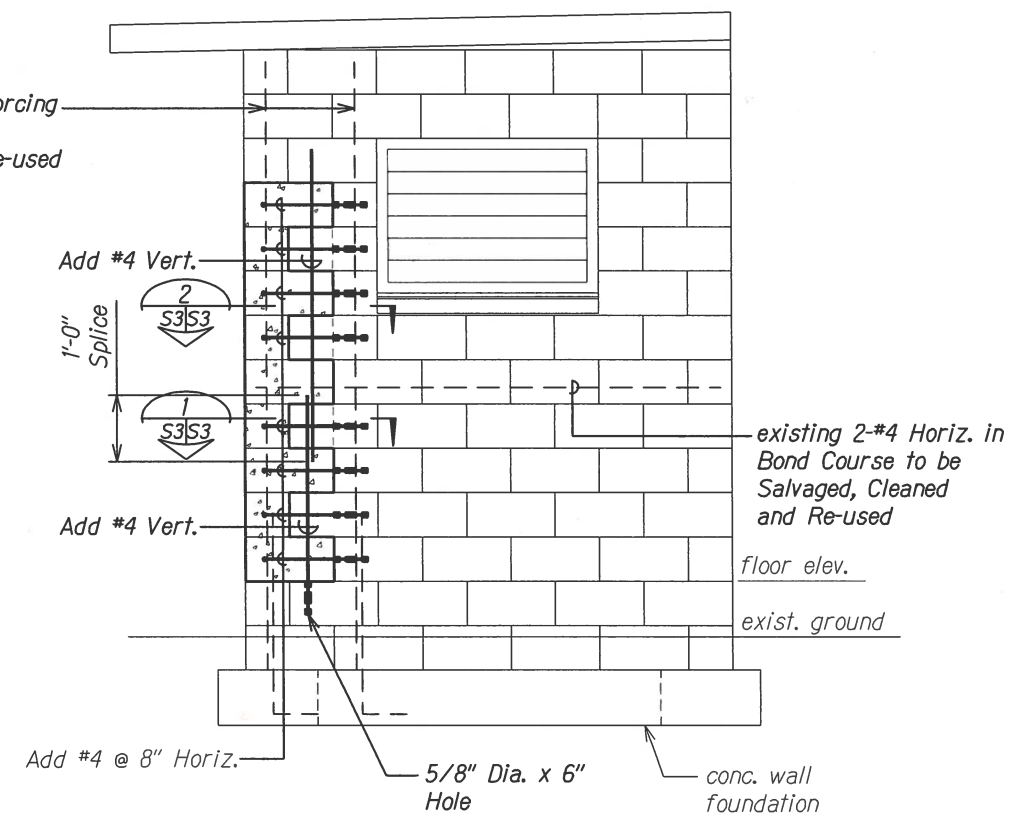

REPAIR ELEVATION B
Scale: 3/8" = 1'-0"

ORIGINAL PLAN	SURVEY PLOTTED BY	DATE
NOTE BOOK	DESIGNED BY	
No.	QUANTITIES BY	
	CHECKED BY	

DRAWING NAME: Z:\00 ONGOING\00 CB PROJECTS\19-000-PALI TUNNEL-WSP\01 CAD\04-22-19 ELEC BLOCK\PEB-S001 ELEC BLOCK.DWG PLOT TIME: 04-19-19, 10:35 AM

STATE OF HAWAII
DEPARTMENT OF TRANSPORTATION
HIGHWAYS DIVISION

REPAIR ELEVATIONS

**PALI HIGHWAY DEBRIS REMOVAL AND
EMERGENCY SLOPE STABILIZATION PROJECT**
FAP Proj. No. ER-22(001)

Scale: As Noted Date: April 19, 2019

SHEET No. S2 OF 00 SHEETS

"AS-BUILT"

00