


FED. ROAD DIST. NO.	STATE	FEDERAL AID PROJ. NO.	FISCAL YEAR	SHEET NO.	TOTAL SHEETS
HAWAII	HAW.	ER-22(001)	2019	SHTNO	--



DATE	_____
DESIGNED BY	_____
TRACED BY	_____
NOTE BOOK	_____
QUANTITIES BY	_____
CHECKED BY	_____

DRAWING NAME: T:\PROJECTS\WORKING\7864-00_PALI HIGHWAY 7864-00SHEET\RA\RA01.DWG PLOT TIME: 03-25-19 4:17 PM

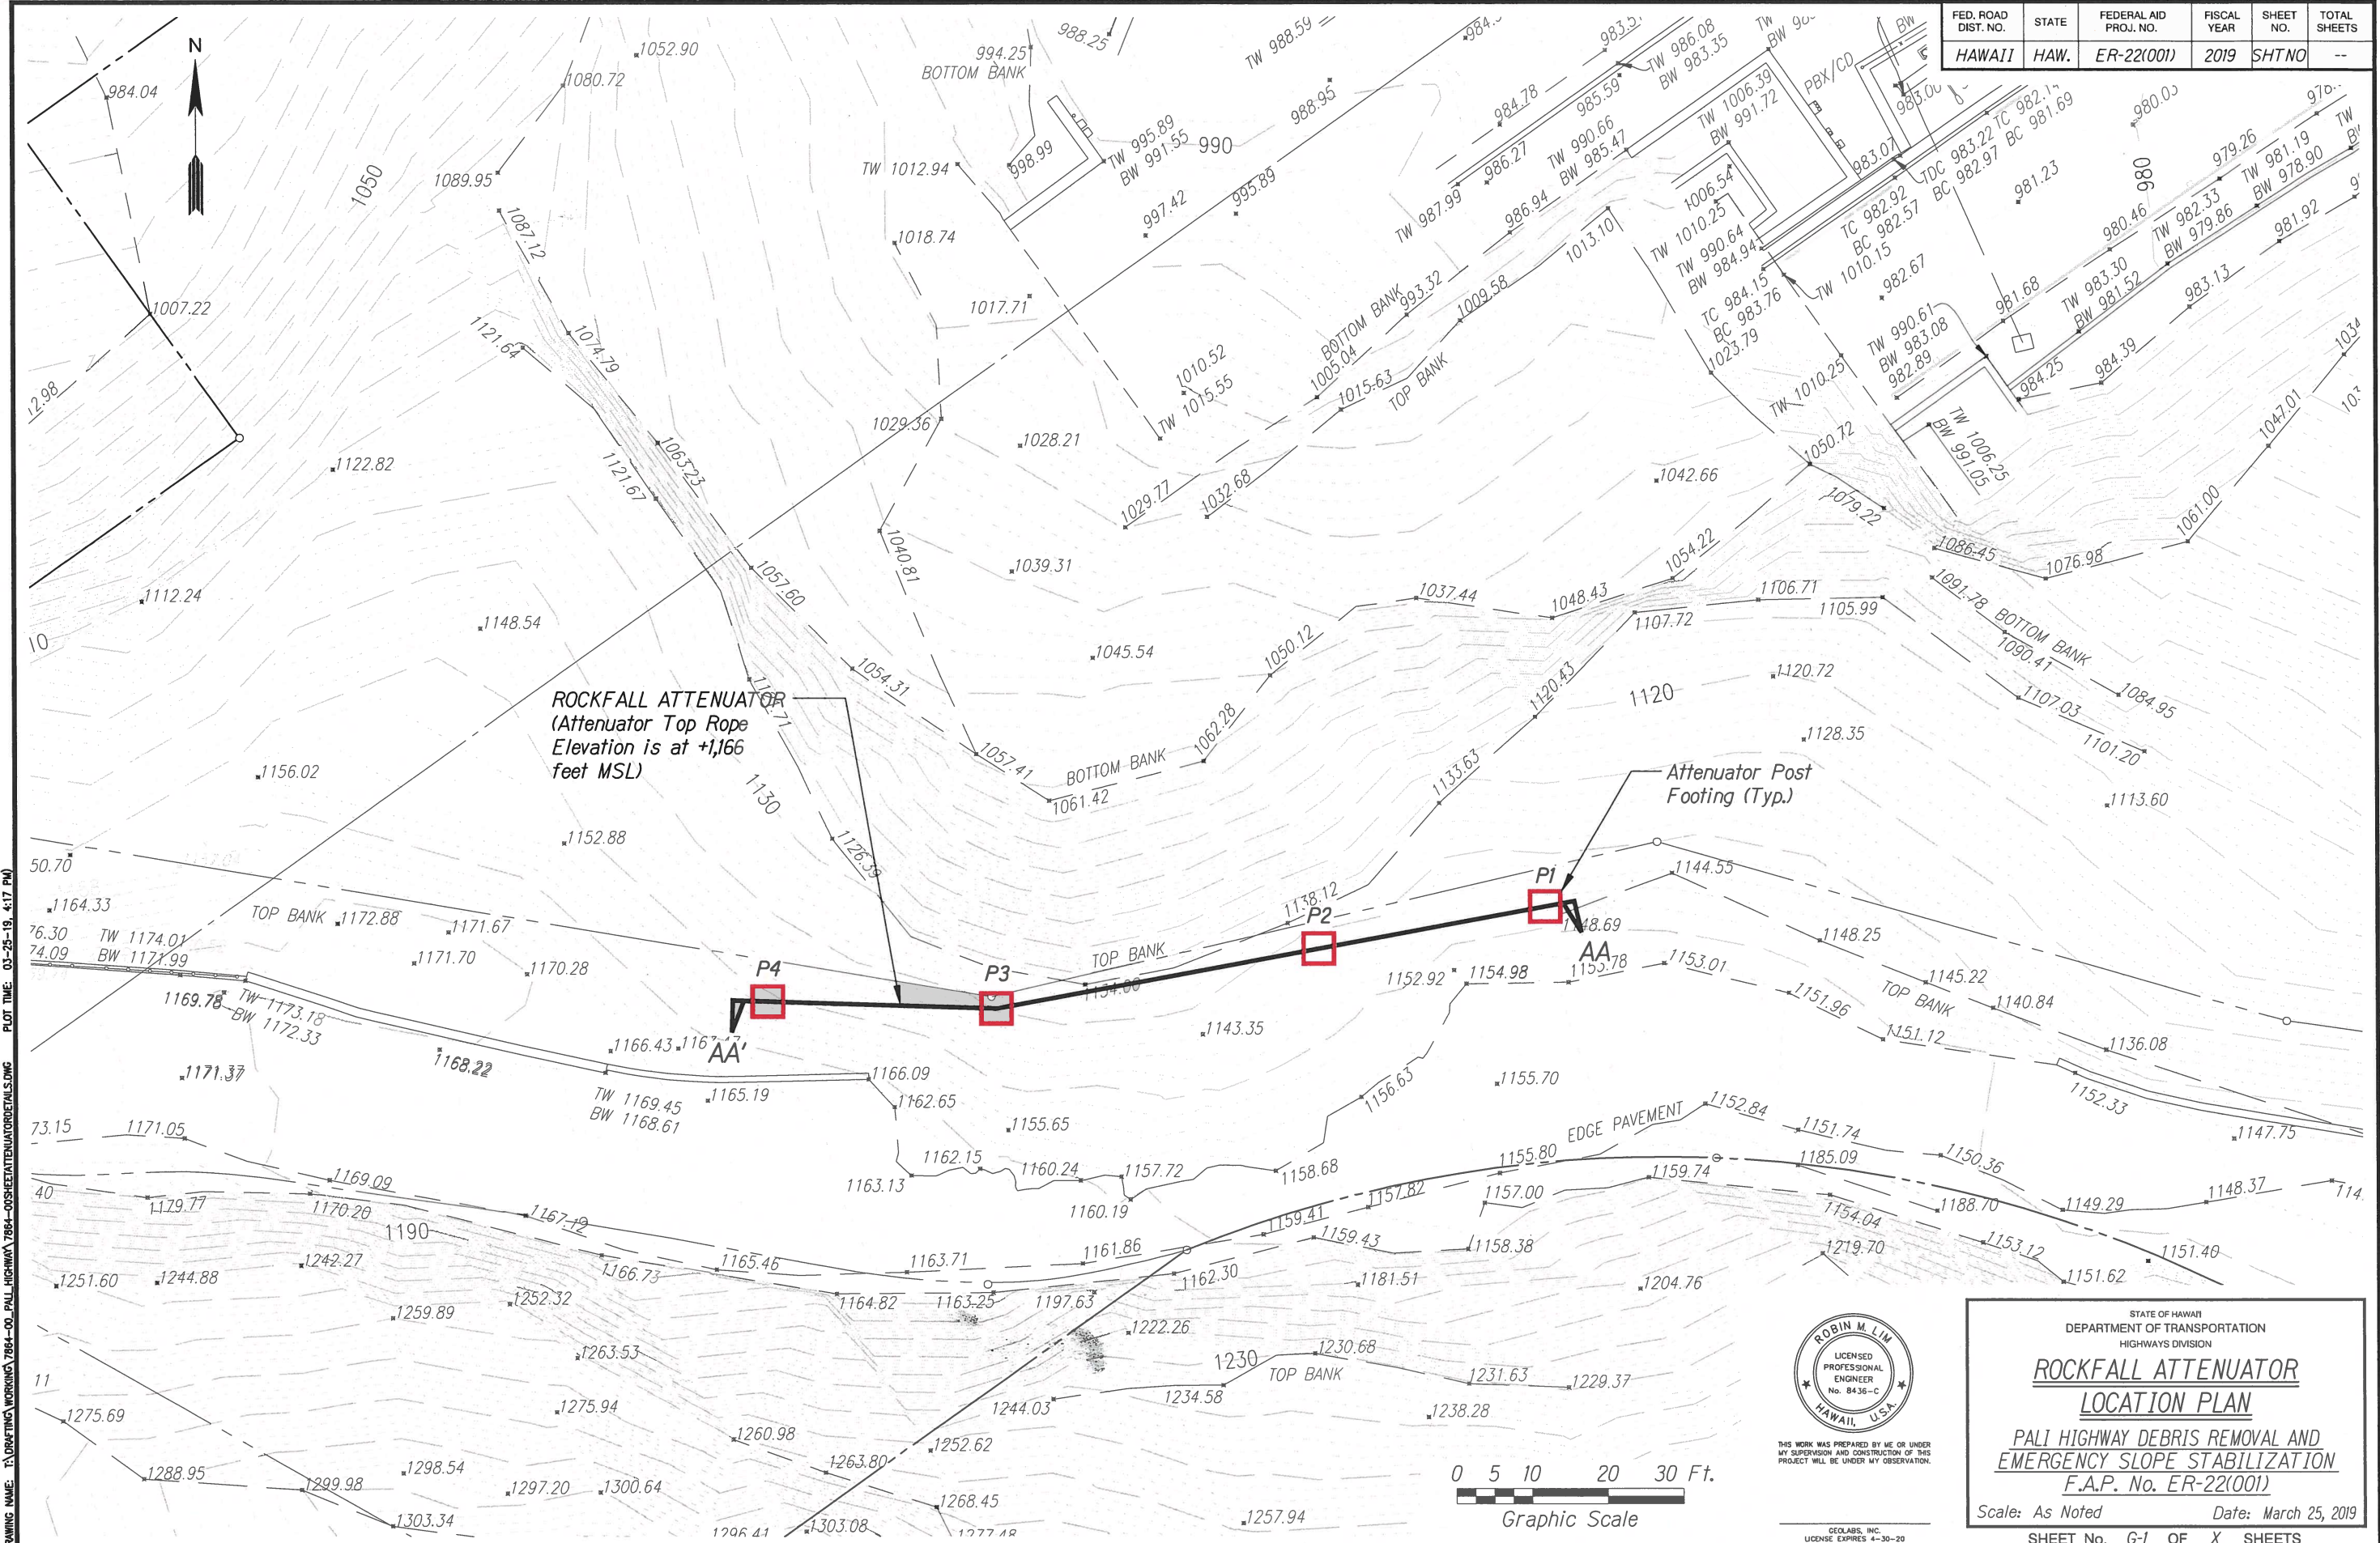

THIS WORK WAS PREPARED BY ME OR UNDER MY SUPERVISION AND CONSTRUCTION OF THIS PROJECT WILL BE UNDER MY OBSERVATION.

STATE OF HAWAII
DEPARTMENT OF TRANSPORTATION
HIGHWAYS DIVISION

ROCKFALL ATTENUATOR
LOCATION PLAN
PALI HIGHWAY DEBRIS REMOVAL AND
EMERGENCY SLOPE STABILIZATION
F.A.P. No. ER-22(001)

Scale: As Noted
Date: March 25, 2019

SHEET No. G-1 OF X SHEETS



PRELIMINARY 03-25-2019 - For Ordering Materials Only

"AS-BUILT"

SHT.NO.