


CAD User: HENRY File Last Updated: March 04, 2019 3:02:11pm Plot Date: March 04, 2019 - 3:27:33pm
File: T:\Drafting\Working\7864-00_Pali_Highway\7864-00SlopeRepairDetails.dwg\PLATE_3
Plotter: DWG To PDF-Geo.pc3 Plotstyle: GEOLABS-Standard-Half.ctb

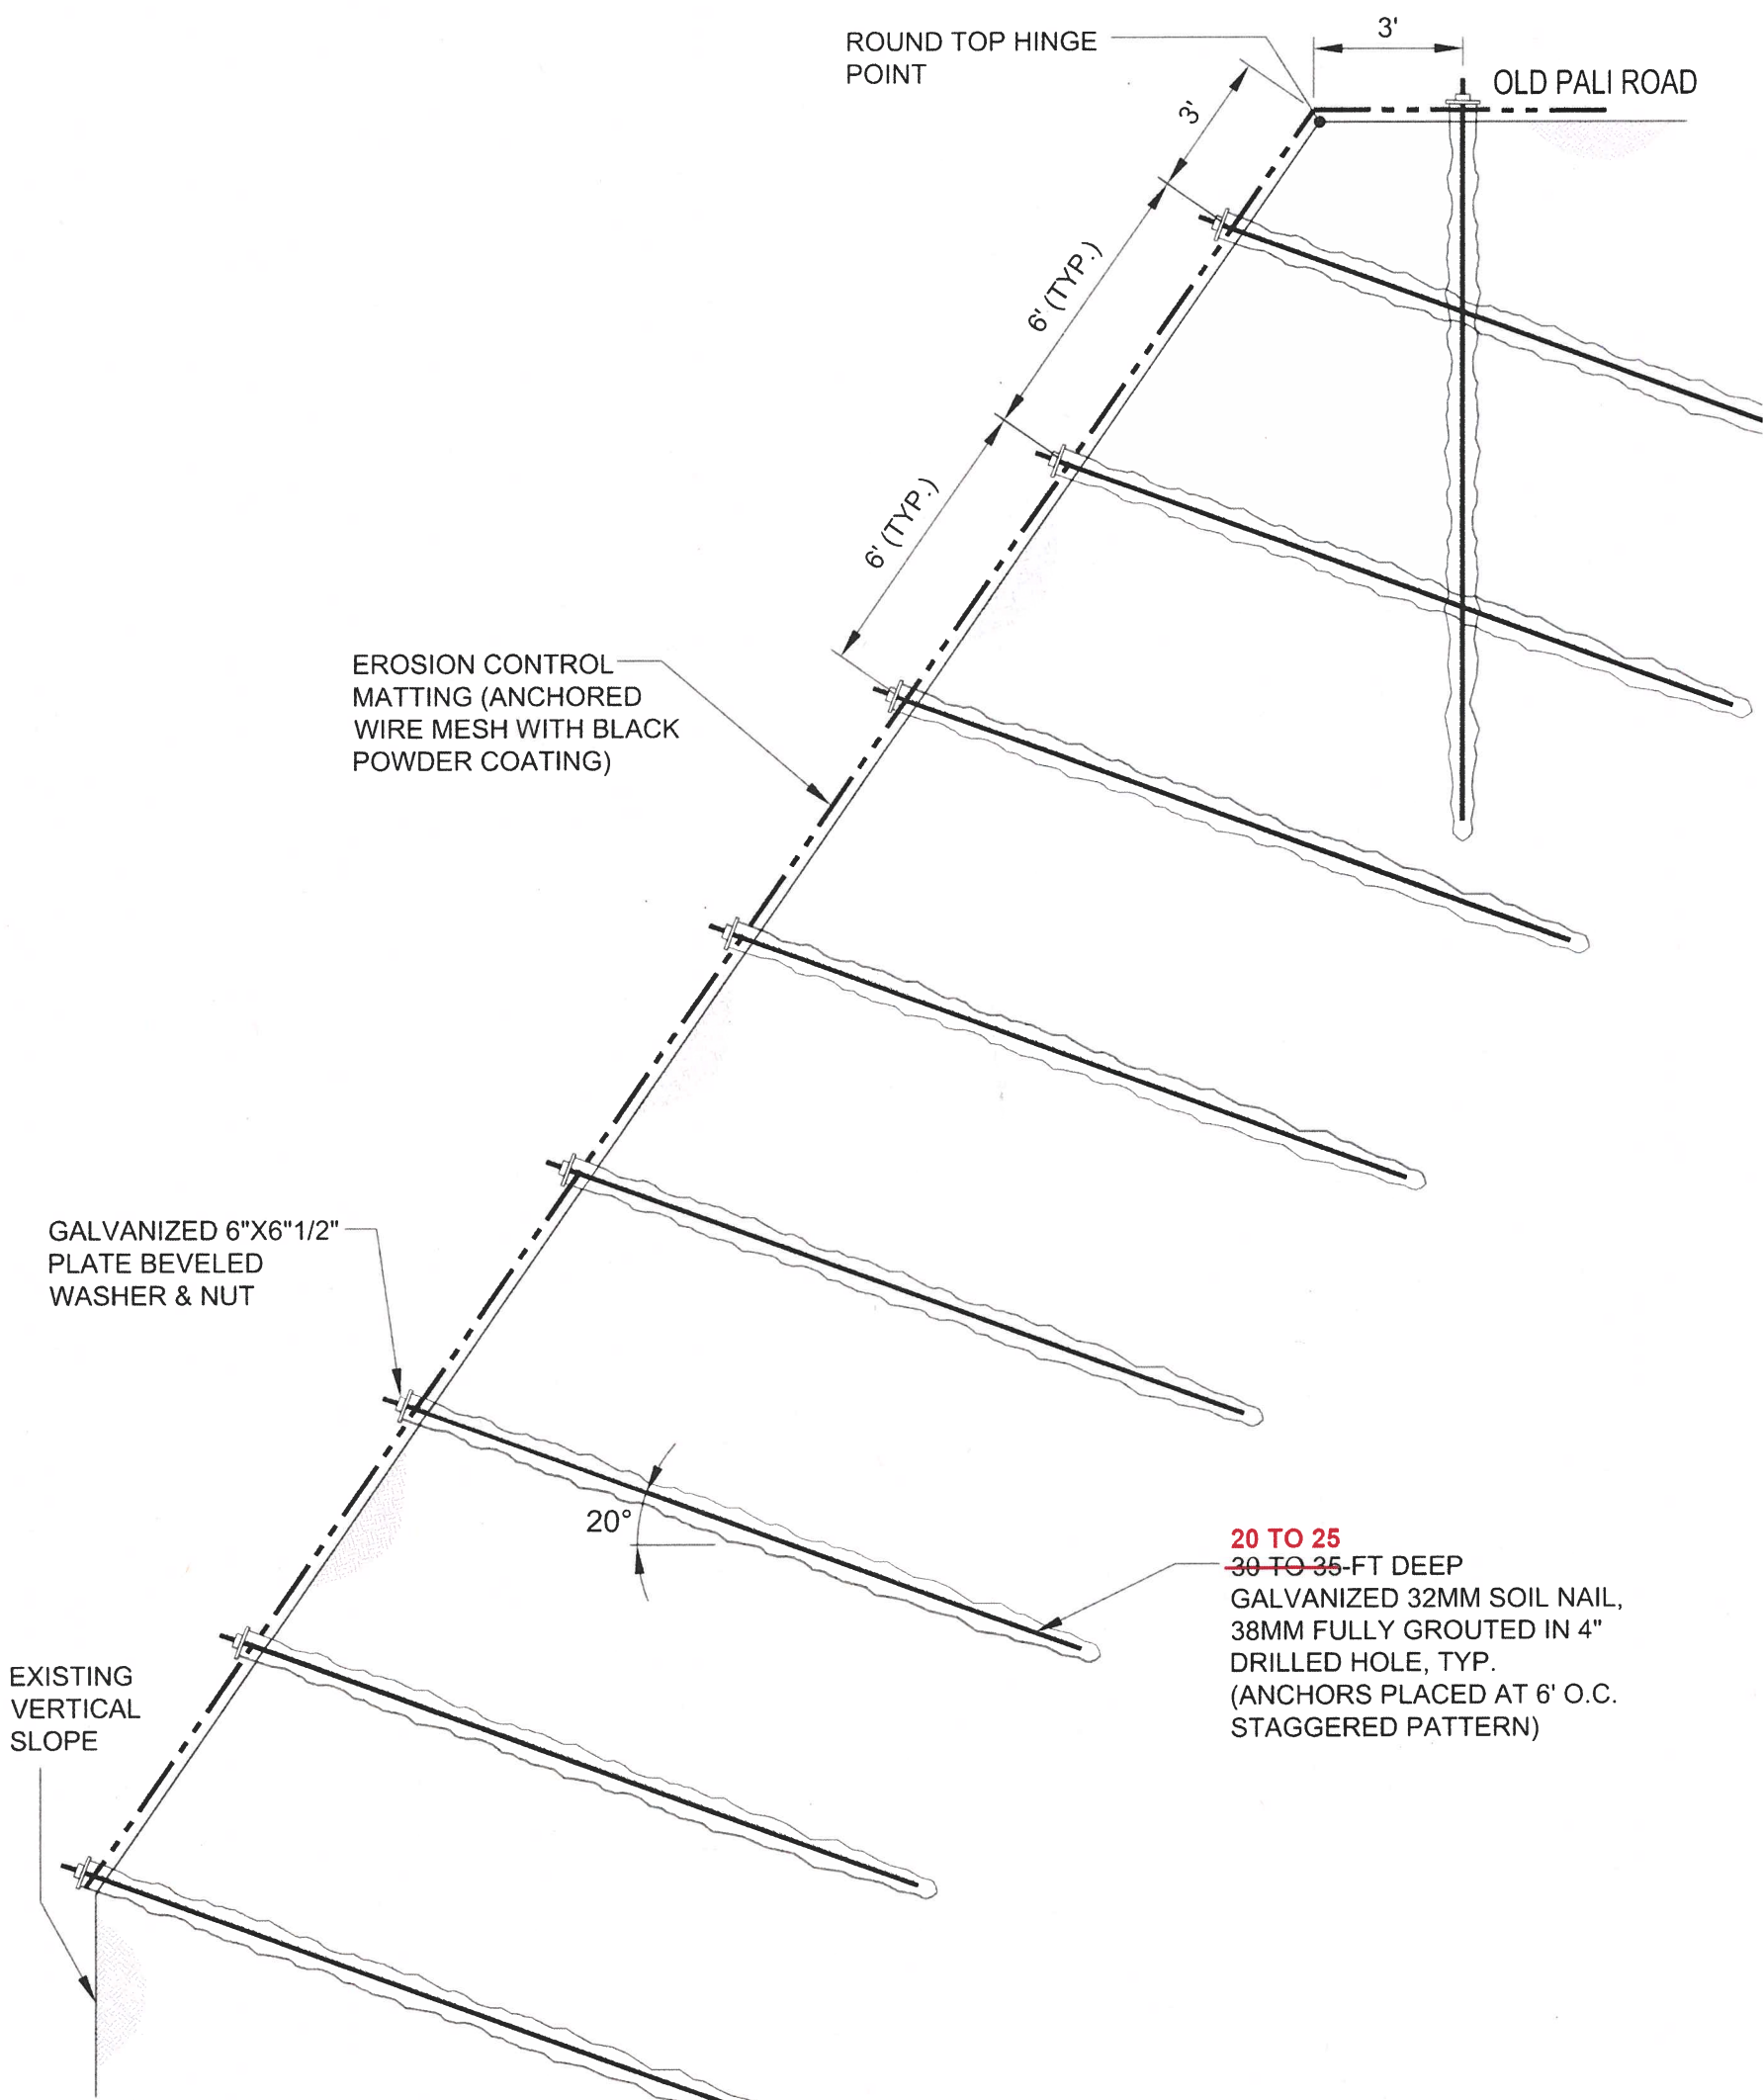

SLOPE STABILIZATION OF OLD PALI ROAD
TYPICAL SECTION - TASK 2

PALI HIGHWAY
DEBRIS REMOVAL AND
EMERGENCY SLOPE STABILIZATION
F.A.P. NO. ER-22(001)
HONOLULU, OAHU, HAWAII



GEOLABS, INC.

Geotechnical Engineering

DATE
FEBRUARY 2019

DRAWN BY
HYC

PLATE

SCALE
NOT TO SCALE

W.O.
7864-00

3

"AS-BUILT"