


TASK 1

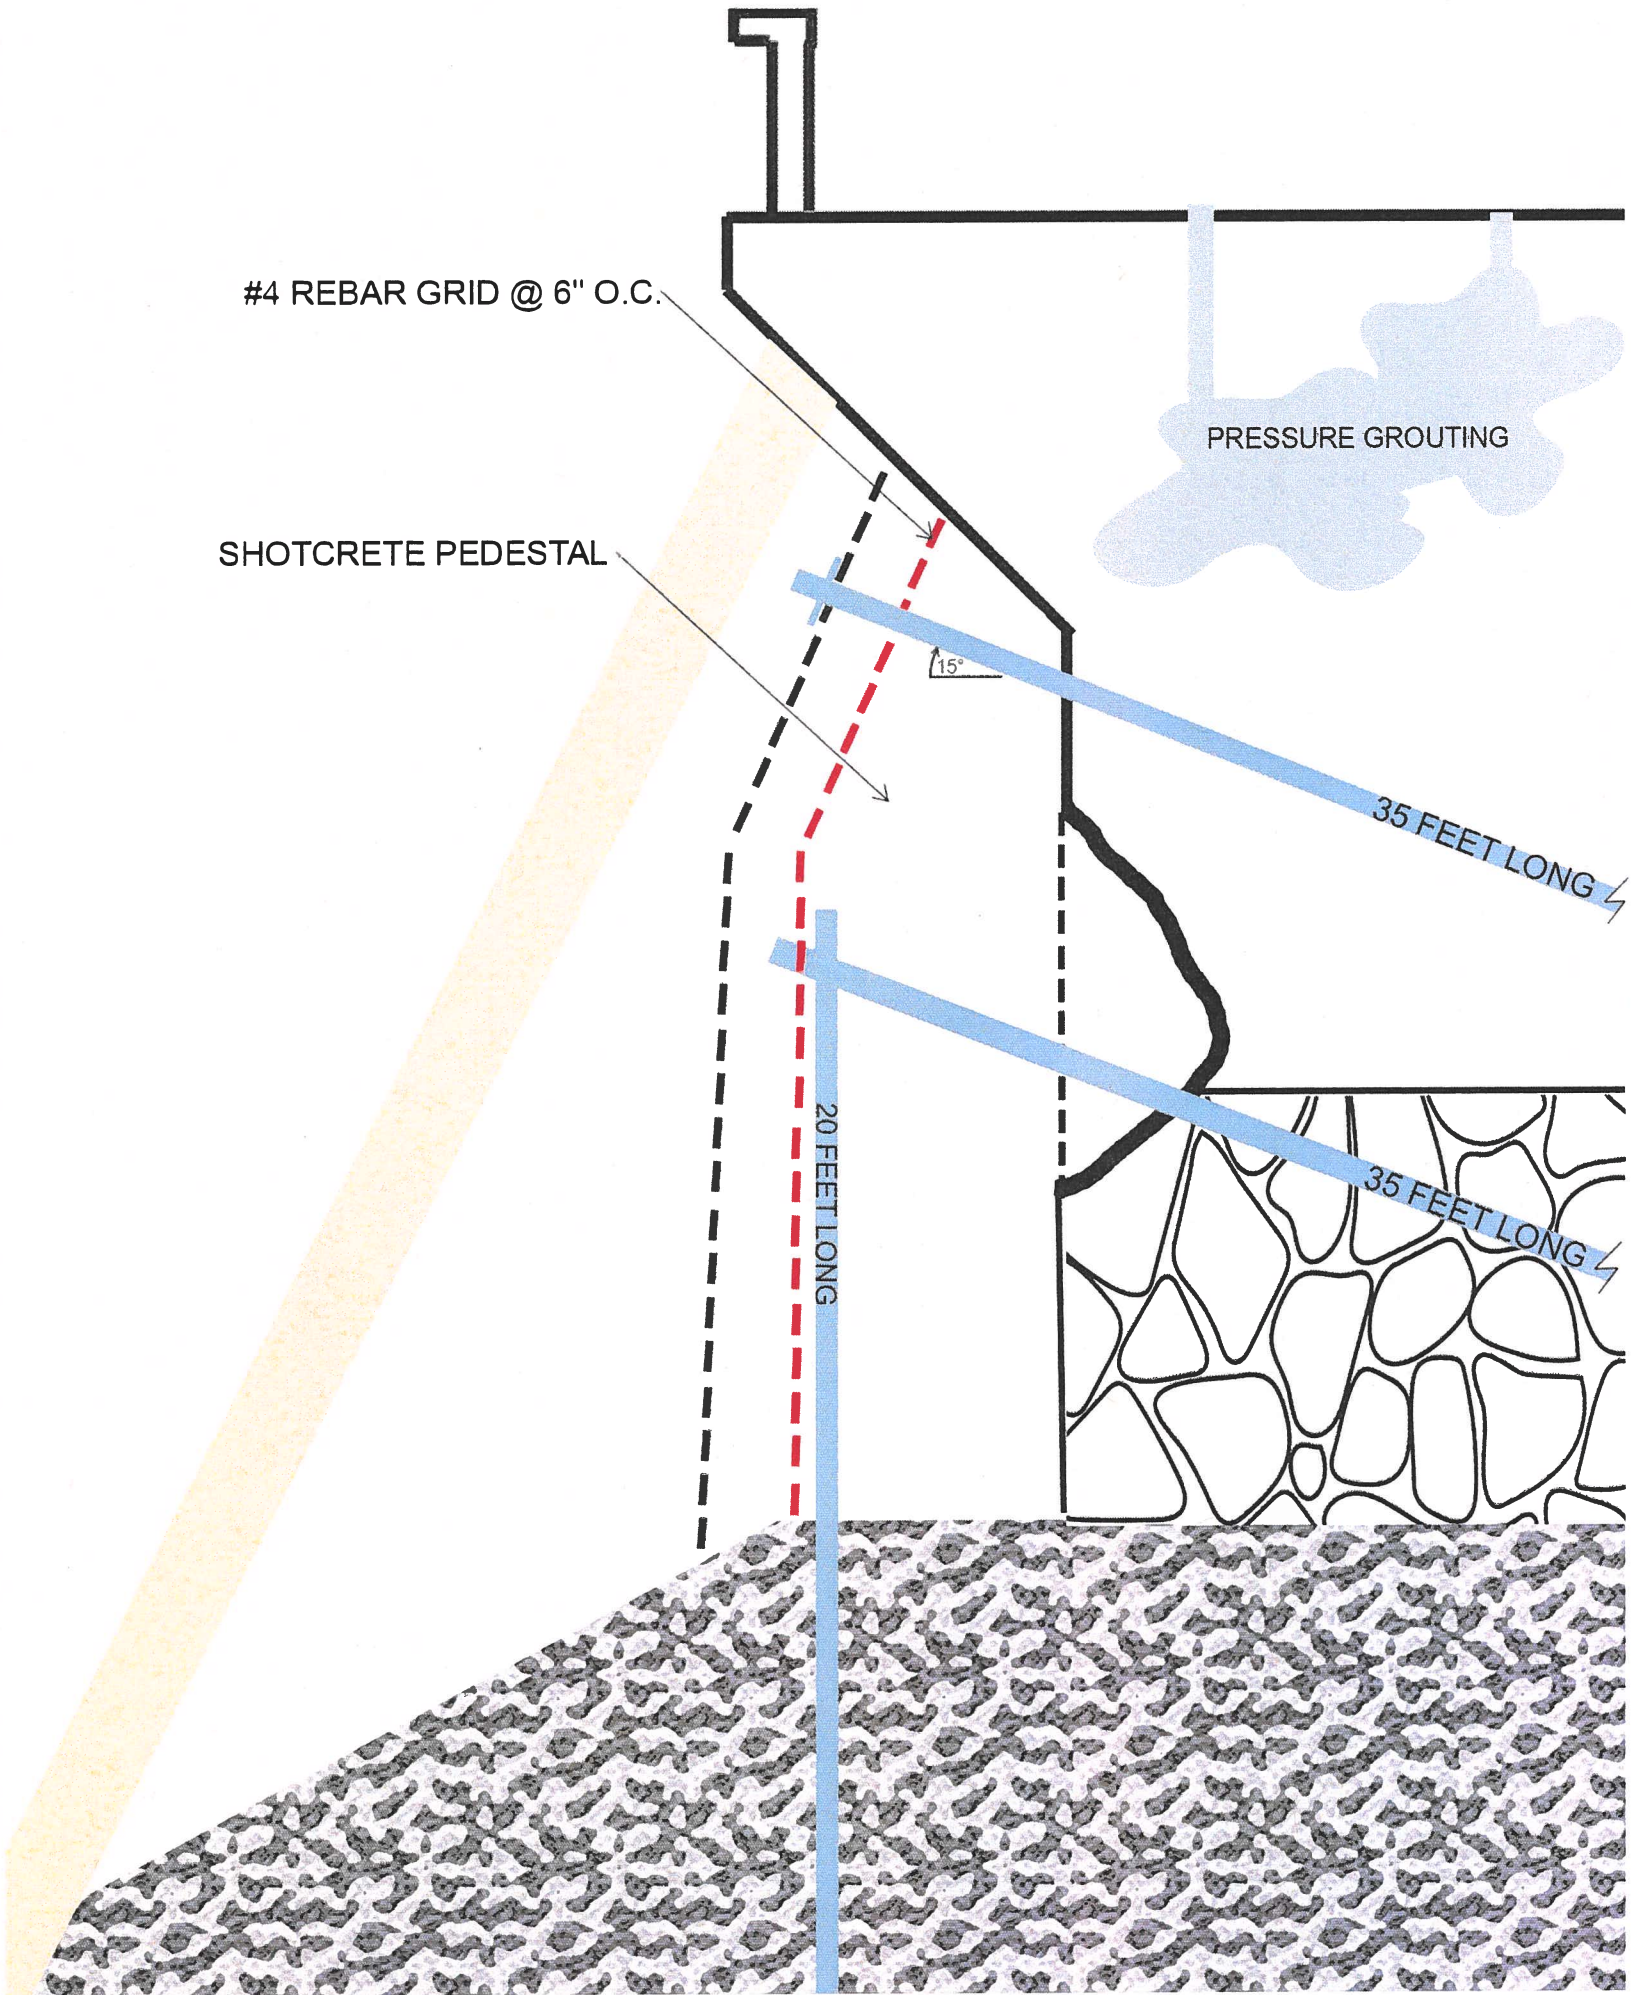

"AS-BUILT"