





FED. ROAD DIST. NO.	STATE	FEDERAL AID PROJ. NO.	FISCAL YEAR	SHEET NO.	TOTAL SHEETS
HAWAII	HAW.	ER-22(002)	2019	ADD 66	94

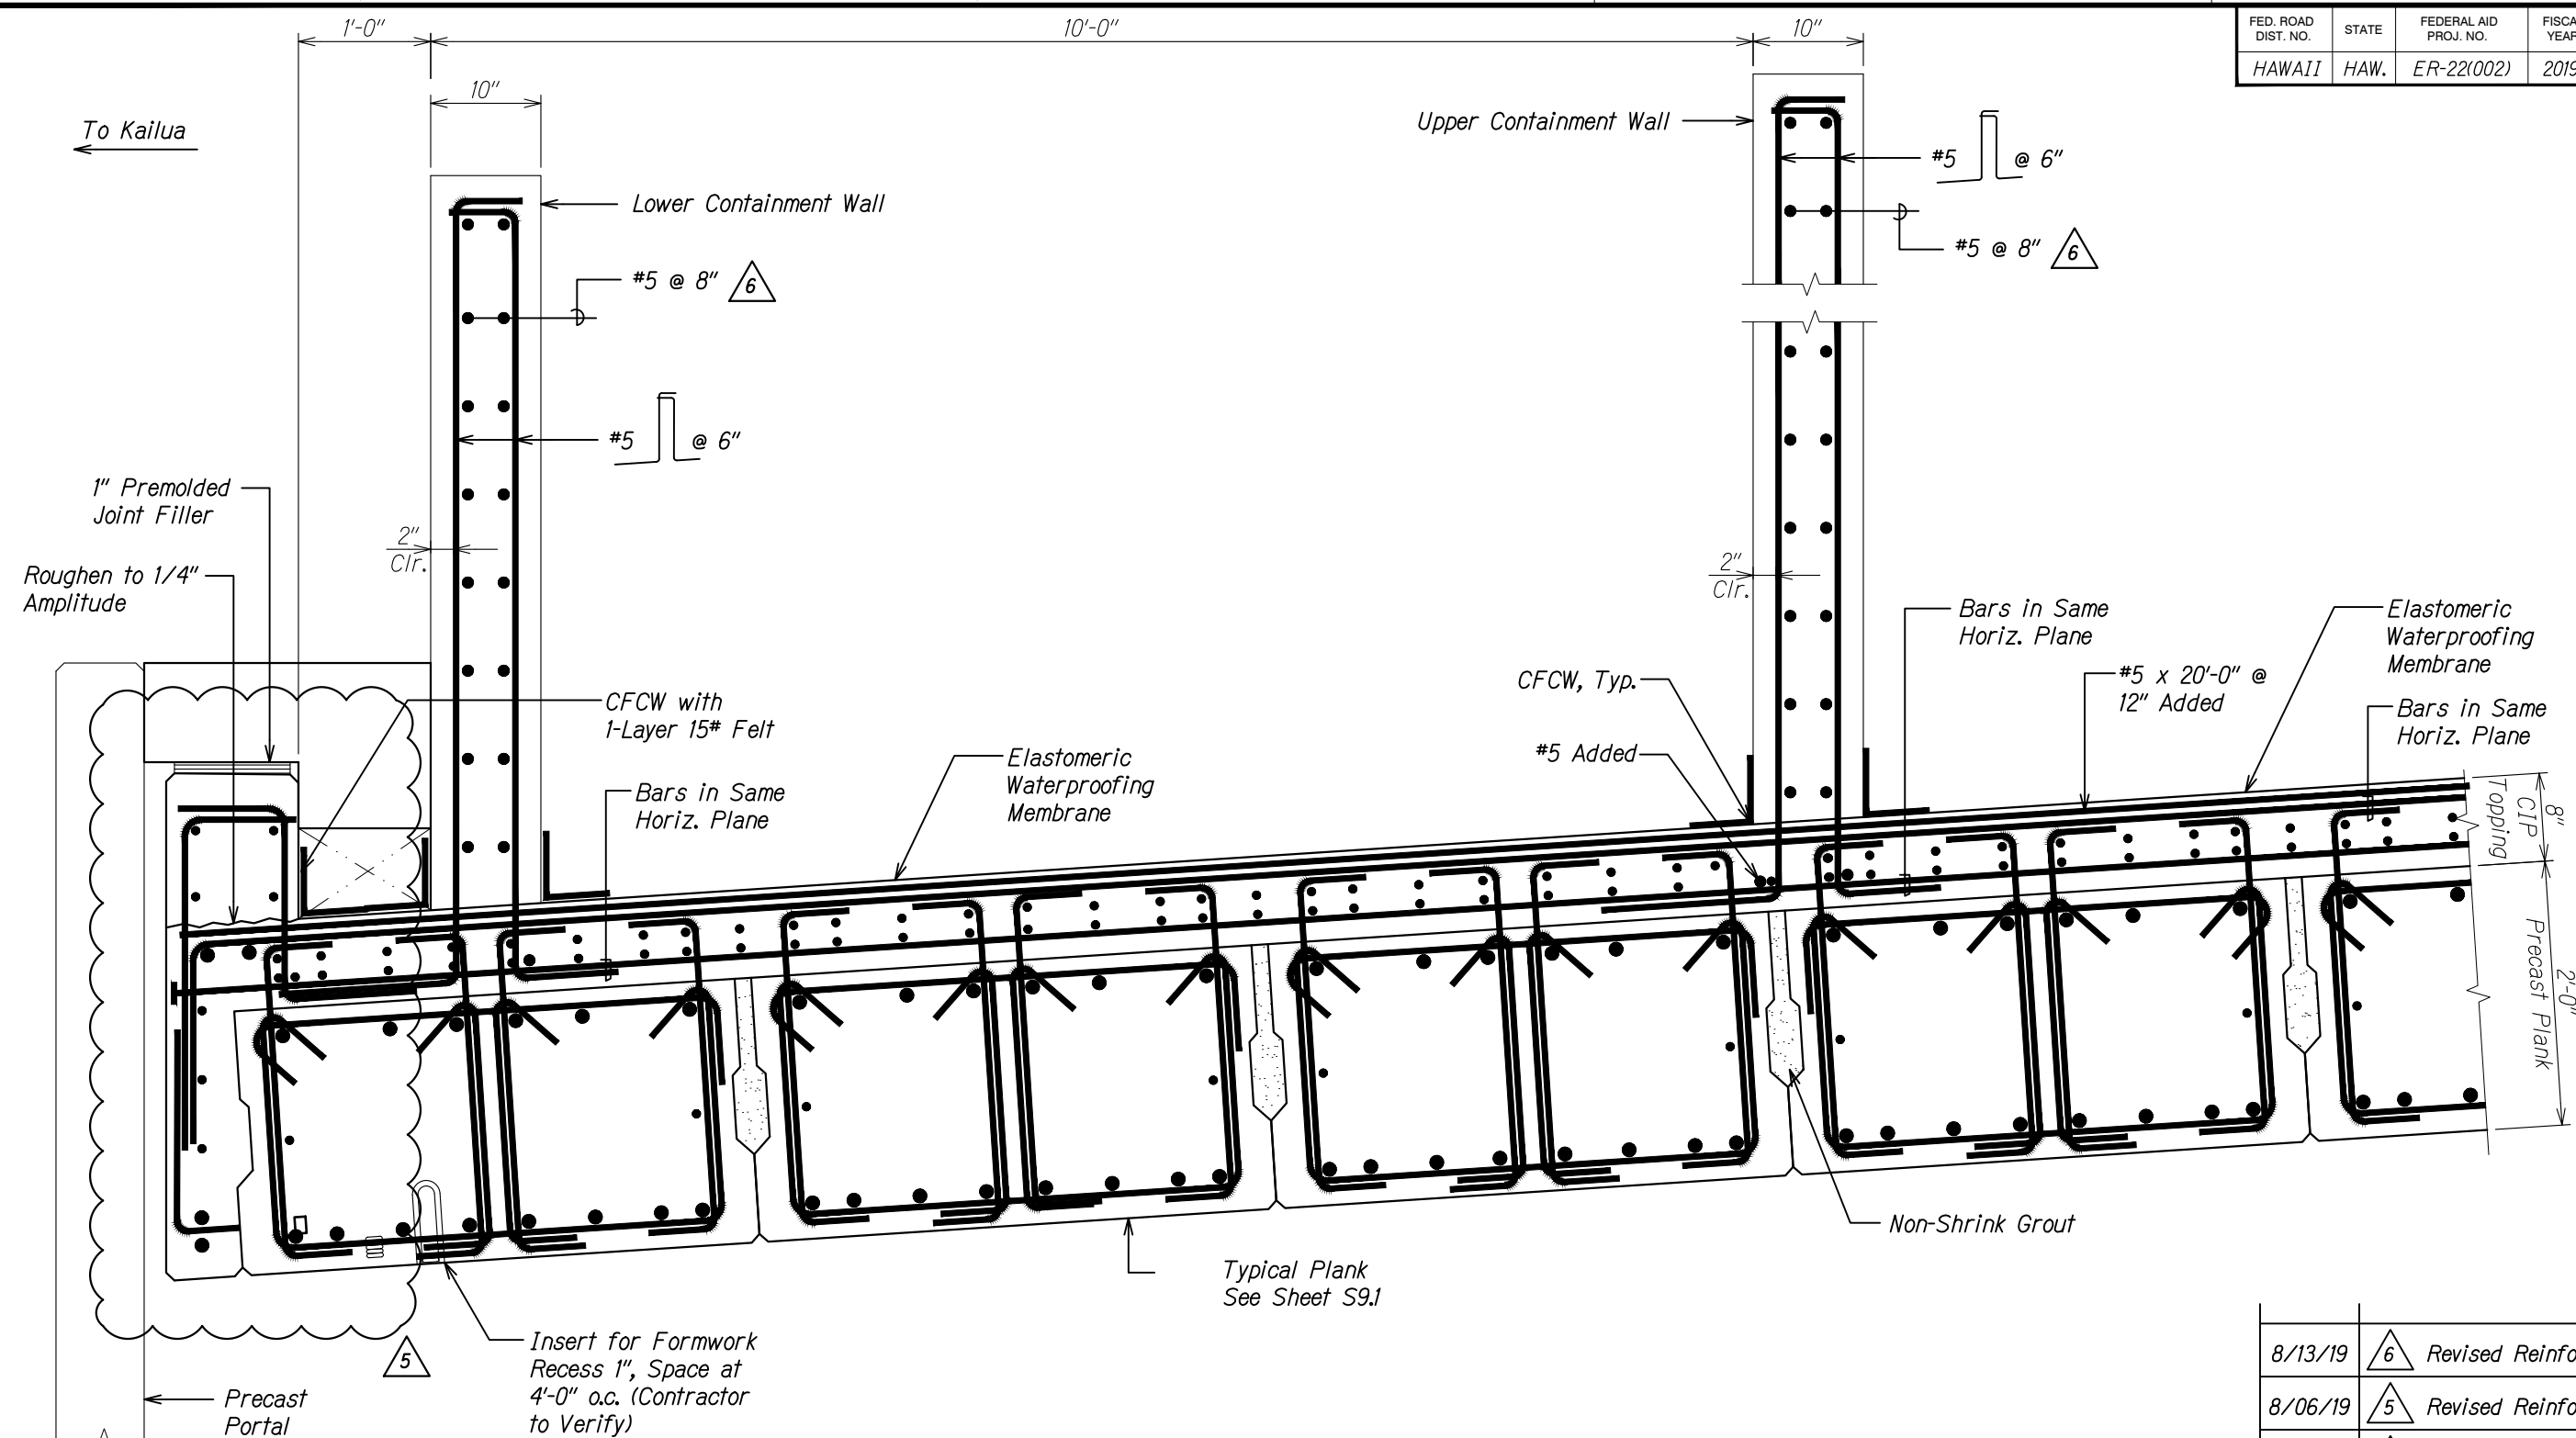

UPPER AND LOWER CONTAINMENT WALLS SECTION

Scale: $1\frac{1}{2}'' = 1'-0''$

8/13/19	 Revised Reinforcing
8/06/19	 Revised Reinforcing
5/24/19	 Revised Section

DATE	REVISION
------	----------

STATE OF HAWAII
DEPARTMENT OF TRANSPORTATION
HIGHWAYS DIVISION

UPPER & LOWER
CONTAINMENT WALL SECTION

PALI HIGHWAY
LANDSLIDE MITIGATION PROJECT
FAP Proj. No. ER-22(002)

Scale: As Noted Date: May 6, 2019



SHEET No. *S8.3* OF 3 SHEETS

ADD 66


ORIGINAL PLAN	SURVEY PLOTTED BY _____ DATE _____
NOTE BOOK	DRAWN BY _____
	TRACED BY _____
	DESIGNED BY _____
	QUANTITIES BY _____
No. _____	CHECKED BY _____

DRAWING NAME: 7:\00 ONGOING\19-014 1A PALL ROOF SHEED POST DESIGN-WSP TW\01 CAT\10-07-19 UPDATE DETA5-6\PM-S0801 ADD1 DETA6 DECK SECT DWG PLOT TIME: 10-07-19 1:03 PM)


FED. ROAD DIST. NO.	STATE	FEDERAL AID PROJ. NO.	FISCAL YEAR	SHEET NO.	TOTAL SHEETS
HAWAII	HAW.	ER-22(002)	2019	ADD 66S-1	94

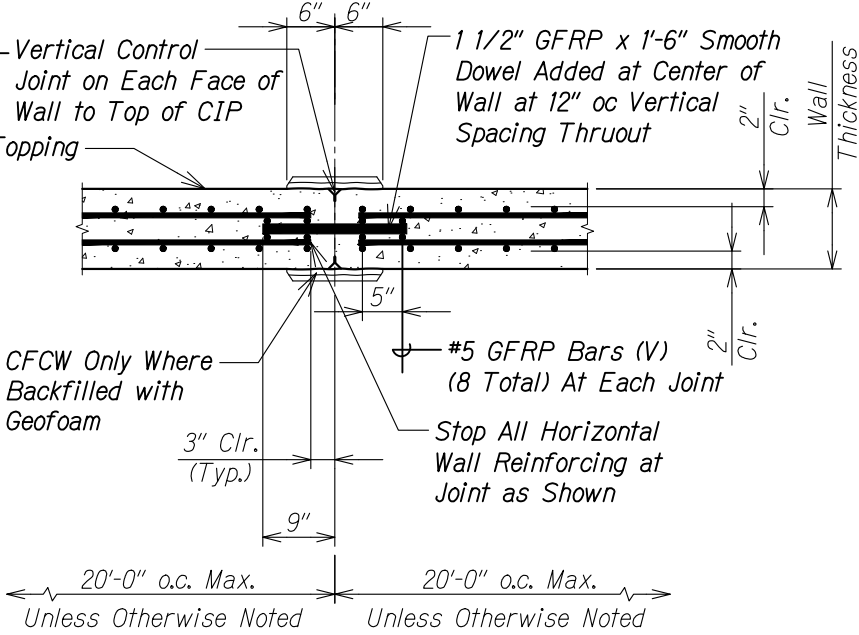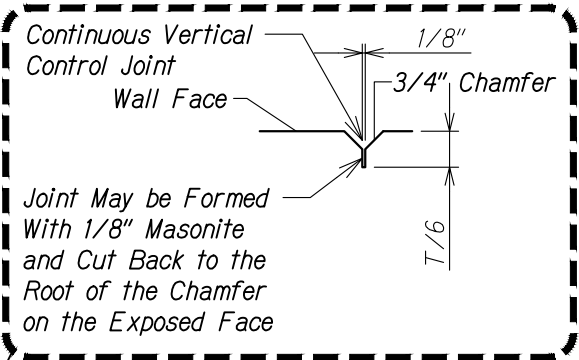

TYPICAL WALL VERTICAL CONTROL JOINT DETAIL
Not to Scale
S6.1 S8.4 S8.4

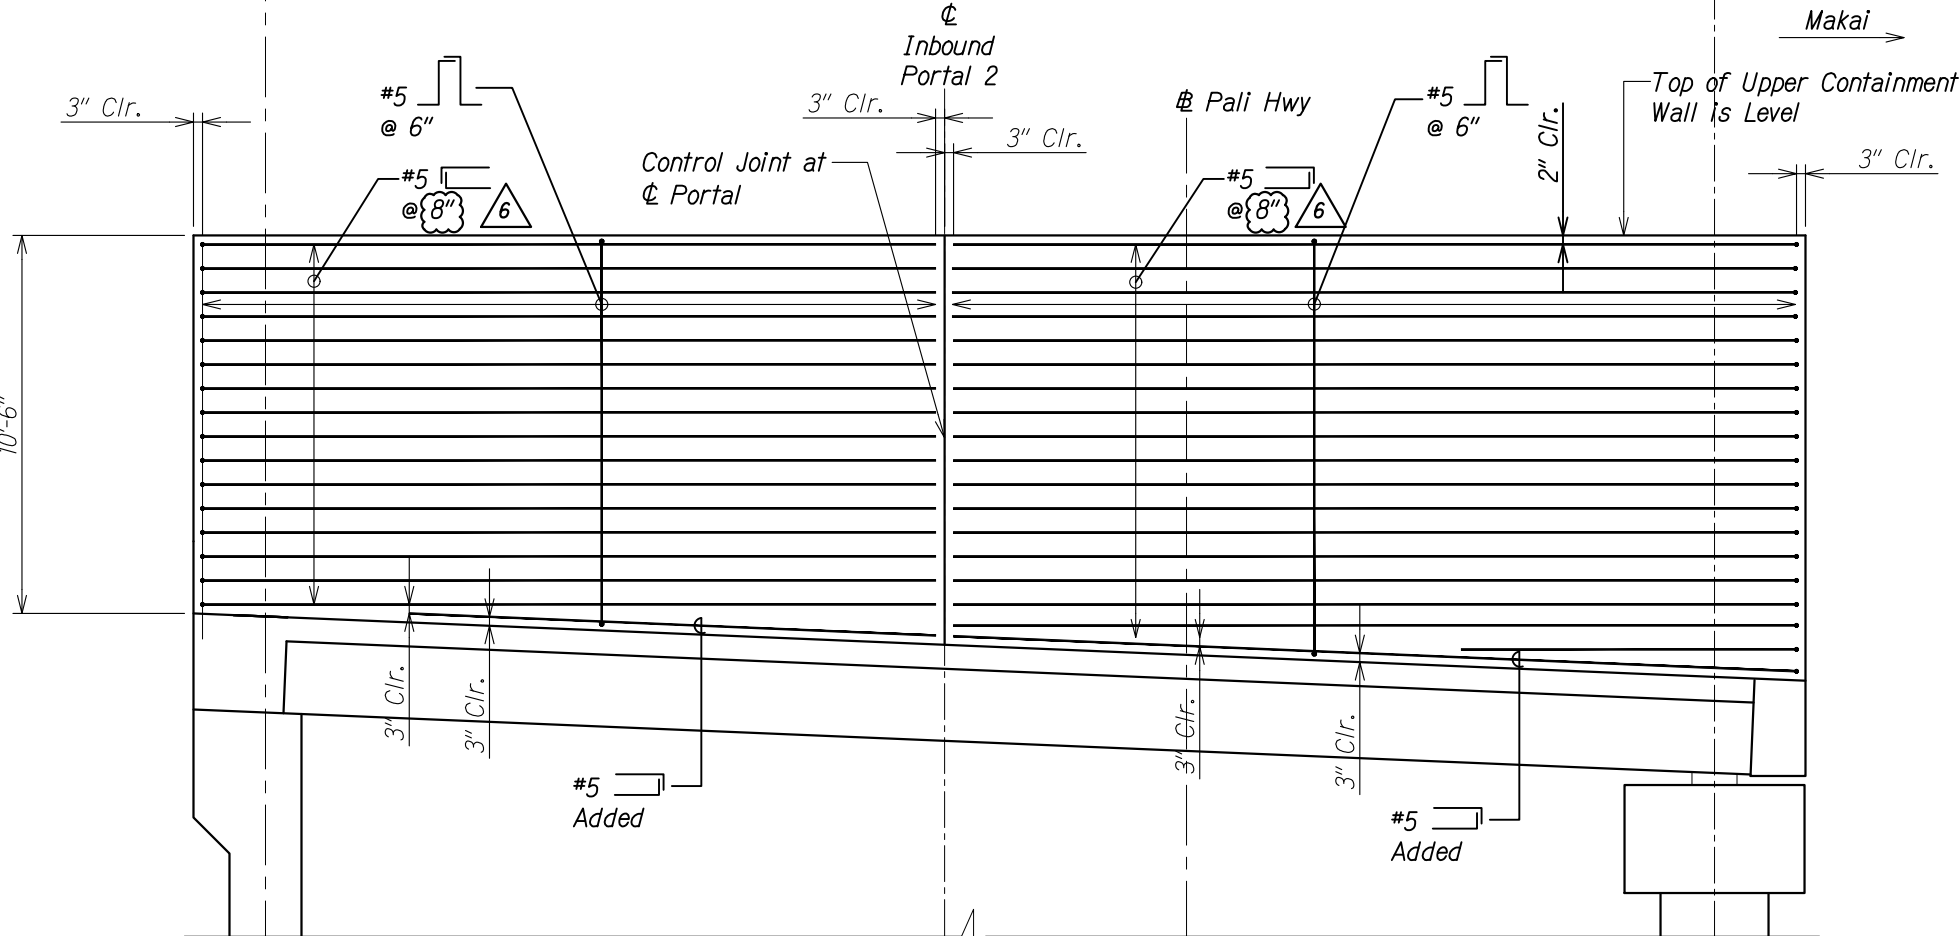

ELEVATION - UPPER CONTAINMENT WALL
Scale: 3/8" = 1'-0"
A S1.5 S8.4

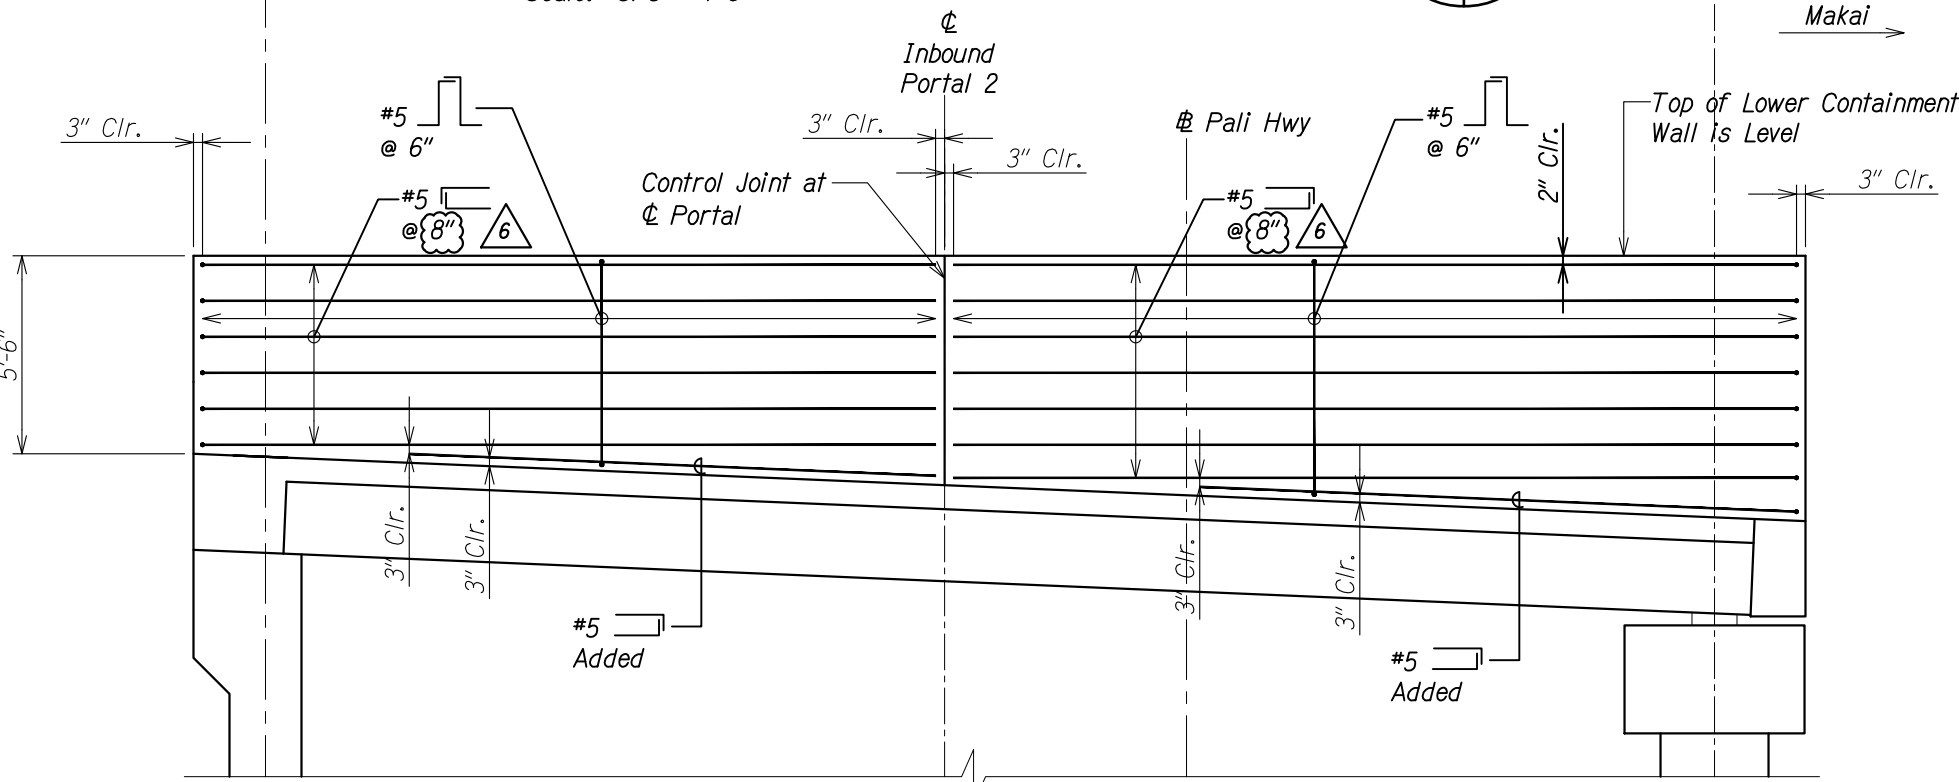

ELEVATION - LOWER CONTAINMENT WALL
Scale: 3/8" = 1'-0"
B S1.5 S8.4

8/13/19	6	Revised Reinforcing
5/24/19	1	New Sheet
DATE	REVISION	

STATE OF HAWAII
DEPARTMENT OF TRANSPORTATION
HIGHWAYS DIVISION

**UPPER & LOWER
CONTAINMENT WALL SECTION**

PALI HIGHWAY
LANDSLIDE MITIGATION PROJECT
FAP Proj. No. ER-22(002)

Scale: As Noted Date: May 6, 2019

SHEET No. S8.4 OF 3 SHEETS