


FED. ROAD DIST. NO.	STATE	FEDERAL AID PROJ. NO.	FISCAL YEAR	SHEET NO.	TOTAL SHEETS
HAWAII	HAW.	ER-22(002)	2019	ADD 11	94

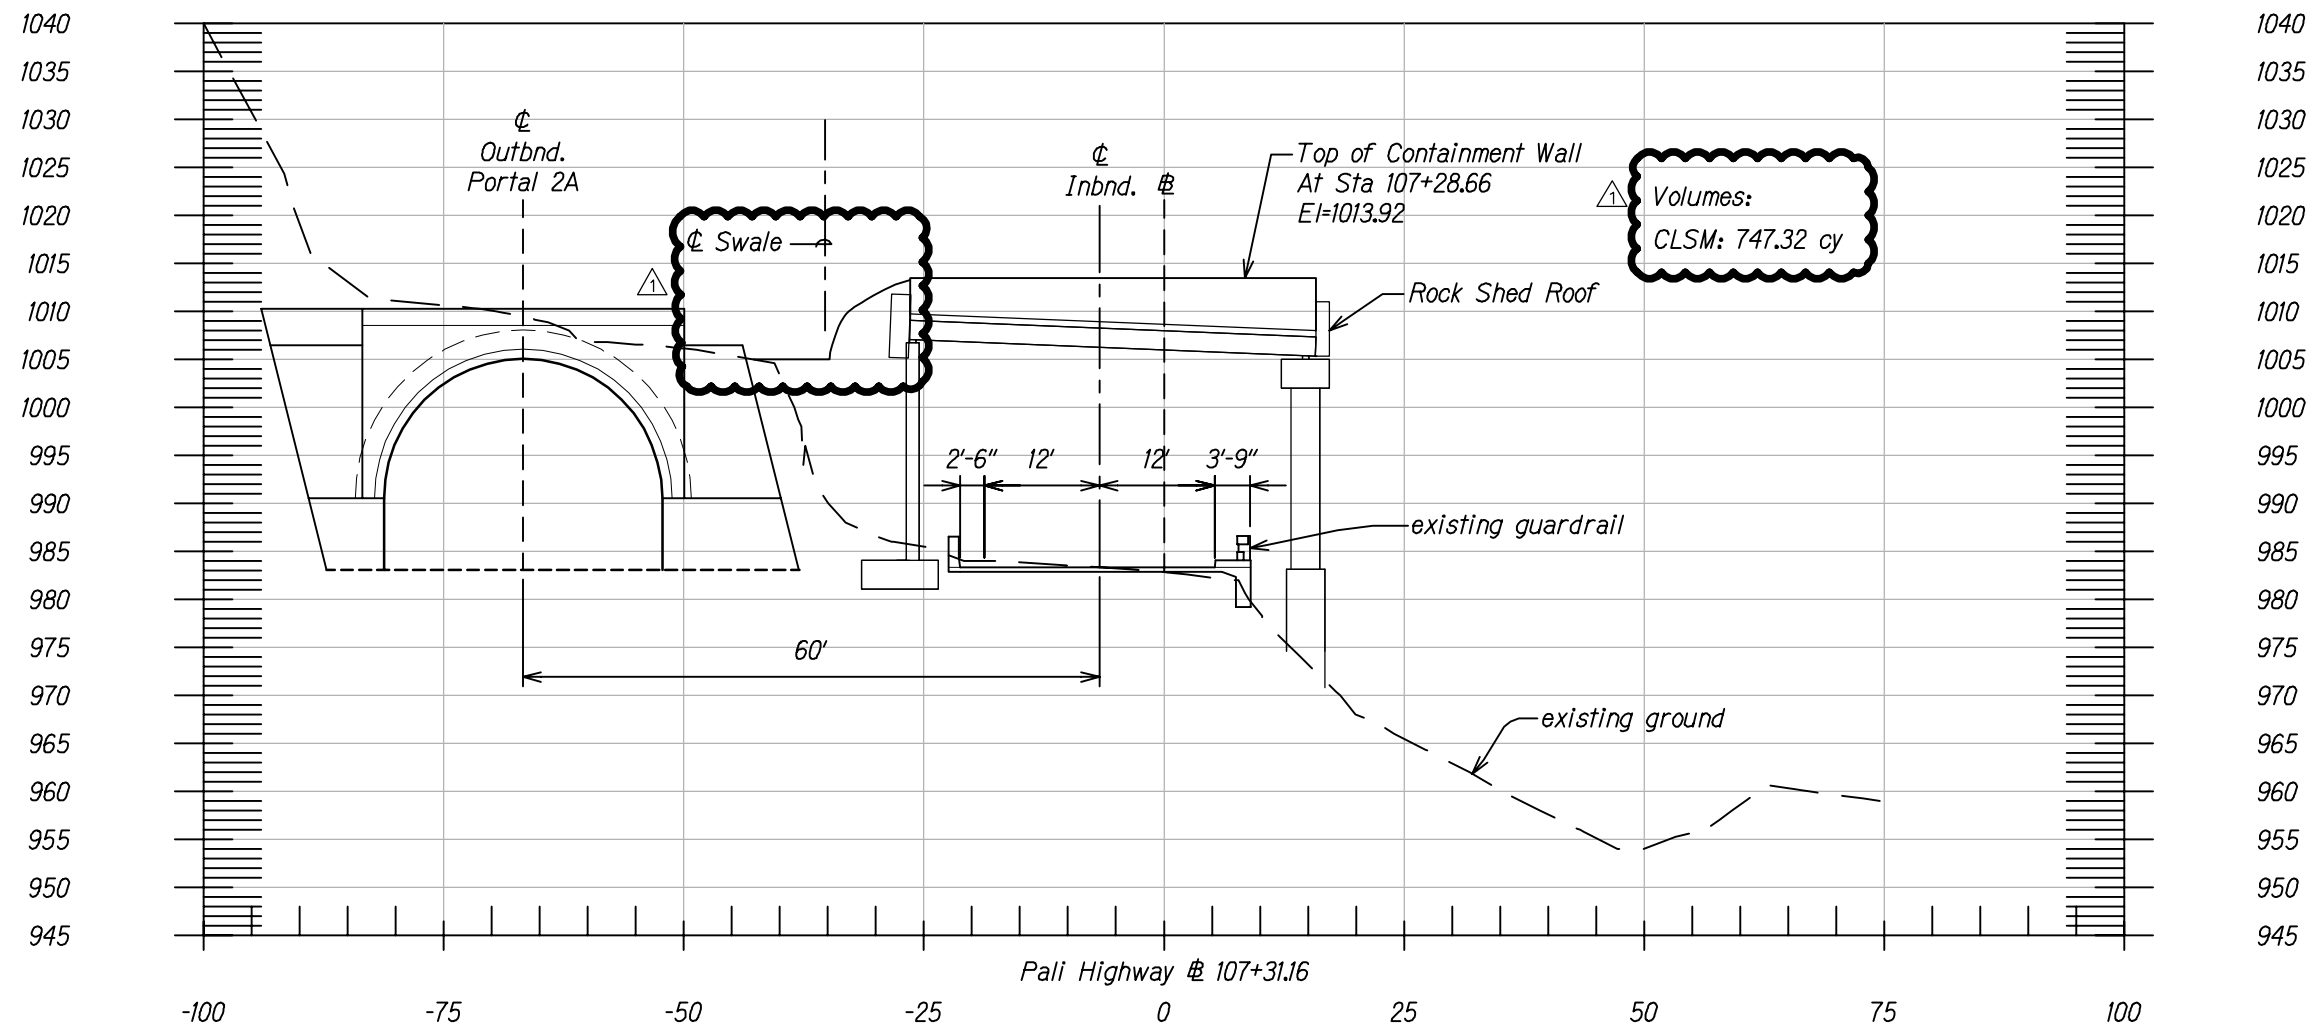

Pali Highway @ 107+31.16
Section
 Vertical: 1"=20'
 Horizontal: 1"=20'

SURVEY PLOTTED BY	DATE
DRAWN BY	
CHECKED BY	
NOTE BOOK	
QUANTITIES BY	
CHECKED BY	
N ^o .	

5/24/19	1 Revised Swale & Volumes
Date	Revision

STATE OF HAWAII

DEPARTMENT OF TRANSPORTATION

HIGHWAYS DIVISION

CROSS SECTIONS

PALI HIGHWAY

LANDSLIDE MITIGATION PROJECT


FAP No. ER-22(002)

Scale: As Shown

Date: May 6, 2019

SHEET No. P-1 OF 9 SHEETS

FED. ROAD DIST. NO.	STATE	FEDERAL AID PROJ. NO.	FISCAL YEAR	SHEET NO.	TOTAL SHEETS
HAWAII	HAW.	ER-22(002)	2019	ADD 12	94

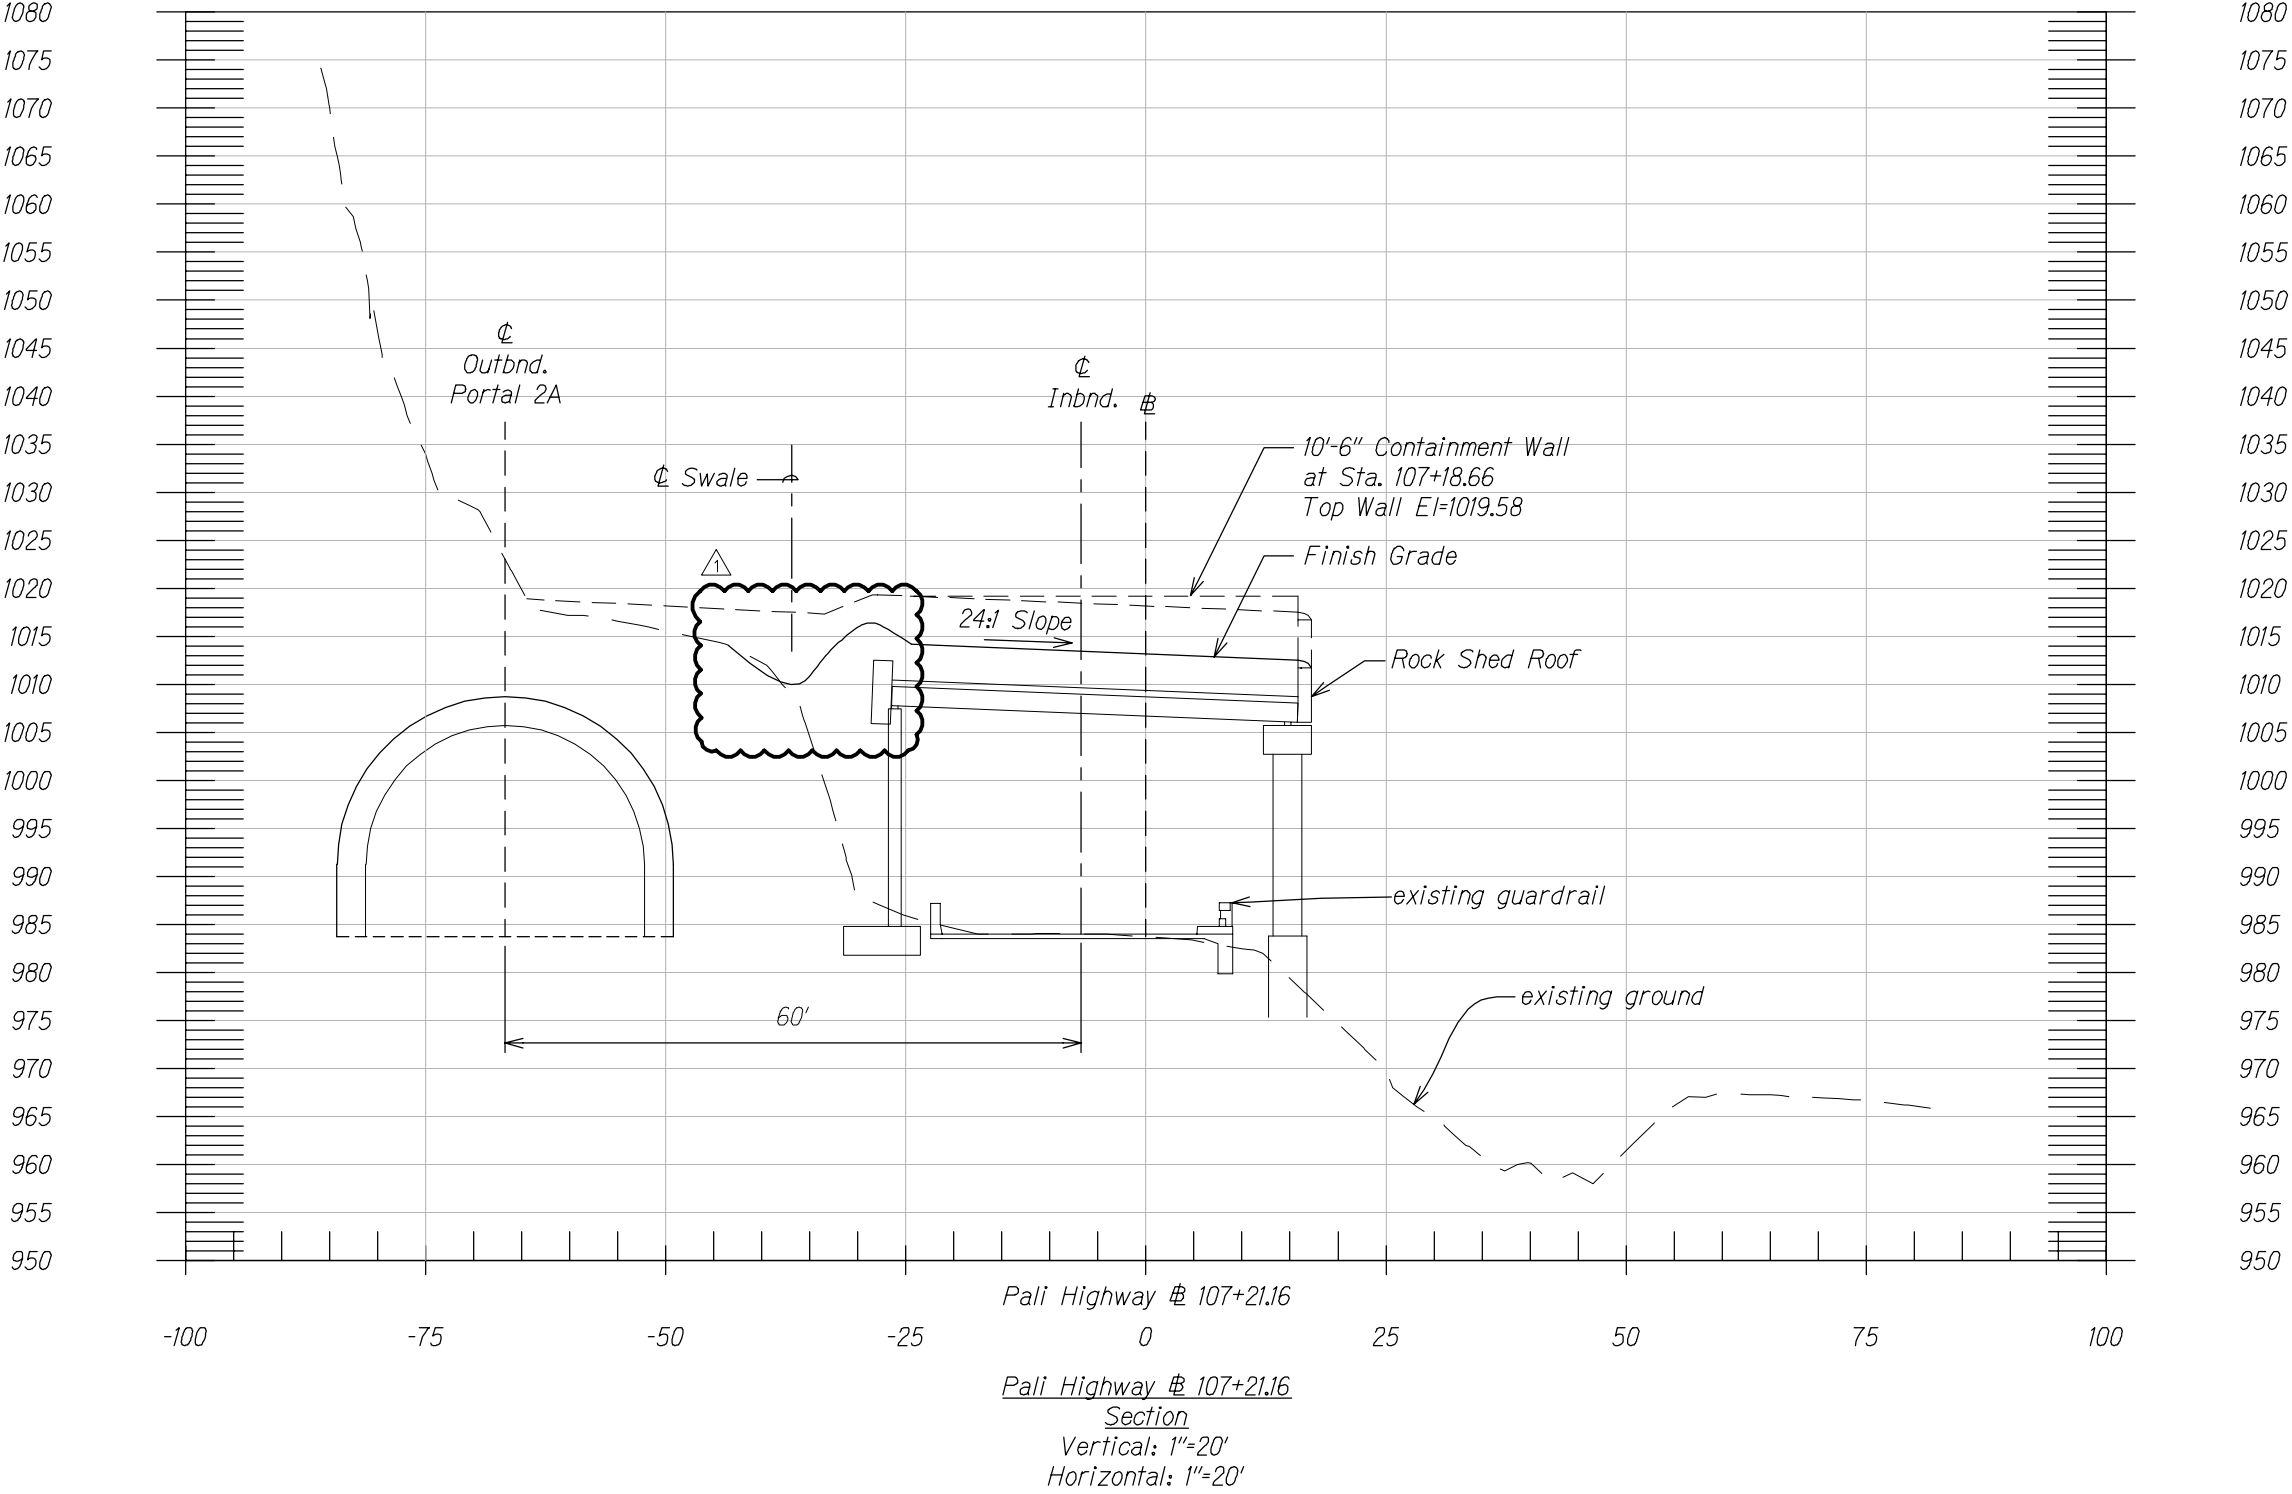

5/24/19	Revised Swale
Date	Revision

STATE OF HAWAII
DEPARTMENT OF TRANSPORTATION
HIGHWAYS DIVISION


CROSS SECTIONS

PALI HIGHWAY
LANDSLIDE MITIGATION PROJECT
FAP No. ER-22(002)

Scale: As Shown Date: May 6, 2019

SHEET No. P-2 OF 9 SHEETS

FED. ROAD DIST. NO.	STATE	FEDERAL AID PROJ. NO.	FISCAL YEAR	SHEET NO.	TOTAL SHEETS
HAWAII	HAW.	ER-22(002)	2019	ADD 13	94

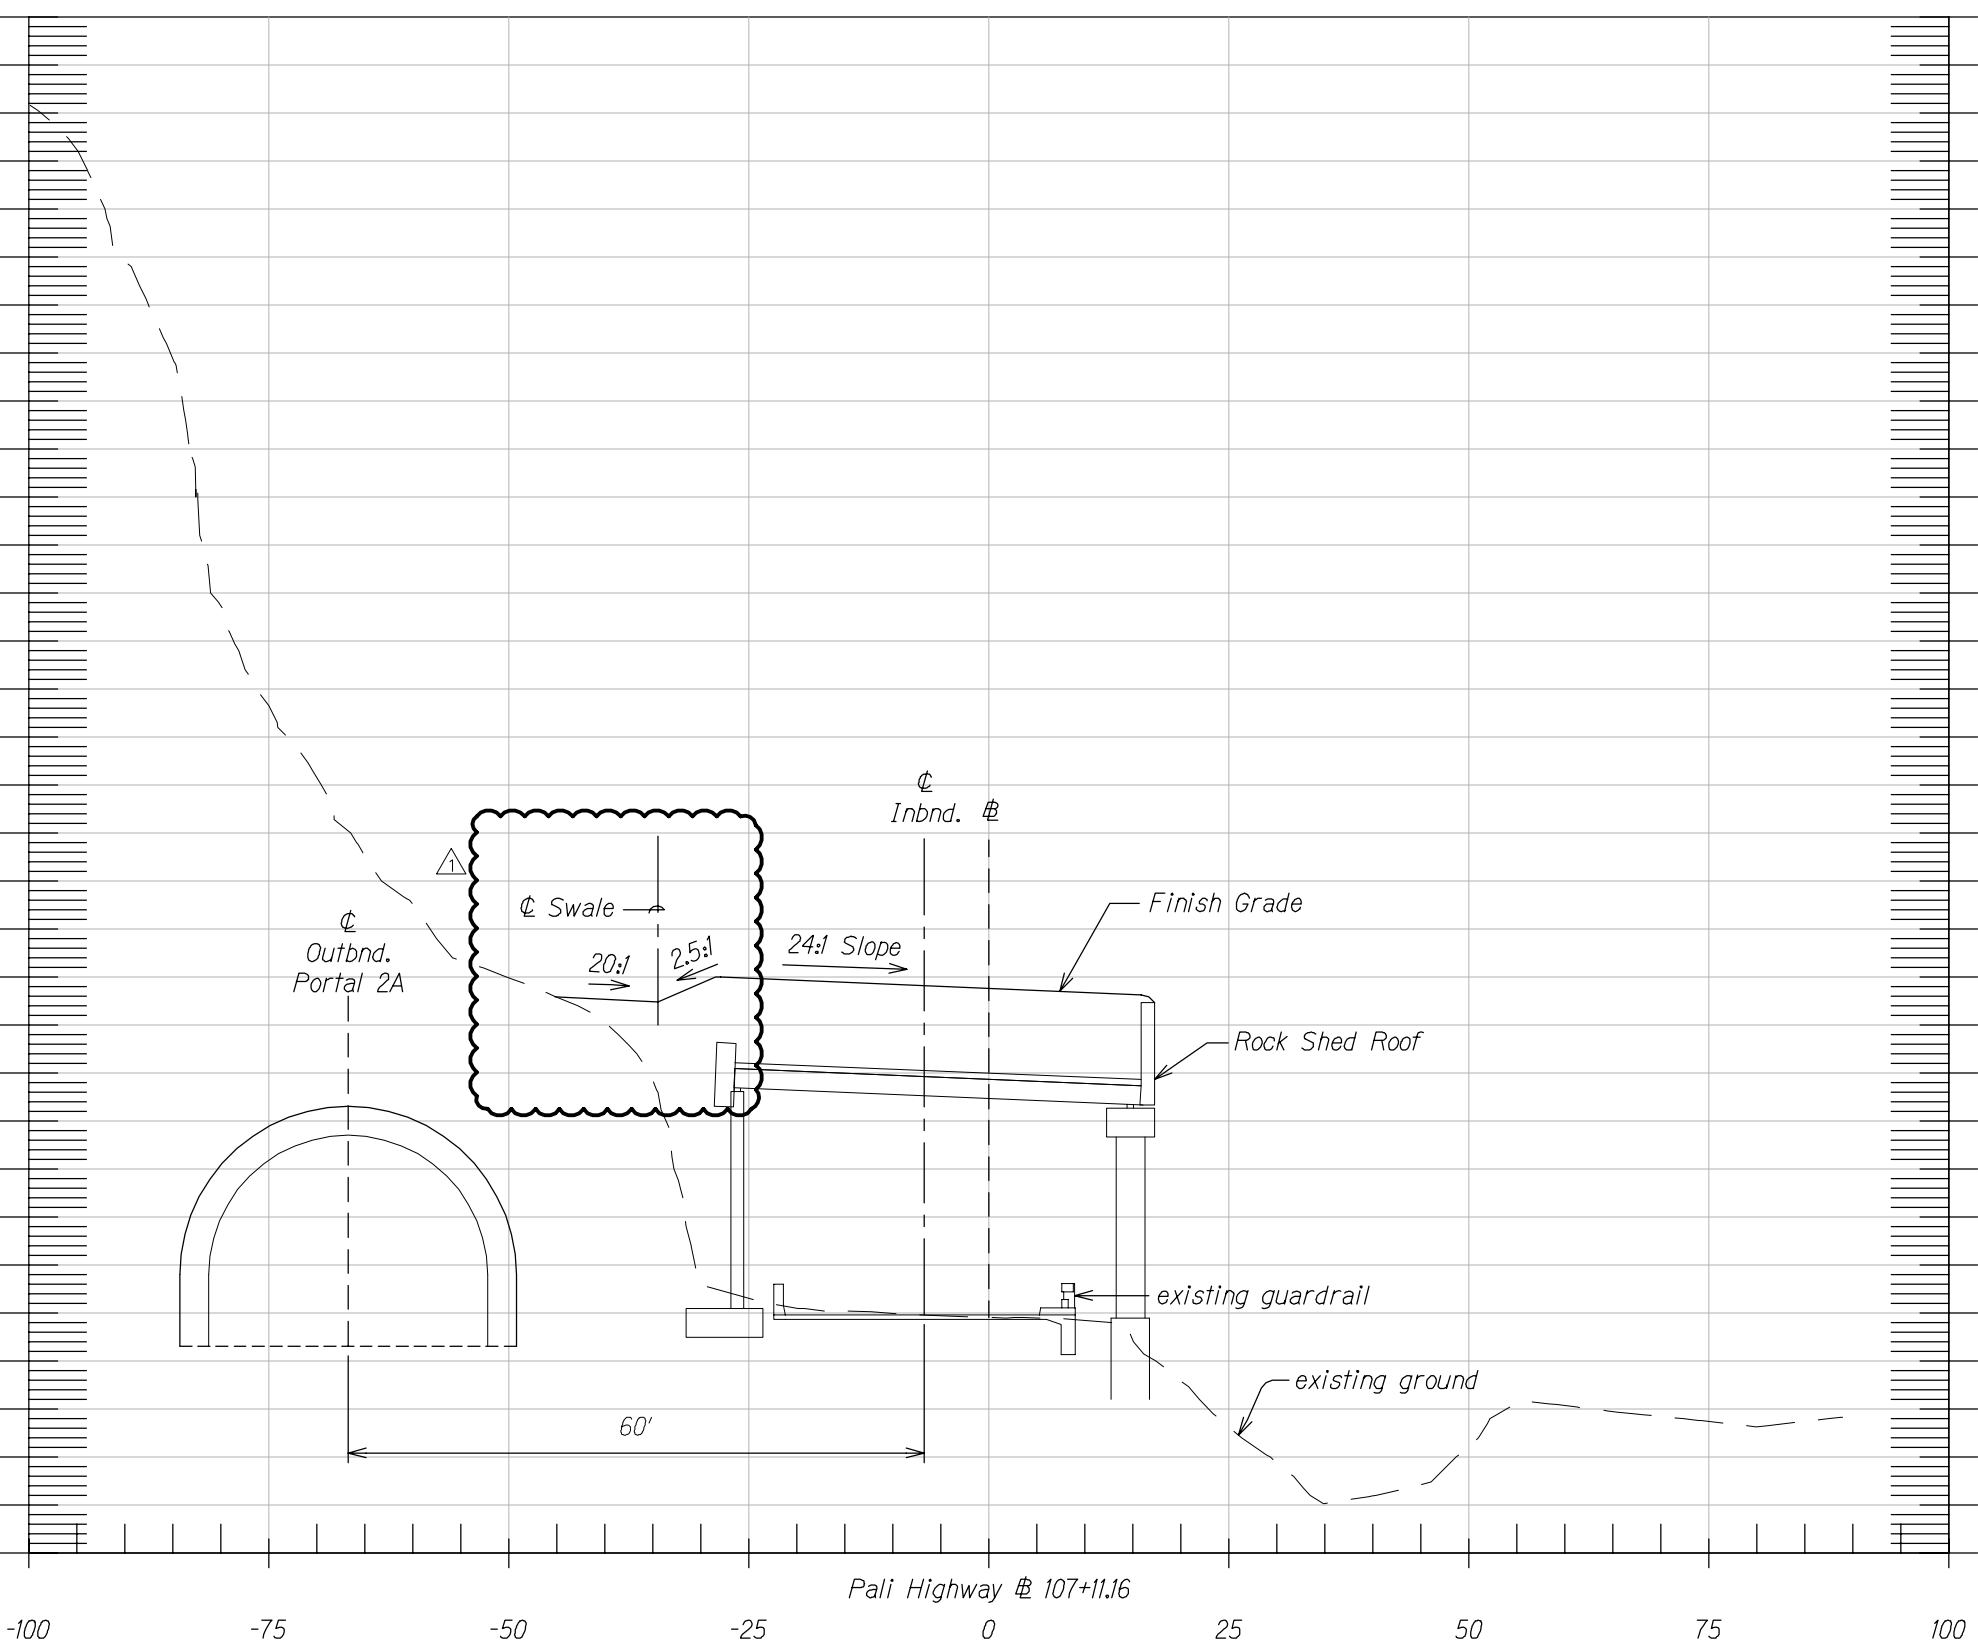

Pali Highway @ 107+11.16
Section
Vertical: 1"=20'
Horizontal: 1"=20'

5/24/19	⚠	Revised Swale
Date		Revision


STATE OF HAWAII
DEPARTMENT OF TRANSPORTATION
HIGHWAYS DIVISION
CROSS SECTIONS

PALI HIGHWAY
LANDSLIDE MITIGATION PROJECT
FAP No. ER-22(002)

Scale: As Shown Date: May 6, 2019

SHEET No. P-3 OF 9 SHEETS

FED. ROAD DIST. NO.	STATE	FEDERAL AID PROJ. NO.	FISCAL YEAR	SHEET NO.	TOTAL SHEETS
HAWAII	HAW.	ER-22(002)	2019	ADD 14	94

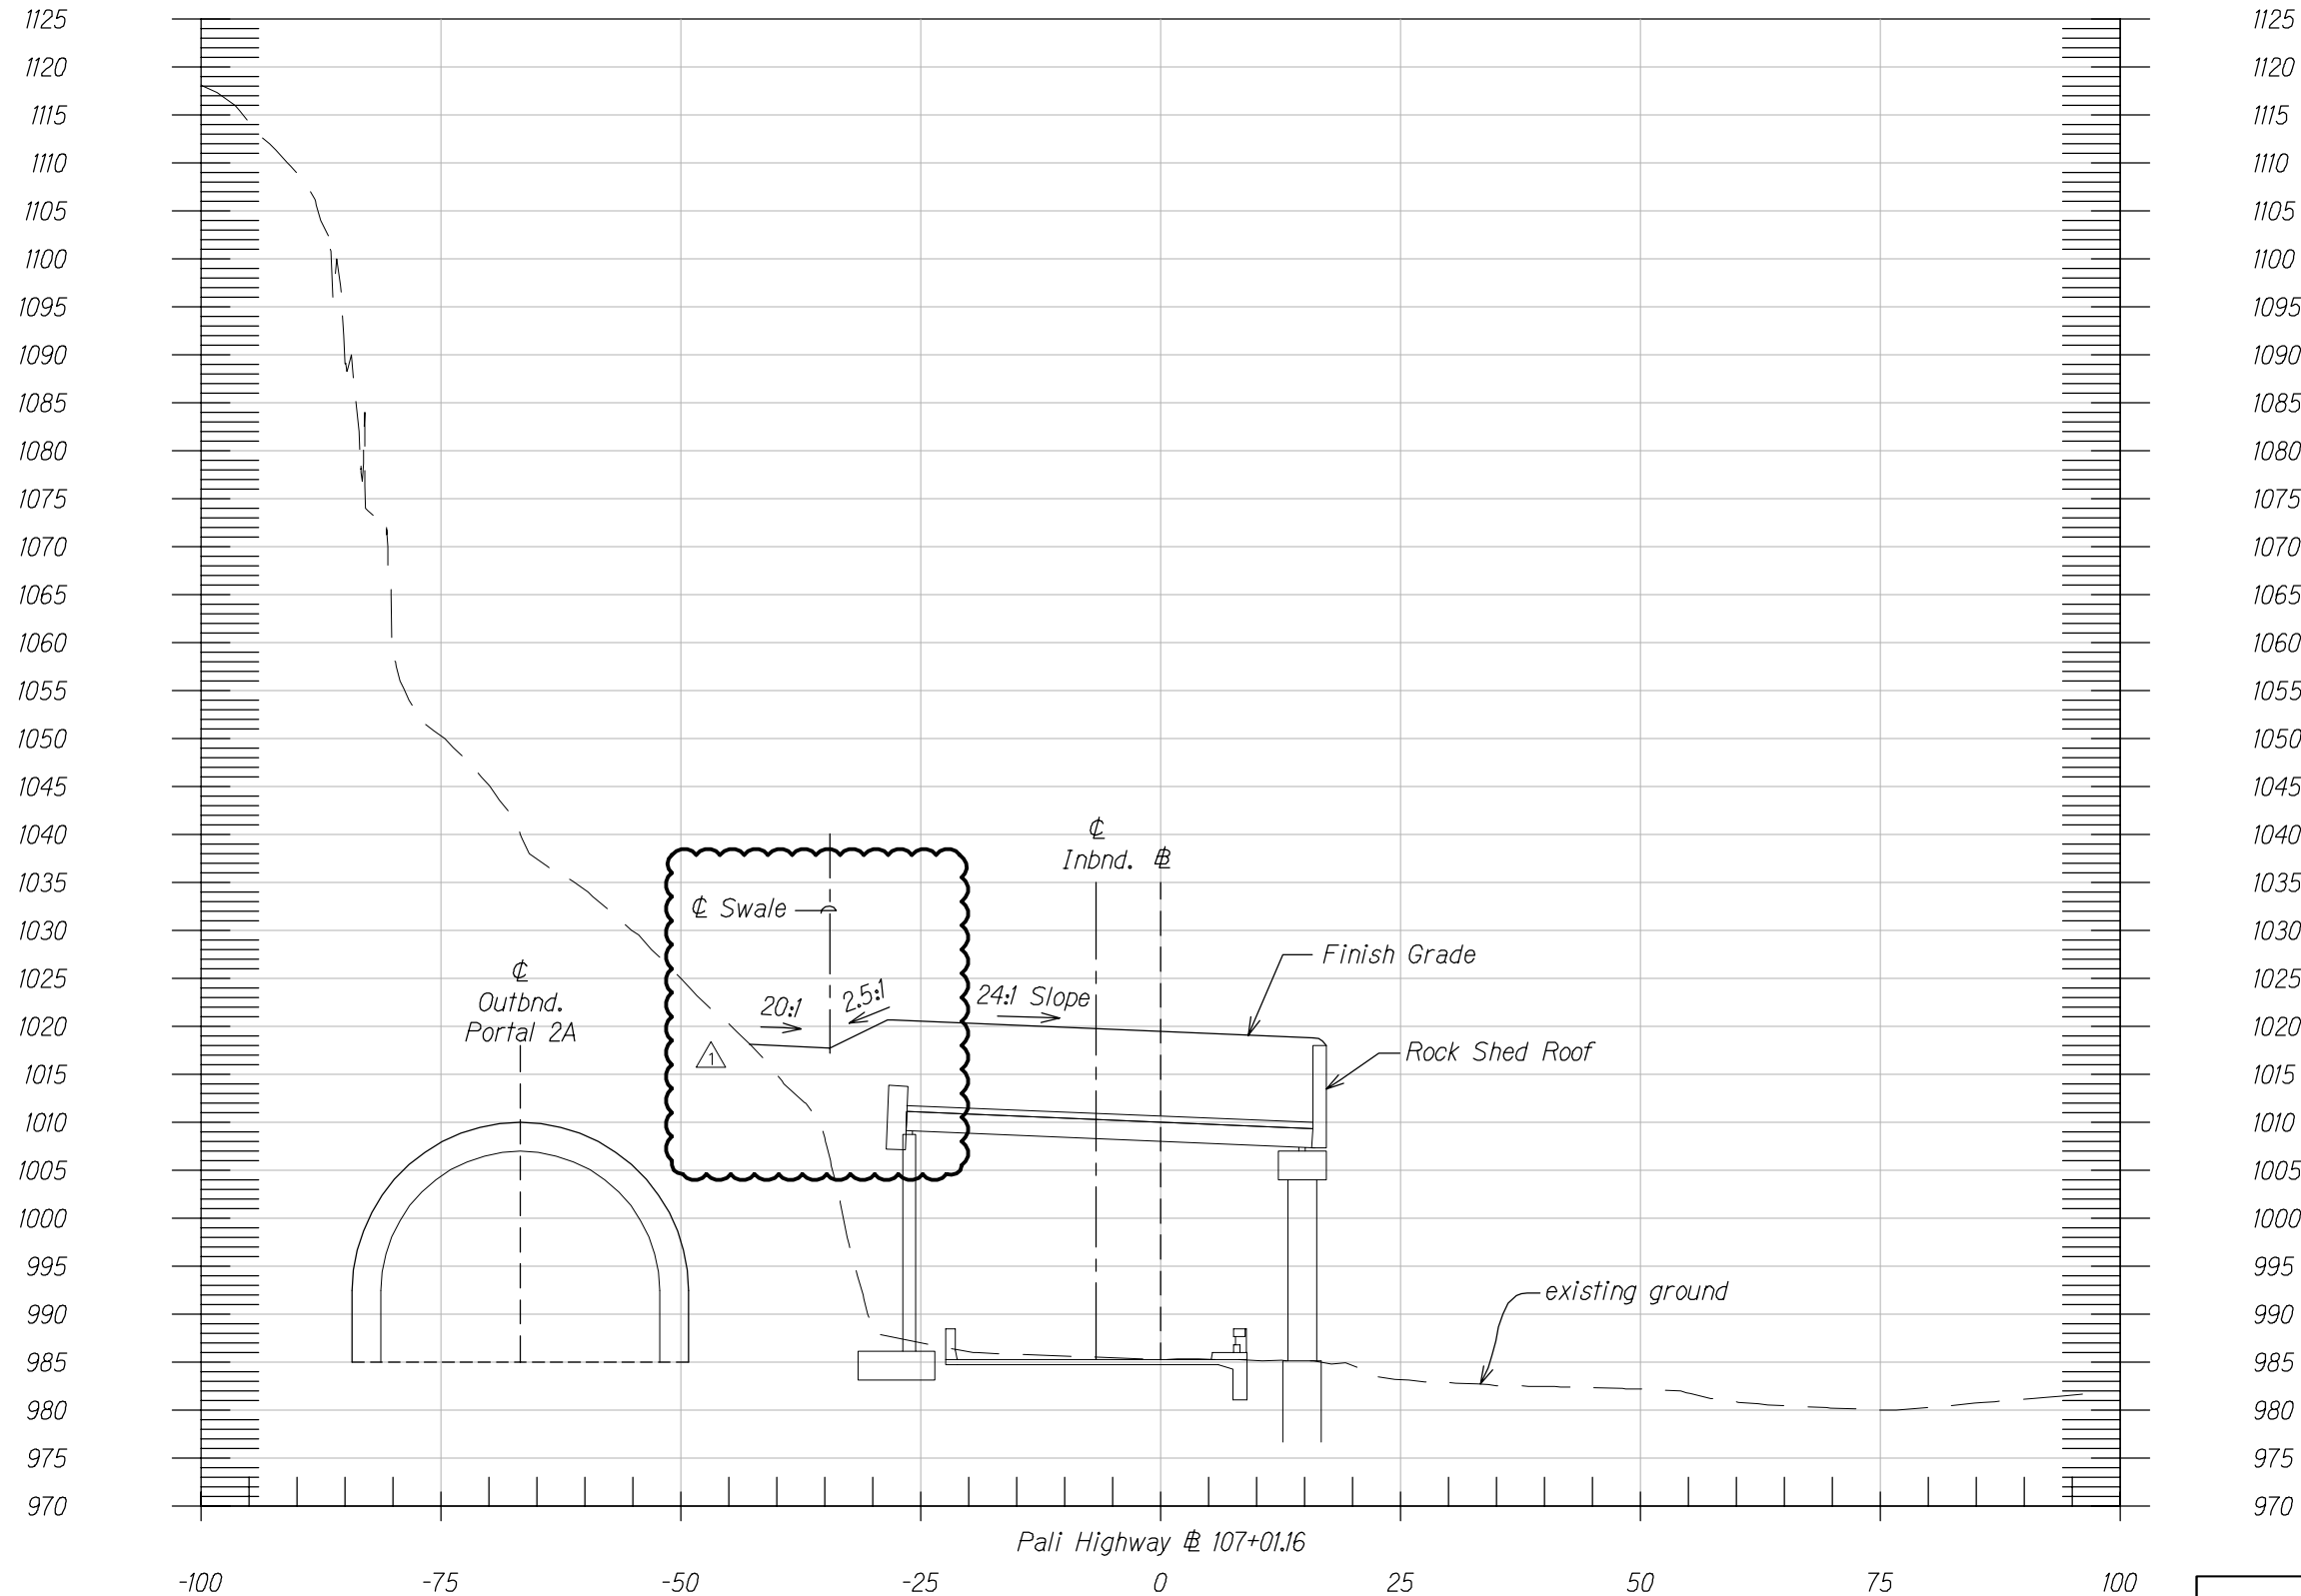

Pali Highway # 107+01.16
Section
Vertical: 1"=20'
Horizontal: 1"=20'

5/24/19	⚠	Revised Swale
Date		Revision


STATE OF HAWAII
DEPARTMENT OF TRANSPORTATION
HIGHWAYS DIVISION
CROSS SECTIONS

PALI HIGHWAY
LANDSLIDE MITIGATION PROJECT
FAP No. ER-22(002)

Scale: As Shown Date: May 6, 2019

SHEET No. P-4 OF 9 SHEETS

FED. ROAD DIST. NO.	STATE	FEDERAL AID PROJ. NO.	FISCAL YEAR	SHEET NO.	TOTAL SHEETS
HAWAII	HAW.	ER-22(002)	2019	ADD 15	94

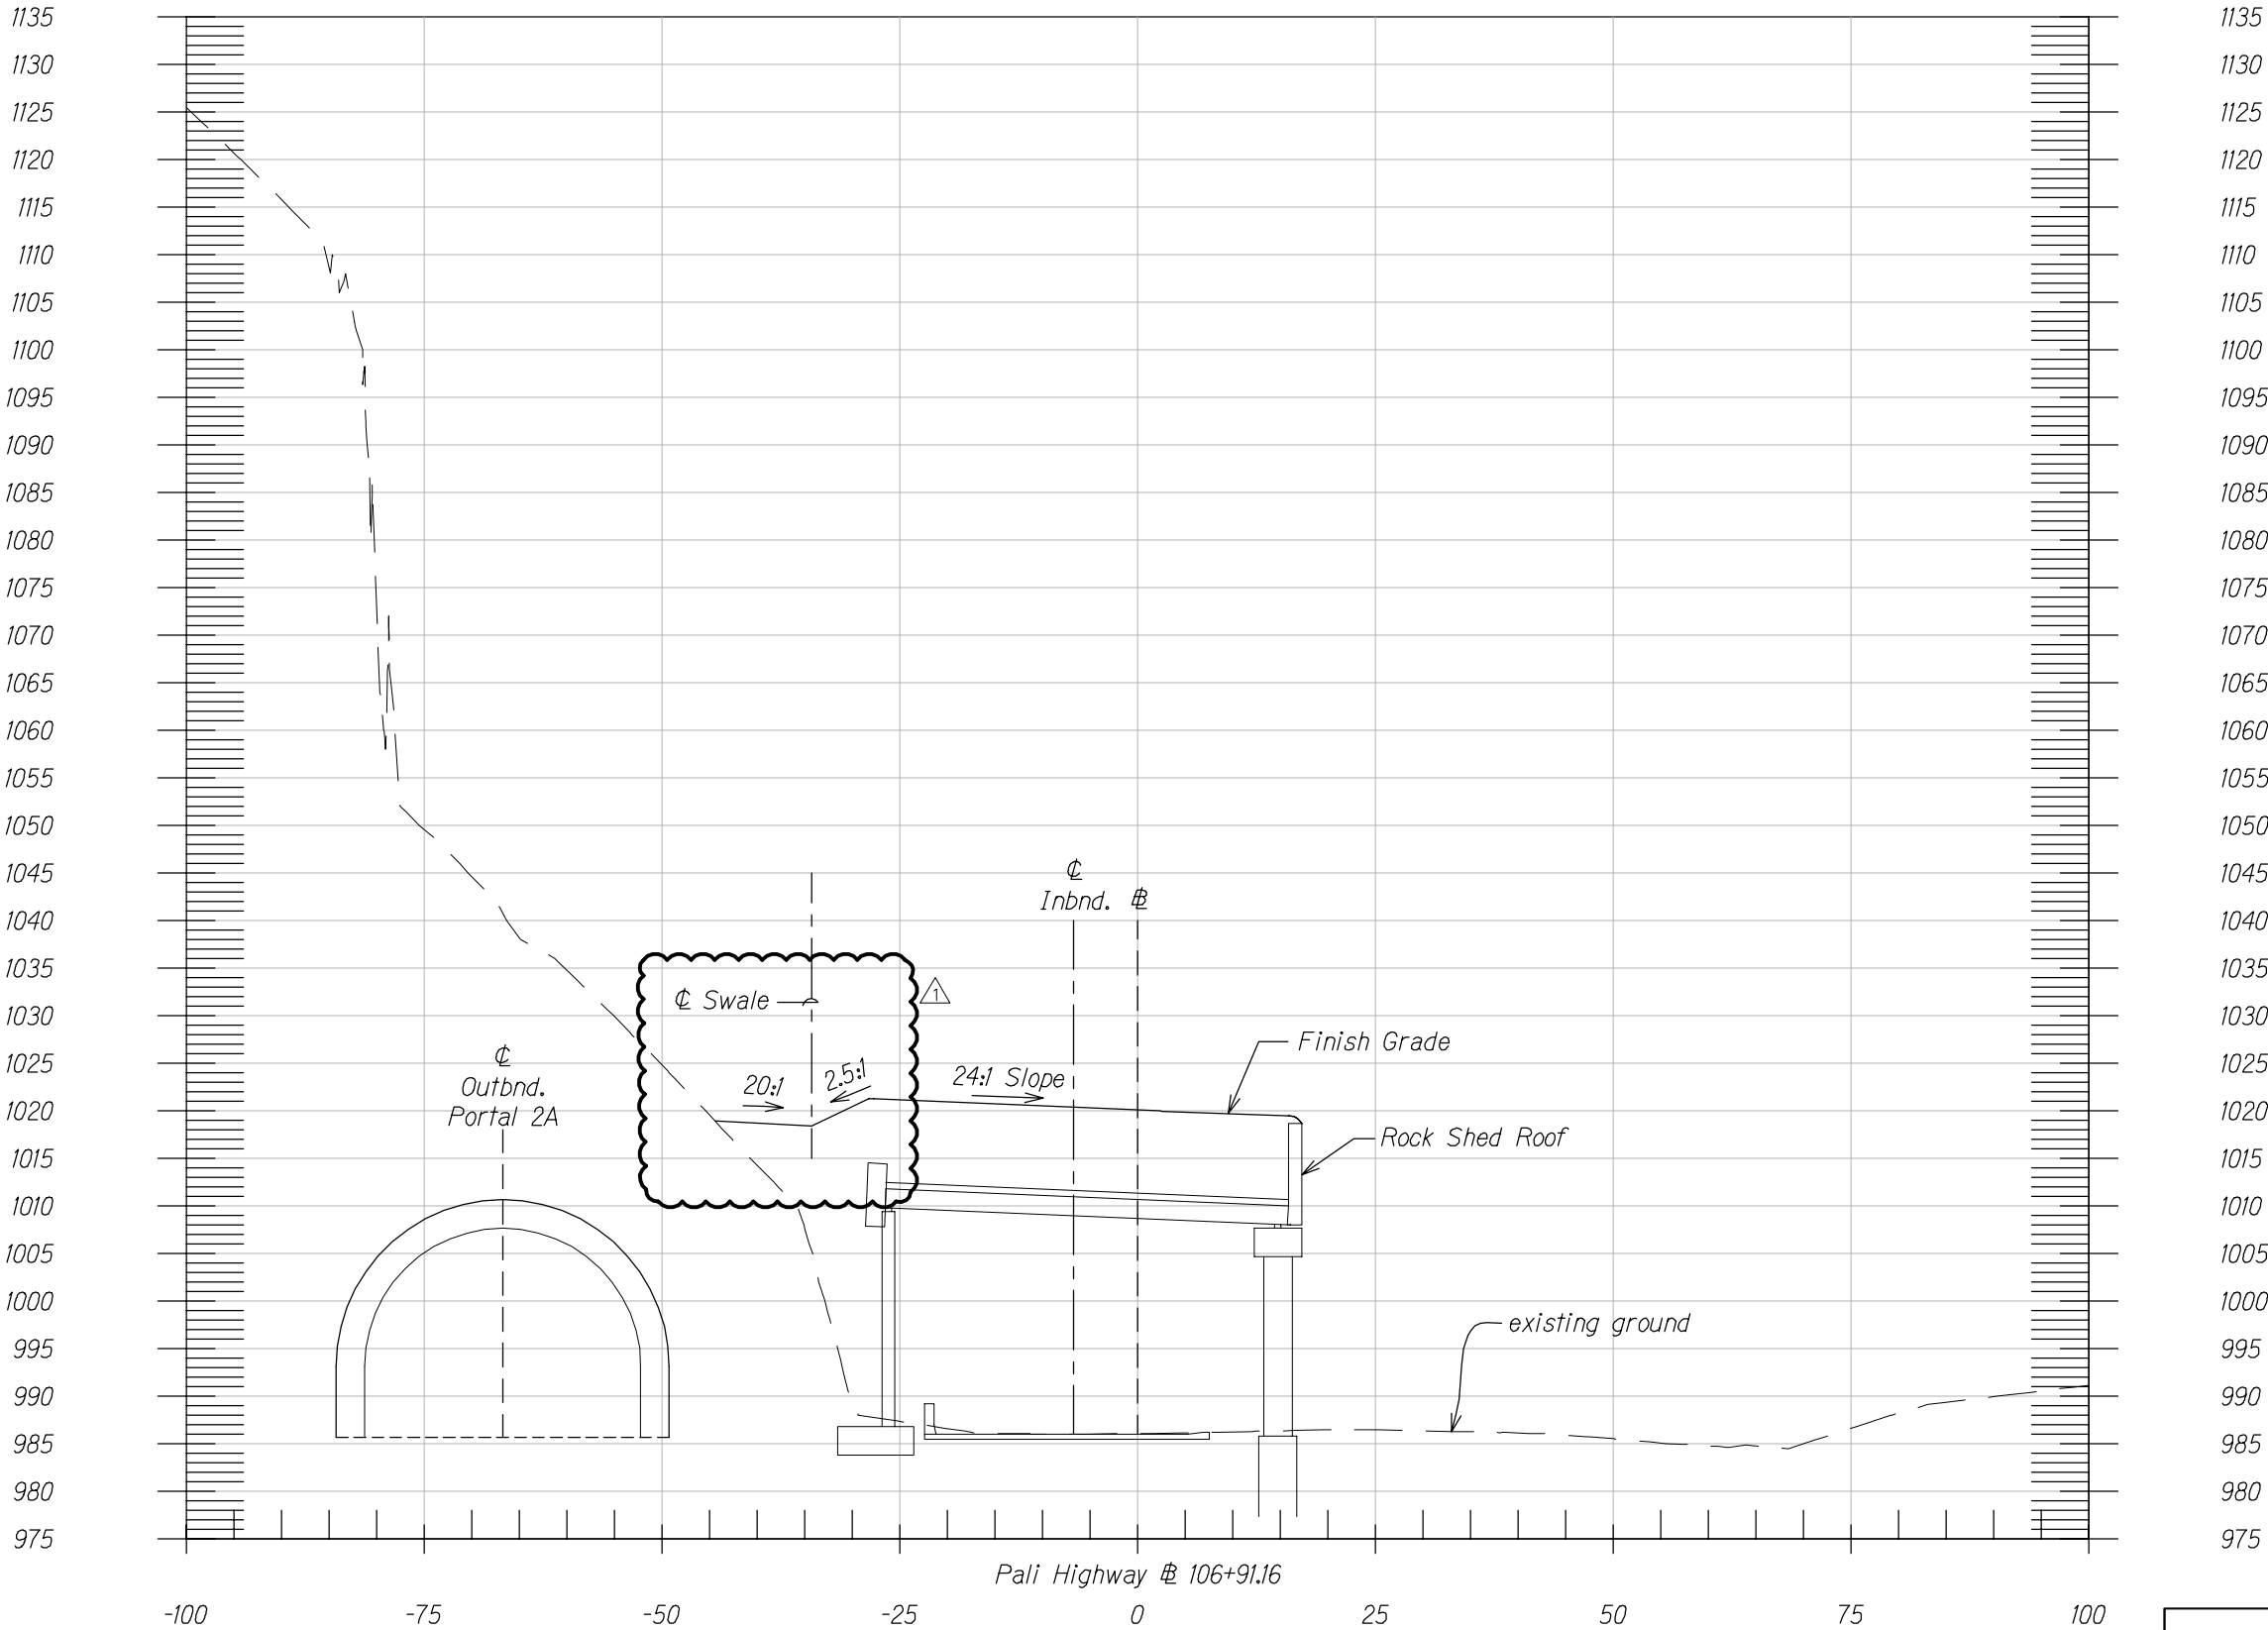

Pali Highway # 106+91.16
Section
Vertical: 1"=20'
Horizontal: 1"=20'

5/24/19	△	Revised Swale
Date		Revision

STATE OF HAWAII
DEPARTMENT OF TRANSPORTATION
HIGHWAYS DIVISION
CROSS SECTIONS

PALI HIGHWAY
LANDSLIDE MITIGATION PROJECT
FAP No. ER-22(002)


Scale: As Shown Date: May 6, 2019

SHEET No. P-5 OF 9 SHEETS

ADD 15

SURVEY PLOTTED BY	DATE
DRAWN BY	
CHECKED BY	
NOTE BOOK	
QUANTITIES BY	
CHECKED BY	

FED. ROAD DIST. NO.	STATE	FEDERAL AID PROJ. NO.	FISCAL YEAR	SHEET NO.	TOTAL SHEETS
HAWAII	HAW.	ER-22(002)	2019	ADD 16	94

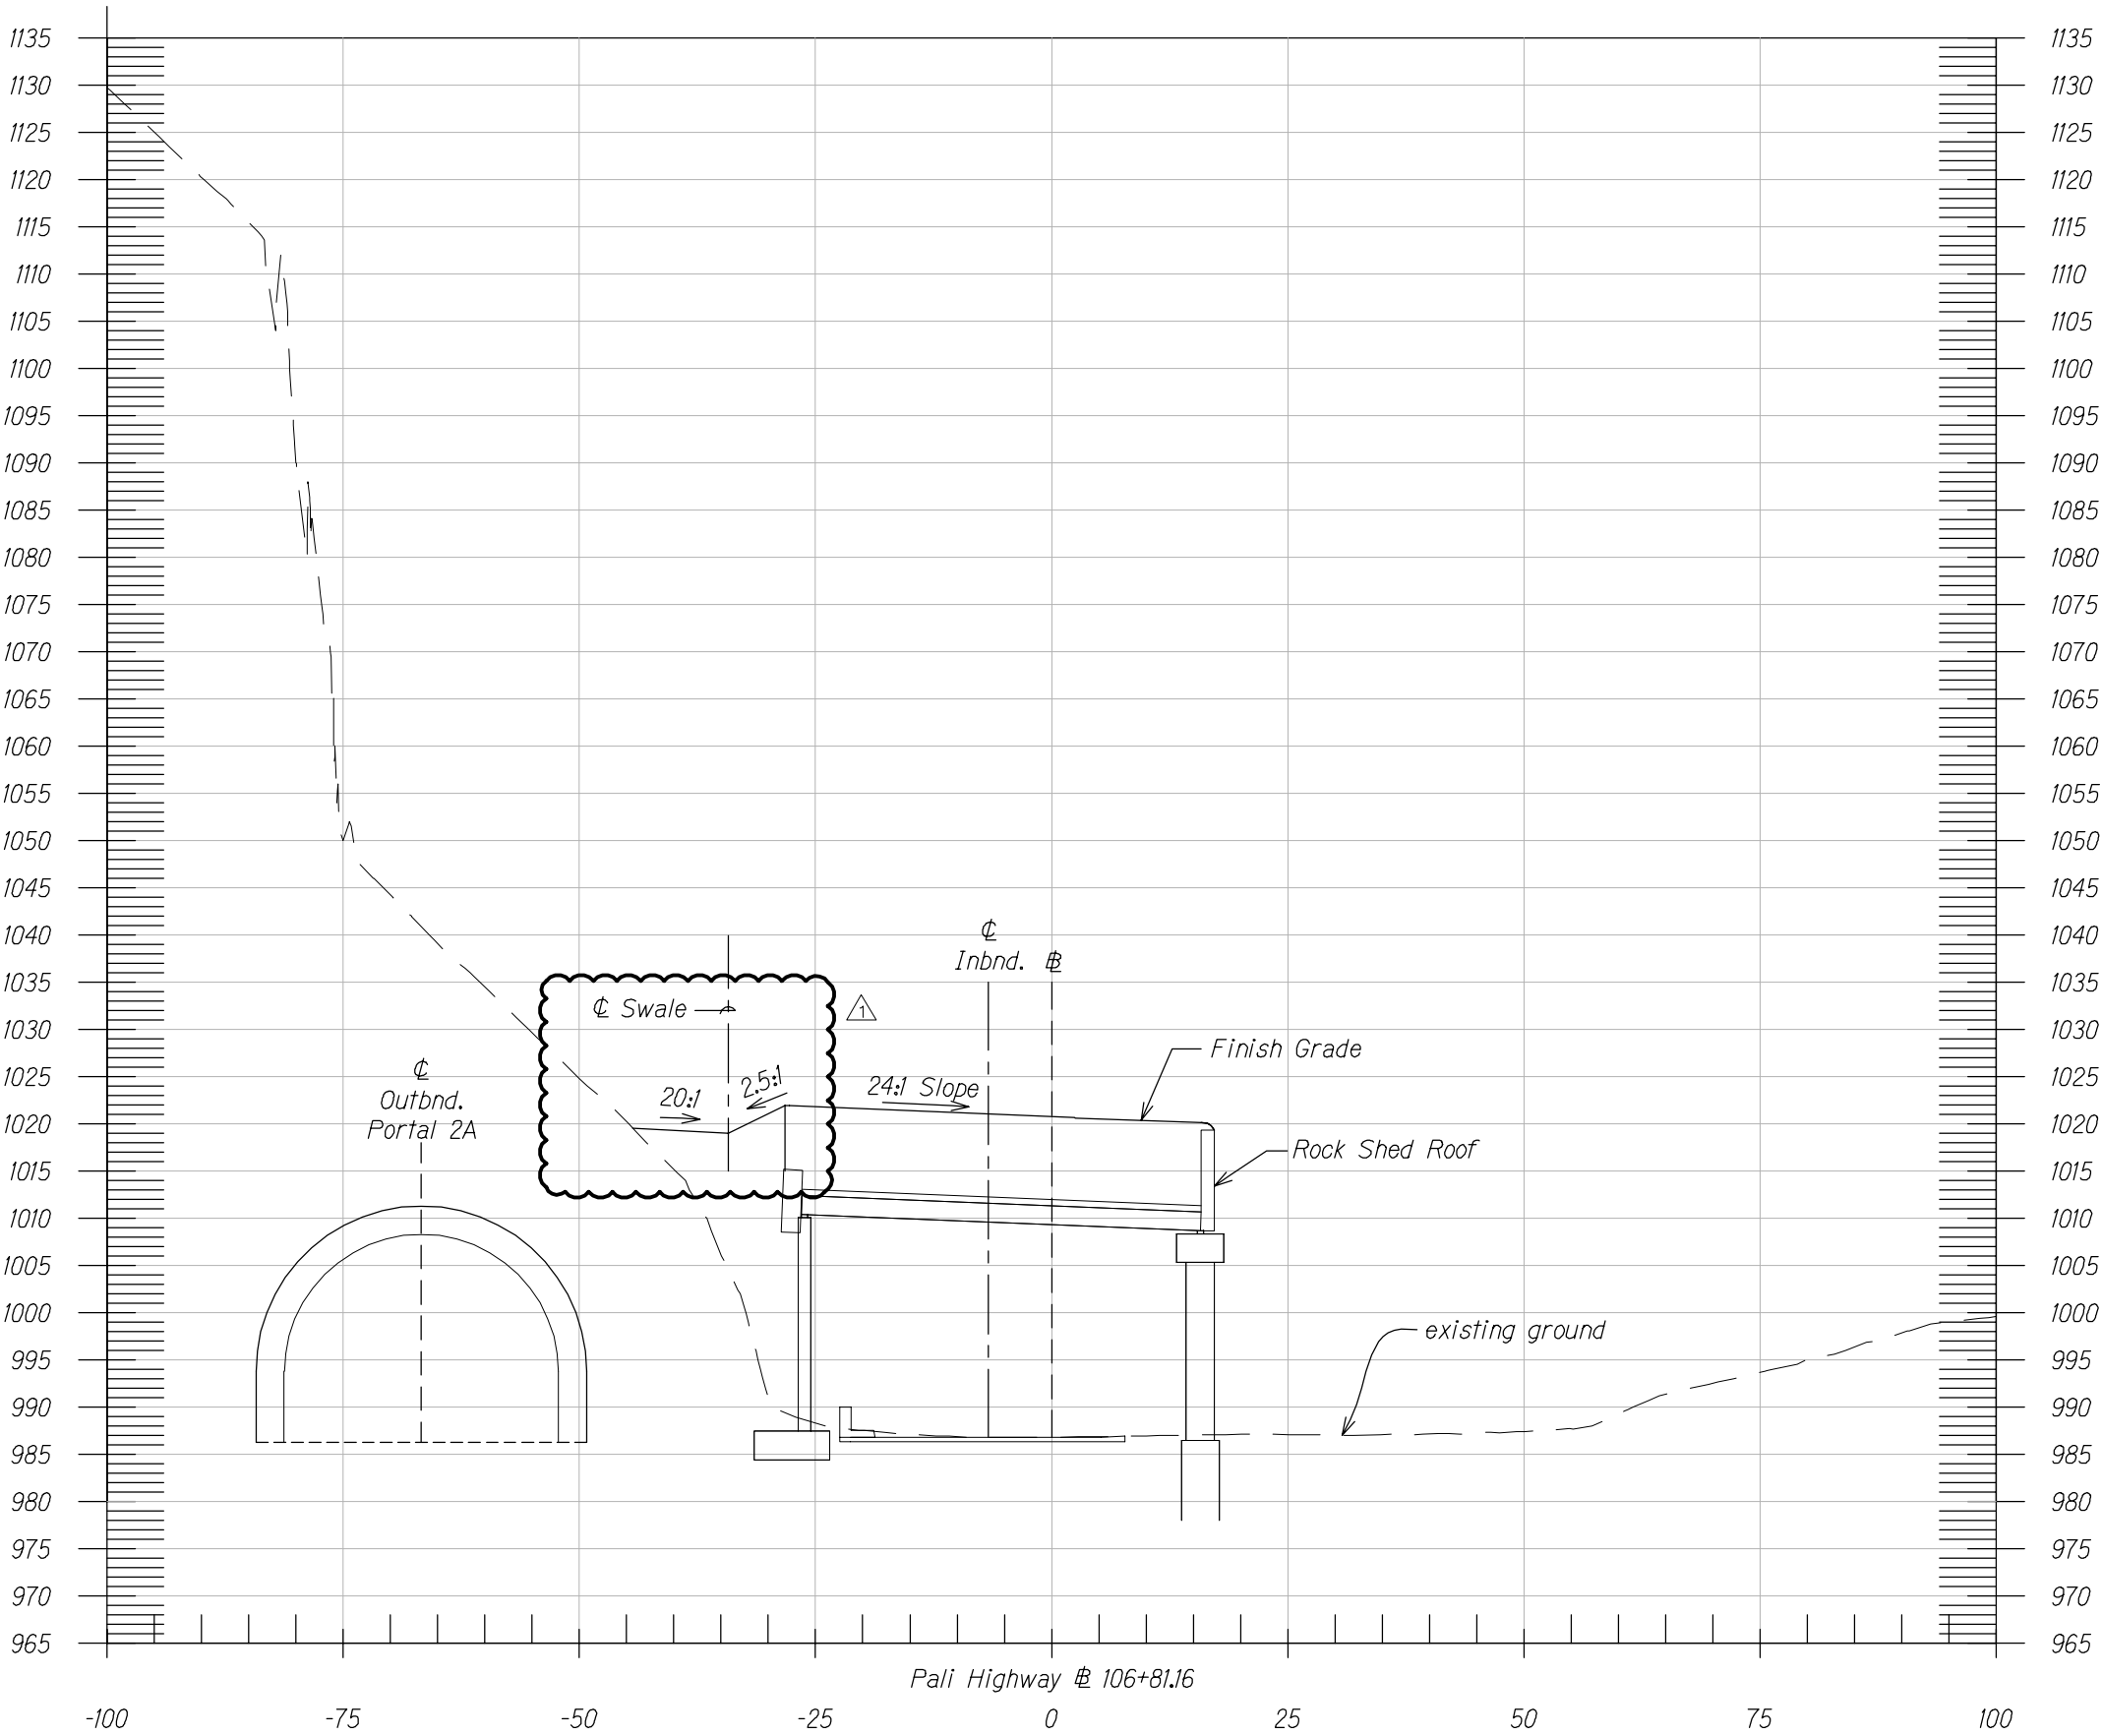

Pali Highway @ 106+81.16

Pali Highway @ 106+81.16

Section

Vertical: 1"=20'

Horizontal: 1"=20'

5/24/19	△	Revised Swale
Date		Revision

STATE OF HAWAII
DEPARTMENT OF TRANSPORTATION
HIGHWAYS DIVISION

CROSS SECTIONS


PALI HIGHWAY
LANDSLIDE MITIGATION PROJECT
FAP No. ER-22(002)

Scale: As Shown Date: May 6, 2019

SHEET No. P-6 OF 9 SHEETS

ADD 16

FED. ROAD DIST. NO.	STATE	FEDERAL AID PROJ. NO.	FISCAL YEAR	SHEET NO.	TOTAL SHEETS
HAWAII	HAW.	ER-22(002)	2019	ADD 17	94

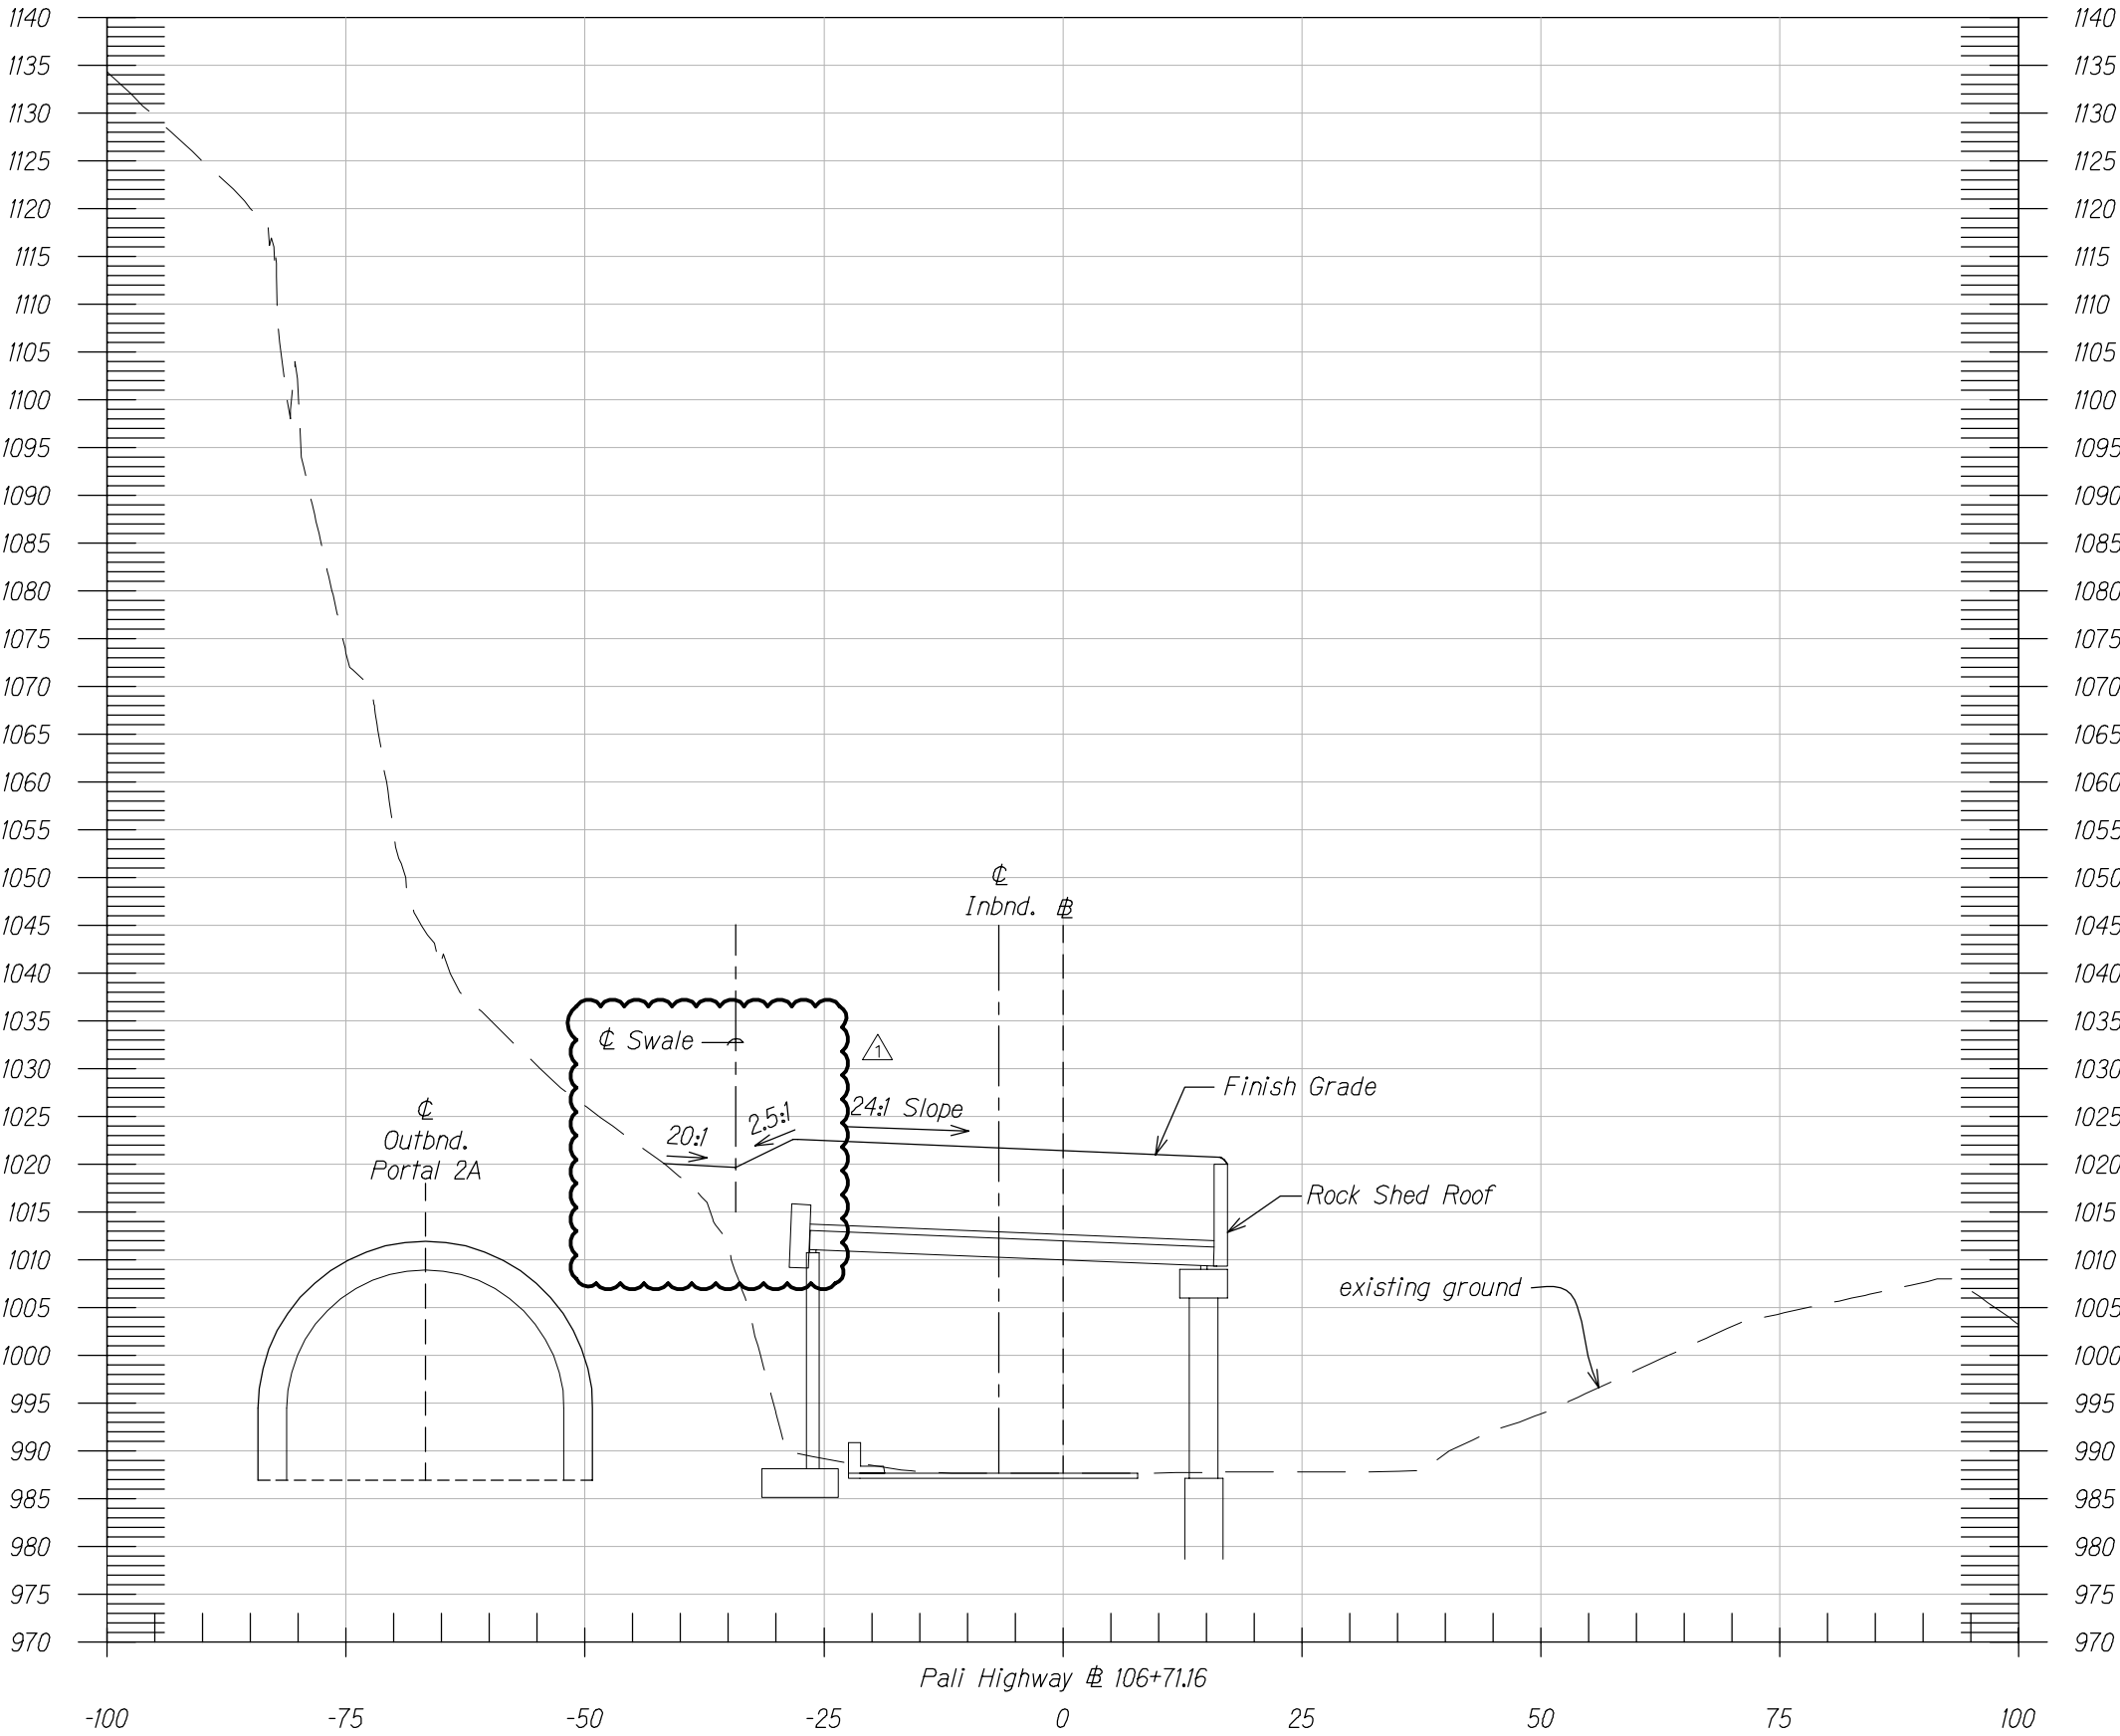

Pali Highway # 106+71.16

Pali Highway # 106+71.16
Section
Vertical: 1"=20'
Horizontal: 1"=20'

5/24/19	△	Revised Swale
Date		Revision

STATE OF HAWAII
DEPARTMENT OF TRANSPORTATION
HIGHWAYS DIVISION

CROSS SECTIONS


PALI HIGHWAY
LANDSLIDE MITIGATION PROJECT
FAP No. ER-22(002)

Scale: As Shown Date: May 6, 2019

SHEET No. P-7 OF 9 SHEETS

FED. ROAD DIST. NO.	STATE	FEDERAL AID PROJ. NO.	FISCAL YEAR	SHEET NO.	TOTAL SHEETS
HAWAII	HAW.	ER-22(002)	2019	ADD 18	94


SURVEY PLOTTED BY	DATE
DRAWN BY	
CHECKED BY	
NOTE BOOK	
QUANTITIES BY	
CHECKED BY	
N ^o .	

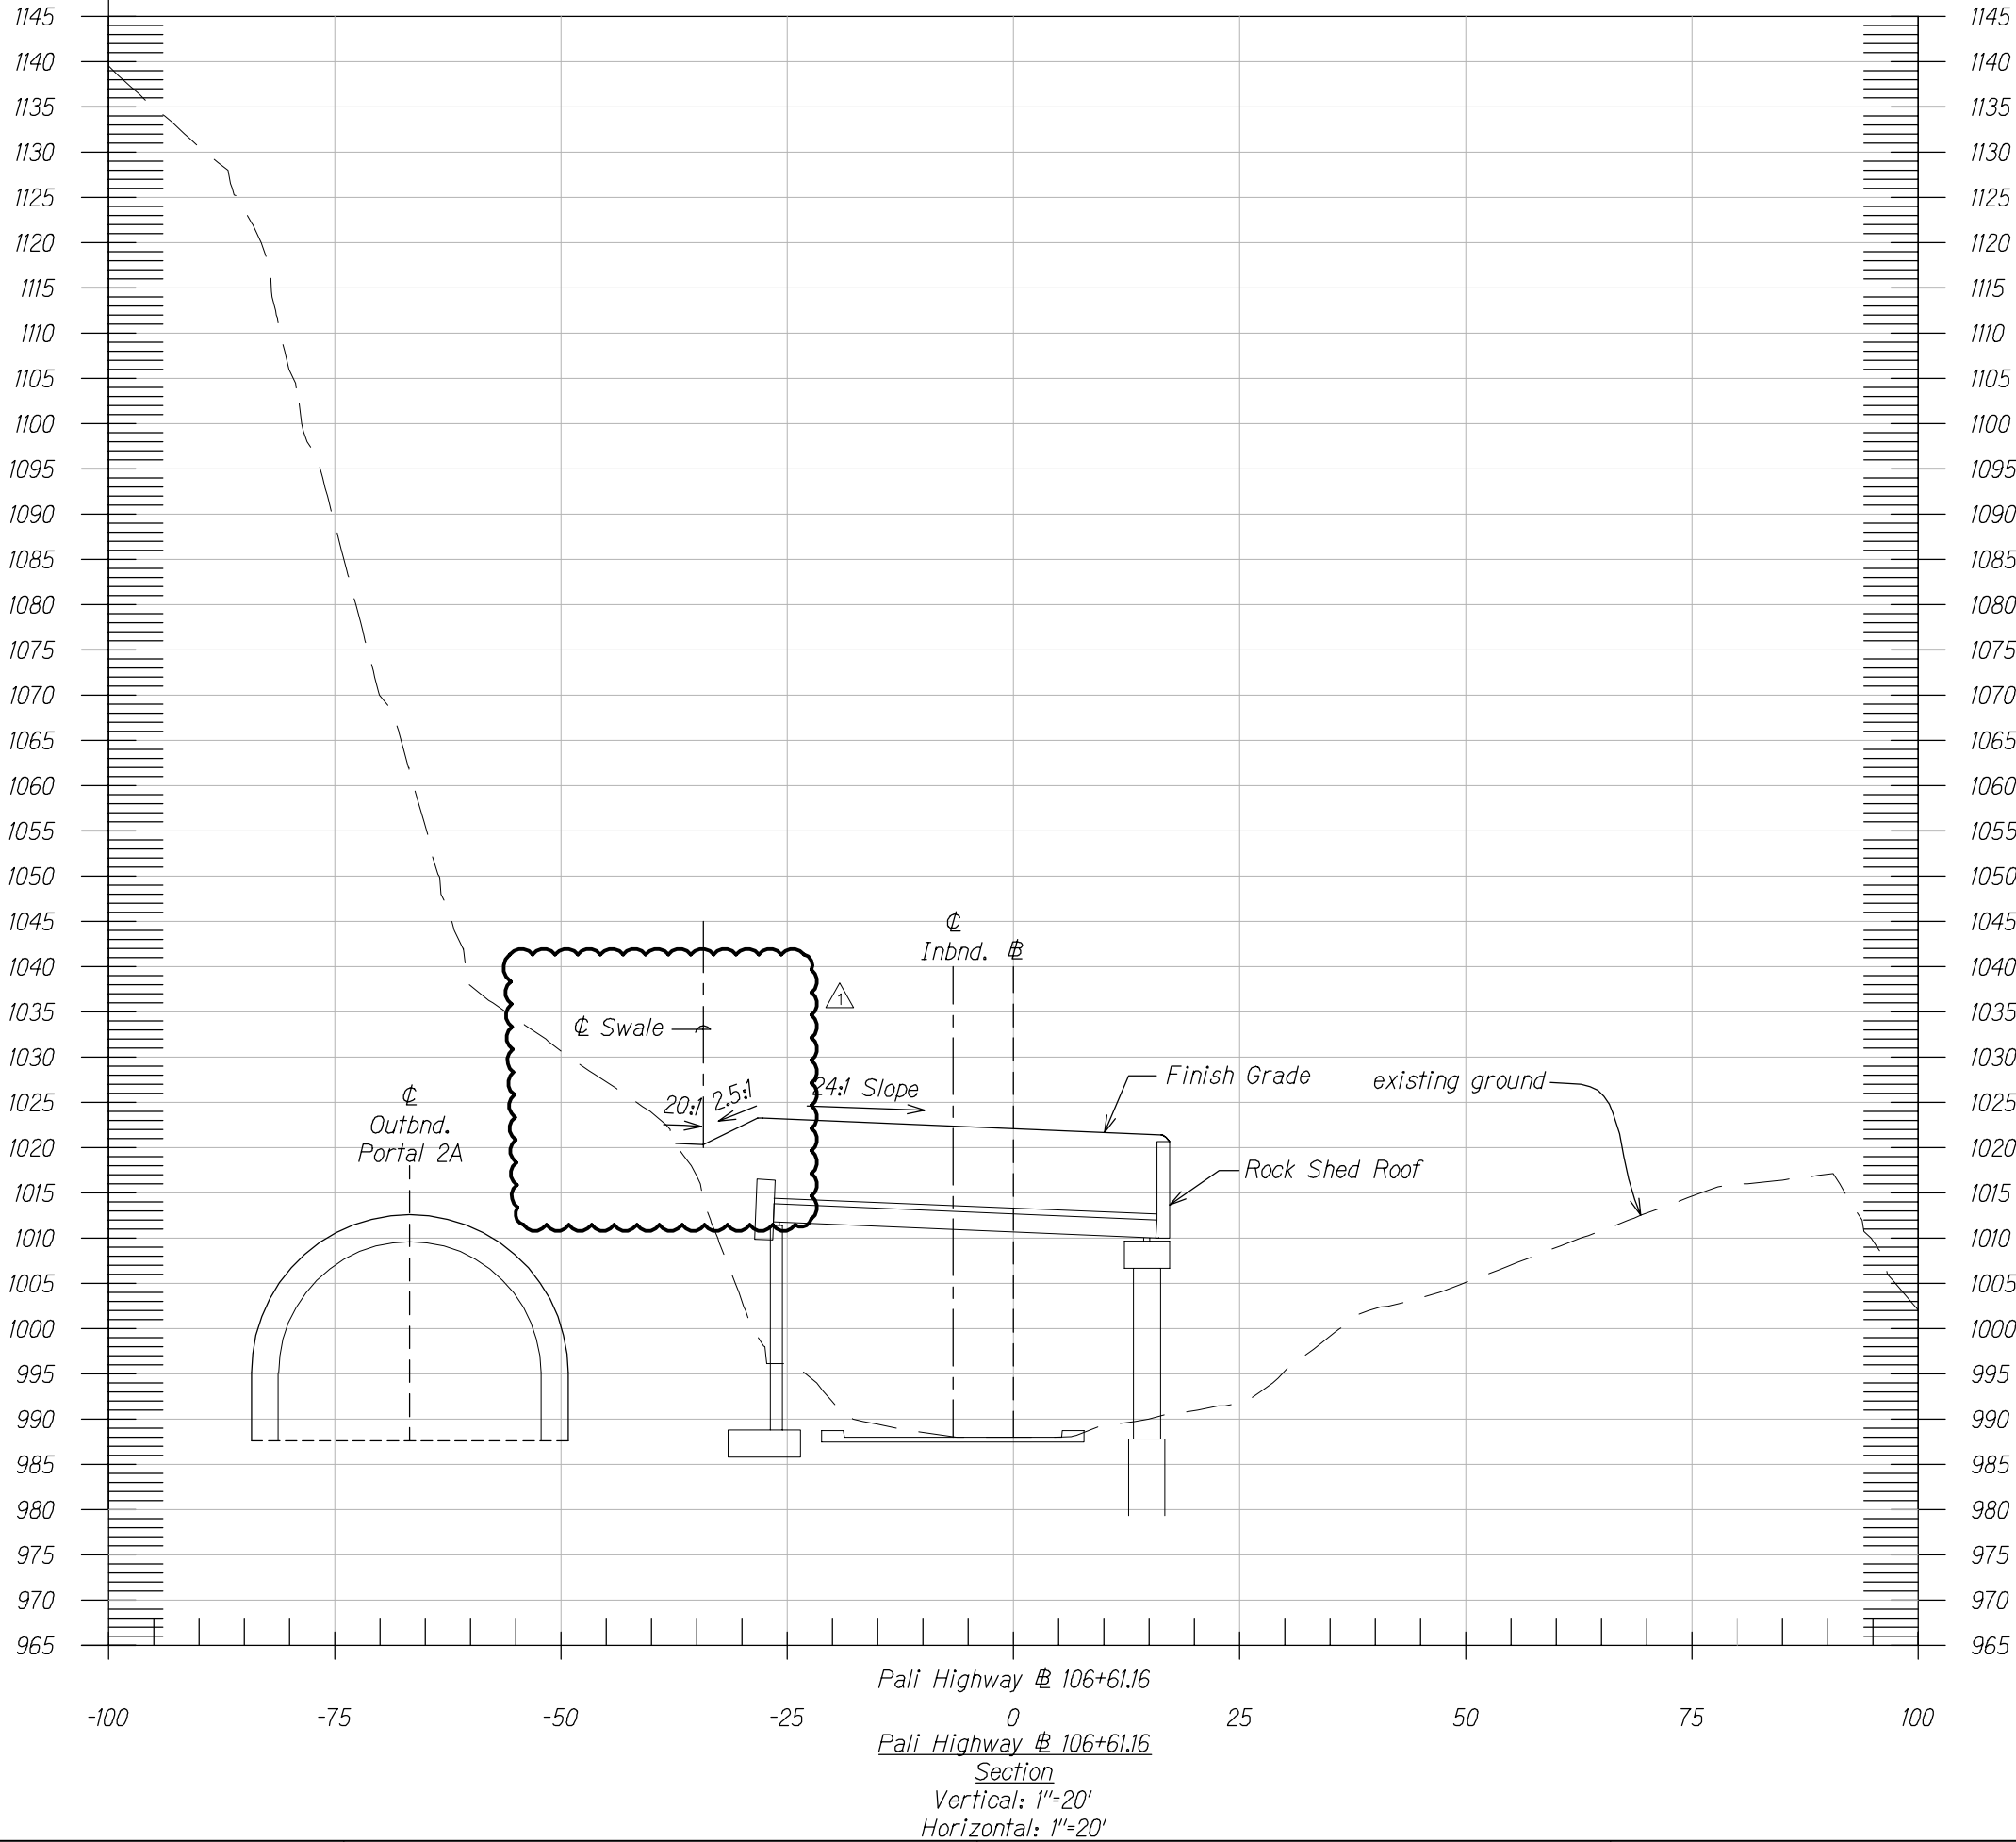

5/24/19	△	Revised Swale
Date		Revision

STATE OF HAWAII DEPARTMENT OF TRANSPORTATION HIGHWAYS DIVISION <u>CROSS SECTIONS</u> PALI HIGHWAY LANDSLIDE MITIGATION PROJECT FAP No. ER-22(002) Scale: As Shown Date: May 6, 2019	
SHEET No. P-8	OF 9 SHEETS

FED. ROAD DIST. NO.	STATE	FEDERAL AID PROJ. NO.	FISCAL YEAR	SHEET NO.	TOTAL SHEETS
HAWAII	HAW.	ER-22(002)	2019	ADD 19	94

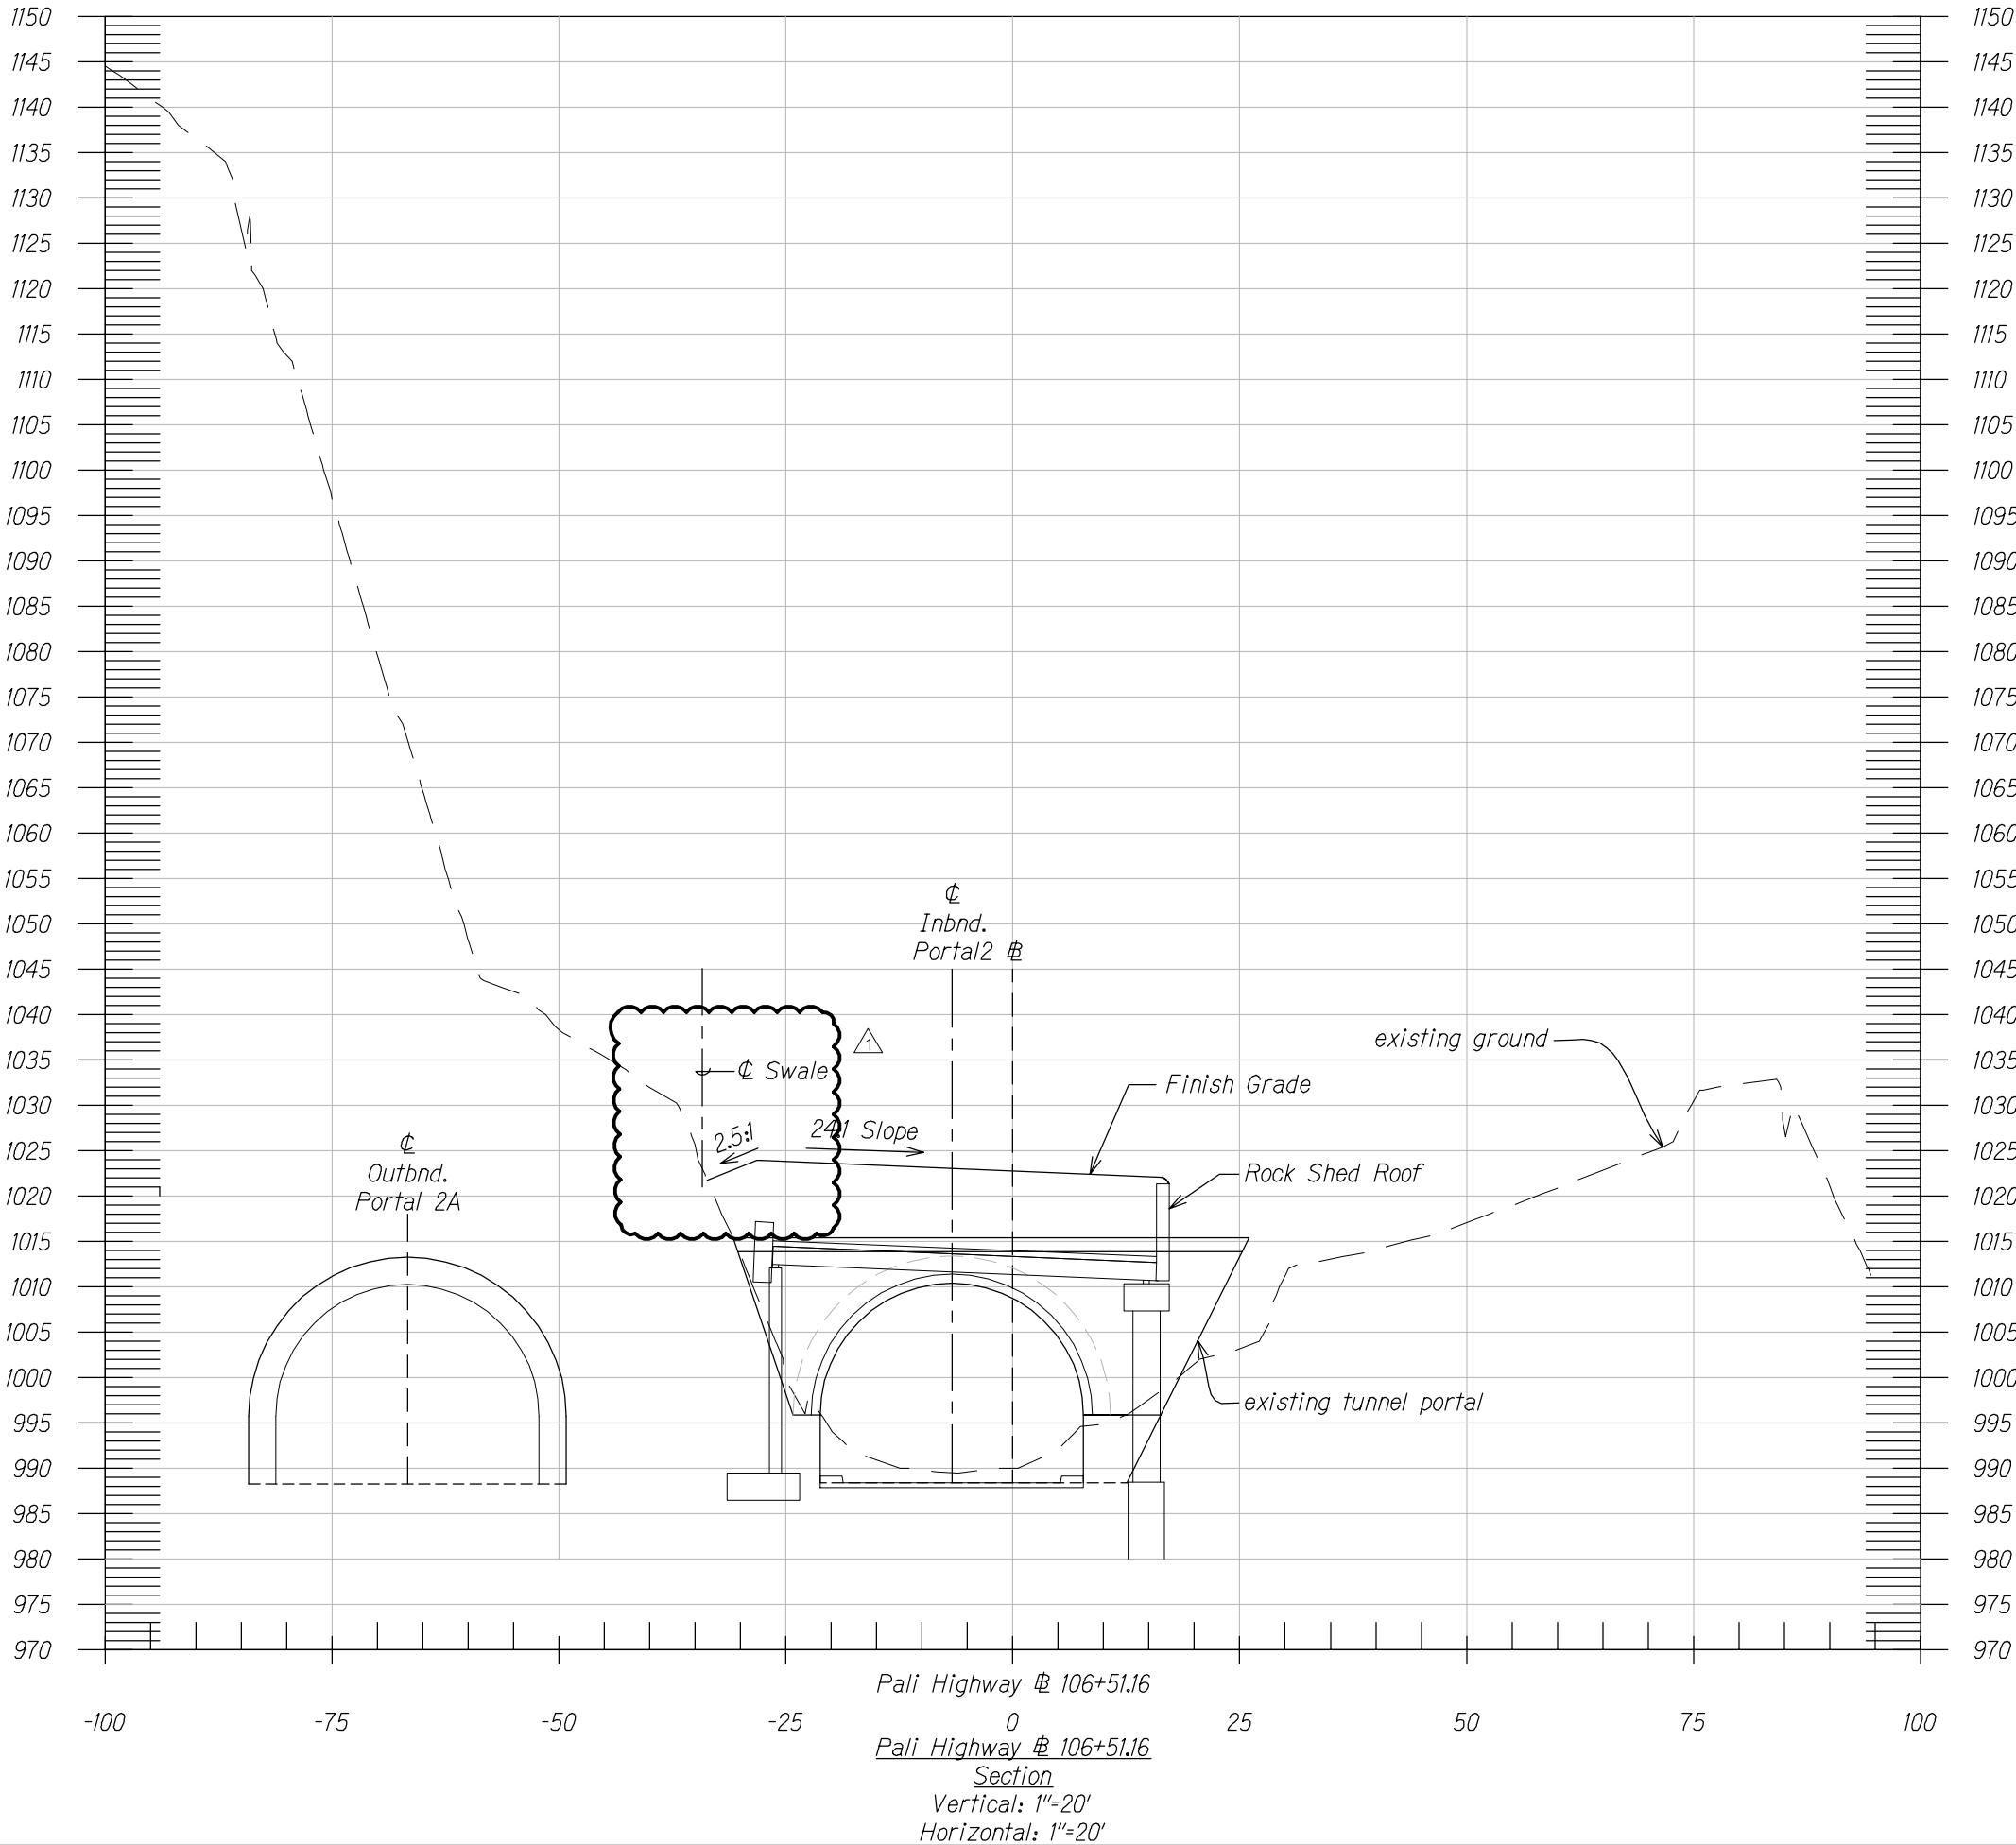

5/24/19	△	Revised Swale
Date		Revision

STATE OF HAWAII
DEPARTMENT OF TRANSPORTATION
HIGHWAYS DIVISION

CROSS SECTIONS

PALI HIGHWAY
LANDSLIDE MITIGATION PROJECT
FAP No. ER-22(002)

Scale: As Shown Date: May 6, 2019

SHEET No. P-9 OF 9 SHEETS