


| FED. ROAD DIST. NO. | STATE | FEDERAL AID PROJ. NO. | FISCAL YEAR | SHEET NO. | TOTAL SHEETS |
|---------------------|-------|-----------------------|-------------|-----------|--------------|
| HAWAII              | HAW.  | ER-22(002)            | 2019        | ADD 41    | 94           |


NOTES:

- Crosshole Sonic Logging (CSL) testing shall be performed on every drilled shaft. Shafts indicating irregular CSL readings may be subjected to additional testing.
- After CSL testing, a portion of the CSL test access tubes shall be removed in the transition zone to one inch above top of the drilled shaft elevation. Tubes shall be completely filled with non-shrink, non-metallic, cementitious grout of at least equal strength as drilled shaft prior to pouring the transition zone. See Structural General Note 4.K.
- Lap splice length for #10 vert. bar shall be 6'-6". No lap splices of vert. bars are allowed in the upper 40'-0" of the drilled shaft.
- Lapped splices shall have a minimum of 2'-0" vertically between splice points.
- Staggered splice points for longitudinal reinforcing shall not be more than 50% of the total at any section normal to the axis of the shaft.
- Lap splice length for #6 spirals shall be 3'-6" min. with a 135° hook bend at each end.
- Each end of the spiral shall have 1 1/2 extra turns with a 135° hook around a vertical reinforcing bar.
- Concrete or other non-corrosive spacing devices shall be used to maintain the reinforcement cage in position within the shaft.
- Bundled bars in the transition zone may consist of one headed vertical bar and one unheaded vertical bar.

Four Crosshole Sonic Logging (CSL) Test Access Tubes (2" Dia. Standard Pipe)

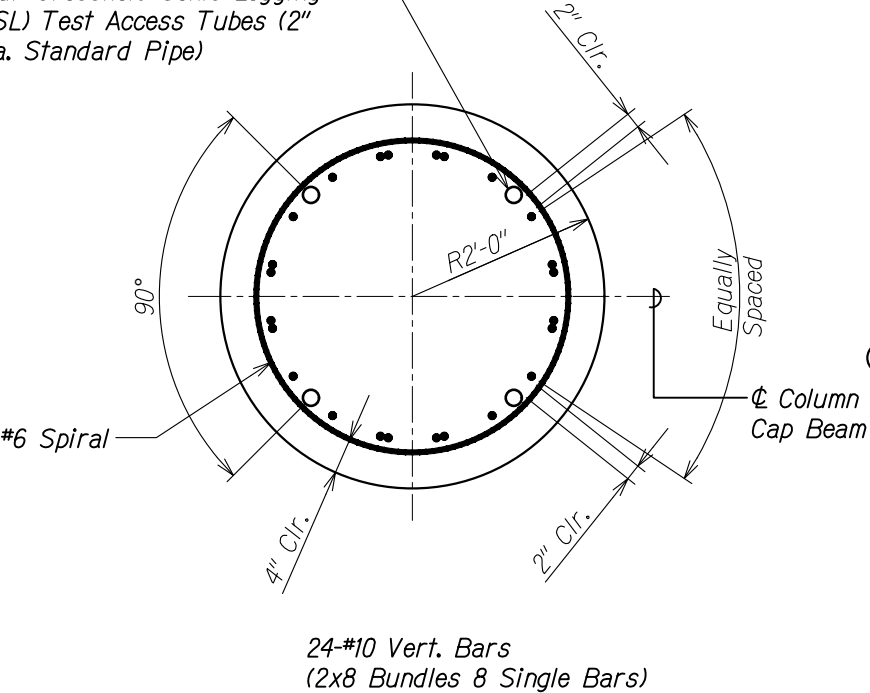

SECTION B  
Scale: 1" = 1'-0"

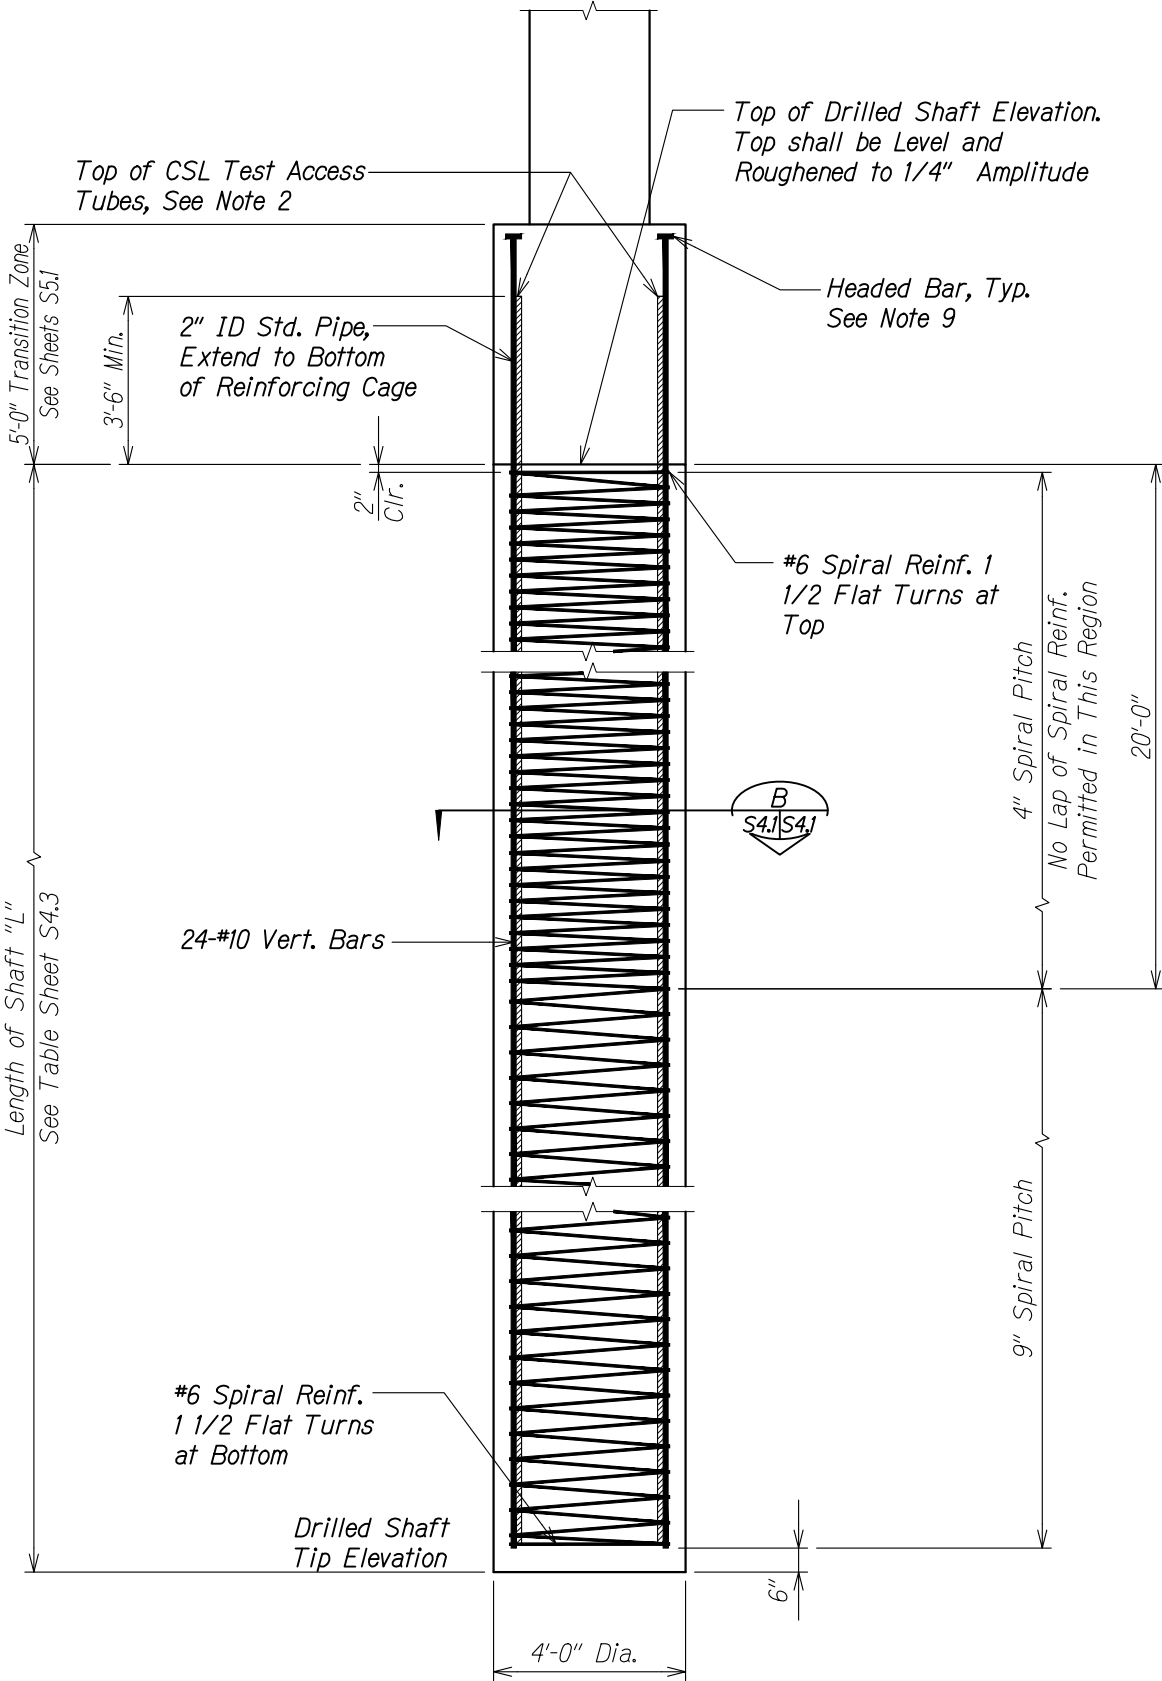


DRILLED SHAFT 1 AND 2 ELEVATION  
Scale: 1/2" = 1'-0"

|  |                   |
|--|-------------------|
| 5/24/19  | Revised Notes     |
| DATE   | REVISION          |
| STATE OF HAWAII<br>DEPARTMENT OF TRANSPORTATION<br>HIGHWAYS DIVISION     |                   |
| DRILLED SHAFT  |                   |
| PALI HIGHWAY<br>LANDSLIDE MITIGATION PROJECT<br>FAP Proj. No. ER-22(002) |                   |
| Scale: As Noted  | Date: May 6, 2019 |
| SHEET No. S41 OF 3 SHEETS  |                   |


| FED. ROAD DIST. NO. | STATE | FEDERAL AID PROJ. NO. | FISCAL YEAR | SHEET NO. | TOTAL SHEETS |
|---------------------|-------|-----------------------|-------------|-----------|--------------|
| HAWAII              | HAW.  | ER-22(002)            | 2019        | ADD 42    | 94           |

NOTES:

- Crosshole Sonic Logging (CSL) testing shall be performed on every drilled shaft. Shafts indicating irregular CSL readings may be subjected to additional testing.
- After CSL testing, a portion of the CSL test access tubes shall be removed in the transition zone to one inch above top of the drilled shaft elevation. Tubes shall be completely filled with non-shrink, non-metallic, cementitious grout of at least equal strength as drilled shaft prior to pouring the transition zone. See Structural General Note 4.K.
- Lap splice length for #11 vert. bar shall be 8'-0". No lap splices of vert. bars are allowed in the upper 40'-0" of the drilled shaft.
- Lapped splices shall have a minimum of 2'-0" vertically between splice points.
- Staggered splice points for longitudinal reinforcing shall not be more than 50% of the total at any section normal to the axis of the shaft.
- Lap splice length for #6 spirals shall be 3'-6" min. with a 135° hook bend at each end.
- Each end of the spiral shall have 1 1/2 extra turns with a 135° hook around a vertical reinforcing bar.
- Concrete or other non-corrosive spacing devices shall be used to maintain the reinforcement cage in position within the shaft.
- Finish grade shown for illustrative purpose. See civil sheets.
- Bundled bars in the transition zone may consist of one headed vertical bar and one unheaded vertical bar.

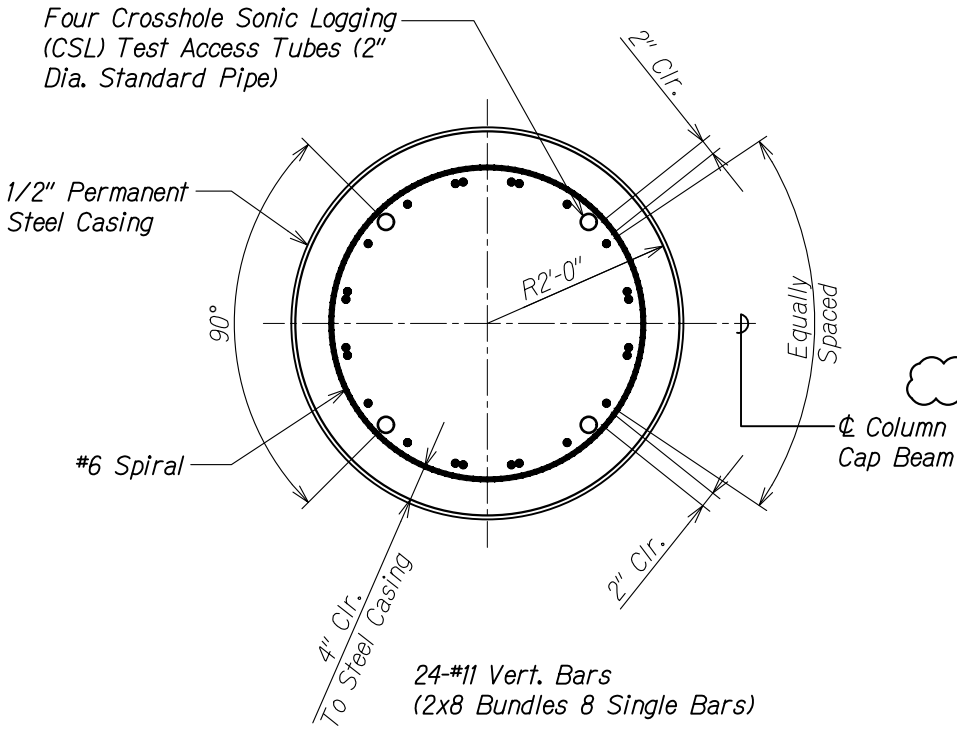

SECTION B  
Scale: 1" = 1'-0"

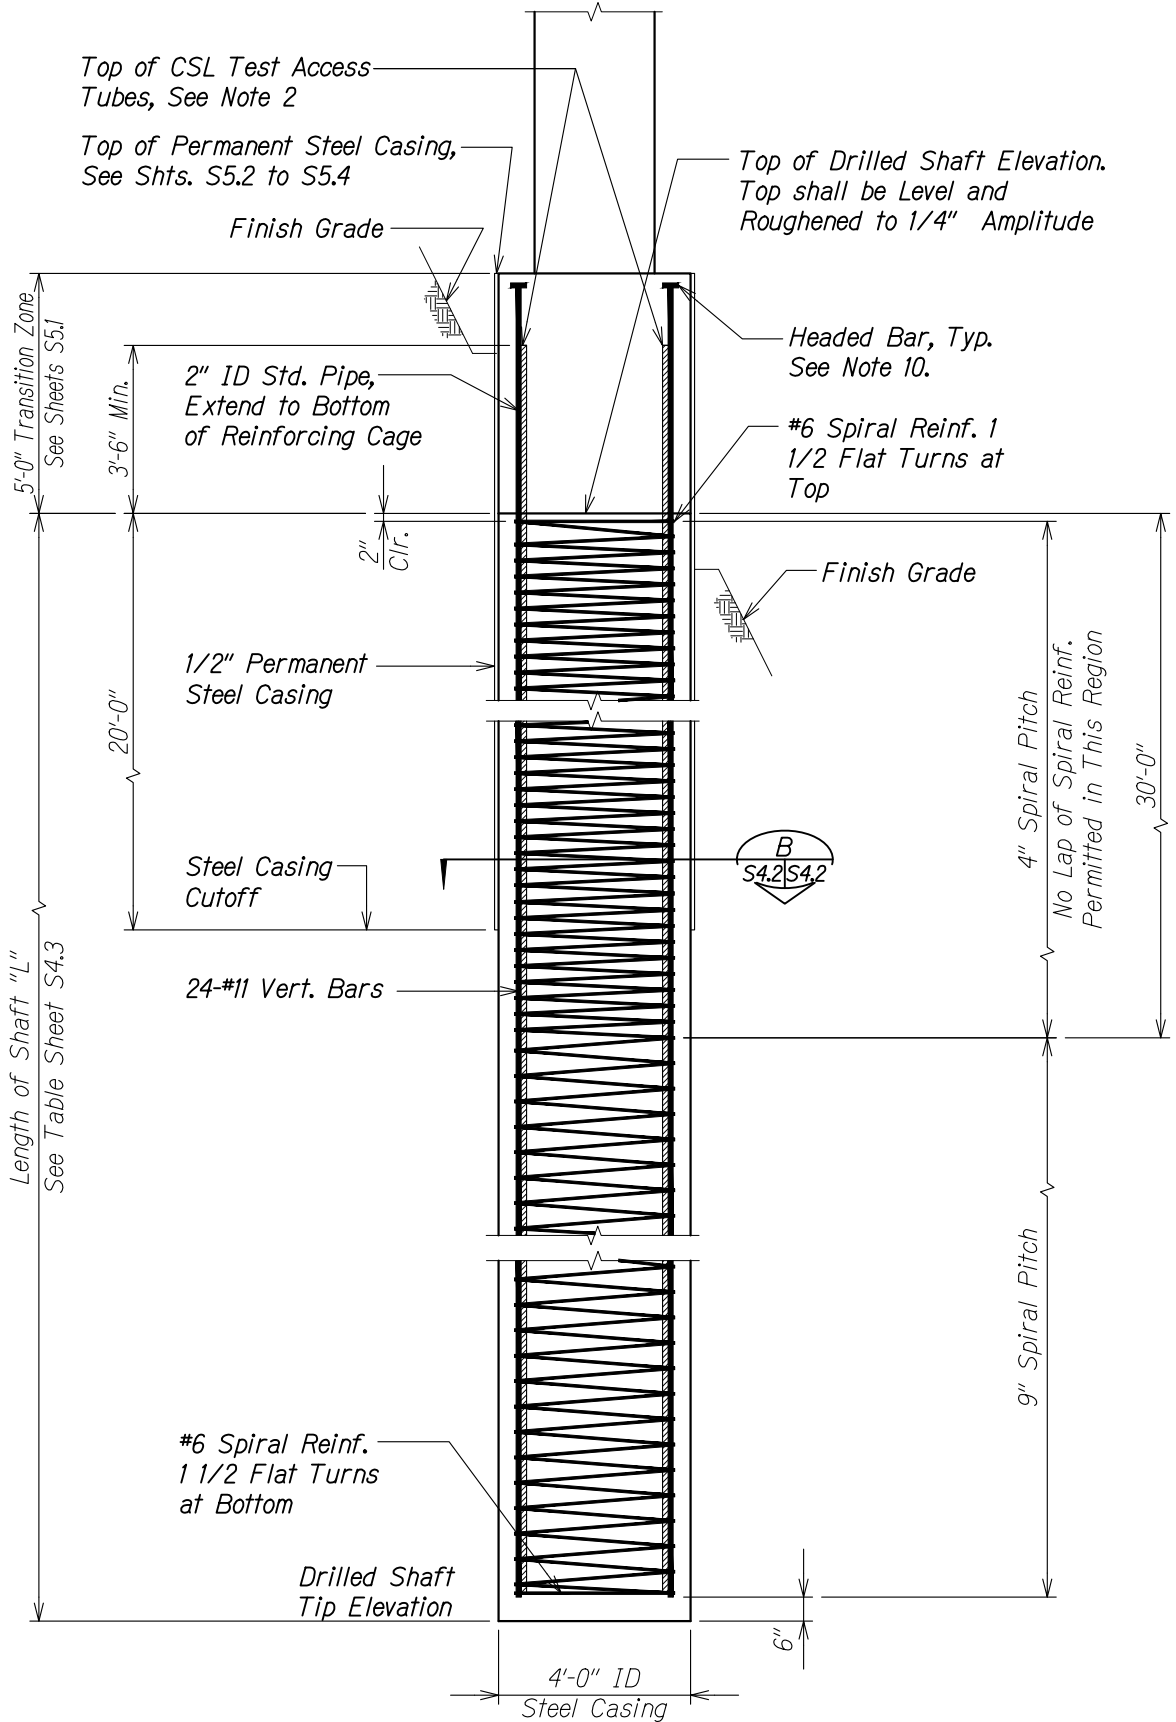

DRILLED SHAFT 3 ELEVATION A  
Scale: 1/2" = 1'-0"

|         |                 |
|---------|-----------------|
| 5/24/19 | 1 Revised Notes |
| DATE    | REVISION        |

STATE OF HAWAII  
DEPARTMENT OF TRANSPORTATION  
HIGHWAYS DIVISION

**DRILLED SHAFT**

**PALI HIGHWAY**  
**LANDSLIDE MITIGATION PROJECT**  
**FAP Proj. No. ER-22(002)**

Scale: As Noted Date: May 6, 2019

SHEET No. S4.2 OF 3 SHEETS

| DRILLED SHAFT SCHEDULE                                    |        |        |        |
|---|--------|--------|--------|
| Drilled Shaft Mark  | 1      | 2      | 3      |
| Drilled Shaft Diameter                                    | 4'-0"  | 4'-0"  | 4'-0"  |
| Top of Shaft Elevation                                    | 982.60 | 979.00 | 975.00 |
| Estimated Drilled Shaft Tip Elevation                     | 952.60 | 949.00 | 935.00 |
| Estimated Length of Shaft (L)                             | 30'-0" | 30'-0" | 40'-0" |
| Strength Limit State<br>Compression Demand (kips)         | 1451   | 1522   | 500    |
| Strength Limit State<br>Compression Capacity (kips)       | 1540   | 1540   | 660    |
| Extreme Event Limit State<br>Compression Demand (kips)    | 1928   | 1988   | 1150   |
| Extreme Event Limit State<br>Compression Capacity (kips)  | 2800   | 2800   | 1200   |
| Non-Redundant Single Shaft<br>Compression Capacity (kips) | 3500   | 3500   | 1500   |

Notes:

- For 4'-0" dia. drilled shafts details see Shts. S4.1 and S4.2.
- For Foundation Plan see Sht. S1.4.
- All excavation and drilling operations for foundations shall be monitored by Geolabs, Inc.
- Drilling of adjacent shafts within three drilled shaft diameters shall not commence until the shaft concrete has cured a minimum of 24 hours.
- Drilled shaft tip elevations are estimated. The actual length of the shaft and drilled shaft tip elevations will be determined by Geolabs, Inc.
- Drilled shaft tip elevations shall be verified by Geolabs, Inc. prior to placing reinforcement and concrete. Concrete shall be placed within 24 hours after drilling, but shall not be placed without prior approval of Geolabs, Inc.

|               |                   |      |
|---------------|-------------------|------|
| ORIGINAL PLAN | SURVEY PLOTTED BY | DATE |
| NOTE BOOK     | DRAWN BY          |      |
| No.           | DESIGNED BY       |      |
|               | CHECKED BY        |      |

DRAWING NAME: Z:\00 ONGOING\19-014.1 PALI ROOF SHED-WSP TM 01 CAD\05-06-19 TOPO\PLM-S0403 DSHAFT SCHED.DWG PLOT TIME: 05-06-19, 11:45 PM)

STATE OF HAWAII  
DEPARTMENT OF TRANSPORTATION  
HIGHWAYS DIVISION

DRILLED SHAFT SCHEDULE

PALI HIGHWAY  
LANDSLIDE MITIGATION PROJECT  
FAP Proj. No. ER-22(002)


Scale: NoneDate: May 6, 2019

SHEET No. S4.3 OF 3 SHEETS




| FED. ROAD DIST. NO. | STATE | FEDERAL AID PROJ. NO. | FISCAL YEAR | SHEET NO. | TOTAL SHEETS |
|---------------------|-------|-----------------------|-------------|-----------|--------------|
| HAWAII              | HAW.  | ER-22(002)            | 2019        | ADD 45    | 94           |

To Honolulu

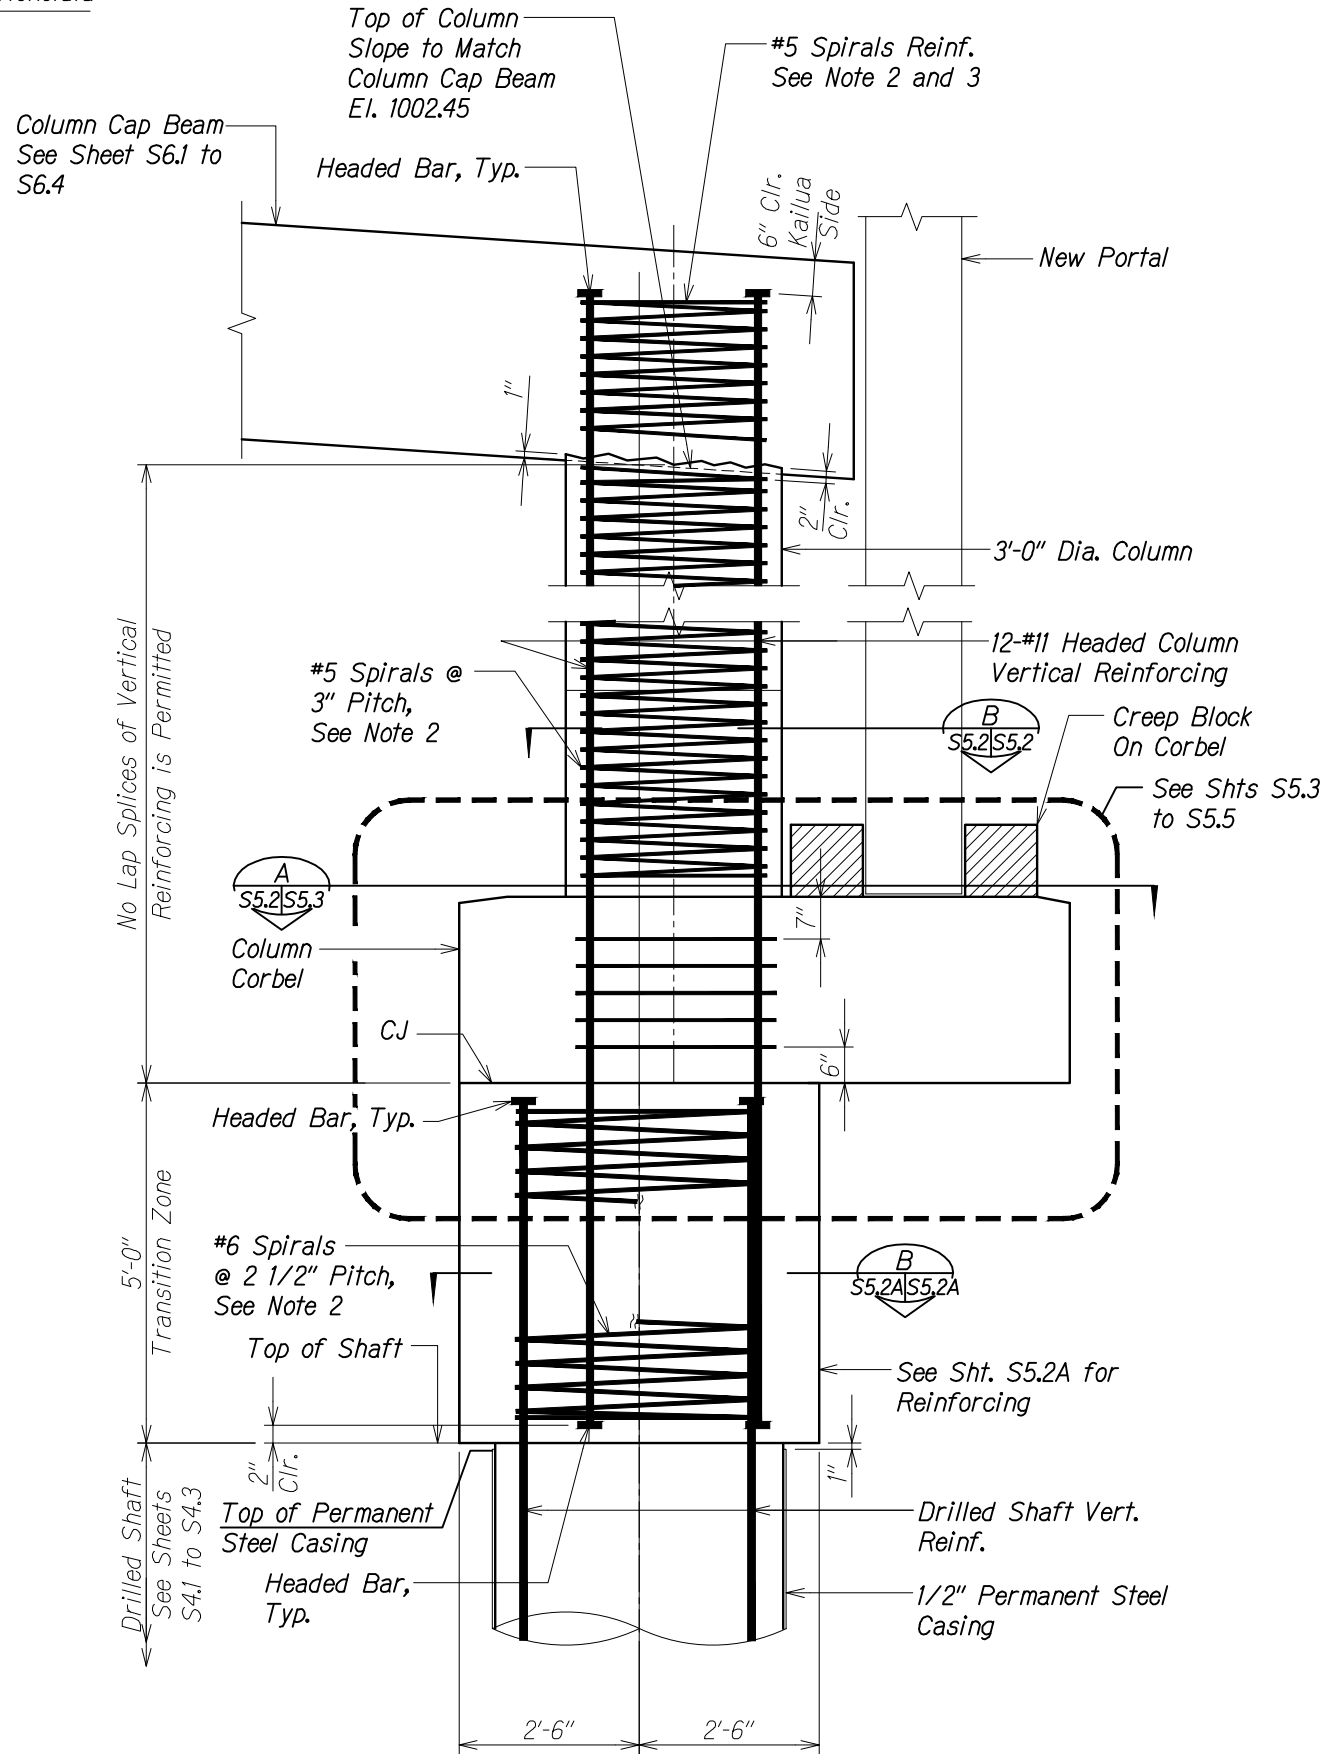



**COLUMN 3 ELEVATION**  
Scale: 3/4" = 1'-0"

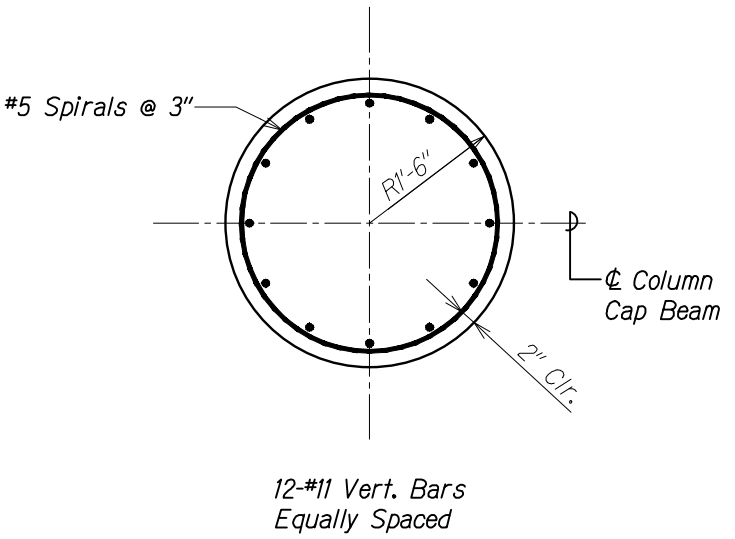- Notes:**
1. All construction joints shall be cleaned and roughen to 1/4" Amplitude.
  2. Each end of the spiral shall have 1 1/2" extra turns with 135° hook around a vertical bar.
  3. Spirals may be discontinuous at the column cap beam to allow for placement of the horizontal reinforcement in the column cap beam.
  4. Top of column elevation shall be taken at  $\phi$  column.
  5. The Contractor shall provide template including details showing exact location of rebars so that no interference will occur between column vertical reinforcement and column cap beam horizontal reinforcement.



**COLUMN SECTION**  
Scale: 1" = 1'-0"

|         |   |   |
|---------|---|---|
| 6/6/19  |  | <i>Revised Section Based on As-Built Conditions</i> |
| 5/24/19 |  | <i>Revised Section</i>                              |
| DATE    | REVISION  |   |

STATE OF HAWAII  
DEPARTMENT OF TRANSPORTATION  
HIGHWAYS DIVISION

**COLUMN 3**


**ELEVATION AND SECTIONS**

*PALI HIGHWAY*  
*LANDSLIDE MITIGATION PROJECT*  
*FAP Proj. No. ER-22(002)*

Scale: *As Noted*      Date: *May 6, 2019*


SHEET No. *S5.2* OF *5* SHEETS

| FED. ROAD DIST. NO. | STATE | FEDERAL AID PROJ. NO. | FISCAL YEAR | SHEET NO. | TOTAL SHEETS |
|---------------------|-------|-----------------------|-------------|-----------|--------------|
| HAWAII              | HAW.  | ER-22(002)            | 2019        | ADD 45S-1 | 94           |

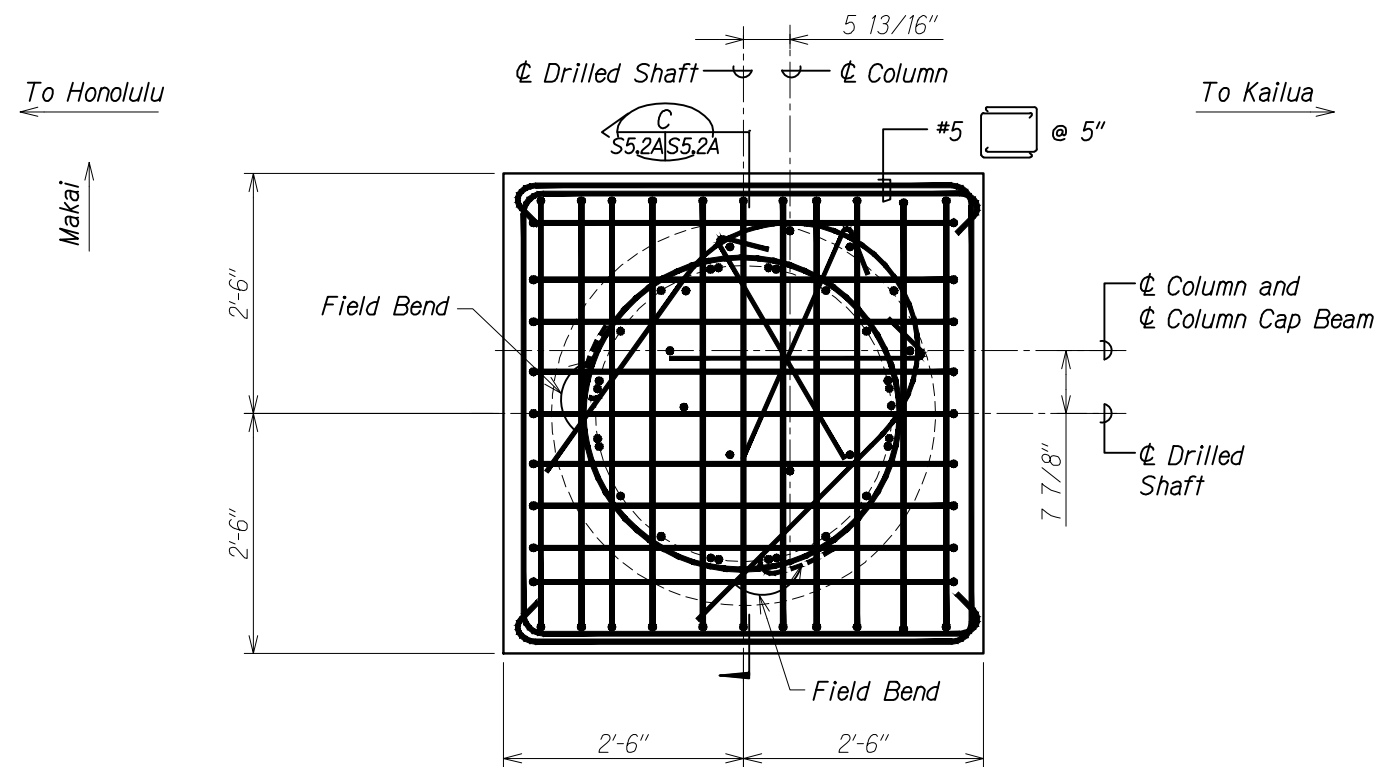


TRANSITION ZONE SECTION  
AT TOP AND BOTTOM

Scale: 1" = 1'-0"

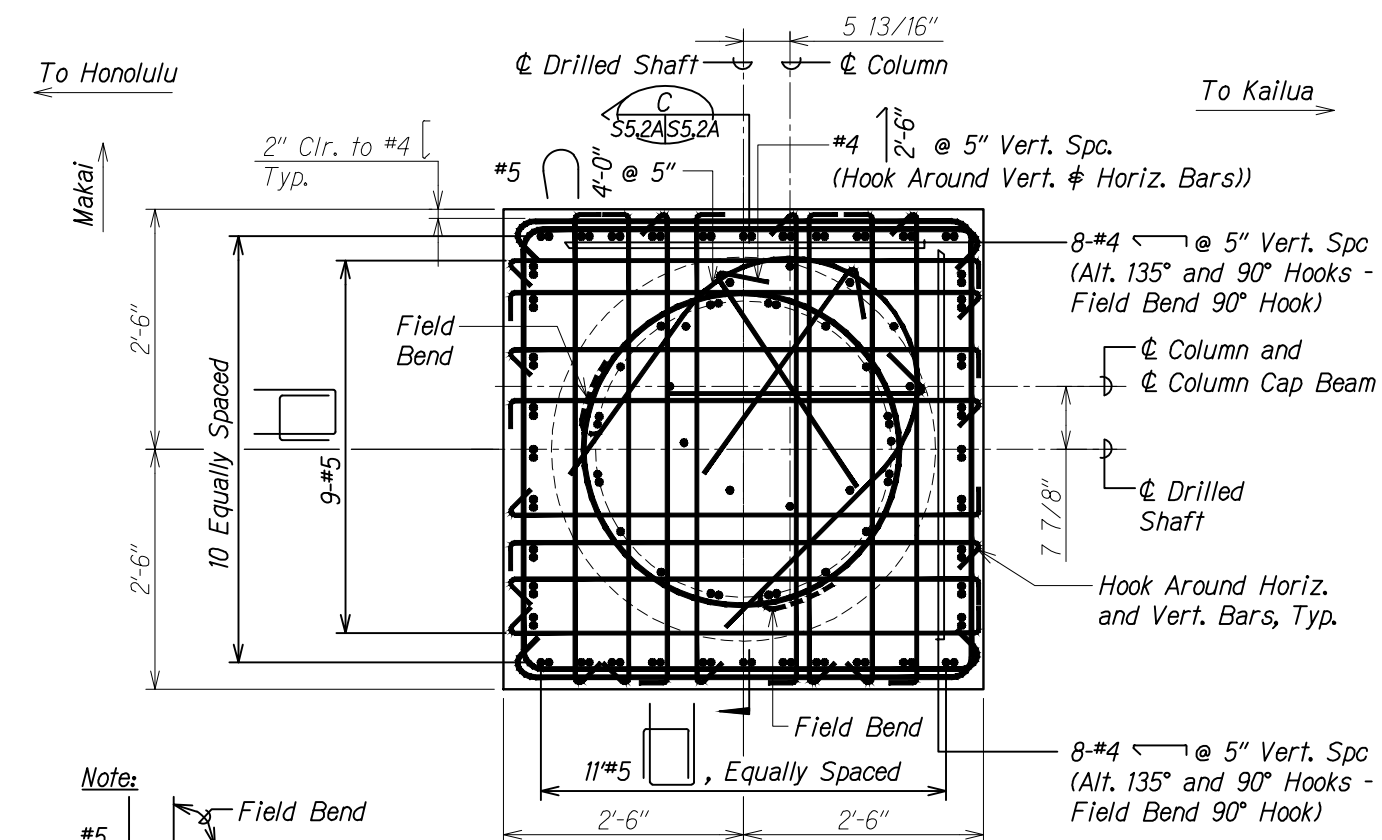


Note:

#5  *Field Bend*  
after inserting L through  
drilled shaft spirals.



TRANSITION ZONE SECTION  
AT MID-HEIGHT

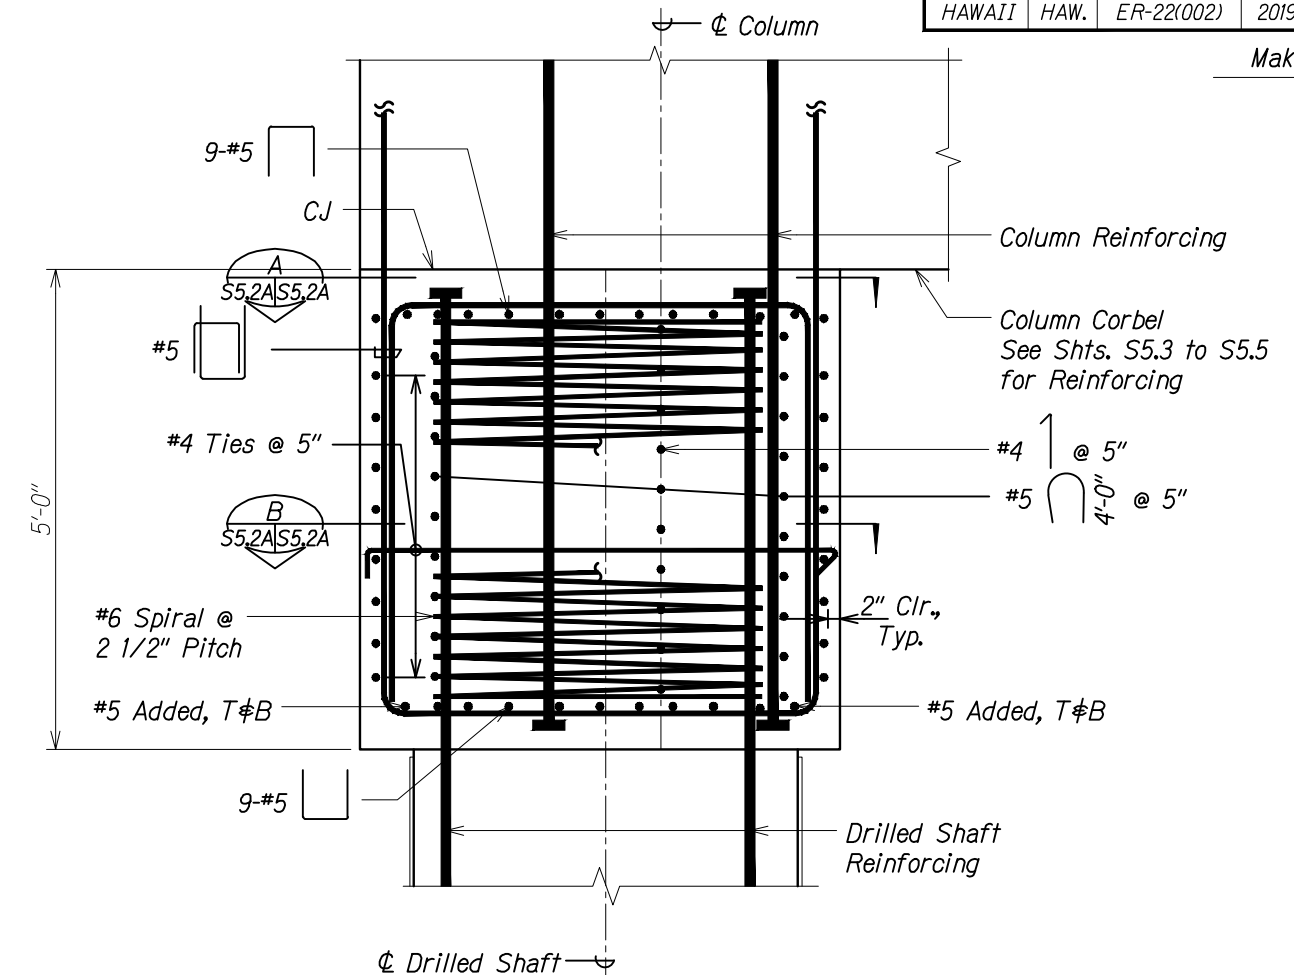Scale: 1" = 1'-0"



TRANSITION ZONE SECTION,

Scale: 1" = 1'-0"

|         |   |
|---------|---|
| 6/6/19  |  <i>New Sheet Based on As-Built Conditions</i> |
| 5/24/19 |  <i>Revised Section</i>                        |
| DATE    | REVISION  |

STATE OF HAWAII  
DEPARTMENT OF TRANSPORTATION  
HIGHWAYS DIVISION

**COLUMN 3**

**TRANSITION ZONE SECTIONS**

**PALI HIGHWAY**  
**LANDSLIDE MITIGATION PROJECT**  
**FAP Proj. No. ER-22(002)**

*Scale: As Noted*      *Date: May 6, 2019*

SHEET No. **S5.2A** OF    **5**    SHEETS

**ADD 45S-1**

DRAWING NAME: Z:\00 QINGGONG\19-014.1 PA1 ROOF SHED-WSP.TA.01 CAD\06-06-19 COL 3 ASE\PI M-SQ501 ADD1 ASE COL.DWG PLOT TIME: 06-06-19 10:00 AM)