


FED. ROAD DIST. NO.	STATE	FEDERAL AID PROJ. NO.	FISCAL YEAR	SHEET NO.	TOTAL SHEETS
HAWAII	HAW.	ER-22(002)	2019	ADD 3	94

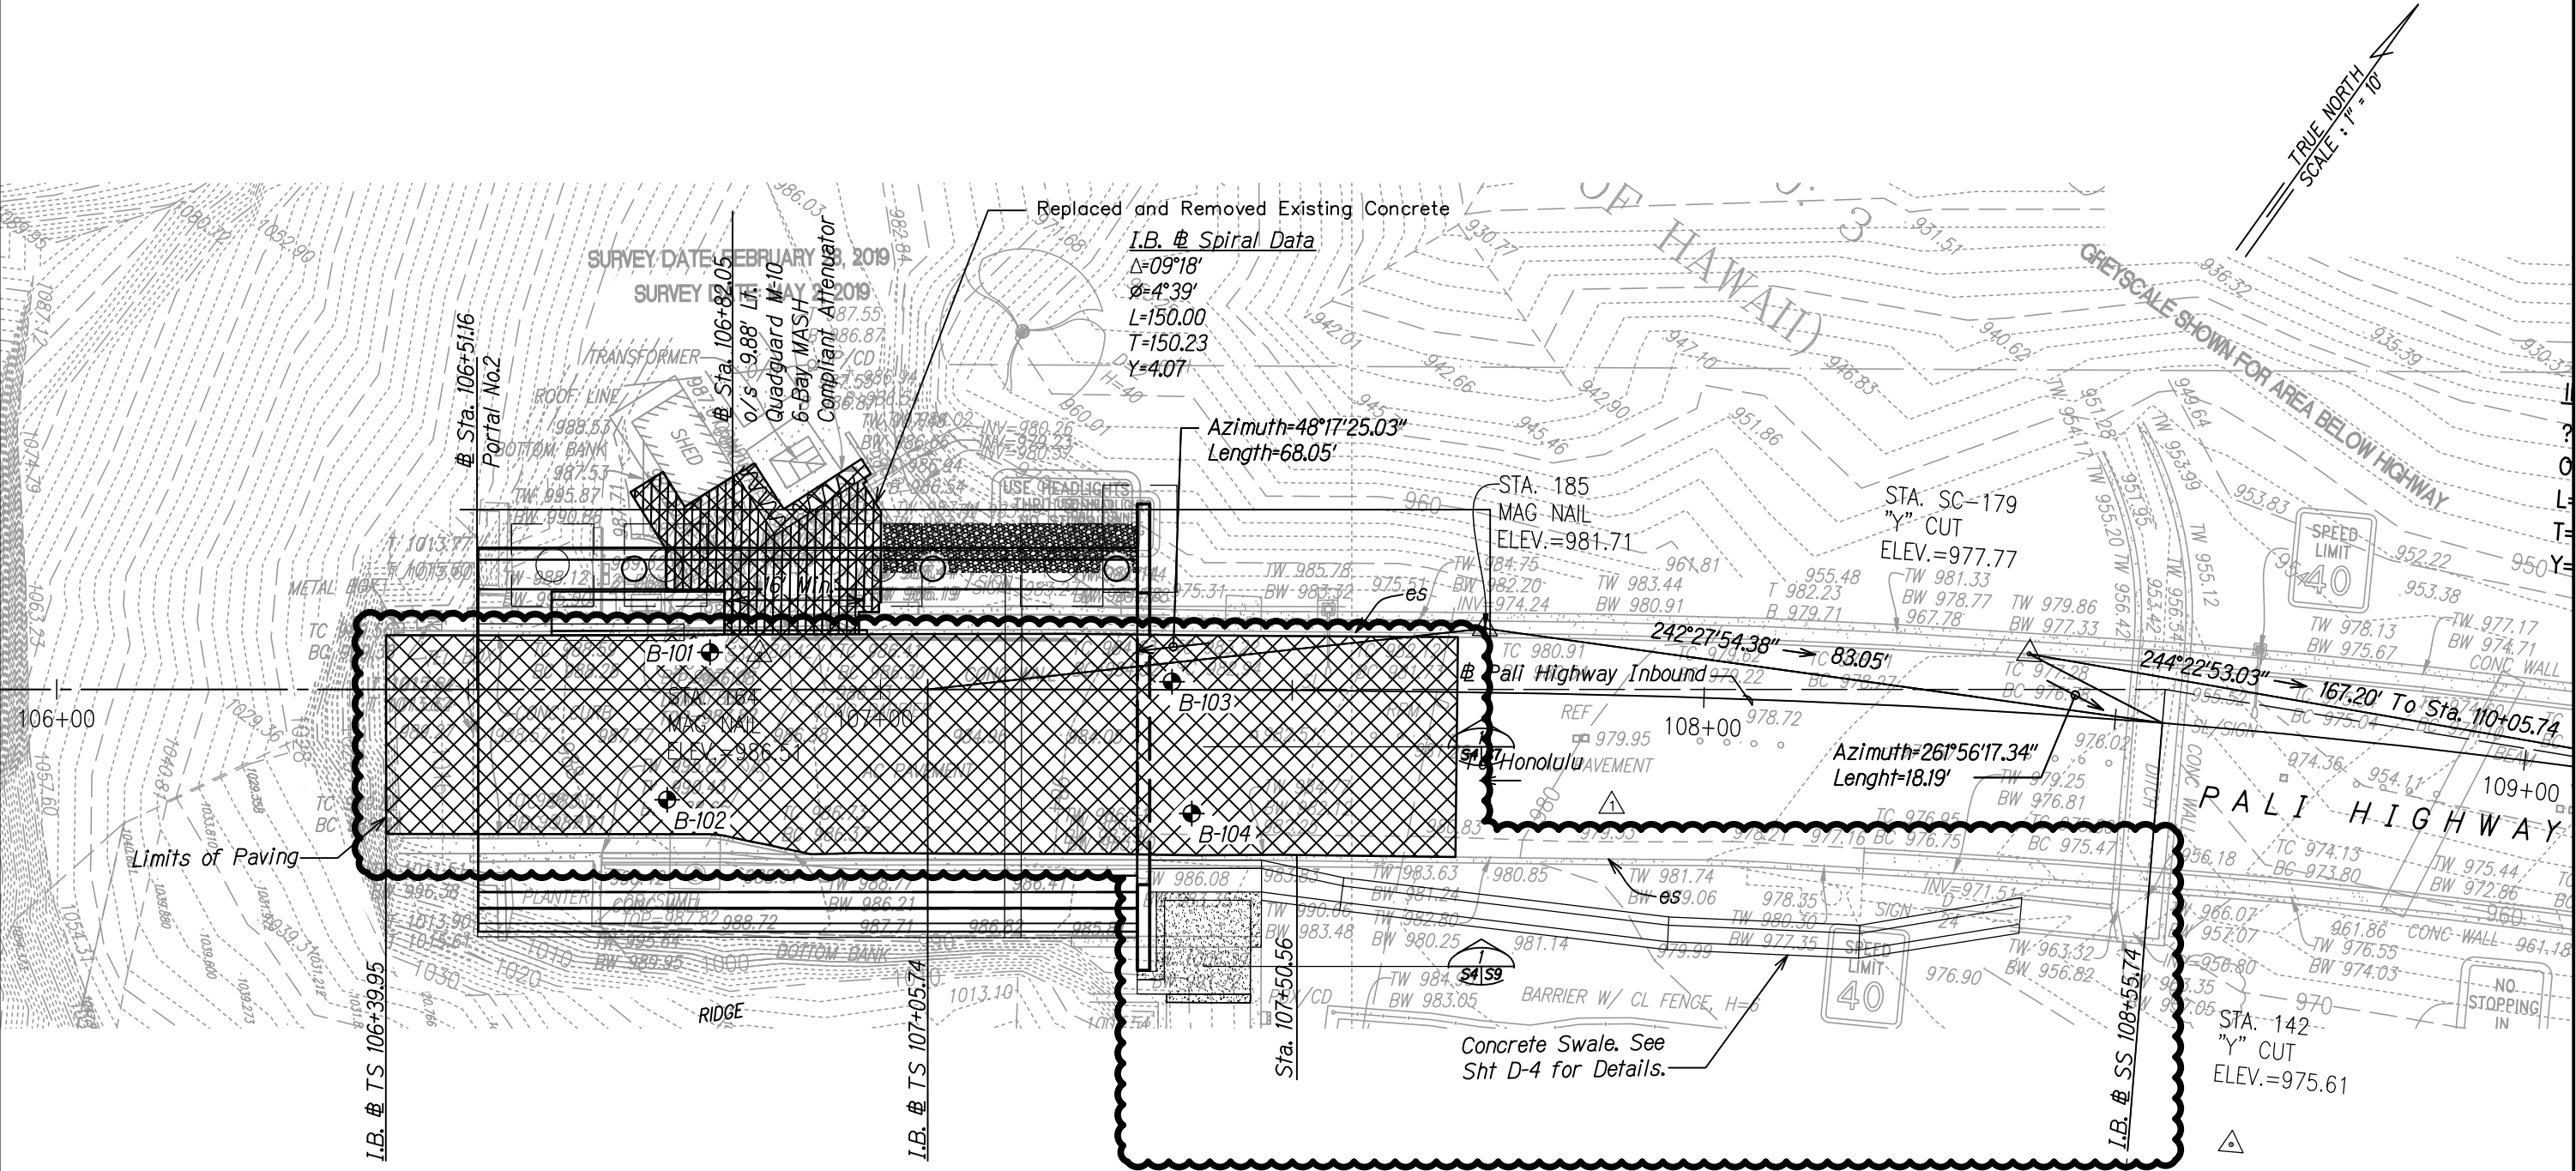


SURVEY PLOTTED BY	DATE
DRAWN BY	
NOTED BY	
QUANTITIES BY	
CHECKED BY	

LEGEND FOR AS-BUILT POSTINGS	
	Squiggly line for as-built deletion
	Double line for as-built deletion
Roadway	Text for as-built posting


ROADWAY PLAN
Scale: 1"=10'

Total Paving Area=3797 SF

LEGEND

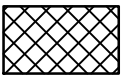

Cold Plane 4"
Repave w/
2" SMA
2" AC Mix No. IV

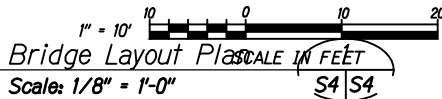

5/24/19	Revised Swale & Paving Area
Date	Revision
STATE OF HAWAII DEPARTMENT OF TRANSPORTATION HIGHWAYS DIVISION ROADWAY PLAN	
PALI HIGHWAY LANDSLIDE MITIGATION PROJECT FAP No. ER-22(002)	
Scale: 1" = 10'	Date: May 6, 2019
SHEET No. R-1 OF 2 SHEETS	

"AS-BUILT"

ADD 3

FED. ROAD DIST. NO.	STATE	FEDERAL AID PROJ. NO.	FISCAL YEAR	SHEET NO.	TOTAL SHEETS
HAWAII	HAW.	ER-22(002)	2019	ADD 3S-1	94

8" Thk. Concrete Pad.
See Structural Drawings
for Details.

Sta 106+81.06
Begin Drop Curb Transition

Sta 106+82.06
Begin 3" Curb

Sta 106+97.38
End 3" Curb

Sta 106+98.38
End Drop Curb Transition

Limits of Paving

TRUE NORTH
SCALE: 1" = 5'

10'-0"
Typical

To Honolulu

Pali Highway

Pali Highway (State)

Match existing pave
provide smooth rid.
connection


Limits of Paving

Legend:

Limits of Paving

5/24/19	Added Sheet
Date	Revision
STATE OF HAWAII DEPARTMENT OF TRANSPORTATION HIGHWAYS DIVISION SPOT ELEVATION PLAN PALI HIGHWAY LANDSLIDE MITIGATION PROJECT FAP No. ER-22(002) Scale: 1" = 5' Date: May 6, 2019 SHEET No. R-1A OF 3 SHEETS	

ADD 3 S-1

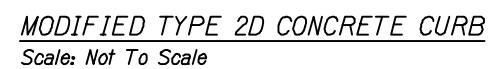

STATE OF HAWAII
DEPARTMENT OF TRANSPORTATION
HIGHWAYS DIVISION

ROADWAY PLAN
OLD PALI ROAD

PALI HIGHWAY
LANDSLIDE MITIGATION PROJECT
FAP No. ER-22(002)

Scale: 1" = 10' Date: Oct. 4, 2019

SHEET No. R-2 OF 2 SHEETS