
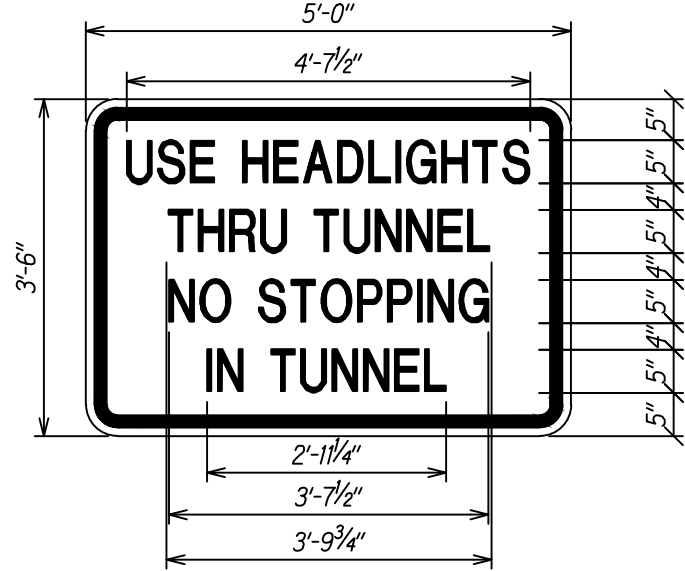
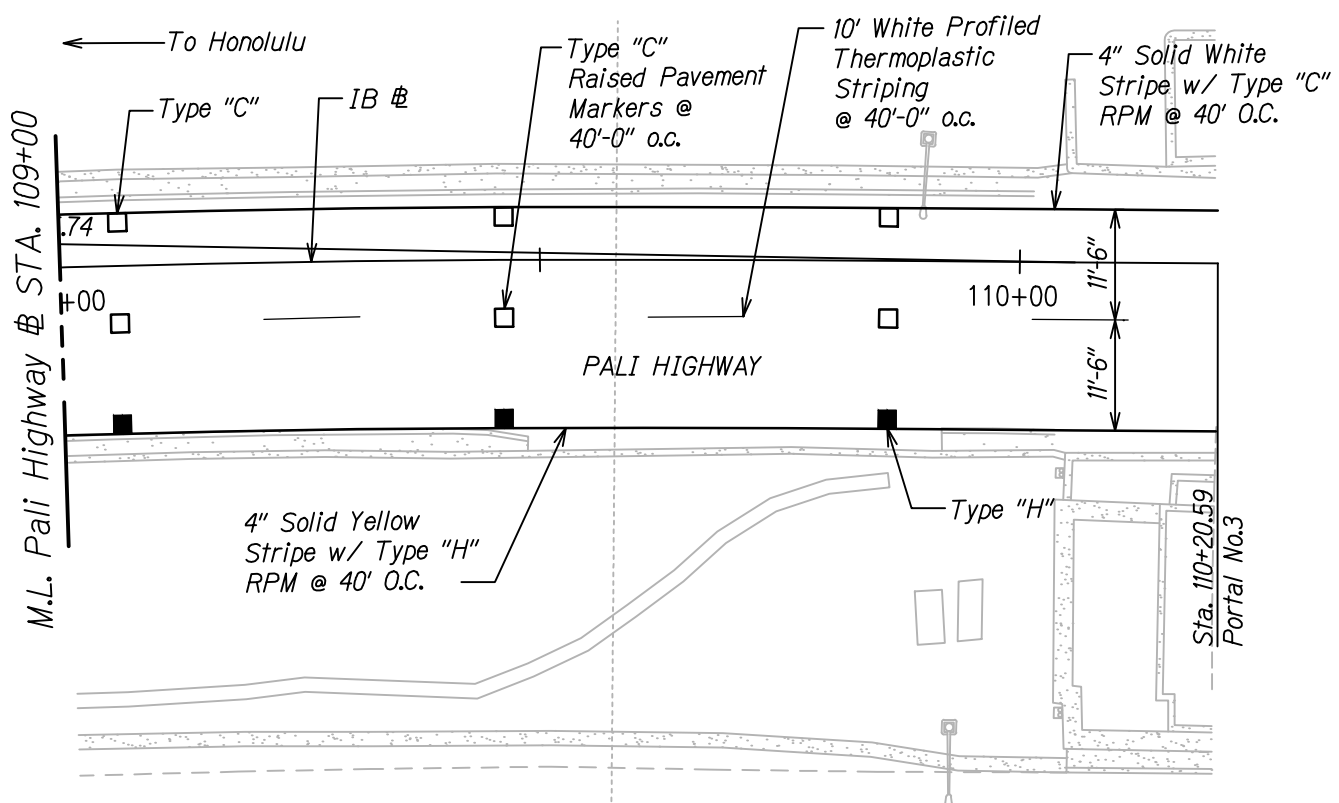


FED. ROAD DIST. NO.	STATE	FEDERAL AID PROJ. NO.	FISCAL YEAR	SHEET NO.	TOTAL SHEETS
HAWAII	HAW.	ER-22(002)	2019	9	94

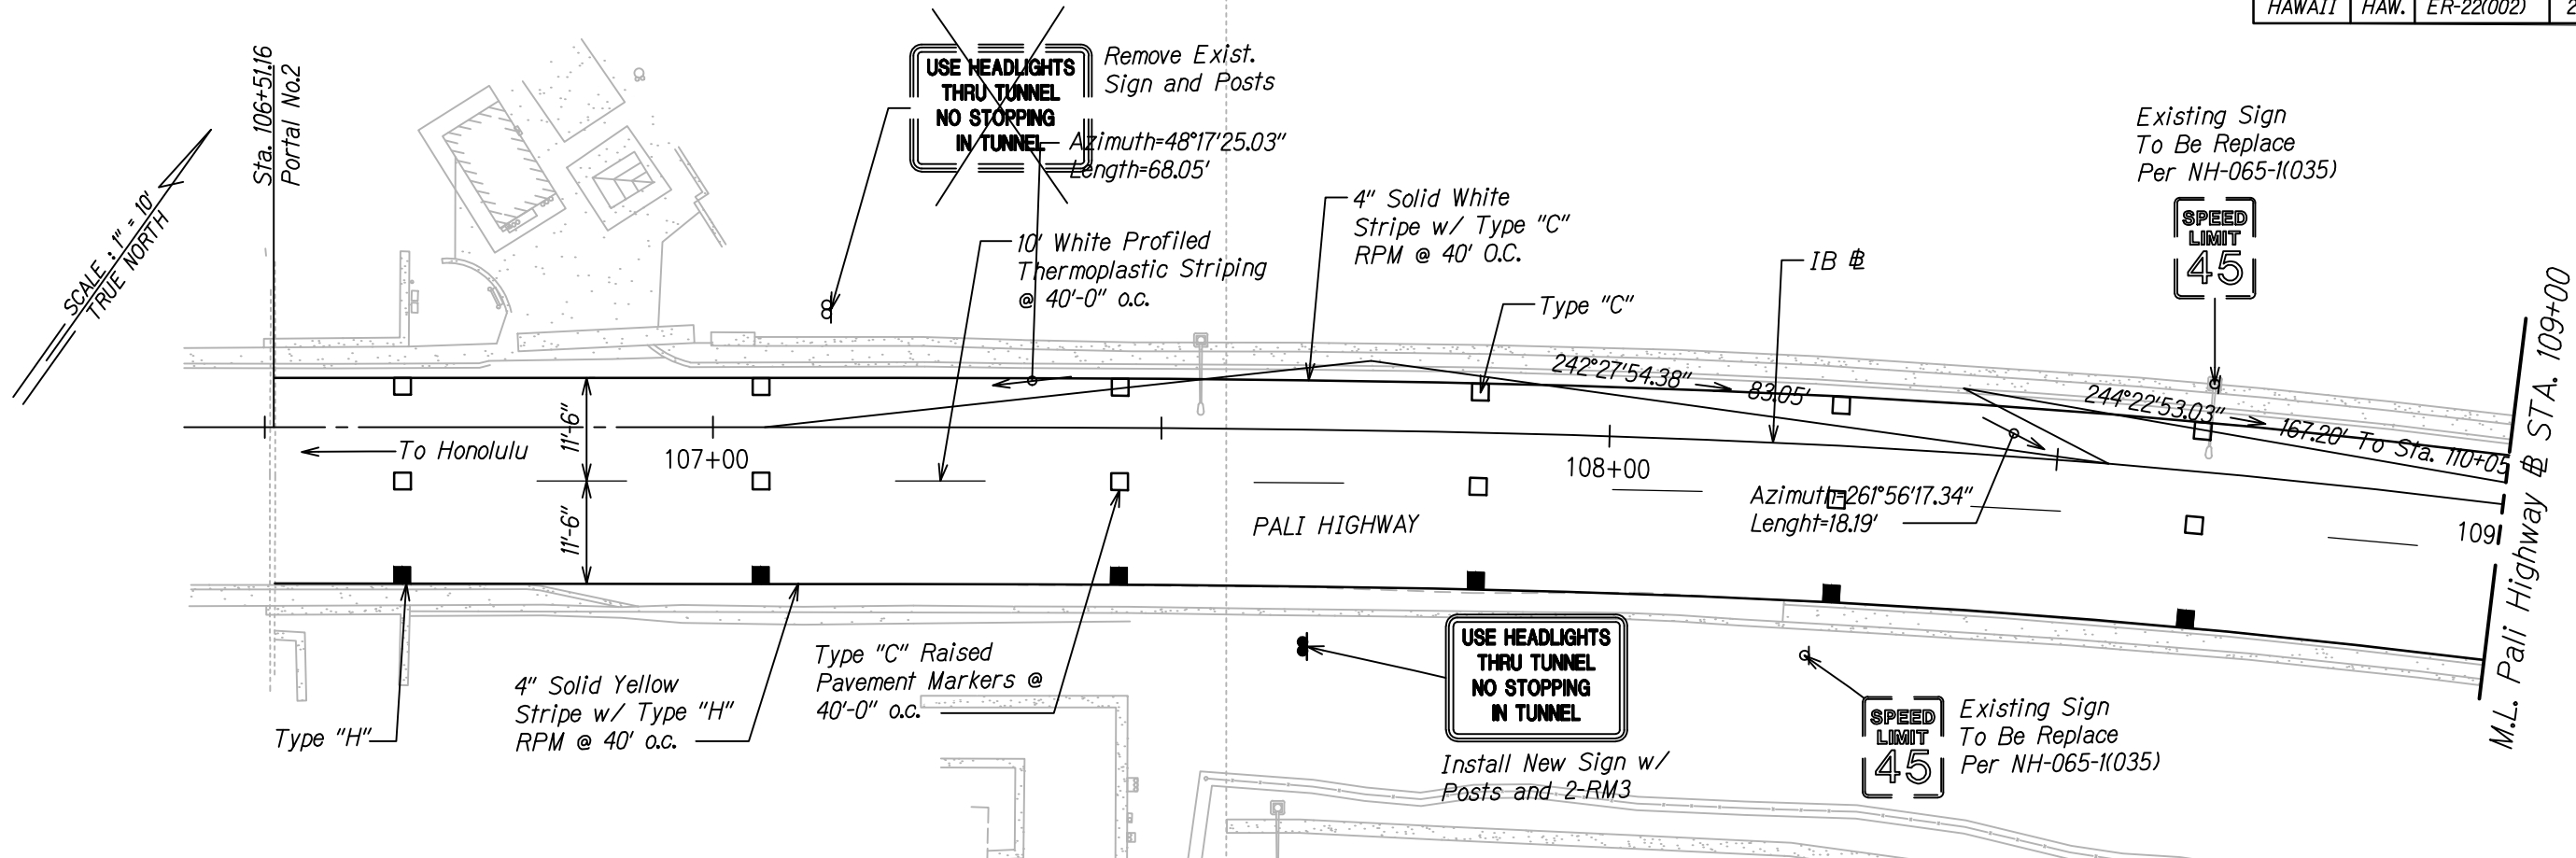

ZNO-STOPPING SIGN DETAIL
Not to Scale

ORIGINAL PLAN	DATE
SURVEY PLOTTED BY	
DRAWN BY	
NOTE BOOK DESIGNED BY	
QUANTITIES BY	
CHECKED BY	
N.	

SCALE: 1" = 10'
TRUE NORTH

STATE OF HAWAII
DEPARTMENT OF TRANSPORTATION
HIGHWAYS DIVISION

SIGNING AND STRIPING PLAN

PALI HIGHWAY
LANDSLIDE MITIGATION PROJECT
FAP No. ER-22(002)

Scale: 1" = 10' Date: May 6, 2019

SHEET No. SS OF 1 SHEETS