


FED. ROAD DIST. NO.	STATE	FEDERAL AID PROJ. NO.	FISCAL YEAR	SHEET NO.	TOTAL SHEETS
HAWAII	HAW.	ER-22(002)	2019	10	94

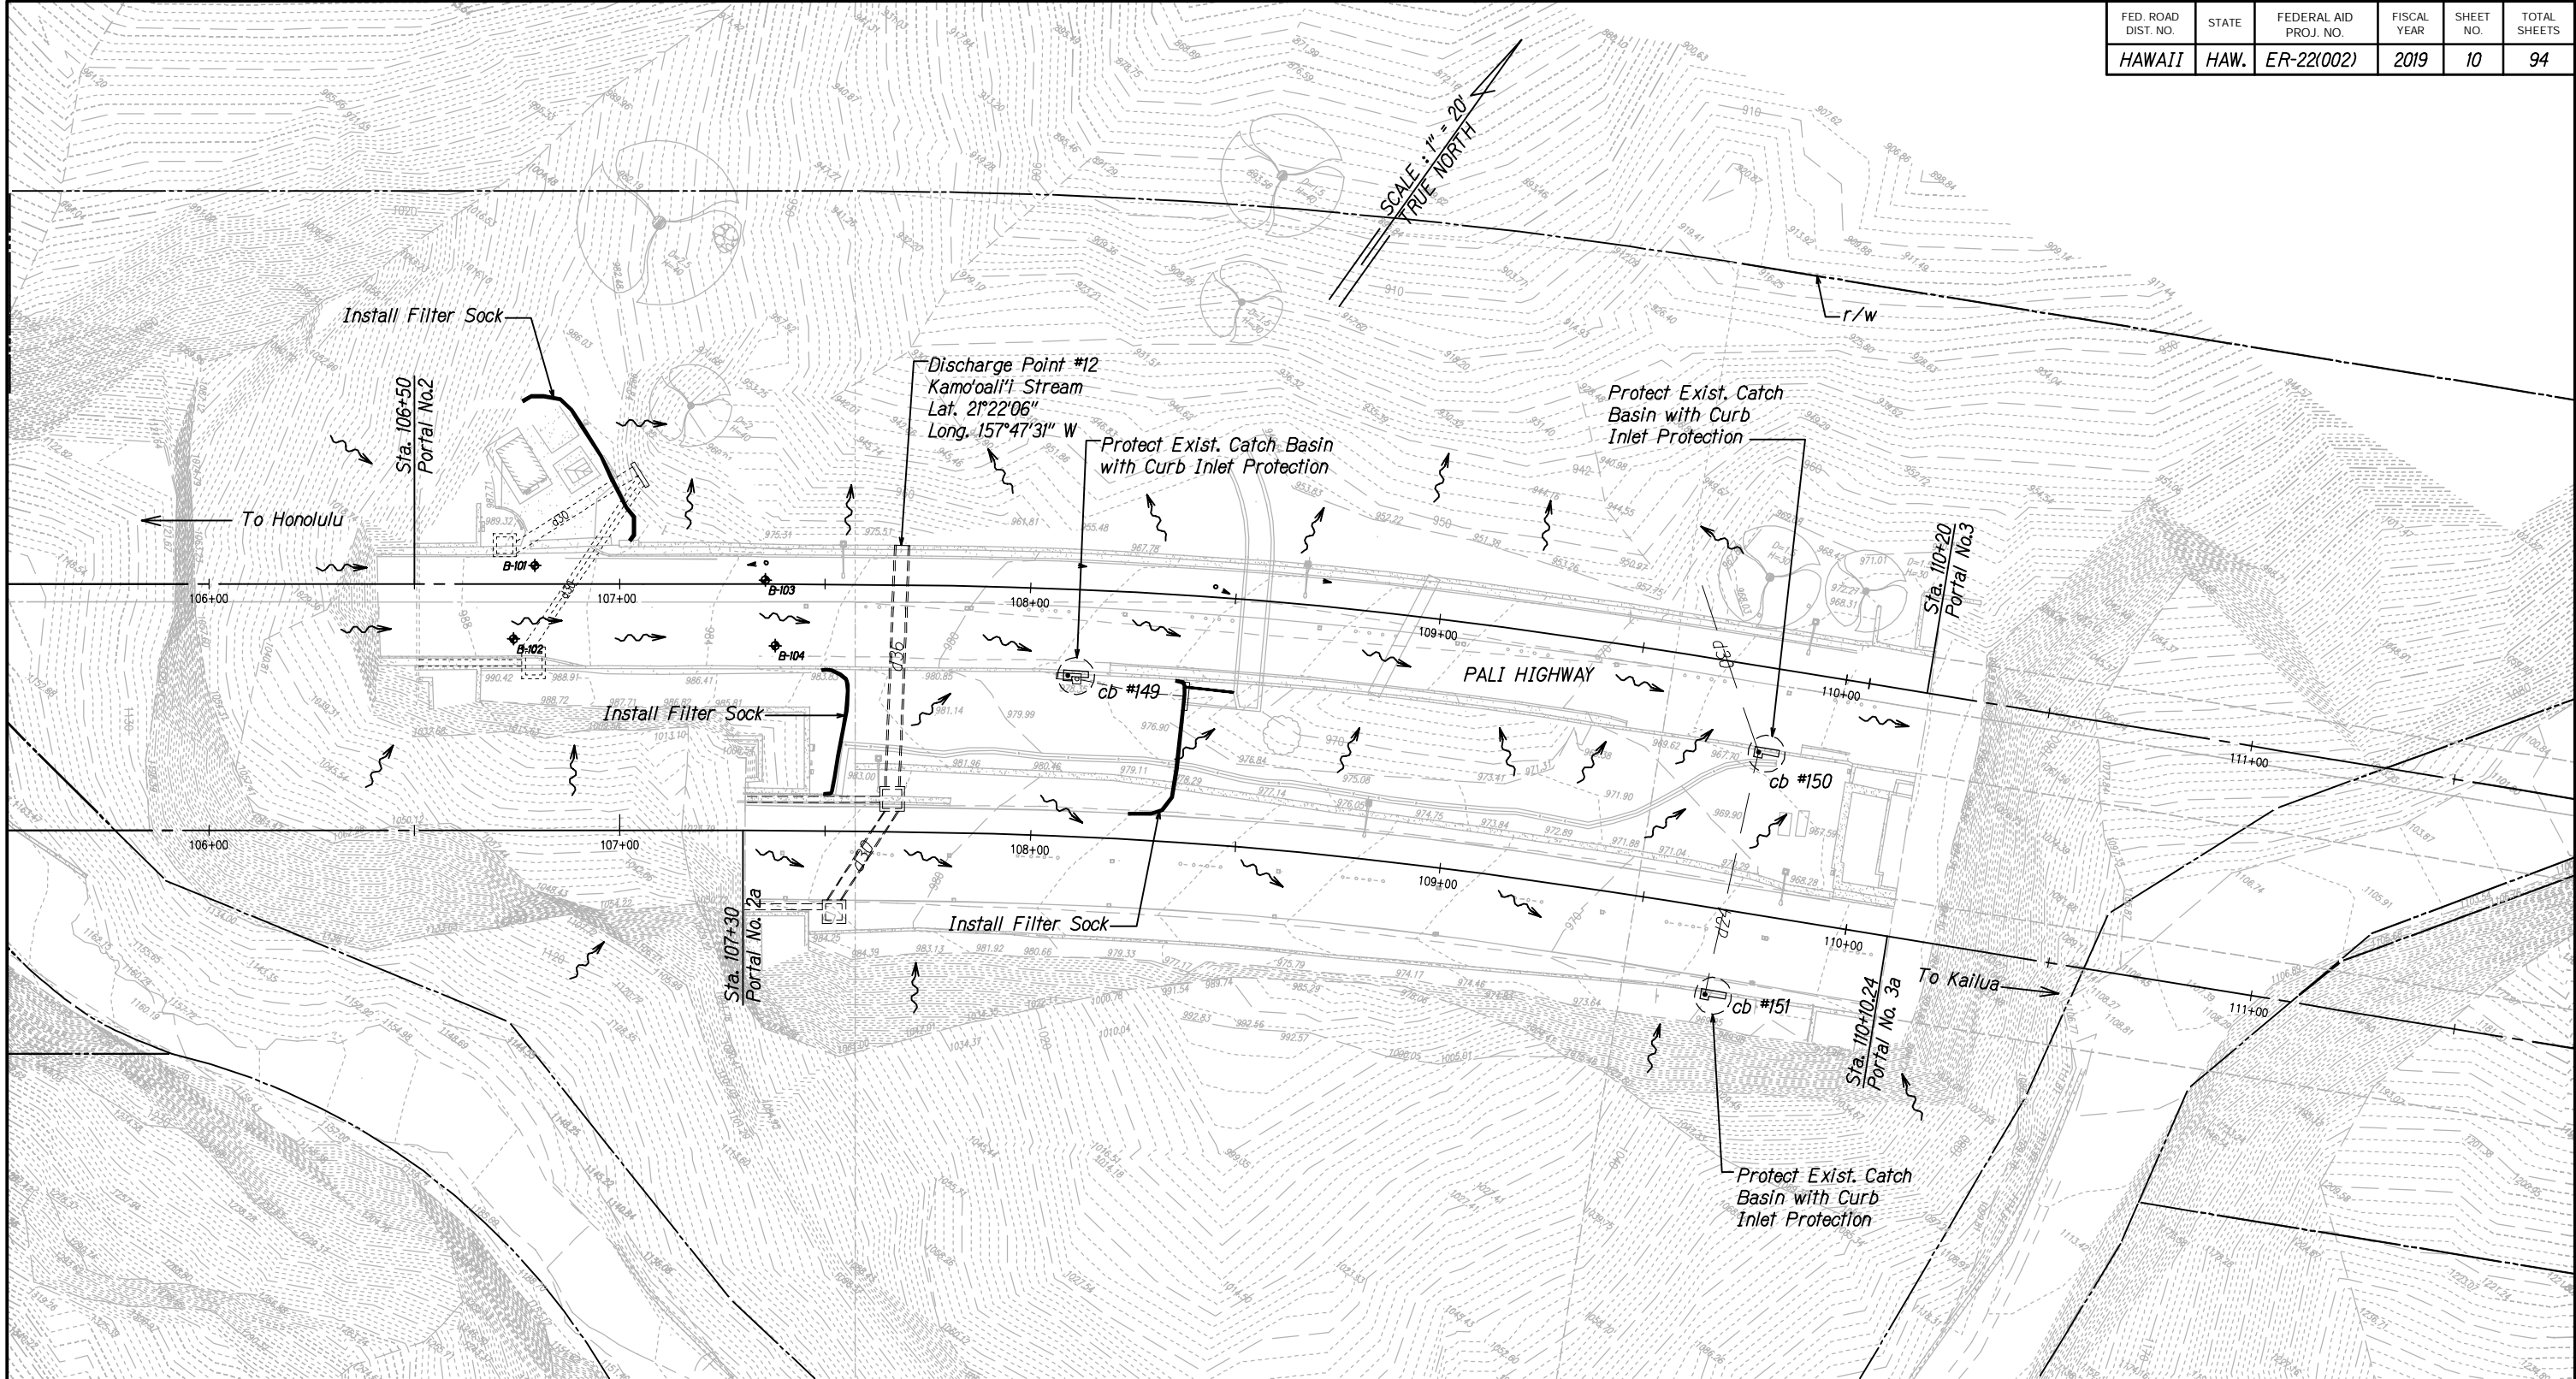

SURVEY PLOTTED BY	DATE
DRAWN BY	
DESIGNED BY	
NOTED BY	
CHECKED BY	

**LEGEND**

- Direction of Flow
- Silt Fence/ Filter Sock
- Existing Curb Inlet Catch Basin To Be Protected with Curb Inlet Dam.

STATE OF HAWAII  
DEPARTMENT OF TRANSPORTATION  
HIGHWAYS DIVISION  
**EROSION CONTROL PLAN**  
  
PALI HIGHWAY  
LANDSLIDE MITIGATION PROJECT  
FAP No. ER-22(002)

Scale: 1" = 20' Date: May 6, 2019  
SHEET No. EC-1 OF 1 SHEETS