


FED. ROAD DIST. NO.	STATE	FEDERAL AID PROJ. NO.	FISCAL YEAR	SHEET NO.	TOTAL SHEETS
HAWAII	HAW.	ER-22(002)	2019	64	94

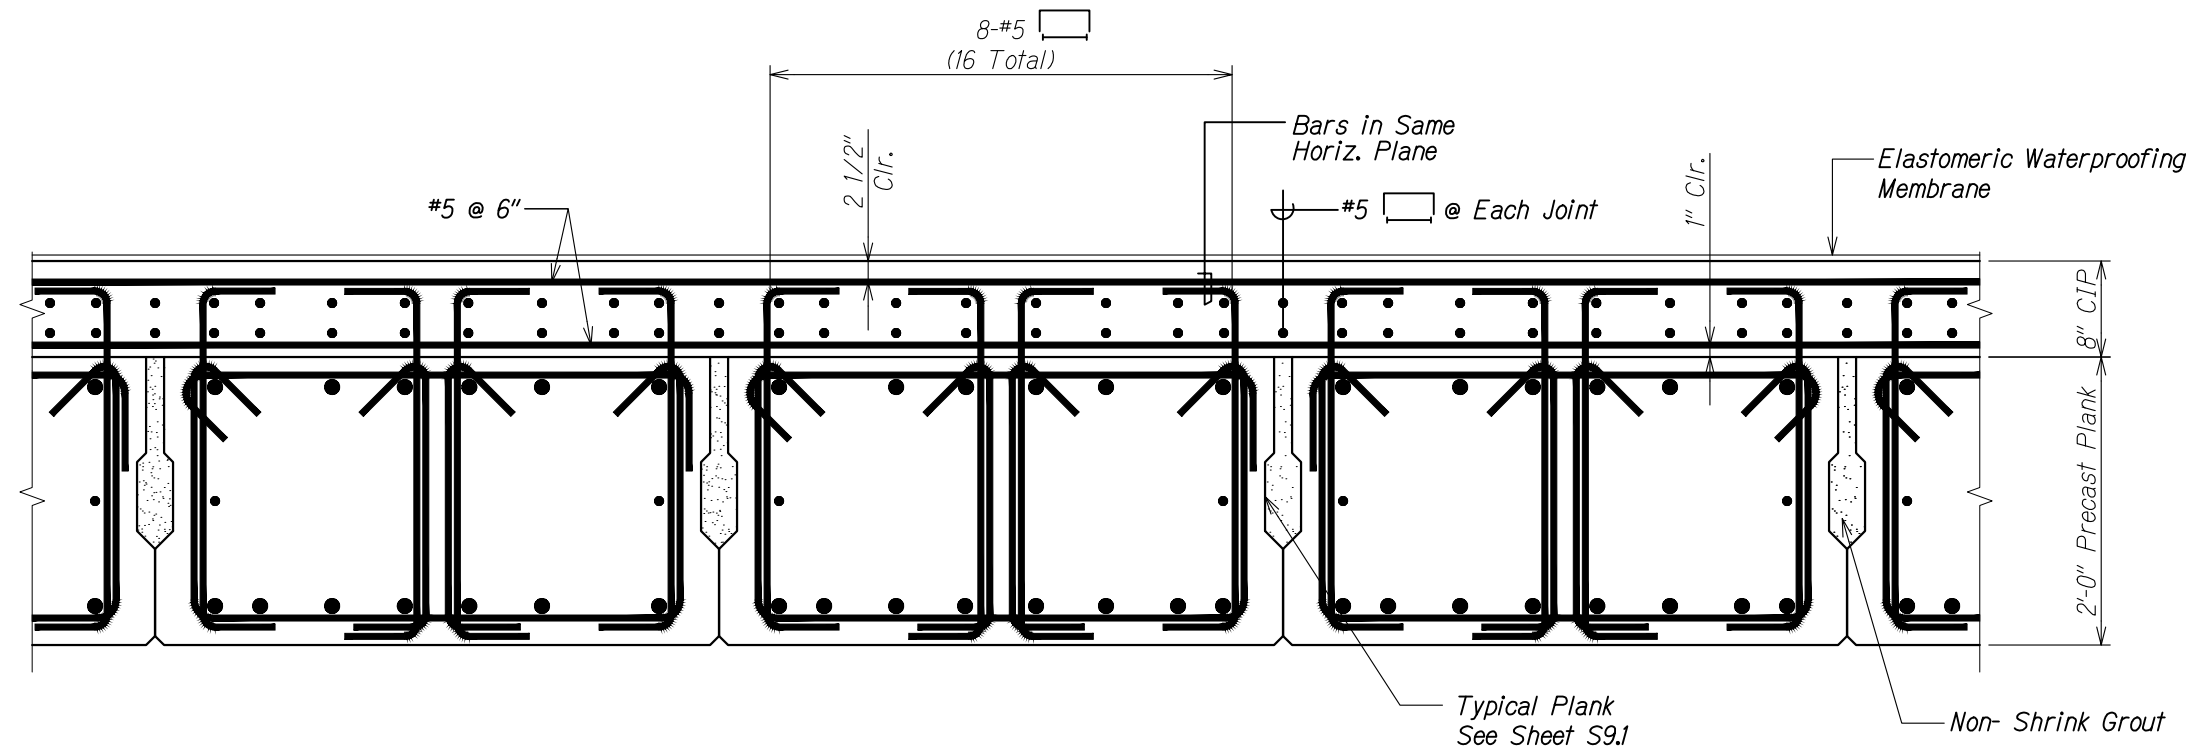

**TYPICAL DECK SECTION**  
Scale: 1 1/2" = 1'-0"

A  
S8.1 S8.1

ORIGINAL PLAN	SURVEY PLOTTED BY	DATE
NOTE BOOK	DRAWN BY	
	DESIGNED BY	
	QUANTITIES BY	
	CHECKED BY	

DRAWING NAME: Z:\00 ONGOING\19-014.1 PALI ROOF SHED-WSP-TM\01 CAD\05-06-19 TOPO\PLM-S0801 DECK SECTION.DWG PLOT TIME: 05-06-19, 11:54 PM

STATE OF HAWAII  
DEPARTMENT OF TRANSPORTATION  
HIGHWAYS DIVISION


**TYPICAL ROOF SECTION**

PALI HIGHWAY  
LANDSLIDE MITIGATION PROJECT  
FAP Proj. No. ER-22(002)


Scale: As Noted Date: May 6, 2019

SHEET No. S8.1 OF 3 SHEETS

FED. ROAD DIST. NO.	STATE	FEDERAL AID PROJ. NO.	FISCAL YEAR	SHEET NO.	TOTAL SHEETS
HAWAII	HAW.	ER-22(002)	2019	ADD 65	94

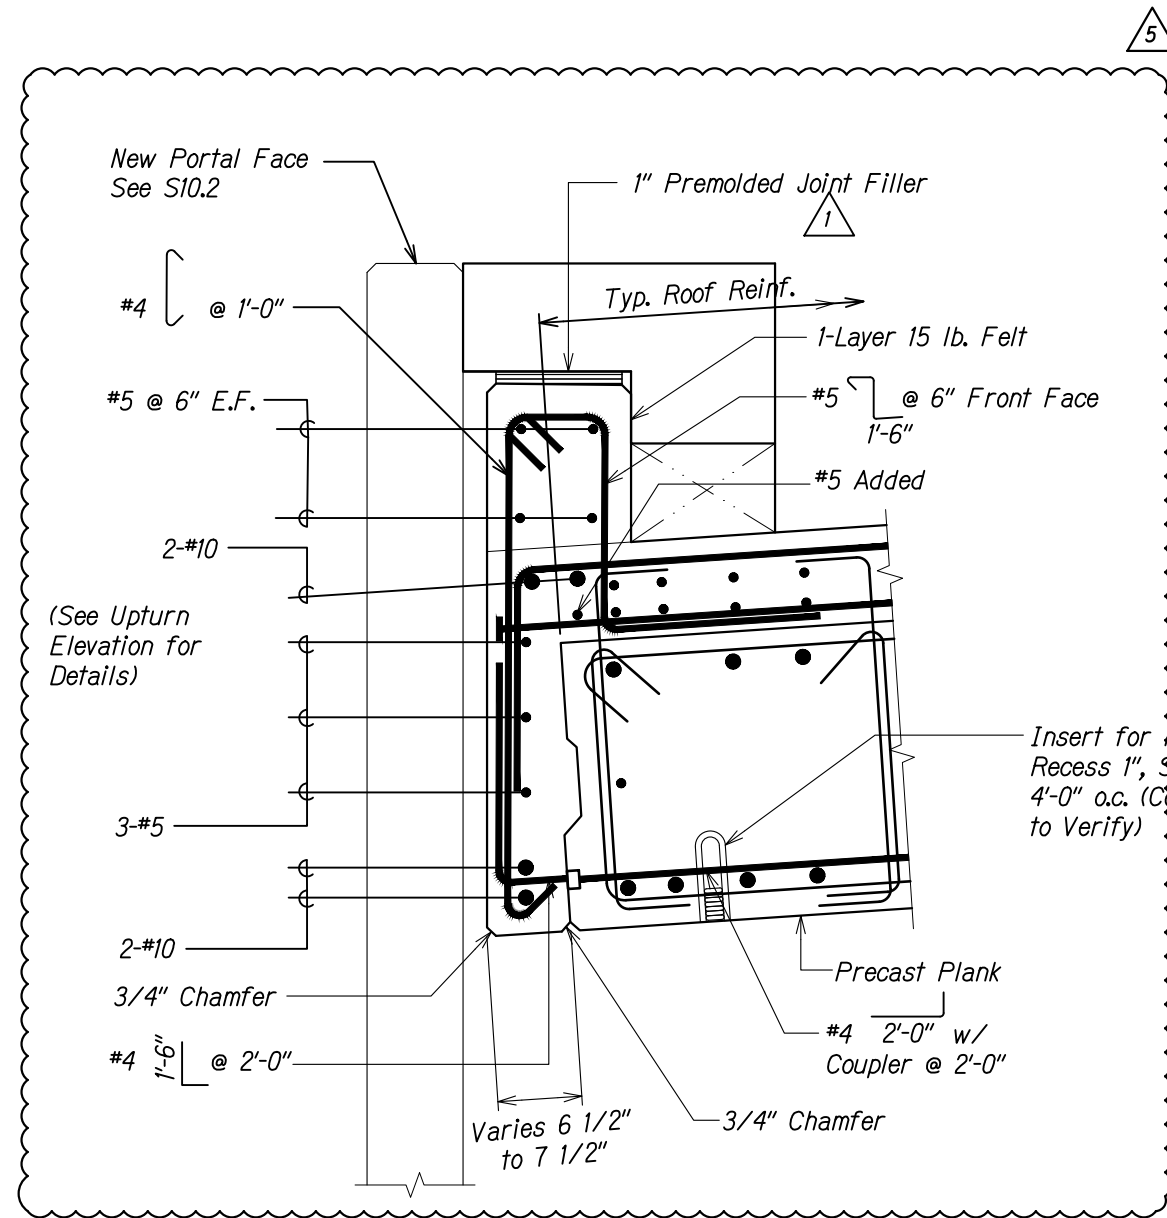

**SECTION**  
Scale: 1 1/2" = 1'-0"  
S1.5, S10.1

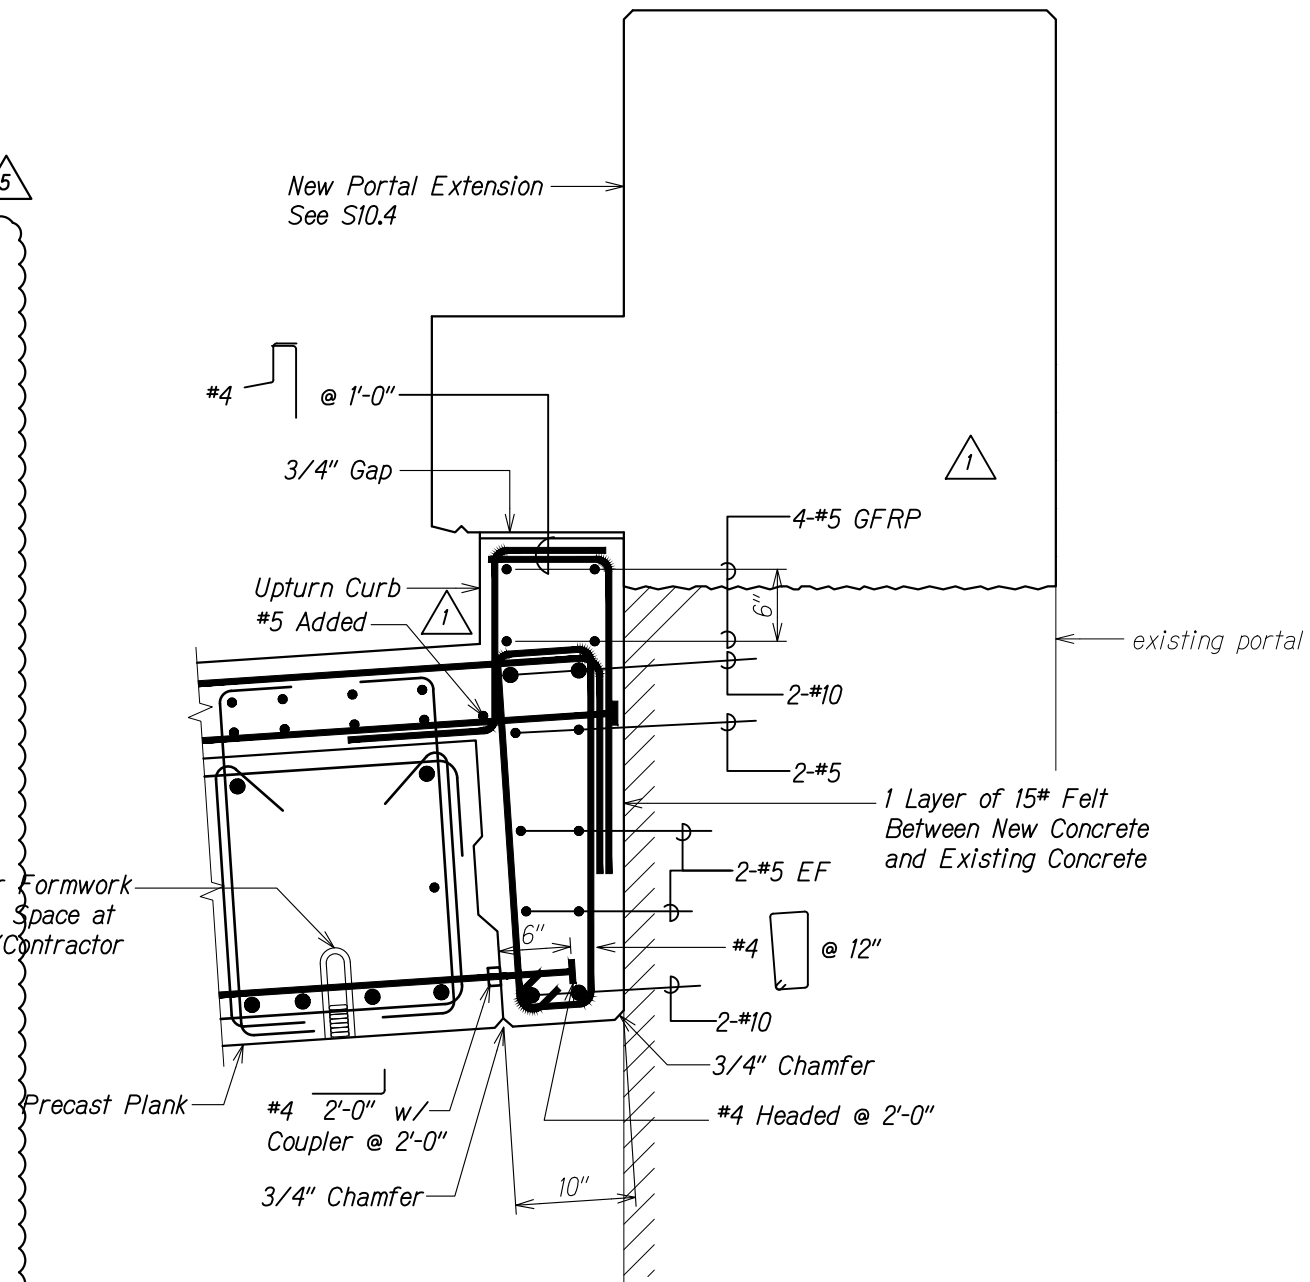



SECTION

Scale:  $1 \frac{1}{2}'' = 1'-0''$

S1.5 | S8.2

S1.6, S10.3

8/06/19	 Revised Sections
5/24/19	 Revised Sections
DATE	REVISION

STATE OF HAWAII  
DEPARTMENT OF TRANSPORTATION  
HIGHWAYS DIVISION

ROOF SECTIONS AT NEW PORTAL FACE AND  
EXISTING INLET PORTAL DECK SECTION

PALI HIGHWAY  
LANDSLIDE MITIGATION PROJECT  
FAP Proj. No. ER-22(002)

Scale: As Noted Date: May 6, 2019

SHEET No. S8.2 OF 3 SHEETS

DRAWING NAME: Z:\00 ONGOING\19-014.1A PALI ROOF SHED POST DESIGN-WSP TM\01 CAD\10-07-19 UPDATE DELTA5-6\PLM-S0801 ADD1 DELTA6 DECK SECT.DWG PLOT TIME: 10-07-19, 10:37 AM)

ORIGINAL PLAN	SURVEY PLOTTED BY _____	DATE _____
NOTE BOOK	DRAWN BY _____	" _____
	TRACED BY _____	" _____
	DESIGNED BY _____	" _____
	QUANTITIES BY _____	" _____
No. _____	CHECKED BY _____	" _____