

FED. ROAD DIST. NO.	STATE	FEDERAL AID PROJ. NO.	FISCAL YEAR	SHEET NO.	TOTAL SHEETS
HAWAII	HAW.	ER-22(002)	2019	ADD 24	94

INDEX OF STRUCTURAL DRAWINGS

<u>SHEET NO.</u>	<u>DESCRIPTION</u>
S0.1	INDEX OF STRUCTURAL DRAWINGS
S0.1A	INDEX OF STRUCTURAL DRAWINGS
S0.2	STRUCTURAL GENERAL NOTES
S0.3	STRUCTURAL GENERAL NOTES
S0.4	STRUCTURAL GENERAL NOTES
S0.5	SYMBOLS AND ABBREVIATIONS
S1.1	LAYOUT PLAN
S1.2	LONGITUDINAL SECTION
S1.3	ROCK SHED ELEVATION
S1.4	FOUNDATION PLAN
S1.5	ROOF FRAMING PLAN
S1.6	TOPPING PLAN
S2.1	DEMOLITION PLAN AND ELEVATION
S2.2	DEMOLITION SECTION AND DETAIL
S2.3	DEMOLITION PLAN AT OUTBOUND TUNNEL PORTAL
S3.1	TYPICAL SECTION
S3.2	SECTION AT EXISTING PORTAL FACE
S3.3	SECTION AT NEW PORTAL FACE
S3.3A	SECTION AT NEW PORTAL FACE
S3.3B	SECTION AT NEW PORTAL FACE
S3.3C	SECTION AT NEW PORTAL FACE
S4.1	DRILLED SHAFT
S4.2	DRILLED SHAFT
S4.3	DRILLED SHAFT SCHEDULE
S5.1	COLUMN 1 AND 2 ELEVATION AND SECTIONS
S5.2	COLUMN 3 ELEVATION AND SECTIONS
S5.2A	COLUMN 3 TRANSITION ZONE SECTIONS
S5.3	COLUMN 3 PLAN AND SECTIONS
S5.4	COLUMN 3 SECTIONS
S5.5	COLUMN 3 CREEP BLOCK

<u>SHEET NO.</u>	<u>DESCRIPTION</u>
S6.1	COLUMN CAP BEAM ELEVATION
S6.2	COLUMN CAP BEAM SECTIONS
S6.2A	COLUMN CAP BEAM SECTIONS
S6.3	COLUMN CAP BEAM AND SEAT SECTIONS
S6.4	COLUMN CAP BEAM AND SECTIONS
S7.1	RETAINING WALL ELEVATION
S7.2	TYPICAL RETAINING WALL SECTION
S7.3	SECTIONS
S7.4	ANCHOR BEAM PLAN AND SECTION
S7.5	PLAN AT EXISTING DRAIN BOX
S7.6	POST-TENSIONING DEAD END ANCHOR
S7.7	POST-TENSIONING STRESSING END ANCHOR
S7.7A	POST-TENSIONING STRESSING END ANCHOR
S7.7B	POST-TENSIONING STRESSING END ANCHOR
S7.8	POST-TENSIONING NOTES
S7.9	RETAINING WALL SECTIONS
S7.10	RETAINING WALL RETURN FOOTING PLAN
S7.11	TYPICAL WALL DETAILS
S7.12	BARRIER ELEVATION
S7.13	RETAINING WALL RETURN ELEVATION AND SECTION
S7.14	INFILL WALL
S8.1	TYPICAL ROOF SECTION
S8.2	ROOF SECTIONS AT NEW PORTAL FACE AND EXISTING INLET PORTAL DECK SECTION
S8.3	UPPER CONTAINMENT WALL AND LOWER CONTAINMENT WALL SECTION
S8.4	UPPER CONTAINMENT WALL AND LOWER CONTAINMENT WALL ELEVATIONS
S9.1	PLANK PLAN AND ELEVATION
S9.2	PLANK SECTIONS AND DETAIL
S9.3	CONCRETE SEAT SECTIONS AND DETAIL

<u>SHEET NO.</u>	<u>DESCRIPTION</u>
S10.1	UPTURN CURB ELEVATION AT NEW PORTAL
S10.2	UPTURN CURB SECTIONS AT NEW PORTAL
S10.2A	PRECAST PORTAL AND LOWER CONTAINMENT WALL REBAR ALTERATION
S10.3	UPTURN CURB SECTIONS AT EXISTING PORTAL
S10.4	EXISTING PORTAL FACE EXTENSION SECTION
S10.5	HEADWALL SECTIONS
S10.6	HEADWALL SECTION AND DETAIL
S11.1	ROCK ANCHOR SECTIONS
S11.2	ROCK ANCHOR SECTION
S11.3	VERTICAL GROUND ANCHOR
S11.4	RELIEF SLAB PLAN AND SECTION
S11.5	ROCK ANCHOR CAP BEAM DETAILS
S12.1	MAKAI END POST PLAN AND ELEVATION
S12.2	MAKAI END POST REINFORCEMENT LAYOUT PLAN
S12.2A	MAKAI END POST REINFORCEMENT LAYOUT PLAN
S12.3	MAKAI END POST SECTIONS
S12.3A	MAKAI END POST SECTION
S12.4	MAKAI END POST SECTION

ORIGINAL
PLAN


SURVEY PLOTTED BY
DATE

NOTE BOOK


DESIGNED BY
QUANTITIES BY
CHECKED BY

DRAWING NAME: Z:\00 ONGOING\19-014.1A PALI ROOF SHED POST DESIGN-WSP.TMA\01 CAD\04-04-01-21 AS-BUILT\PLM-S0001 ADD1 DELTA3-7 INDEX.DWG PLOT TIME: 04-01-21, 4:59 PM


LEGEND FOR
AS-BUILT POSTINGS



Quiggly line for
as-built deletion

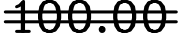


Double line for
as-built deletion

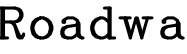


Text for as-built
posting


9/27/19

 Revised Index

6/12/19

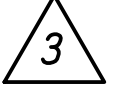 Revised Index

5/24/19

 Revised Index

DATE

REVISION

STATE OF HAWAII
DEPARTMENT OF TRANSPORTATION
HIGHWAYS DIVISION

INDEX OF STRUCTURAL DRAWINGS

PALI HIGHWAY
LANDSLIDE MITIGATION PROJECT
FAP Proj. No. ER-22(002)

Scale: None Date: May 6, 2019

SHEET No. S01 OF 5 SHEETS

ADD 24

ORIGINAL PLAN	DATE
NOTE BOOK	
NO.	

DRAWING NAME: Z:\00 ONGOING\19-014\1A PALI HIGHWAY SHED POST DESIGN-WSP TMA(01 CAD)\04-06-20B RFD3 RVSQ REBAR-PLM-S0002 ADD1 DELTA7 DELTA8 STRUCT NOTES.DWG PLOT TIME: 07-02-20, 10:23 AM

1. General Specifications:

- A. Hawaii Department of Transportation (HDOT), Standard Specifications for Road and Bridge, Construction, 2005, together with Special Provisions prepared for this project.

2. Design Specifications:

- A. American Association of State Highway and Transportation Officials (AASHTO) 2017 LRFD Bridge Design Specifications, Eight Edition, including the 2015 Interim revision edition as amended by Hawaii Department of Transportation (HDOT) document dated August 8, 2014 with subject title "Design Criteria for Bridges and Structures" and HDOT memorandum dated January 8, 2018 with subject title "Changes to Design Criteria for Bridges and Structures".
- B. Technical paper titled "Rock Fall Sheds - Application of Japanese Designs in North America" by Hiroshi Yoshida, Toshimitsu Nomura, Duncan C. Wyllie, and Anthony J. Morris presented to ASCE in 2007.

3. Design Loads:

- A. **Dead Load:**
Weight of all components of the structures, appurtenances attached thereto, and earth covers.
Unit Weight of Concrete - 160 pcf
Unit Weight of Compacted Earth - 120 pcf
Unit Weight of Debris Buildup - 95 pcf
Energy Absorbing Material - 1.8 pcf
- B. **Seismic Load:**
In accordance with AASHTO LRFD Bridge Design Specifications 8th Edition 2017
- Peak Ground Acceleration ($PGA = 0.171$) modified by the Site Coefficient ($F_{PGA} = 1.206$) to give a spectrum acceleration, $A_s = 0.206$
- Short period acceleration at 0.2 seconds ($S_s = 0.400$) modified by the Site Coefficient ($F_{PGA} = 1.206$) to give the short period spectrum acceleration, $S_{DS} = 0.483$.
- Long period acceleration at 1.0 seconds ($S_1 = 0.109$) modified by the Site Coefficient ($F_v = 1.694$) to give the long period spectrum acceleration, $S_{D1} = 0.185$.
- Site Class = C
Seismic Zone = 2
Operational Category = Essential
- C. **Soil Properties:**
(1) **Bearing Pressure**
(a) Extreme Event Limit State - 31,000 psf
(b) Strength Limit State - 15,000 psf
(2) **Coefficient of Friction**
(a) Extreme Event Limit State - 0.62
(b) Strength Limit State - 0.53

STRUCTURAL GENERAL NOTES:

3. Design Loads (Continued):

- (3) **Passive Earth Pressure**
(a) Extreme Event Limit State - 300 pcf
(b) Strength Limit State - 150 pcf
(4) **Static Lateral Earth Pressure** - 5 pcf
(5) **Dynamic Lateral Earth Pressure** - $13H^2$ lb/ft
Where H = Height of retained soil or backfill in feet acting at the mid-height of the wall.

- C. **Wind:** Design Wind Velocity - 105 MPH (Acting on the portal)

4. Materials:





- A. All concrete properties shall be as noted below:

Item No.	Structural Parts	Minimum Compressive Strength, f'c (28 Days)	Maximum Water/Cement (W/C)	Included Admixtures*
(1)	Footing	6,000 psi	0.40	4.(B), 4.(C)
(2)	Retaining Wall and End Post	6,000 psi	0.40	4.(B), 4.(C), 4.(D), 4.(E)
(3)	Drilled Shafts	4,500 psi	0.45	4.(B)
(4)	Column	6,000 psi	0.40	4.(B)
(5)	Column Pilaster	6,000 psi	0.40	4.(B), 4.(C)
(6)	Column Corbel	6,000 psi	0.40	4.(B), 4.(C), 4.(D), 4.(E)
(7)	Column Cap Beam Seat and Curtain Wall	6,000 psi	0.40	4.(B), 4.(C), 4.(D)
(8)	Transition Zone	6,000 psi	0.40	4.(B)
(9)	Column Cap Beam	6,000 psi	0.40	4.(B), 4.(C), 4.(D), 4.(E)
(10)	End Beam	6,000 psi	0.40	4.(B), 4.(C), 4.(D), 4.(E)
(11)	Headwall	6,000 psi	0.40	4.(B), 4.(C), 4.(D), 4.(E), 4.(R)
7	Rock Anchor Beam and Cap Beam	6,000 psi	0.40	4.(B), 4.(C), 4.(D)
(13)	Upturn Curbs	6,000 psi	0.40	4.(B), 4.(C), 4.(D), 4.(E)
(14)	Wall Extension on existing Portal	6,000 psi	0.40	4.(B), 4.(C), 4.(D), 4.(E)
(15)	Anchor Block	6,000 psi	0.40	4.(B), 4.(C), 4.(D), 4.(E)
(16)	Precast Planks	8,000 psi	0.40	4.(B), 4.(C)
(17)	CIP Topping	6,000 psi	0.40	4.(B), 4.(C), 4.(D), 4.(E)
(18)	Precast Portal	6,000 psi	0.40	4.(B), 4.(C), 4.(D), 4.(R)
(19)	CIP Planter at Precast Portal	5,000 psi	0.40	4.(B), 4.(C), 4.(D), 4.(E), 4.(R)
(20)	Shotcrete	5,000 psi	0.40	8 4.(F)
(21)	Lower Containment Wall and Upper Containment Wall	6,000 psi	0.40	4.(B), 4.(C), 4.(D), 4.(E), 4.(R)
(22)	Return Wall	6,000 psi	0.40	4.(B), 4.(C), 4.(D), 4.(E), 4.(R)
(23)	Creep Wall	6,000 psi	0.40	4.(B), 4.(C), 4.(D), 4.(E)
(24)	Quadguard Slab	5,000 psi	0.40	4.(B), 4.(C), 4.(E)
(25)	All Others	6,000 psi	0.45	4.(B)
(26)	Roof slab, Walls, and Curbs at Electrical Building	6,000 psi	0.40	4.(B), 4.(C), 4.(D)

*Refer to notes 4.(B) through 4.(F) in this section

4. Materials (Continued):

- B. Amine carboxylate corrosion inhibiting water-based admixture such as Cortec MCI 2005 NS or approved equal shall be added at a dosage of 24 ounces per cubic yard.
- C. Shrinkage reducing admixture such as Eclipse 4500 or Masterlife SRA 20 or approved equal shall be added at a dosage of 128 ounces per cubic yard or as recommended by the manufacturer.
- D. Alkali resistant structural glass fiber such as CEMFIL, ANTI-CRAK HP67/36 or approved equal shall be added to the concrete mix. The dosage rate shall be 15 lbs per cubic yard for CEMFIL or the equivalent amount of approved equal to achieve similar properties as the glass dosage. The fiber shall be added to the concrete as recommended by the manufacturer during the mixing process.
- E. An integral waterproofing admixture such as KIM HS or approved equal shall be added to the concrete mix. The dosage rate shall be 13.5 lbs per cubic yard.
- F. A 2 1/4" long macro synthetic fiber such as Forta Ferro or approved equal shall be added to the concrete mix. The dosage shall be 7.5 lbs per cubic yard or the equivalent amount of approved equal to achieve similar properties.
- 1 G. Contractor is not limited to only adding admixtures listed on these notes. Other admixtures may be added upon approval of the Engineer.
- 11 H. The maximum cementitious content for all concrete except for items 16 and 20 shall be 670 lbs of portland cement per cubic yard. The maximum cementitious content for Item 16 shall be 700 lbs of portland cement per cubic yard. The maximum cement content for Item 20 shall be 752 lbs of portland cement per cubic yard.
- 11 I. The use of calcium chloride in any concrete is prohibited.
- J. All concrete exposed within 7 days of placement shall be cured using Sinak Lithium Cure 1000 or approved equal at a coverage rate of no less than 400 sq. ft. per gallon.

11/15/19		Revised Note
10/04/19		Revised Note
9/27/19		Revised Note
5/24/19		Revised Notes
DATE	REVISION	

STATE OF HAWAII
DEPARTMENT OF TRANSPORTATION
HIGHWAYS DIVISION

STRUCTURAL GENERAL NOTES

PALI HIGHWAY
LANDSLIDE MITIGATION PROJECT
FAP Proj. No. ER-22(002)

Scale: None

Date: May 6, 2019

SHEET No. S02 OF 5 SHEETS

FED. ROAD DIST. NO.	STATE	FEDERAL AID PROJ. NO.	FISCAL YEAR	SHEET NO.	TOTAL SHEETS
HAWAII	HAW.	ER-22(002)	2019	ADD 26	94

STRUCTURAL GENERAL NOTES:

4. Materials (Continued):

K. Non-shrink grout shall be a pre-mixed product consisting of non-staining, non-metallic aggregate cement, water reducing and plasticizing agents capable of developing a minimum compressive strength of 4000 psi in 3 days and 7000 psi in 28 days. The non-shrink grout shall contain at least 10 grams of migrating amine carboxylate corrosion inhibiting admixture per 0.4 to 0.5 cubic feet of no-shrink grout.

L. Elastomeric waterproofing membrane shall be applied on the CIP topping. The tensile strength (ASTM D412) shall be at least 350 psi, the elongation (ASTM D412 at least 300% and the tensile bond adhesion (ASTM C297) at least 300 psi cohesive. All work including surface preparation, application and limitations shall be in accordance with the manufacturer's brochure.

M. Rock anchors and vertical ground anchors shall be all-thread rebar conforming to ASTM A615 Grade 75 and hot-dip galvanized in accordance with ASTM A767 Class 1. Any damage to corrosion protective coating on bars shall be repaired in accordance with manufacturer's recommendations or else bars shall not be used.

N. Bearing plates, nuts, washers and couplers for ground anchors shall conform to the following:

(1) Bearing plates: ASTM A36

(2) Nuts: ASTM A563

(3) Washers: ASTM F436

(4) Couplers: ASTM A108

(5) All hardware shall be hot-dip galvanized in accordance with ASTM A123, A153, and F2329, respectively.

O. Grout for rock anchors and vertical ground anchors shall conform to "Section 681 - Grouted Anchor". In addition, grout mix shall be proportioned as follows:

(1) Use 94 lbs of type I/II cement, 4 gallons of water, and 3 to 6 lbs of Masterroc FLC 100 admixture or approved equal.

(2) Use 1 oz. of Amine Carboxylate corrosion inhibiting water-based admixture such as Cortec MCI 2005 NS or approved equal per 94 lb bag of cement.

(3) Use Glenium 3030 or approved equal for workability as needed.

(4) Grout shall be stable (bleed less than 2%) per ASTM C940.

(5) Corrosion inhibitor and Masterroc shall be added to the mixing water before adding cement.

4. Materials (Continued):

(6) Temperature of grout shall not exceed 85°F at the end of the grouting hose coupling to fill tube.

(7) Use 0.3 lbs ± 0.1 lbs of VMA such as Walocel MW PFV admixture or approved equal per 94 lb bag of cement.

P. Bonding agent shall be a three-component, preproportioned, water based epoxy modified portland cement bonding agent and anti-corrosion coating. Bond strength shall exceed 2,400 psi in accordance with ASTM C882.

Q. Expanded Polystyrene (EPS) used as energy absorbing material shall have a maximum density of 1.80 lb/cf, a minimum elastic modulus of 730 psi, and a poisons ratio equal to exactly 0.05.

R. A dark gray internal pigmenting shall be added to Item Nos 11, 18, 19, 21, and 22. A test sample shall be submitted to the Engineer for review and approval.

S. Very Early Strength Latex Modified Concrete (VESLMC) shall consist of FasTrac 246 concrete, an added amine carboxylate corrosion inhibiting admixture, and a Ready-To-Use FasTrac Polymer so that when combined it produces a rapid-setting material capable of achieving 2,500 psi of compressive strength in 1.5-hours.

T. Very Early Strength Grout shall be FasTrac 246 mortar. Grout shall be of pourable consistency and shall be capable of developing 2,500 psi of compressive strength in 3 hours.

5. Reinforcement:

A. Unless otherwise noted, the clear covering measured from the surface of the concrete to the face of any reinforcing steel bars shall be as follows:

(1) Deck Topping

(a) Top bars = 2 1/2"

(2) For precast planks see Sheets S9.1 through S9.2.

(3) Stirrups and ties = 2"

(4) Drilled shafts = 4"

(5) Reinforcing in concrete cast against and permanently exposed to earth = 3".

(6) All others = 2"

B. Reinforcing steel shall conform to ASTM A615, Grade 60 deformed bars unless otherwise noted.

C. Minimum clear spacing between parallel bars shall be 1 1/2 times the maximum size of the coarse aggregate or 1 1/2 inches, whichever is greater, except when bundled.

5. Reinforcement (Continued):

D. Reinforcing bars shall be placed and installed in accordance with the CRSI Manual of Standard Practice and CRSI Placing Reinforcing Bars, unless otherwise noted.

E. Reinforcing bars shall be securely tied at all intersections and lap splices except where the spacing of the intersections is less than 12 inches in each direction, in which case alternate intersections shall be tied.

F. Minimum lap splice length for steel reinforcing shall be 40 bar diameters or 2'-0", whichever is greater, unless otherwise noted. Increase lap length by multiplying the minimum lap splice length by 1.3 for bars having more than 12" of fresh concrete below bars.

G. Unless otherwise noted, reinforcing splices shall be staggered. Minimum distance between staggered lap splice shall be equal to the length required for the lap splice. Number of bars spliced at sections normal to axis of member shall not exceed 50 percent of the total main reinforcing in the member.

H. All dimensions relating to reinforcing bars are to centers of bars unless otherwise noted.

I. Stainless steel deformed reinforcing bars (as noted) shall conform to ASTM A955 Type 2205, with a minimum yield and ultimate strength of 65 ksi and 95 ksi respectively. Follow CRSI Engineering Technical Note ETN-M-2-12 for stainless steel rebar handling and storage.

J. Stainless steel shall not come into contact with dissimilar metals. Separate contact points using teflon isolation material or dielectric tape.

K. Glass Fiber Reinforced Polymer (GFRP) rebar ASTM D7957 shall have a minimum modulus of elasticity of 6,500,000 psi.

ORIGINAL PLAN	DATE
DESIGNED BY	
TRACED BY	
NOTED BY	
CHECKED BY	

DRAWING NAME: Z:\00 ONGOING\19-014.1 PALI ROOF SHED-WSP-TM-01 CAD\07-15-19 DELTA 4\PLM-S0002 ADD1 STRUCT NOTES.DWG PLOT TIME: 07-12-19, 7:39 AM

7/12/19	4 Revised Notes
5/24/19	1 Revised Notes
DATE	REVISION
STATE OF HAWAII DEPARTMENT OF TRANSPORTATION HIGHWAYS DIVISION	
STRUCTURAL GENERAL NOTES	
PALI HIGHWAY LANDSLIDE MITIGATION PROJECT FAP Proj. No. ER-22(002)	
Scale: None	Date: May 6, 2019
SHEET No. S0.3 OF 5 SHEETS	

FED. ROAD DIST. NO.	STATE	FEDERAL AID PROJ. NO.	FISCAL YEAR	SHEET NO.	TOTAL SHEETS
HAWAII	HAW.	ER-22(002)	2019	ADD 27	94

6. General Construction Notes:

- 1

A. Requirements for formwork within these general notes shall govern over the specifications and special provisions.
- B. Unless otherwise noted, all vertical dimensions are measured plumb.
- C. The Contractor shall verify all site conditions before commencing the work of excavation.
- D. Unless otherwise noted, all exposed concrete surfaces shall be chamfered 3/4"x3/4".
- E. Existing reinforcing shall not be damaged during demolition work, unless otherwise permitted.
- F. For concrete finish see standard specifications and special provisions.
- G. Construction joints may be relocated or additional ones added subject to the approval of the Engineer.
- H. Retaining walls shall meet the following requirements:

1

1. Do not erect formwork for retaining wall on footing until minimum of 24 hours after concrete placement of footing.

2. Do not remove formwork for the retaining wall until a minimum of 24 hours.

3. Post-tension and grout the retaining wall after 48 hours and once the concrete has reached a minimum compressive strength of 3,000 psi.

4. Retaining wall shall not be vertically loaded until reaching a minimum compressive strength of 4,000 psi and 120 hours has elapsed since placing concrete.

I. Columns shall meet the following requirements:

- 1

1. Do not erect formwork for transition zone on the drilled shaft until minimum of 24 hours after concrete placement of drilled shaft.
2. Do not erect formwork for column on transition zone until minimum of 24 hours after concrete placement of transition zone.
3. Do not remove formwork for the columns until a minimum of 24 hours.
4. Do not erect formwork for cap beam on columns until reaching a minimum compressive strength of 4,000 psi and 72 hours has elapsed since placing concrete.

6. General Construction Notes (Continued):

J. Cap beams shall meet the following requirements:

- 1

1. Side forms for cap beams shall be removed after a minimum of 96 hours.
2. Formwork for the soffit shall be removed only after reaching a minimum compressive strength of 4,000 psi and 120 hours as elapsed since placing concrete.
3. Cap beams shall not be vertically loaded until reaching both a minimum compressive strength of 5,000 psi and 120 hours has elapsed since placing concrete.

K. Precast planks may be lifted and moved after reaching both a minimum compressive strength of 4,000 psi and 48 hours has elapsed since placing concrete.

L. Waterproofing over the CIP topping may be applied no sooner than 120 hours after the concrete has been placed when using a curing accelerator such as Vapor Shield or approved equal. Contractor shall follow manufacturer's recommendations during construction.



ORIGINAL PLAN	SURVEY PLOTTED BY _____	DATE _____
NOTE BOOK	DRAWN BY _____	
No. _____	DESIGNED BY _____	
	QUANTITIES BY _____	
	CHECKED BY _____	

DRAWING NAME: Z:\00 ONGOING\19-014.1 PALI ROOF SHED-WSP-TM\01 CAD\05-24-19 PH 2\PLM-S0002 ADD1 STRUCT NOTES.DWG PLOT TIME: 06-03-19, 10:46 AM

5/24/19	<div><div>1</div><div>Revised Notes</div></div>
DATE	REVISION
STATE OF HAWAII DEPARTMENT OF TRANSPORTATION HIGHWAYS DIVISION	
STRUCTURAL GENERAL NOTES	
PALI HIGHWAY LANDSLIDE MITIGATION PROJECT FAP Proj. No. ER-22(002)	
Scale: None	Date: May 6, 2019
SHEET No. 50.4 OF 5 SHEETS	

ORIGINAL PLAN	DATE
NOTE BOOK	
No.	

DRAWING NAME: Z:\00 ONGOING\19-014.1 PALI ROOF SHED-WSP-TM-01 CAD\05-06-19 TOPO\PLM-S0005 SYMBOLS\REV.DWG PLOT TIME: 05-06-19, 11:37 PM

FED. ROAD DIST. NO.	STATE	FEDERAL AID PROJ. NO.	FISCAL YEAR	SHEET NO.	TOTAL SHEETS
HAWAII	HAW.	ER-22(002)	2019	28	94

SYMBOLS AND ABBREVIATIONS

\$	And	Demo	Demolish, Demolition	H	Height	P(e)	Effective or Working	Stirr.	Stirrup
@	At	Def.	Detail	(H)	Hinge		Prestressing Force	Str.	Straight
Ø	Diameter	Dia.	Diameter	Horiz.	Horizontal	PP	Precast Plank	Struct.	Structure
#	Number, Pound	Dim.	Dimension	HS	High strength	Perf.	Perforated	SE	Super Elevation
		Dist.	Distance	HSS	Hollow Structural Section	PL	Plate	Symm.	Symmetrical
		DO	Ditto	HECO	Hawaiian Electric Company	PCC	Portland Cement Concrete		
Abut.	Abutment	Dwls.	Dowels			PC	Point of Curvature		
Abbr.	Abbreviation	Dn.	Down			PCF	Pounds per Cubic Foot	Tan.	Tangent
Add.	Additional, Added	Dbl.	Double	IB, Inbnd.	Inbound	PSF	Pounds per Square Foot	Temp.	Temporary
Alt.	Alternate	DI	Drain Inlet, Ductile Iron	In.	Inch	PSI	Pounds per Square Inch	Thk.	Thick
AB	Anchor Bolt	Dwg., Dwgs.	Drawing, Drawings	ID	Inside Diameter	PLF	Pounds per Linear Foot	T	Top
AC	Asphaltic Concrete	DS	Drilled Shaft	IF	Inside Face	PI	Point of Intersection of Tangents	T&B	Top and Bottom
Approx.	Approximate			Int.	Interior		Point of Intersection of Vertical Curve	TOD	Top of Deck
AZ.	Azimuth			Inv.	Invert	PIVC	Point of Intersection of Vertical Curve	TFE	Top of Footing Elevation
		EA, Ea, ea.	Each			PT	Point of Tangency, Post Tensioned	TOW	Top of Wall
		EF	Each Face				Point, Points	Tot.	Total
Bk.	Back	EFH	Each Face Horizontal	Jt.	Joint	Pt., Pts.	Point of Reverse Curvature	Transv.	Transverse
Bal.	Balance	EFV	Each Face Vertical			PRC	Polyvinyl Chloride	TS	Structural Tubing
Ø	Baseline	EW	Each Way			PVC	Prestressed	Typ.	Typical
Bm.	Beam	EP	Edge of Pavement	K	Kips	Prestr.	Prestressed Strands		
Brg., Brgs.	Bearing, Bearings	EPS	Expanded Polystyrene	KF	Kip Foot	P/S	Pull Box	Undergrd.	Underground
BVC	Beginning of Vertical Curve	E	East	KSI	Kips Per Square Inch	PB		UNO	Unless Noted Otherwise
BMP	Best Management Practices	Elec.	Electrical	KLF	Kips Per Linear Foot				
Bet.	Between	EMH	Electrical Manhole						
BF	Both Faces, Back Face	El., Elev.	Elevation						
BW	Both Ways	Emb.	Embankment						
BFE	Bottom of Footing Elevation	Embed.	Embedded, Embedment						
Bot., Bott., B	Bottom	EVC	End of Vertical Curve	L	Length	Q	Flow Rate	Var.	Varies
Br.	Bridge	Eq.	Equal	lb., lbs., LBS.	Pound, Pounds			Vert., V	Vertical
Blt.	Bolt	Est.	Estimated	Ltg. Std.	Lighting Standard	Rad., R	Radius	VC	Vertical Curve
		Exc.	Excavation	LF	Linear Feet/Foot	RF	Rear Face		
		Excl.	Excluding	Lin. Ft.	Linear Feet/Foot	Rebar	Reinforcing Bar	W/C	Water/Cement Ratio
		Exist., Ex.	Existing	LS	Lump Sum	Ref.	Reference	w/	With
Cant.	Cantilever	Exp., (E)	Expansion	Longit.	Longitudinal	Reinf.	Reinforced, Reinforcing, Reinforcement	W	West
C.B.	Catch Basin	EJ	Expansion Joint					WWR	Welded Wire Reinforcing
CIP	Cast-in-Place	Ext.	Exterior					WW	Wing Wall
Ø	Centerline					Req'd.	Required	WP	Work Point, Working Point
CG	Center of Gravity					Ret.	Retaining	WS	Water Surface
cgs	Center to Gravity of Strands					ROW	Right of Way		
cc	Center to Center					Rdwy.	Roadway		
Cl.	Class								
Clr.	Clearance	FF	Far Face, Front Face	M	Modified	Sch.	Schedule	Yr.	Year
Col.	Column	F'c	Specified Strength of Concrete	MH	Manhole	Sect.	Section		
Conc.	Concrete			Max.	Maximum	SDMH	Sewer Drain Manhole		
Conn.	Connection	F'ci	Strength of Concrete at Time of Initial Prestress	Mech.	Mechanical	Sht.	Sheet		
Const.	Construction			Min.	Minimum	SRA	Shrinkage Reducing Admixture		
CFCW	Continuous Flashing	Ft.	Feet, Foot	Misc.	Miscellaneous	SI.	Slope		
	Compound Waterproofing	Fig.	Figure	MPH	Miles Per Hour	S	South		
CJ	Control Joint	Fin. Gr.	Finish Grade			Spc	Spacing		
Const. Jt.	Construction Joint	(F)	Fixed	NF	Near Face	Sprd.	Spread		
CLSM	Controlled Low Strength Material	FB	Flat Bar	NIC	Not in Contract	Spec.	Specification		
		Ftg.	Footing	No.	Number	SF	Square Feet		
		FA	Force Account	NTS	Not to Scale	SY	Square Yard		
Cont.	Continuous					SS. SSTL	Stainless Steel		
CF	Cubic Feet					Std.	Standard		
CY, Cu. Yd.	Cubic Yard					Sta.	Station		
CSL	Crosshole Sonic Logging					Stagg.	Staggered		
						Stiff.	Stiffener		
		Ga.	Gage, Gauge	O/S	Offset				
		Galv.	Galvanized	oc	On Center				
		GFRP	Glass Fiber Reinforced Polymer	Opn'g	Opening				
		Gr.	Grade	OB, Outbnd.	Outbound				
		Grd.	Ground	OD	Outside Diameter				
		GRP	Grouted Rubble Pavement						

STATE OF HAWAII
DEPARTMENT OF TRANSPORTATION
HIGHWAYS DIVISION

SYMBOLS AND ABBREVIATIONS

PALI HIGHWAY
LANDSLIDE MITIGATION PROJECT
FAP Proj. No. ER-22(002)

Scale: None Date: May 6, 2019

SHEET No. S0.5 OF 5 SHEETS