




FED. ROAD DIST. NO.	STATE	FEDERAL AID PROJ. NO.	FISCAL YEAR	SHEET NO.	TOTAL SHEETS
HAWAII	HAW.	ER-22(002)	2019	ADD 30	94

**Note:**  
Location of existing bridge is shown per As-Built information from Pali Road (Tunnel Section) Project S216(5). Contractor shall verify.

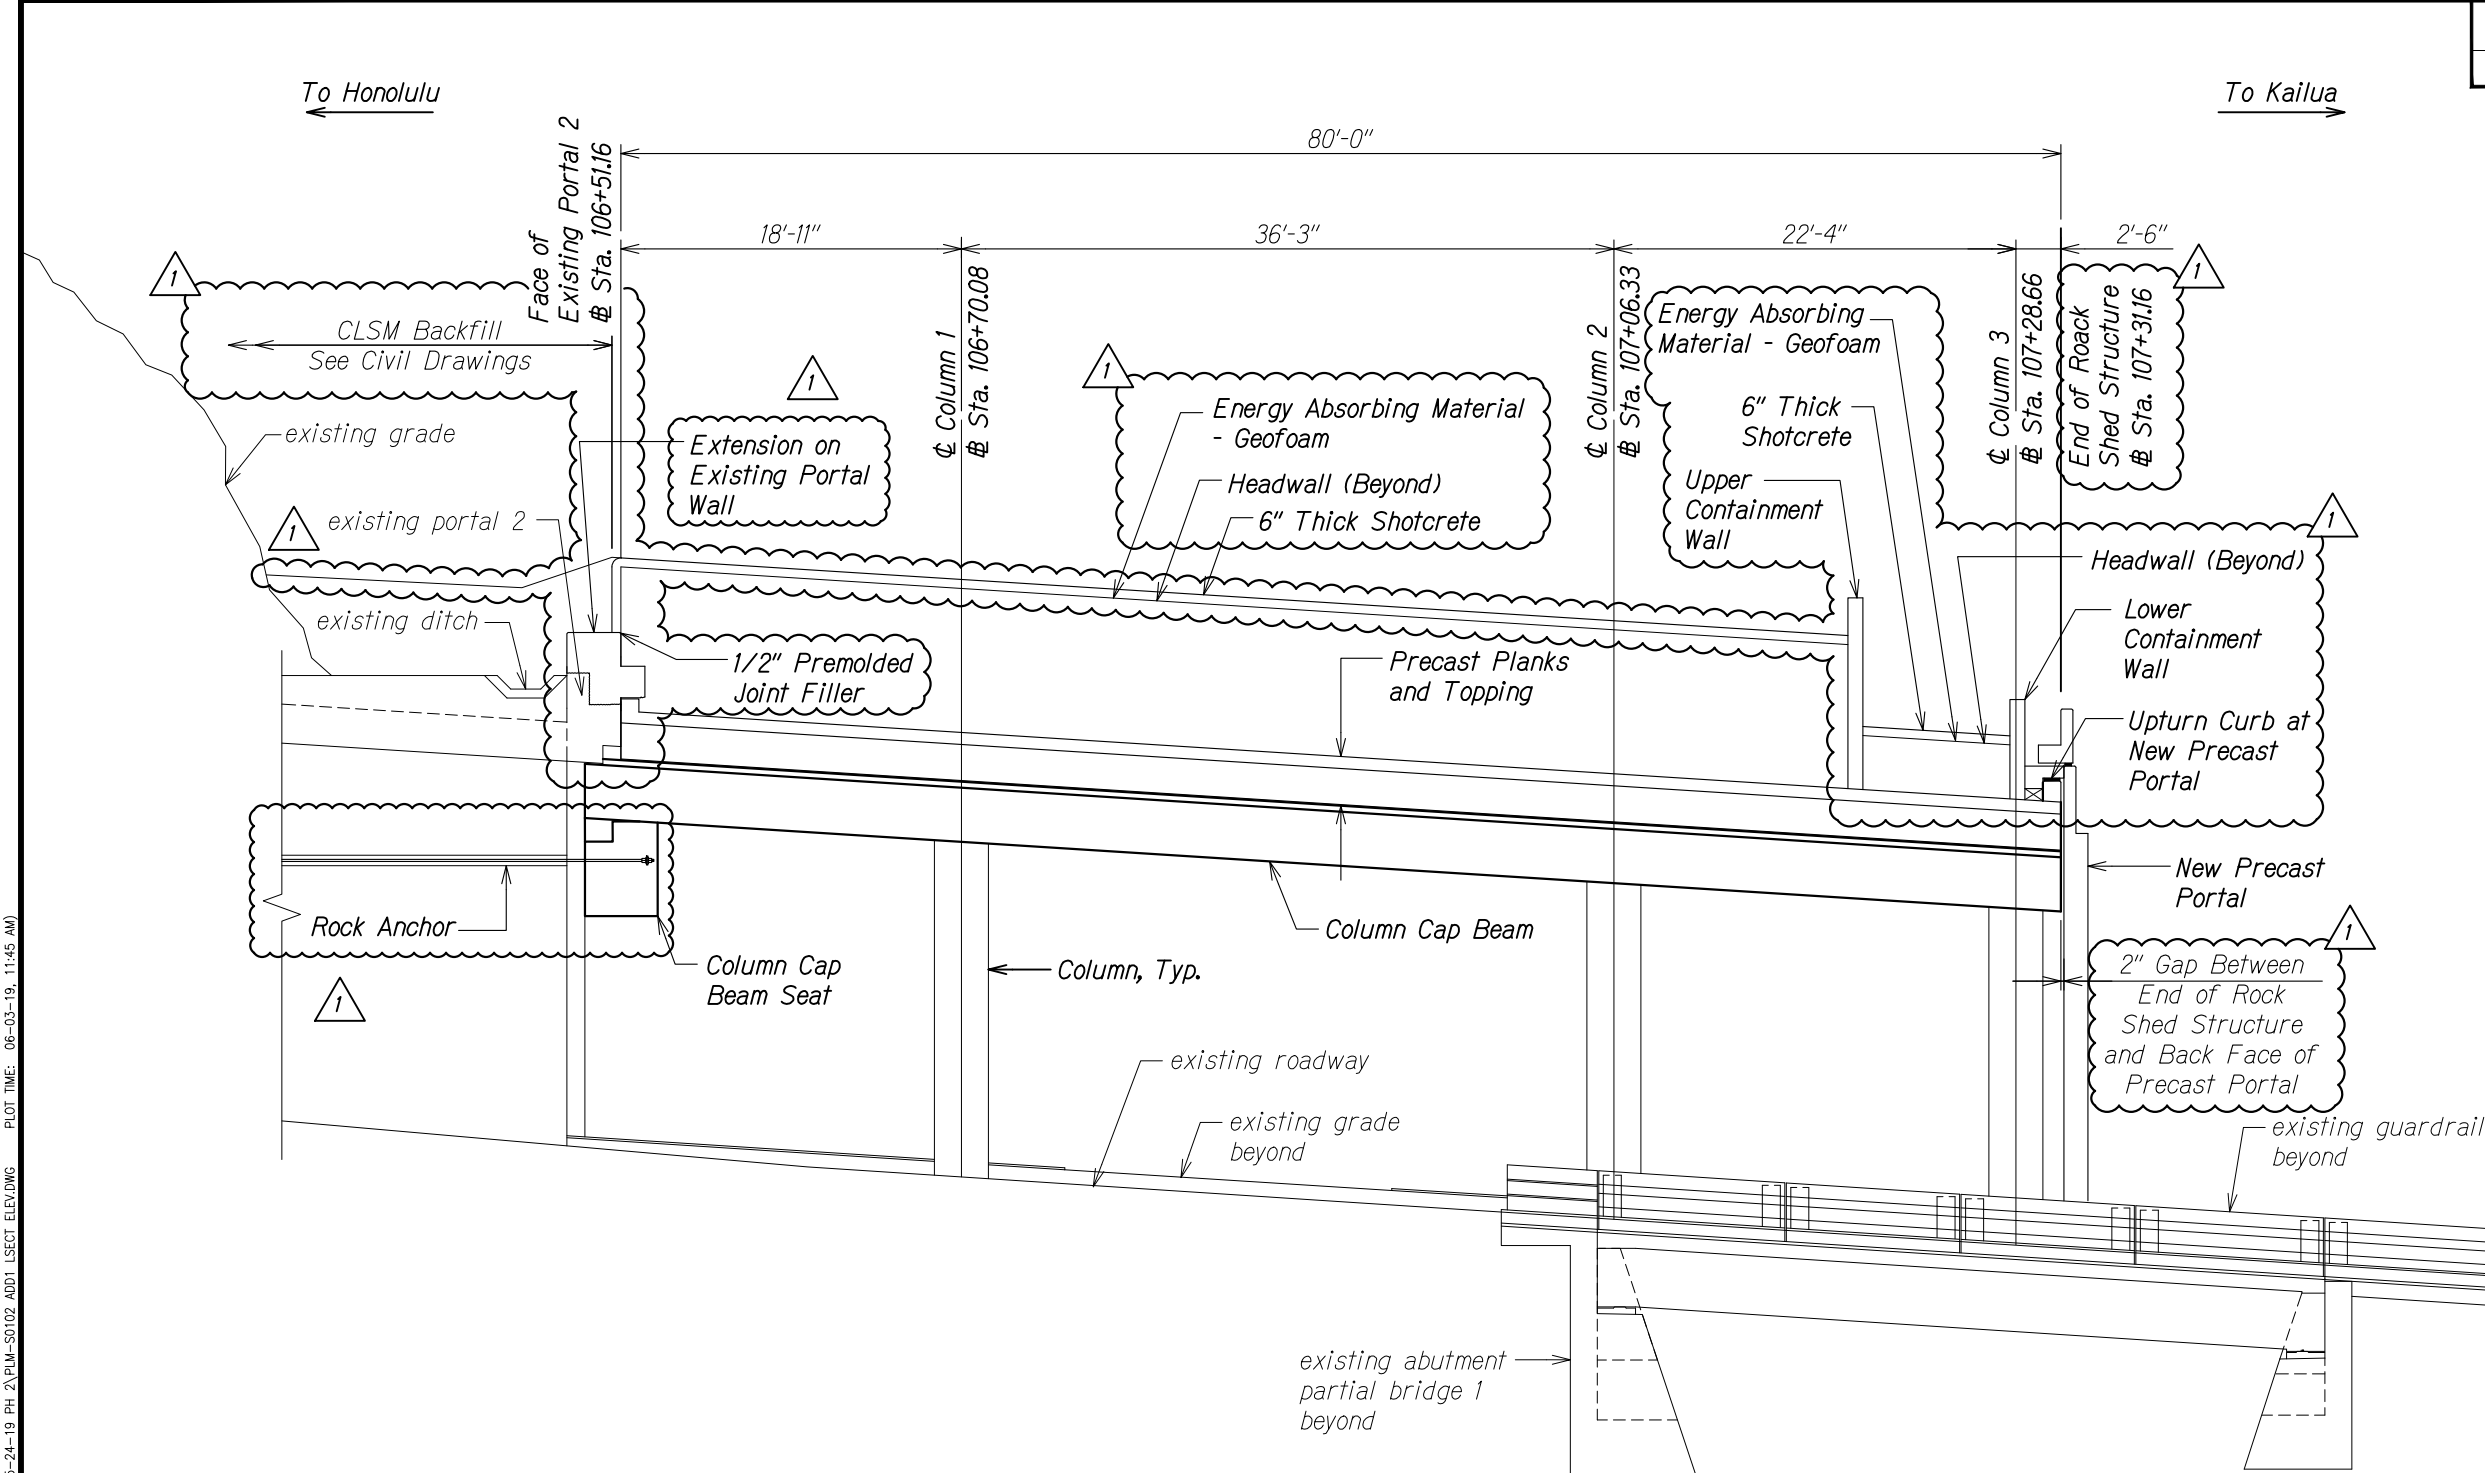

**LONGITUDINAL SECTION AT  $\phi$  ROCK SHED**  
Scale: 3/16" = 1'-0"  
A  
S1.2 | S1.2

5/24/19	<div>1</div> Revised Section
DATE	REVISION
STATE OF HAWAII DEPARTMENT OF TRANSPORTATION HIGHWAYS DIVISION	
<b>LONGITUDINAL SECTION</b>	
PALI HIGHWAY LANDSLIDE MITIGATION PROJECT FAP Proj. No. ER-22(002)	
Scale: As Noted	Date: May 6, 2019
SHEET No. S1.2 OF 6 SHEETS	




FED. ROAD DIST. NO.	STATE	FEDERAL AID PROJ. NO.	FISCAL YEAR	SHEET NO.	TOTAL SHEETS
HAWAII	HAW.	ER-22(002)	2019	ADD 32	94



**Note:**  
Location of existing bridge is shown per As-Built information from Pali Road (Tunnel Section) Project S216(5). Contractor shall verify.

DATE	10-04-19, 4:57 PM
DESIGNED BY	DELIA8 FNDLWS
CHECKED BY	DELIA8 FNDLWS
DATE	10-04-19, 4:57 PM
DESIGNED BY	DELIA8 FNDLWS
CHECKED BY	DELIA8 FNDLWS

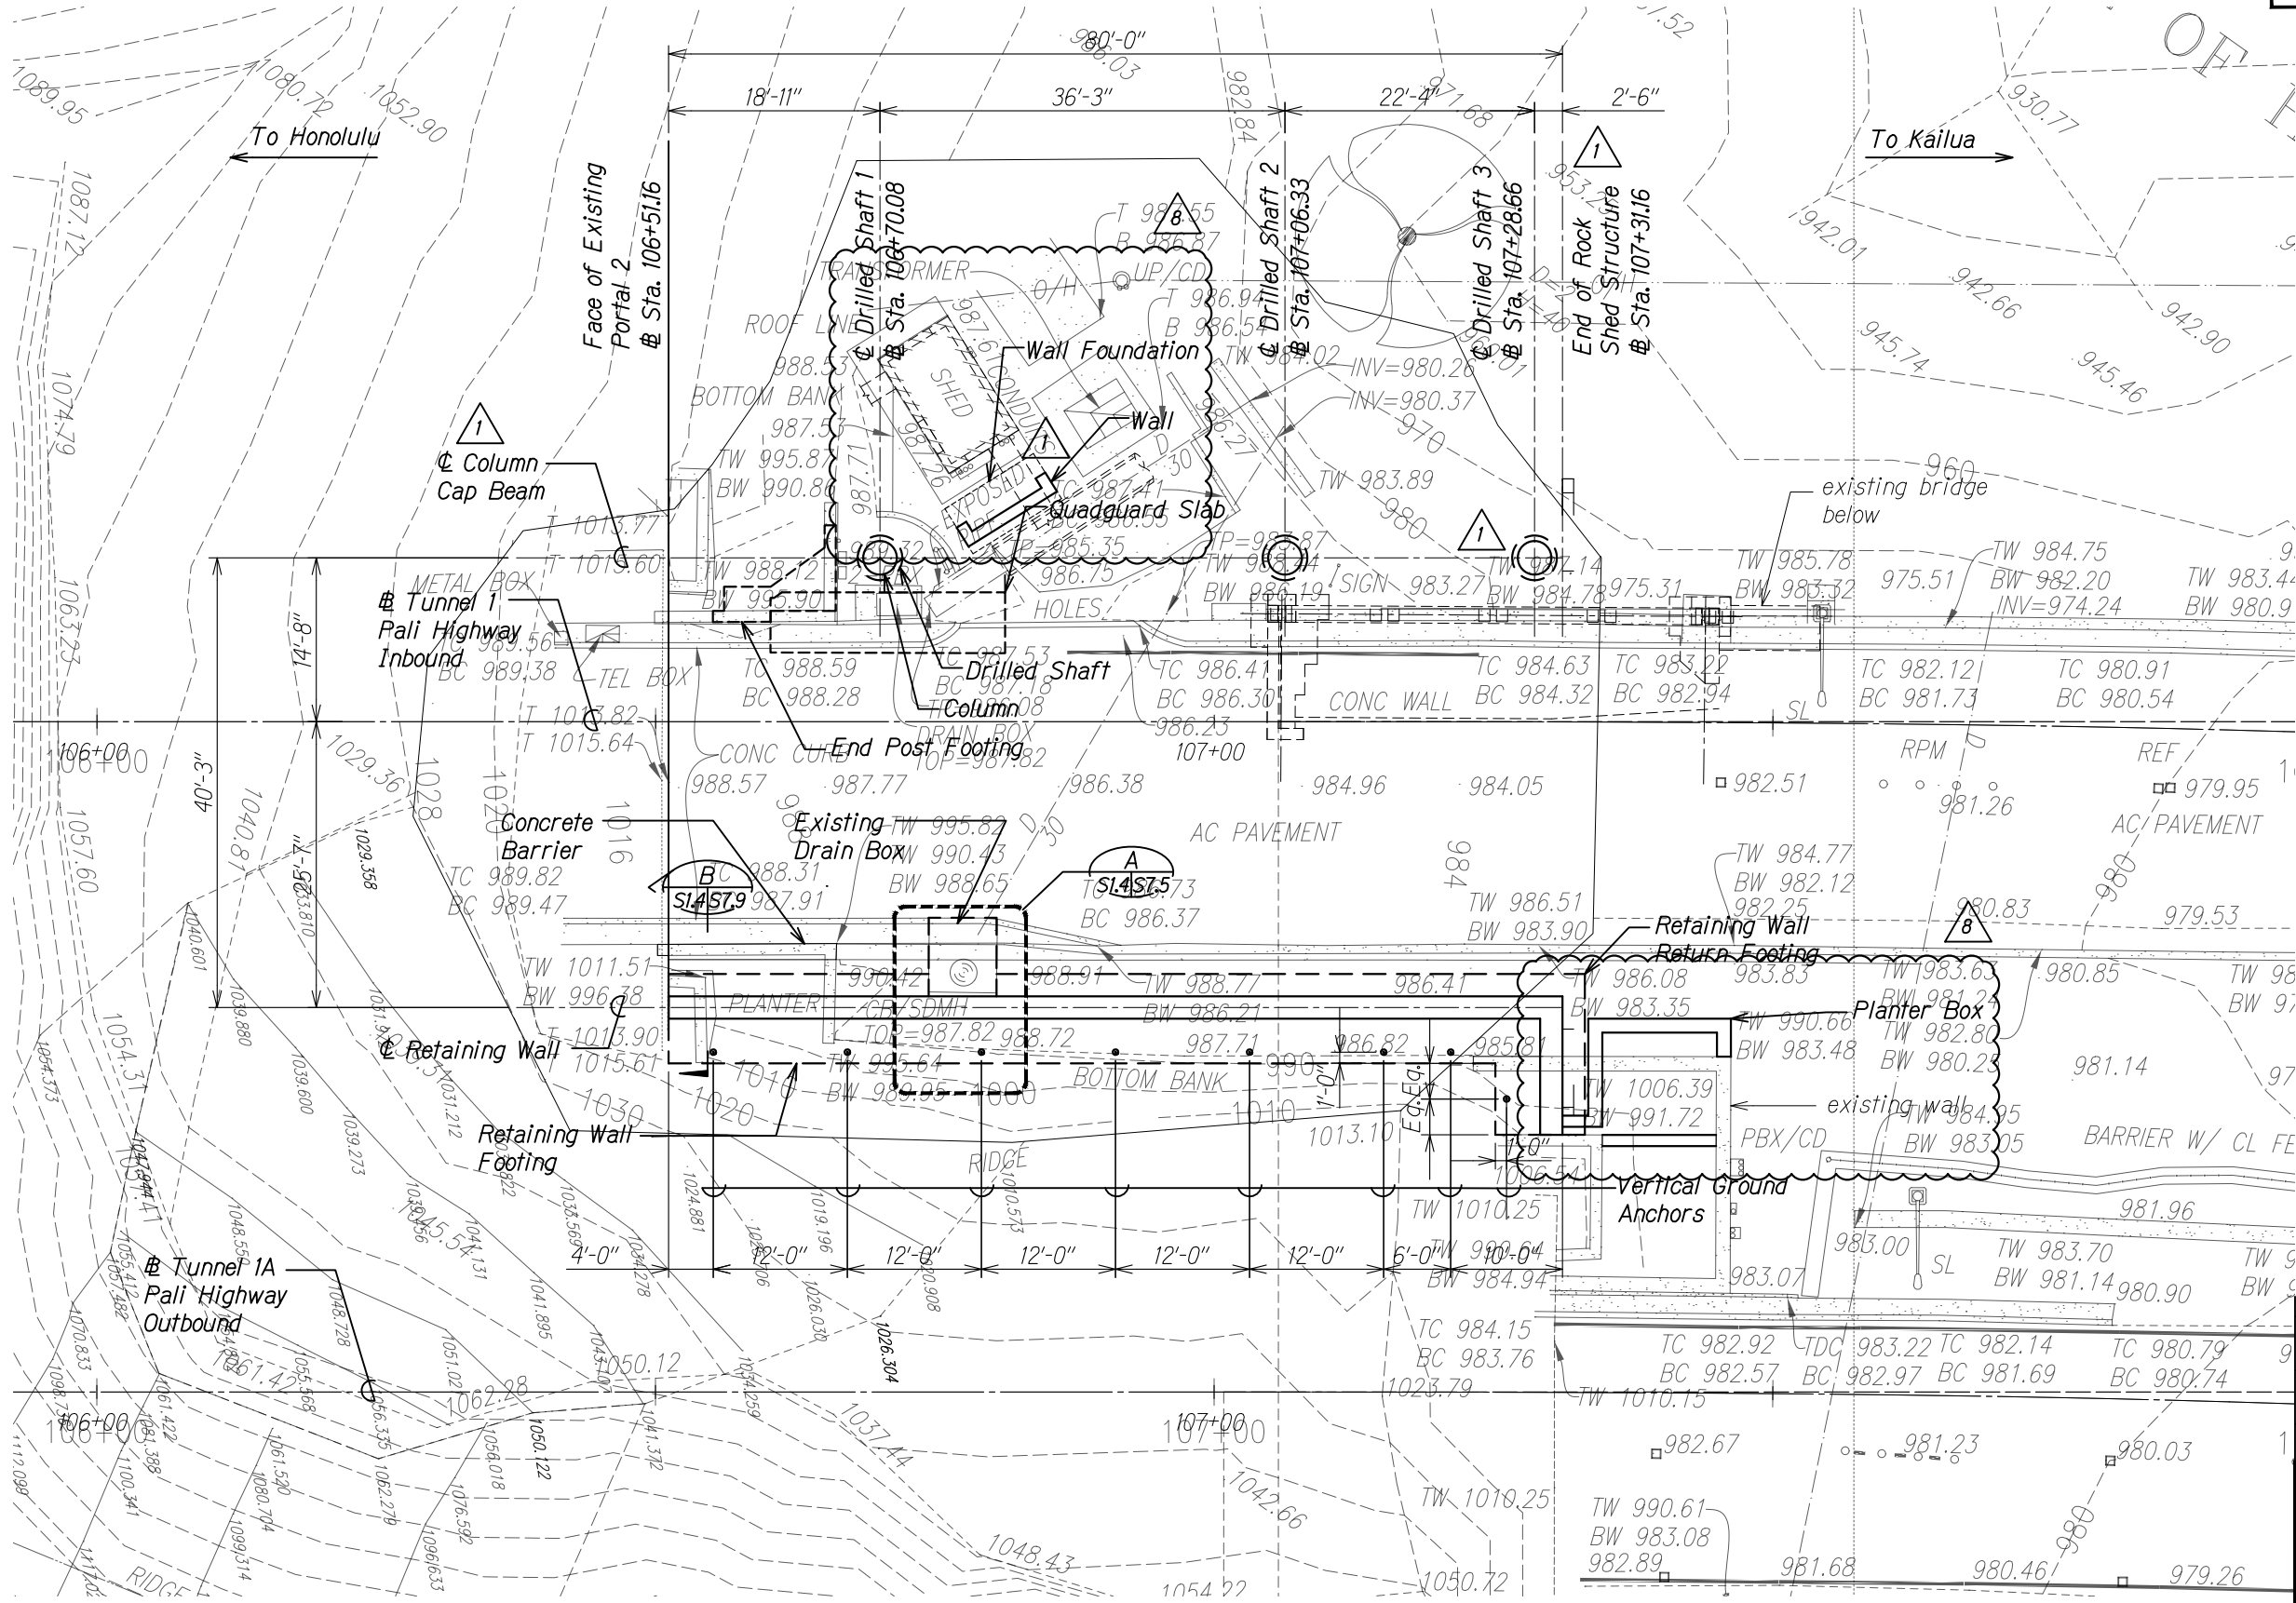DRAWING NAME: 23\00 ONDOING\19-014\1A PALI ROAD SHED POST DESIGN-WSP TIA01 CAD\10-04-19 DELIA8 FNDLWS PLOT TIME: 10-04-19, 4:57 PM



**FOUNDATION PLAN**  
Scale: 1/8" = 1'-0"  
A  
S1.4 S1.4

10/04/19		Revised Planter
5/24/19		Revised Callouts, Adjusted Drilled Shafts per As-Build Locations
DATE	REVISION	

STATE OF HAWAII  
DEPARTMENT OF TRANSPORTATION  
HIGHWAYS DIVISION

FOUNDATION PLAN


PALI HIGHWAY  
LANDSLIDE MITIGATION PROJECT  
FAP Proj. No. ER-22(002)

Scale: As Noted

Date: May 6, 2019

SHEET No. *SL4* OF 6 SHEETS

FED. ROAD DIST. NO.	STATE	FEDERAL AID PROJ. NO.	FISCAL YEAR	SHEET NO.	TOTAL SHEETS
HAWAII	HAW.	ER-22(002)	2019	ADD 33	94

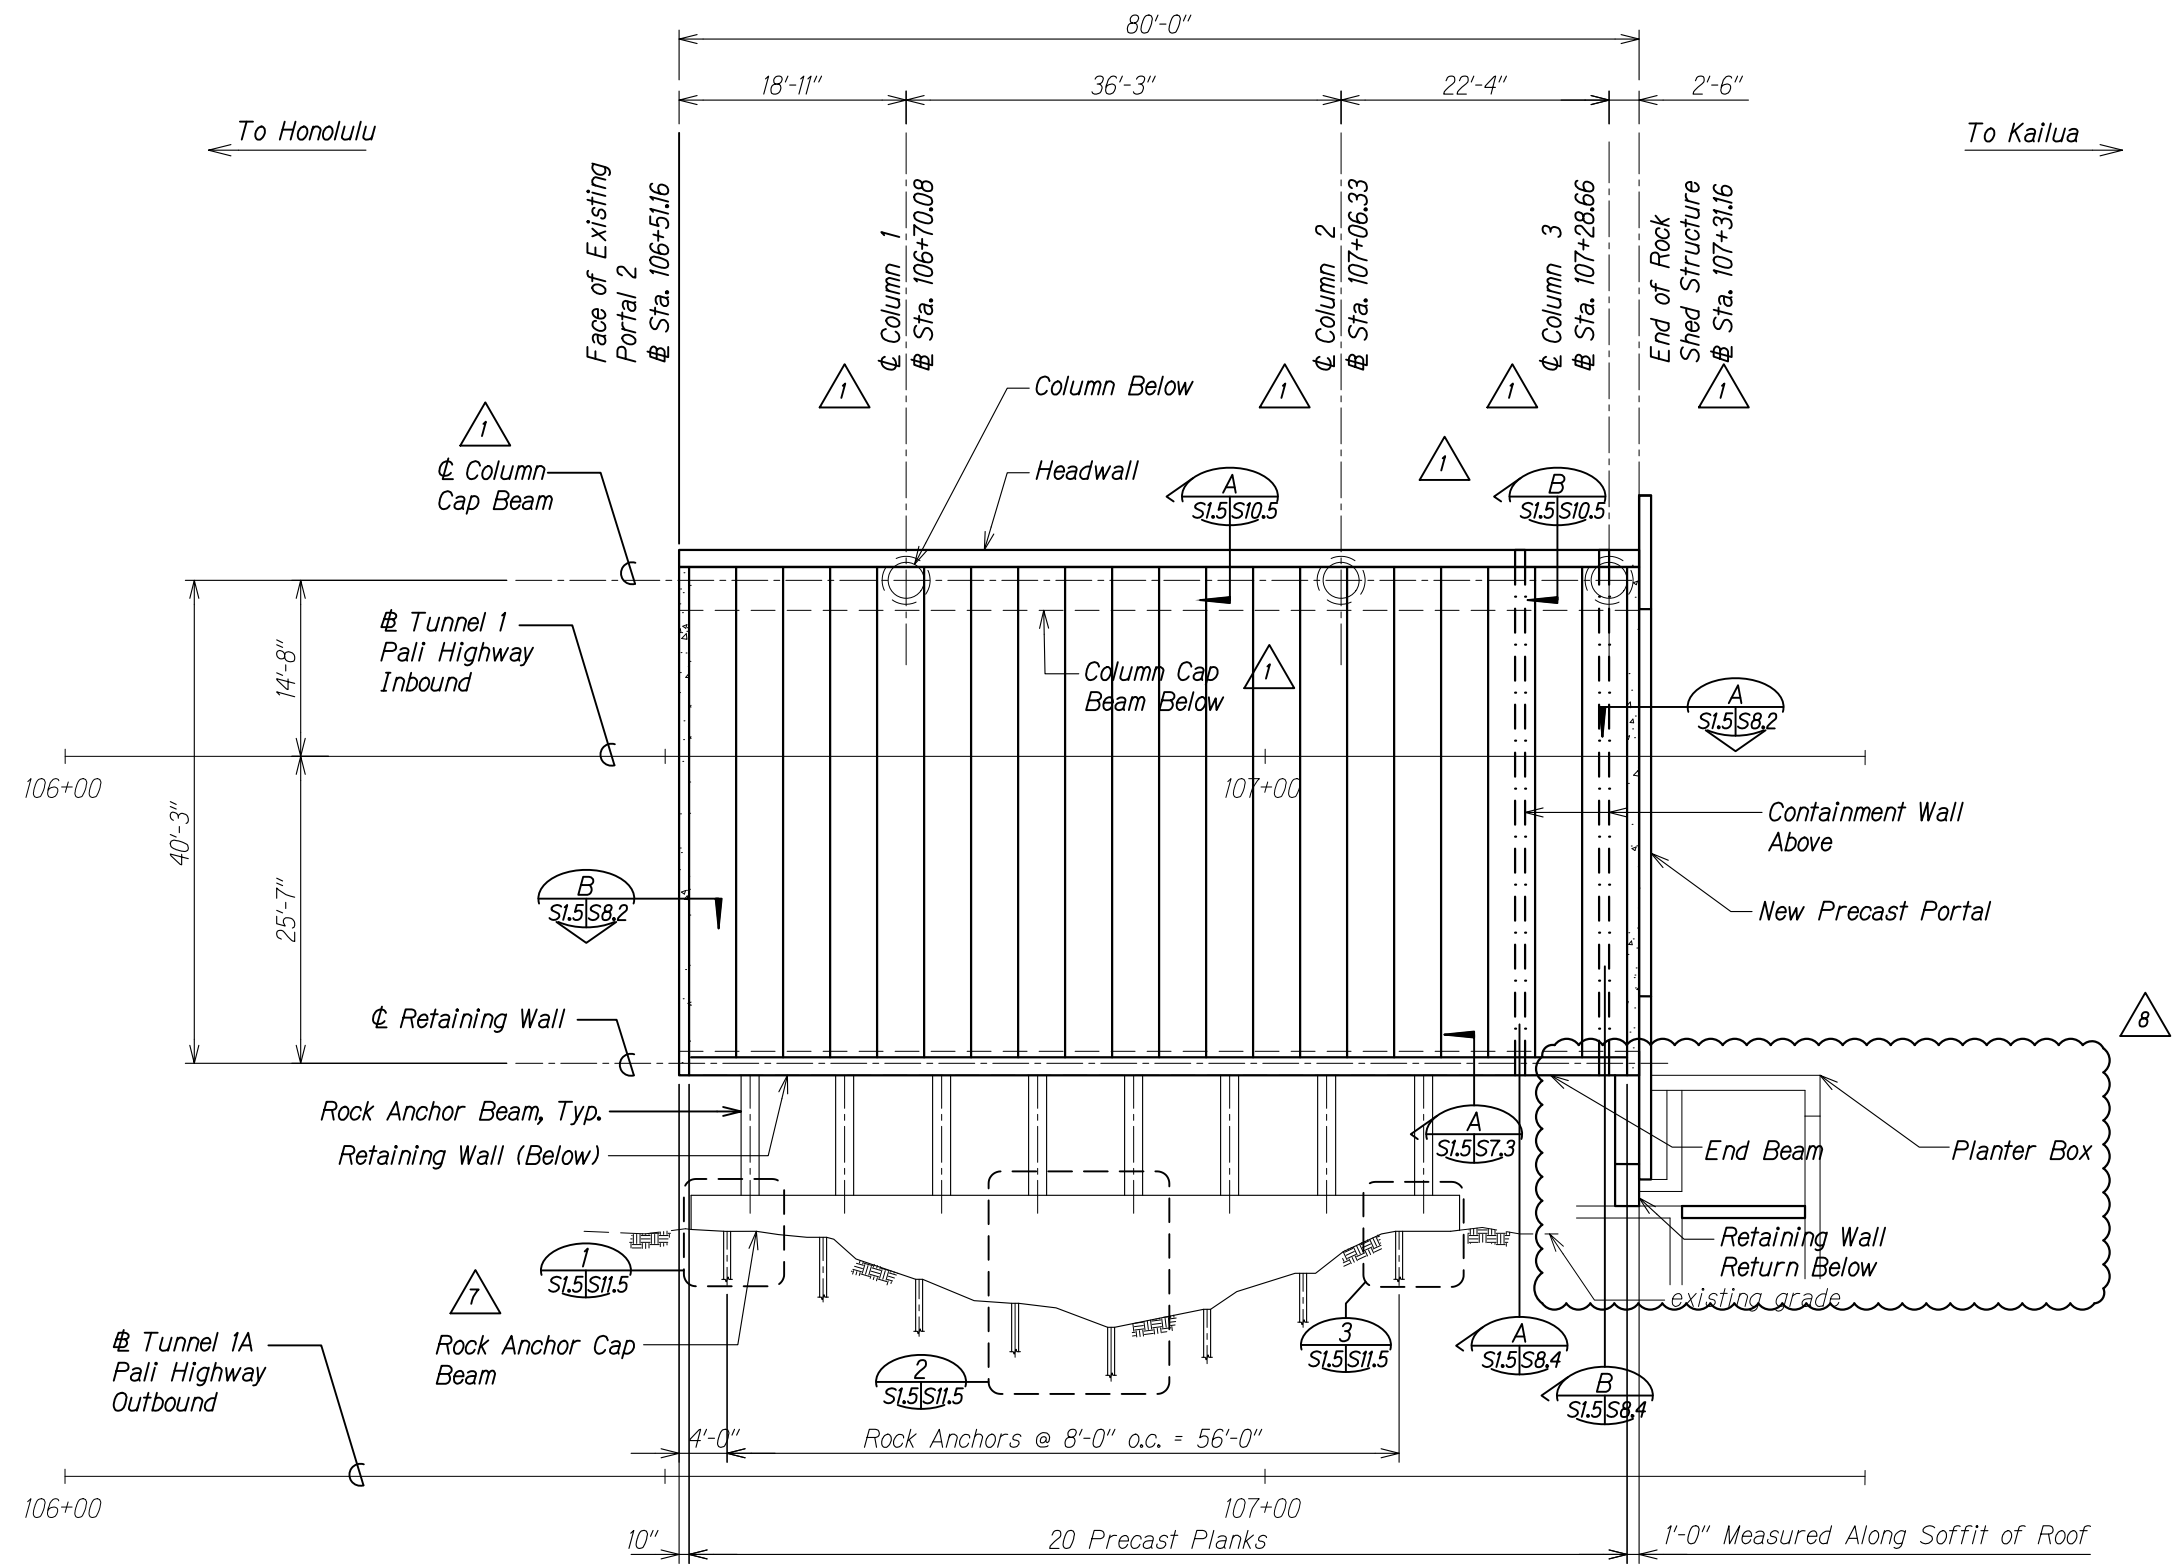

ROOF FRAMING PLAN  
Scale: 1/8" = 1'-0"

DATE	REVISION
10/04/19	8 Revised Planter
9/27/19	7 Added Rock Anchor Cap Beam
5/24/19	1 Revised Callouts, Adjusted Drilled Shafts per As-built Location

STATE OF HAWAII  
DEPARTMENT OF TRANSPORTATION  
HIGHWAYS DIVISION


**ROOF FRAMING PLAN**

PALI HIGHWAY  
LANDSLIDE MITIGATION PROJECT  
FAP Proj. No. ER-22(002)

Scale: As Noted Date: May 6, 2019

SHEET No. S1.5 OF 6 SHEETS

FED. ROAD DIST. NO.	STATE	FEDERAL AID PROJ. NO.	FISCAL YEAR	SHEET NO.	TOTAL SHEETS
HAWAII	HAW.	ER-22(002)	2019	ADD 34	94

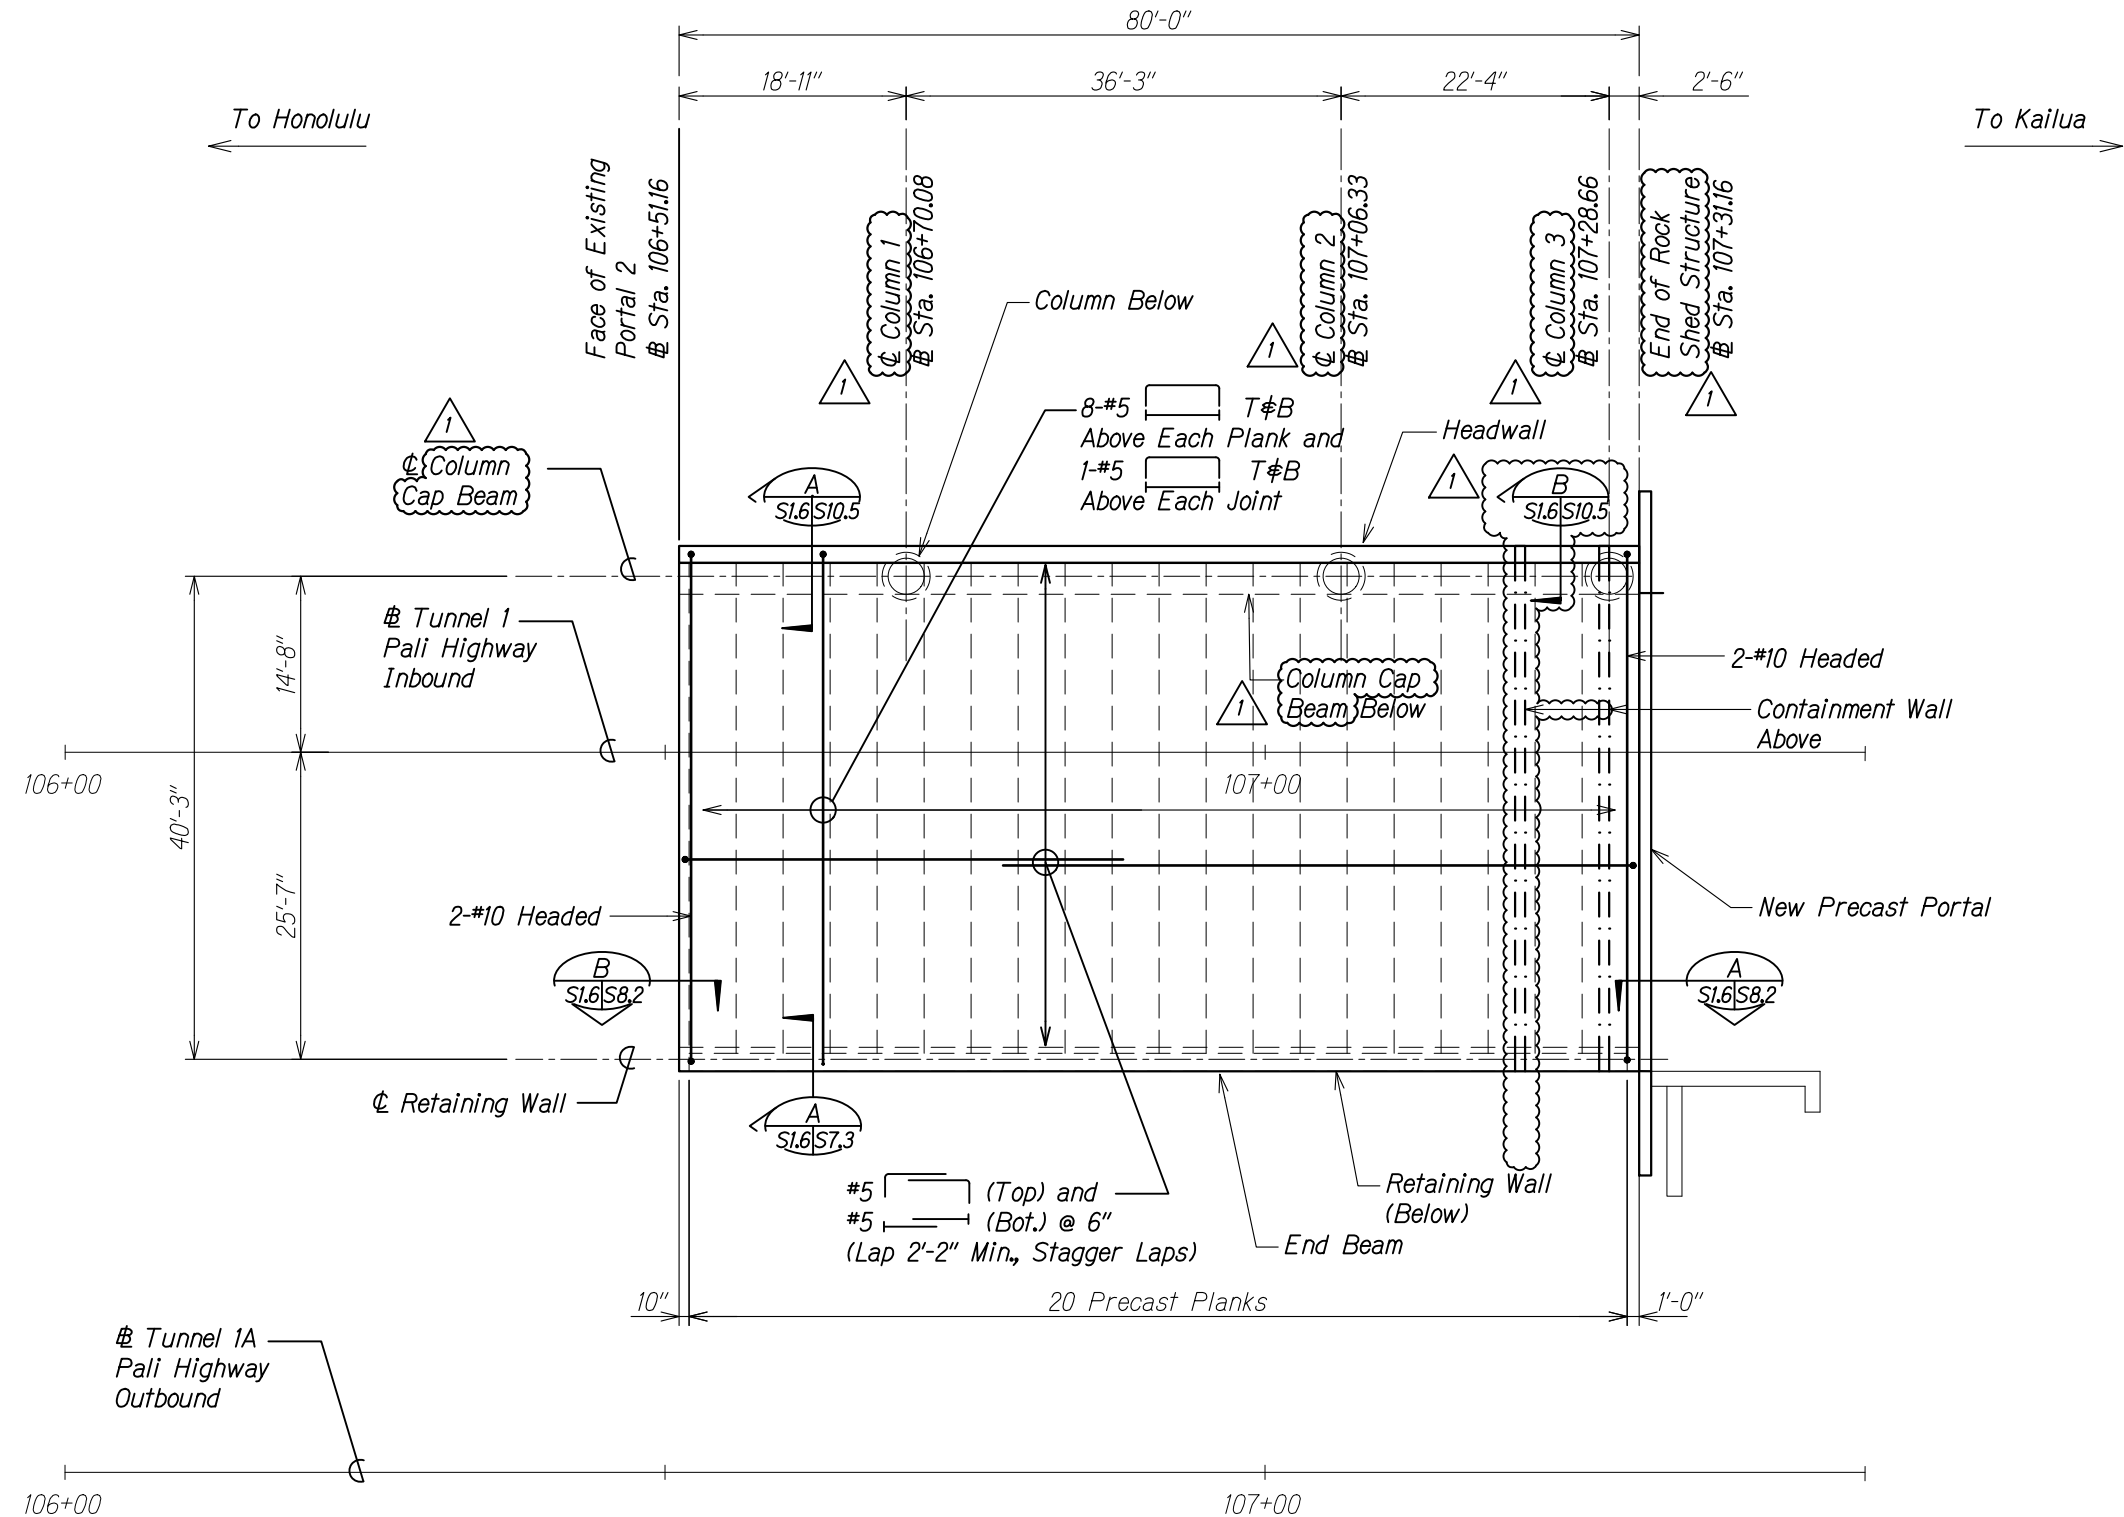

ORIGINAL PLAN	DATE
DESIGNED BY	
CHECKED BY	
NOTED BY	
QUANTITIES BY	
NO.	

**TOPPING PLAN**  
Scale: 1/8" = 1'-0"  
A  
S1.6 S1.6

5/24/19	1 Revised Callouts. Adjusted Drilled Shafts per As-built Location
DATE	REVISION
STATE OF HAWAII DEPARTMENT OF TRANSPORTATION HIGHWAYS DIVISION	
<b>TOPPING PLAN</b>	
<b>PALI HIGHWAY LANDSLIDE MITIGATION PROJECT FAP Proj. No. ER-22(002)</b>	
Scale: As Noted	Date: May 6, 2019
SHEET No. S1.6 OF 6 SHEETS	