


FED. ROAD DIST. NO.	STATE	FEDERAL AID PROJ. NO.	FISCAL YEAR	SHEET NO.	TOTAL SHEETS
HAWAII	HAW.	ER-22(002)	2019	ADD 39	94

ORIGINAL PLAN	DATE
NOTE BOOK	DESIGNED BY
No.	CHECKED BY

DRAWING NAME: Z:\00 ONGOING\19-014.1 PALI ROAD SHED-WSP TIA\01 CAD\05-24-19 PH 2\PLM-S0301 ADD1 TYPSEC1.DWG PLOT TIME: 06-03-19, 4:28 PM

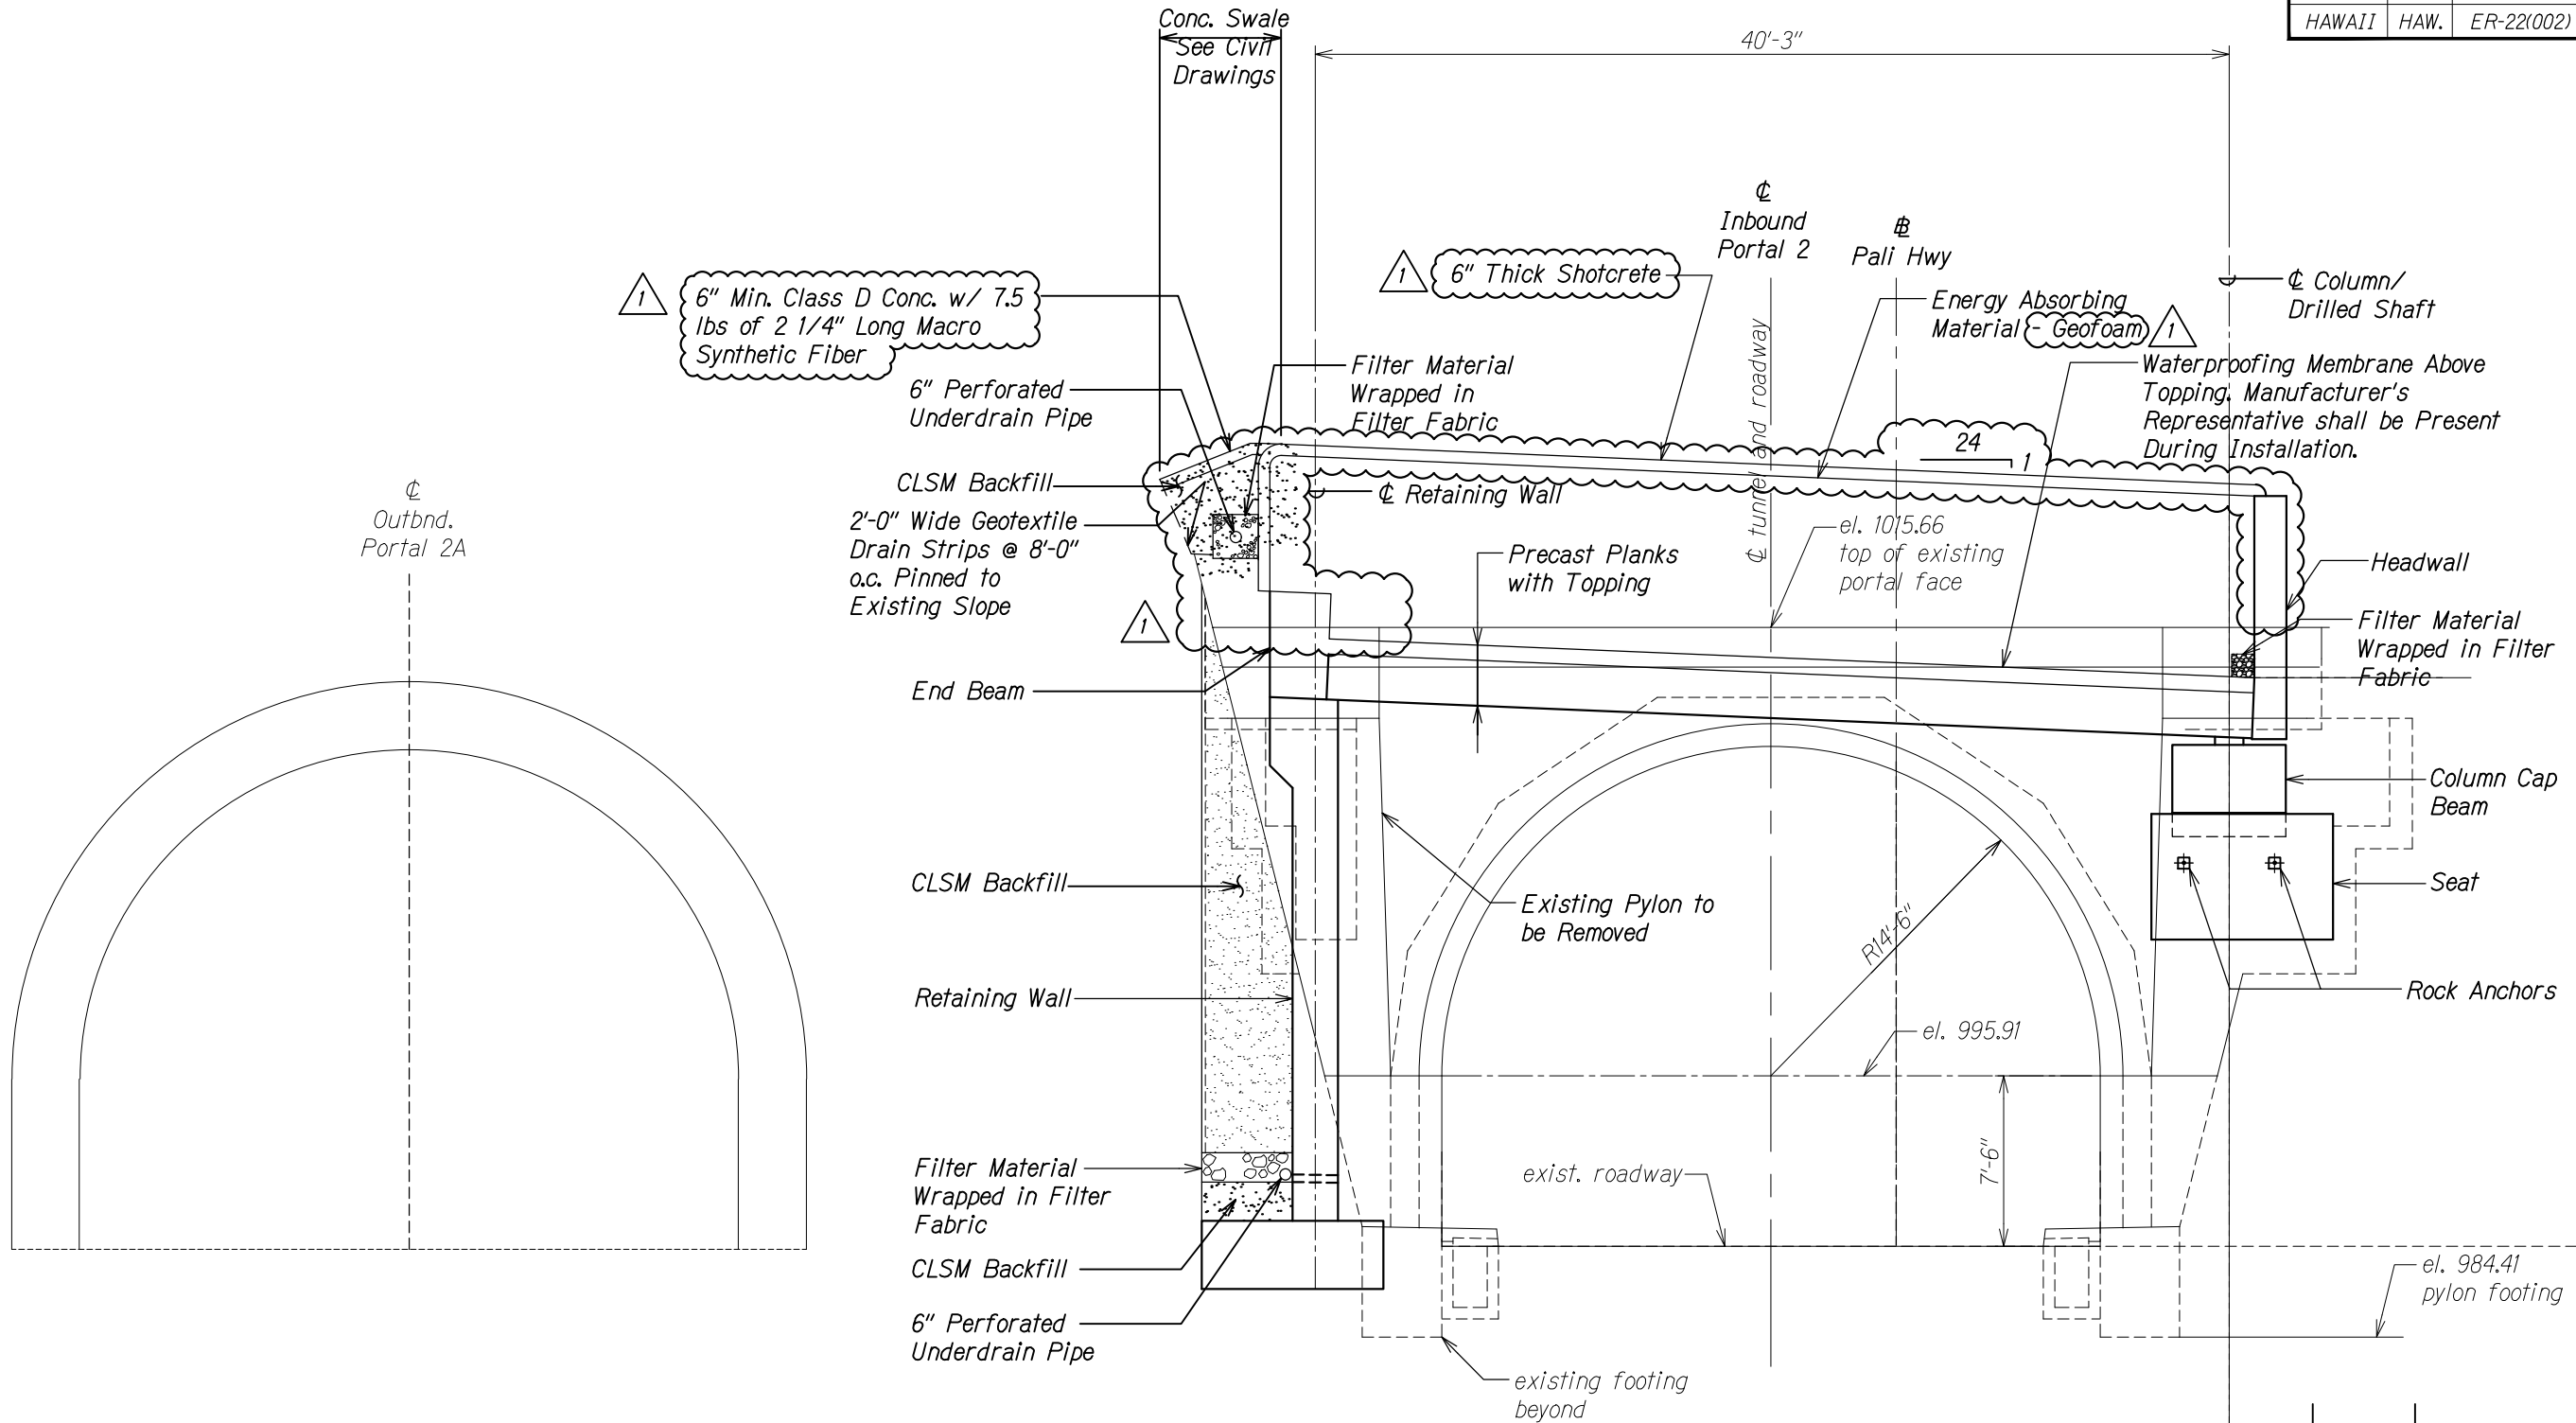


SECTION AT EXISTING PORTAL FACE
Scale: 1/4" = 1'-0"



5/24/19	1 Revised section
DATE	REVISION
STATE OF HAWAII DEPARTMENT OF TRANSPORTATION HIGHWAYS DIVISION SECTION AT EXISTING PORTAL FACE PALI HIGHWAY LANDSLIDE MITIGATION PROJECT FAP Proj. No. ER-22(002) Scale: As Noted Date: May 6, 2019 SHEET No. S3.2 OF 3 SHEETS	

FED. ROAD DIST. NO.	STATE	FEDERAL AID PROJ. NO.	FISCAL YEAR	SHEET NO.	TOTAL SHEETS
HAWAII	HAW.	ER-22(002)	2019	ADD 40	94

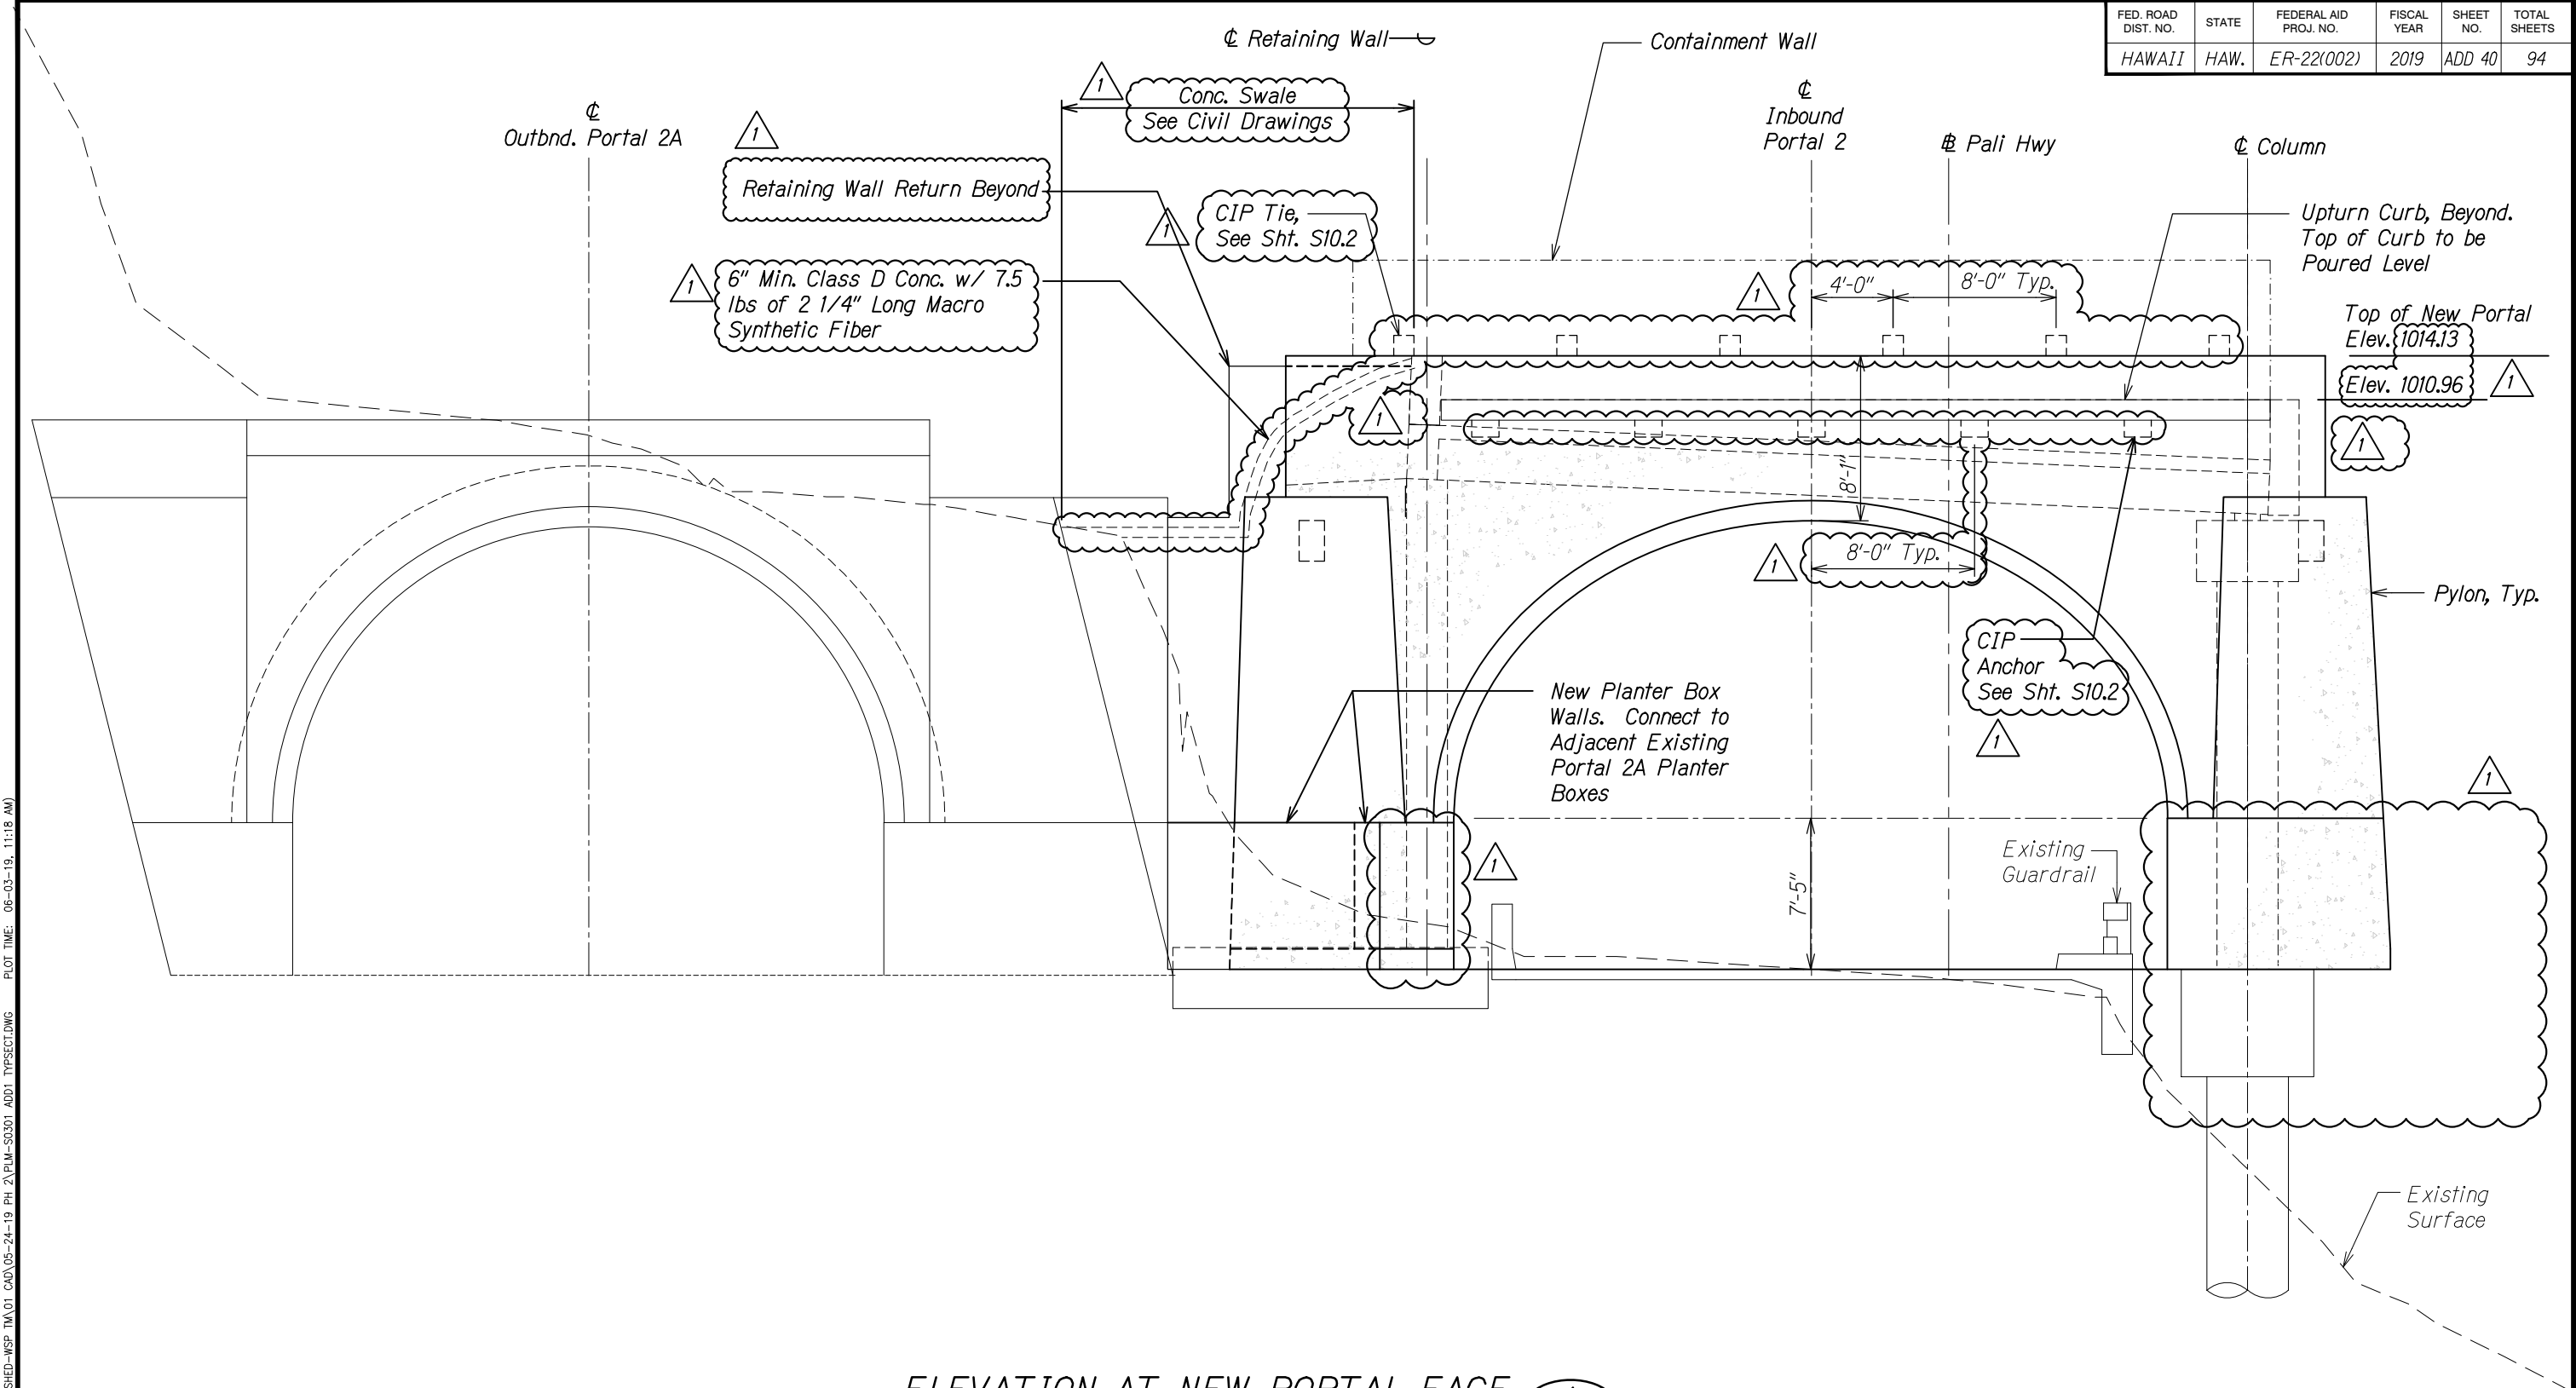

ELEVATION AT NEW PORTAL FACE A
 Scale: 1/4" = 1'-0" S3.3 S3.3

ORIGINAL PLAN	SURVEY PLOTTED BY	DATE
NOTE BOOK	DESIGNED BY	
	QUANTITIES BY	
	CHECKED BY	

DRAWING NAME: Z:\00 ONGOING\19-014.1 PALI ROOF SHED-WSP TIA\01 CAD\05-24-19 PH 2\PLM-S0301 ADD1 TYPSEC1.DWG PLOT TIME: 06-03-19, 11:18 AM

5/24/19	1 Added CIP Tie & Anchor
DATE	REVISION


STATE OF HAWAII
DEPARTMENT OF TRANSPORTATION
HIGHWAYS DIVISION



SECTION
AT NEW PORTAL FACE
PALI HIGHWAY
LANDSLIDE MITIGATION PROJECT
FAP Proj. No. ER-22(002)

Scale: As Noted
SHEET No. S3.3 OF 3 SHEETS

Date: May 6, 2019

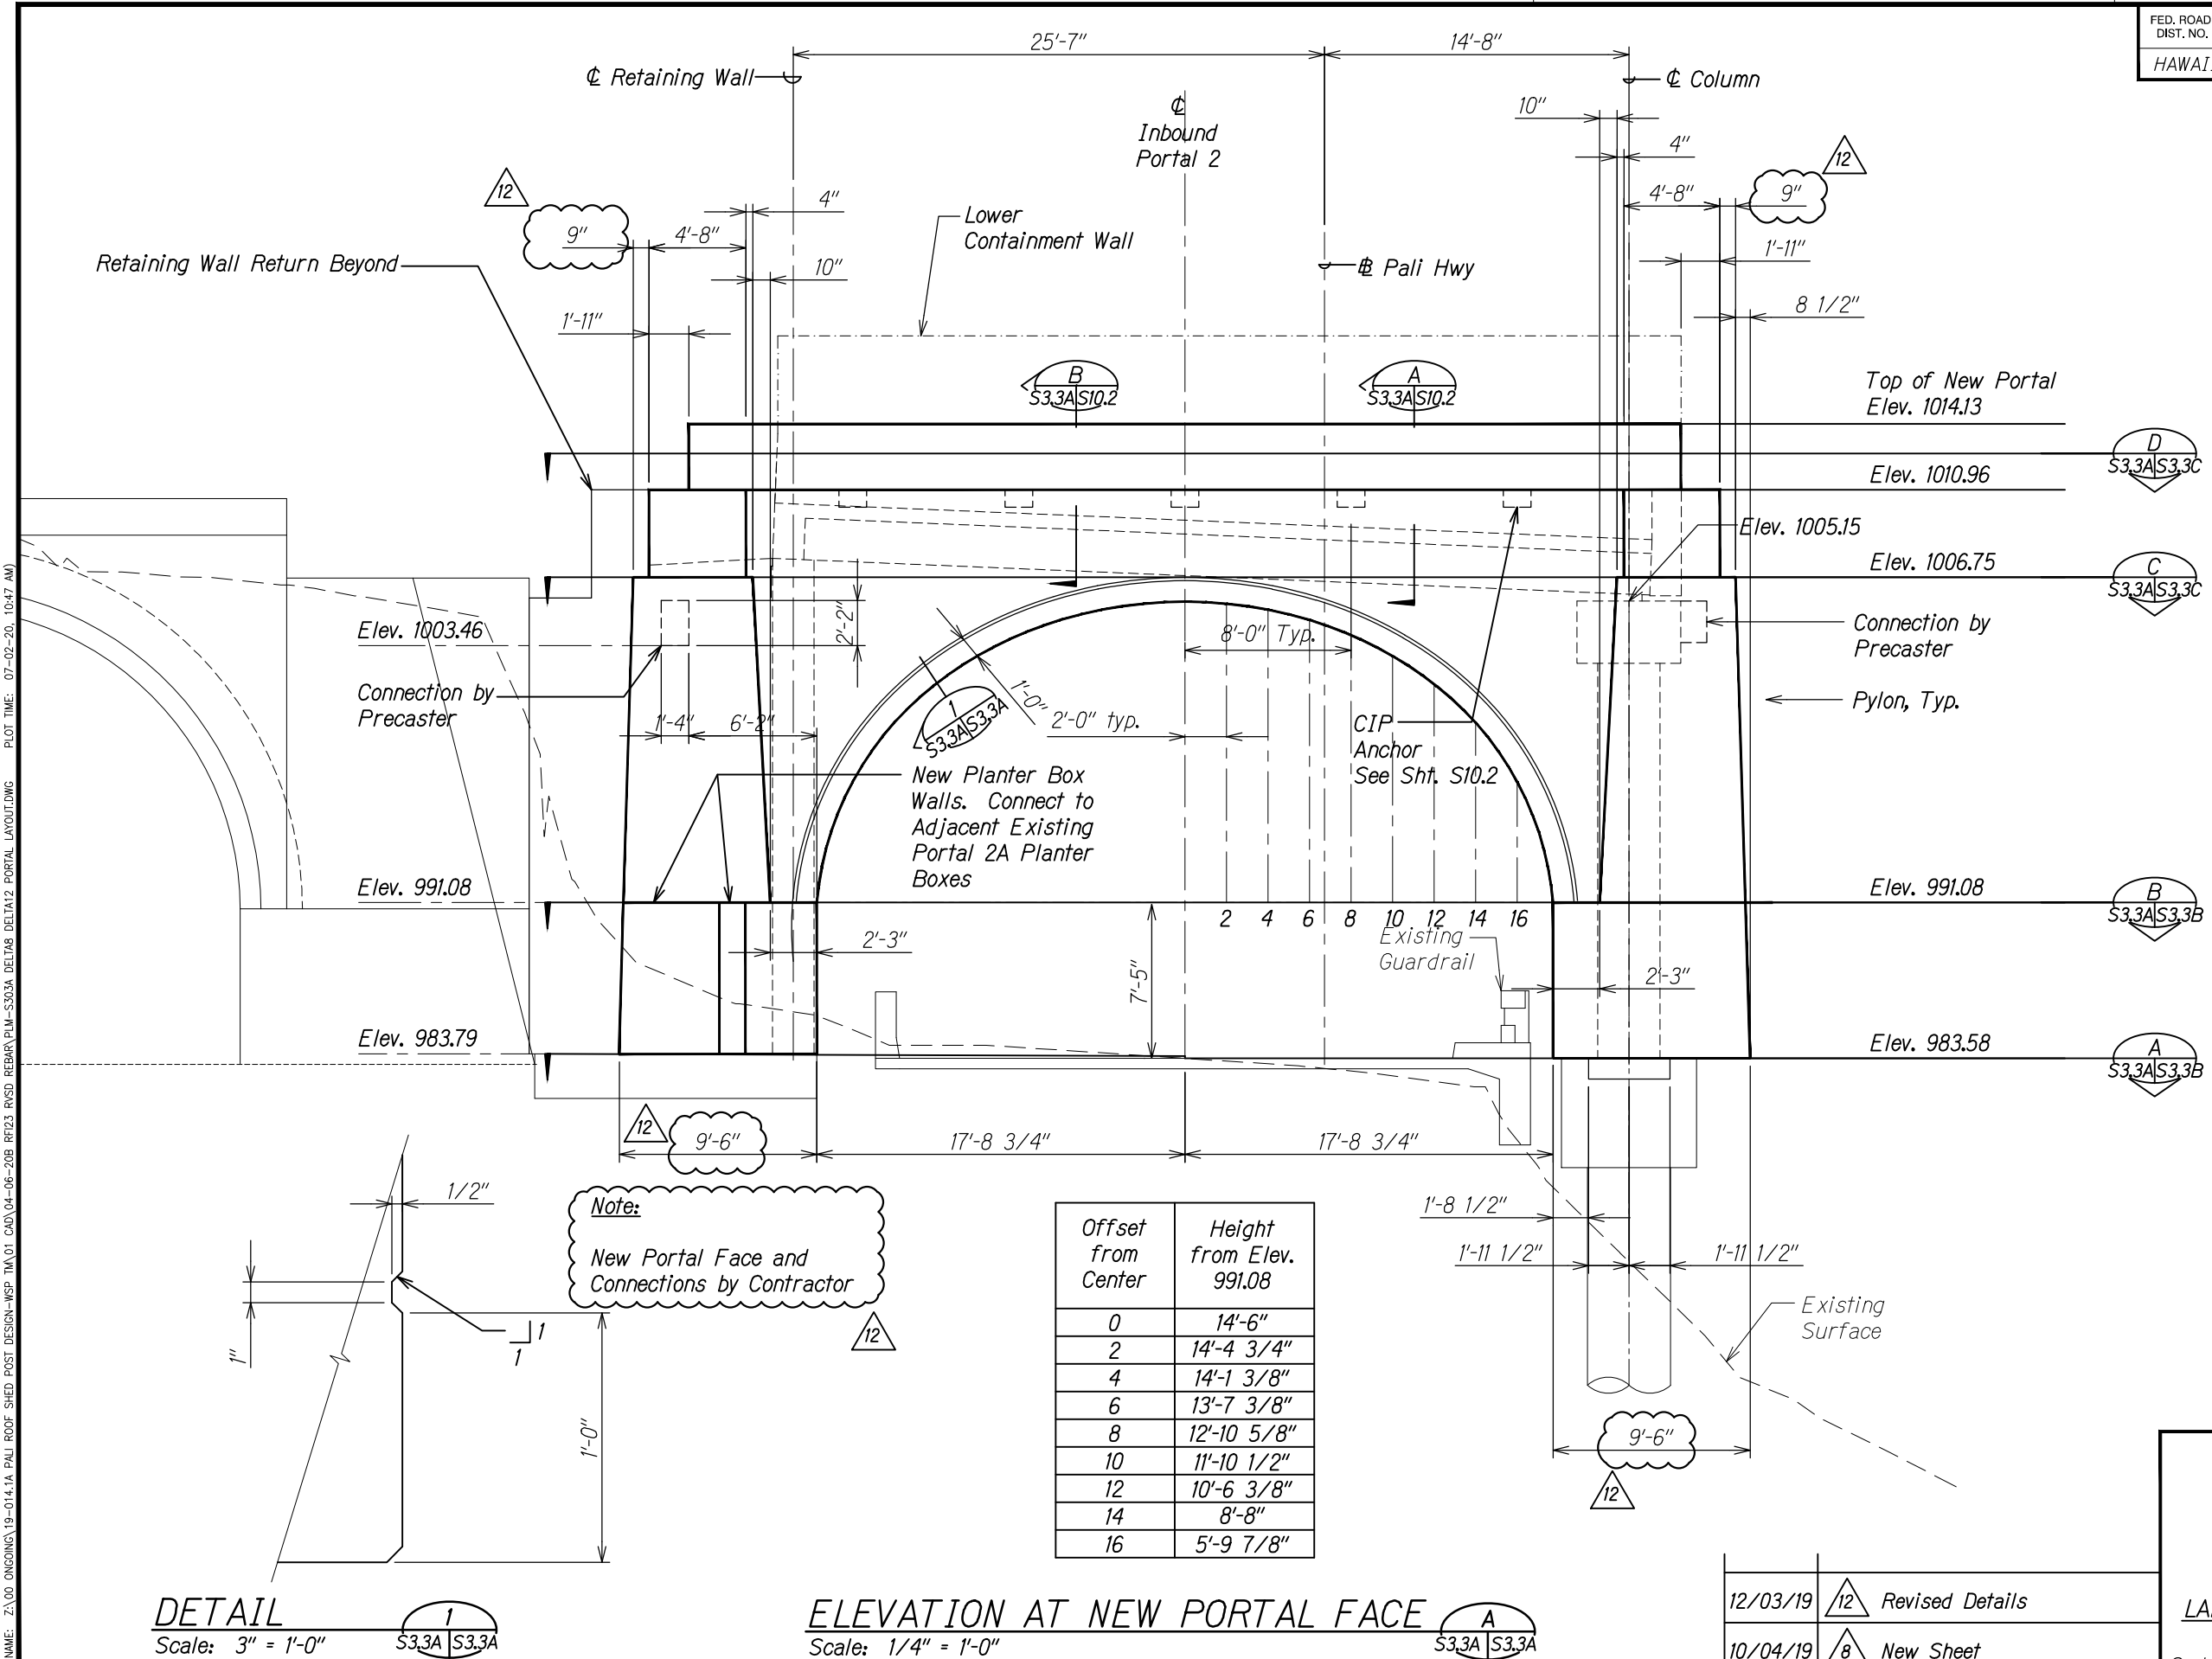FED. ROAD DIST. NO.	STATE	FEDERAL AID PROJ. NO.	FISCAL YEAR	SHEET NO.	TOTAL SHEETS
HAWAII	HAW.	ER-22(002)	2019	40S-1	94





12/03/19	 Revised Details
10/04/19	 New Sheet
DATE	REVISION

STATE OF HAWAII
DEPARTMENT OF TRANSPORTATION
HIGHWAYS DIVISION
SECTION
AT NEW PORTAL FACE
PALI HIGHWAY
LANDSLIDE MITIGATION PROJECT
FAP Proj. No. ER-22(002)

Scale: As Noted Date: May 6, 2019

SHEET No. S3.3A OF 3 SHEETS

FED. ROAD DIST. NO.	STATE	FEDERAL AID PROJ. NO.	FISCAL YEAR	SHEET NO.	TOTAL SHEETS
HAWAII	HAW.	ER-22(002)	2019	40S-2	94

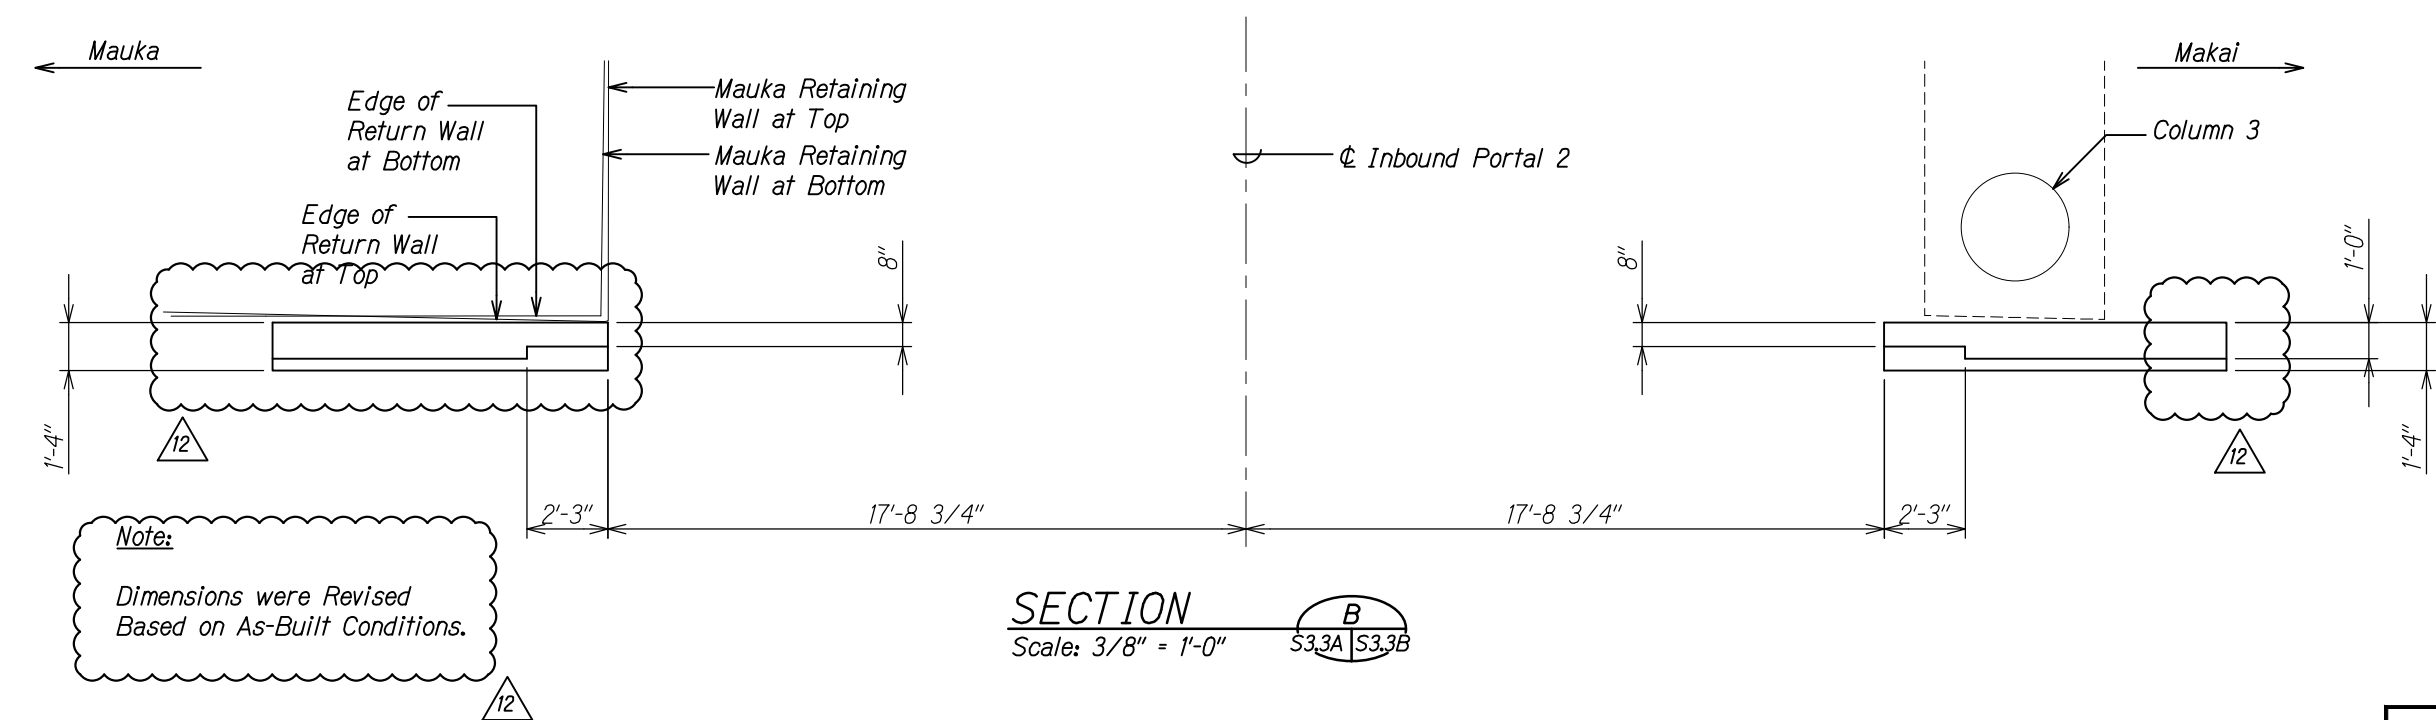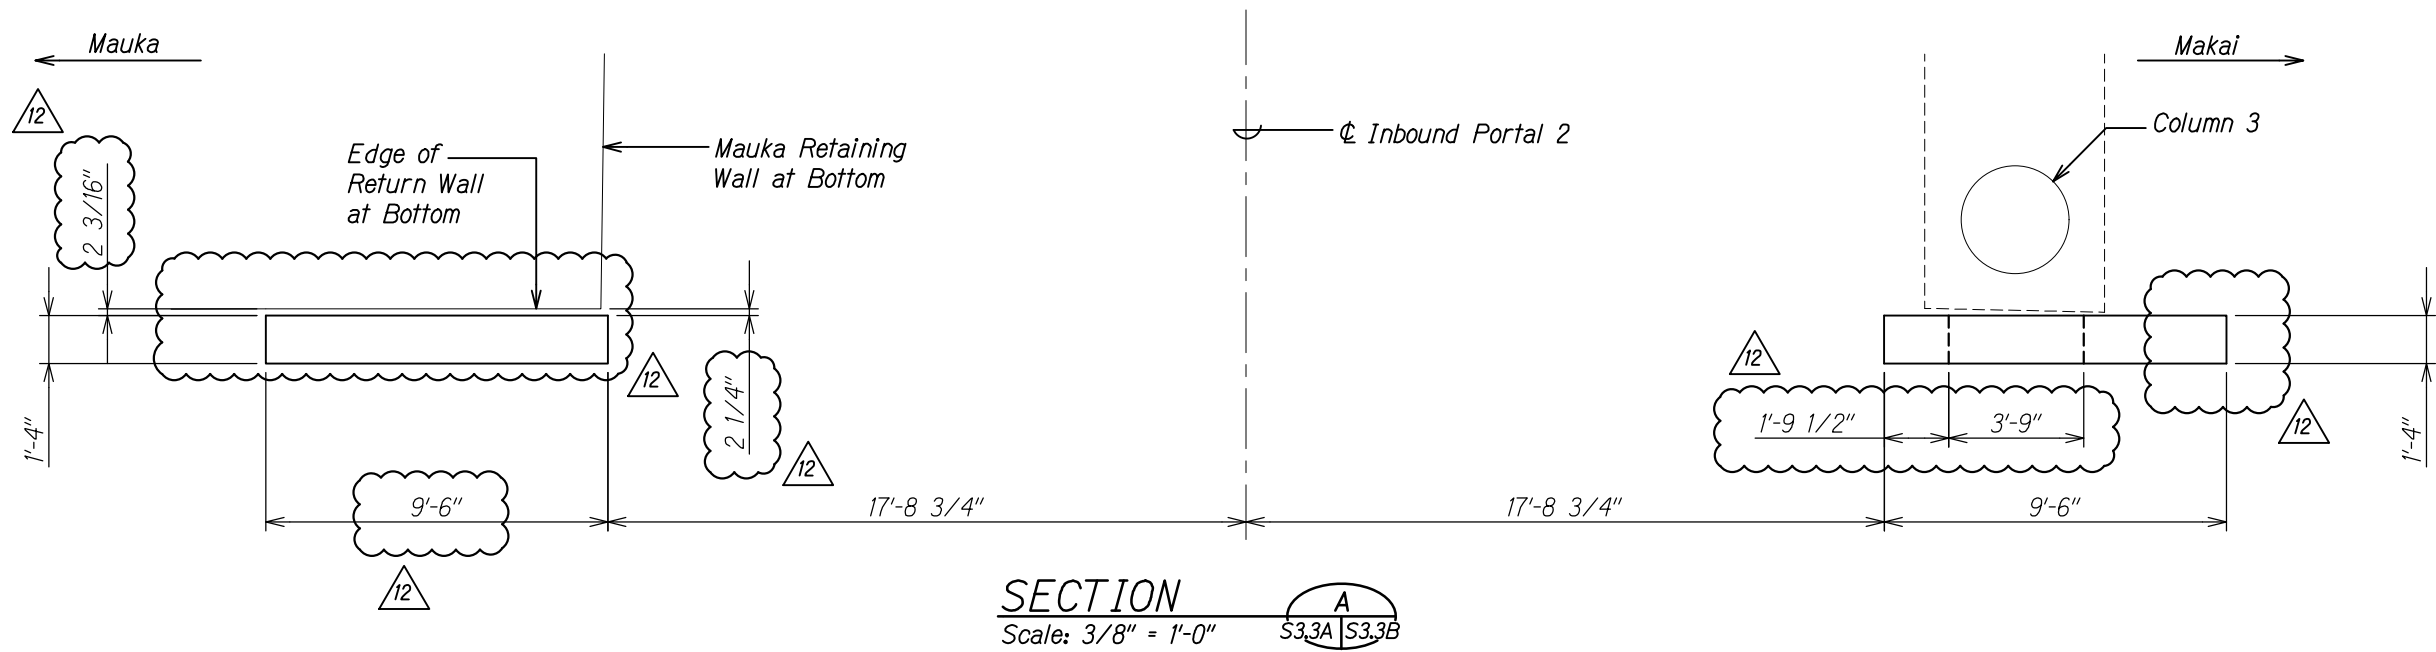

Note:
Dimensions were Revised
Based on As-Built Conditions.

ORIGINAL PLAN	DATE
DESIGNED BY	DATE
TRACED BY	DATE
DESIGNED BY	DATE
QUANTITIES BY	DATE
CHECKED BY	DATE

12/03/19	12 Revised Details
10/04/19	8 New sheet
DATE	REVISION

STATE OF HAWAII
DEPARTMENT OF TRANSPORTATION
HIGHWAYS DIVISION



SECTION
AT NEW PORTAL FACE

PALI HIGHWAY
LANDSLIDE MITIGATION PROJECT
FAP Proj. No. ER-22(002)

Scale: As Noted Date: May 6, 2019

SHEET No. S3.3B OF 3 SHEETS

FED. ROAD DIST. NO.	STATE	FEDERAL AID PROJ. NO.	FISCAL YEAR	SHEET NO.	TOTAL SHEETS
HAWAII	HAW.	ER-22(002)	2019	40S-3	94

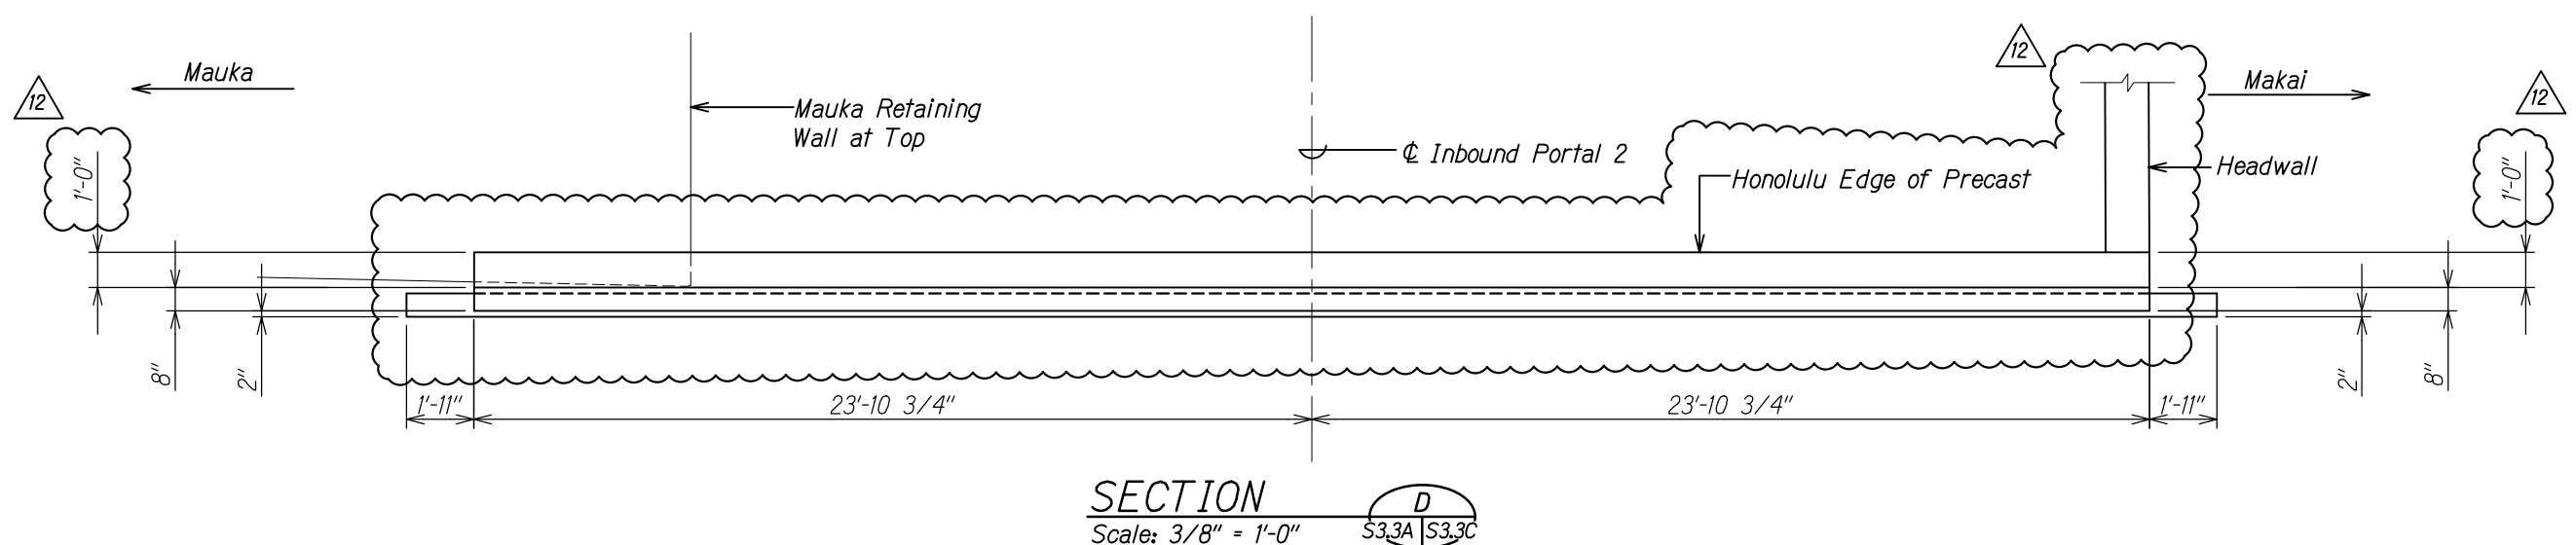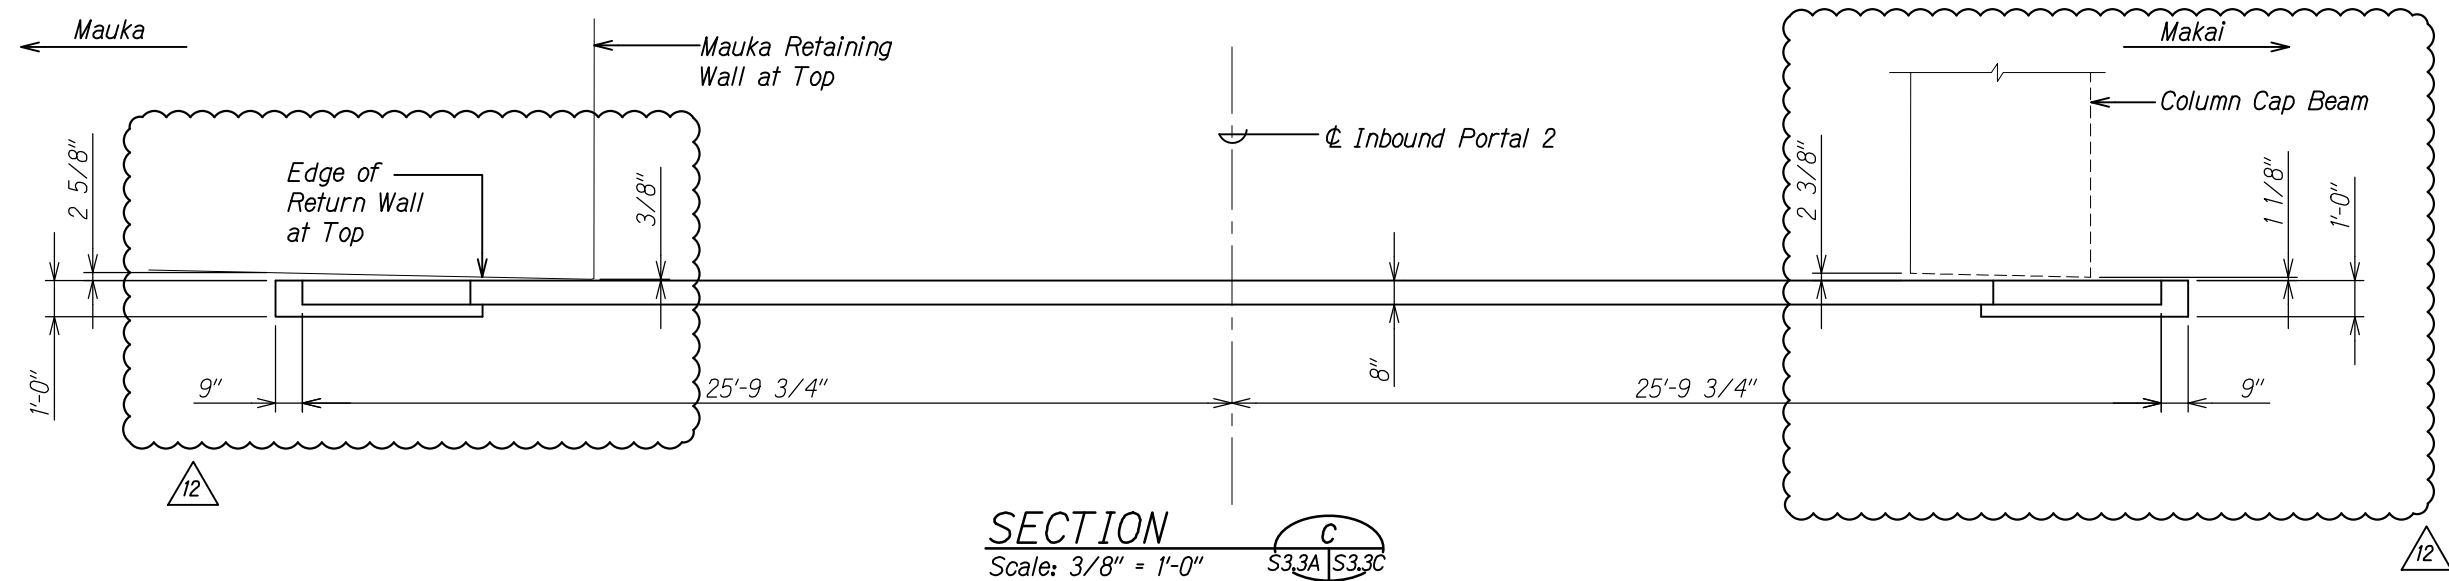

Note:
Dimensions were Revised
Based on As-Built Conditions.

ORIGINAL PLAN	DATE
NO. 1	
NO. 2	
NO. 3	
NO. 4	
NO. 5	
NO. 6	
NO. 7	
NO. 8	
NO. 9	
NO. 10	

12/03/19	12	Revised Details
10/04/19	8	New sheet
DATE		REVISION

STATE OF HAWAII
DEPARTMENT OF TRANSPORTATION
HIGHWAYS DIVISION

SECTION
AT NEW PORTAL FACE

PALI HIGHWAY
LANDSLIDE MITIGATION PROJECT
FAP Proj. No. ER-22(002)

Scale: As Noted Date: May 6, 2019

SHEET No. S3.3C OF 3 SHEETS