


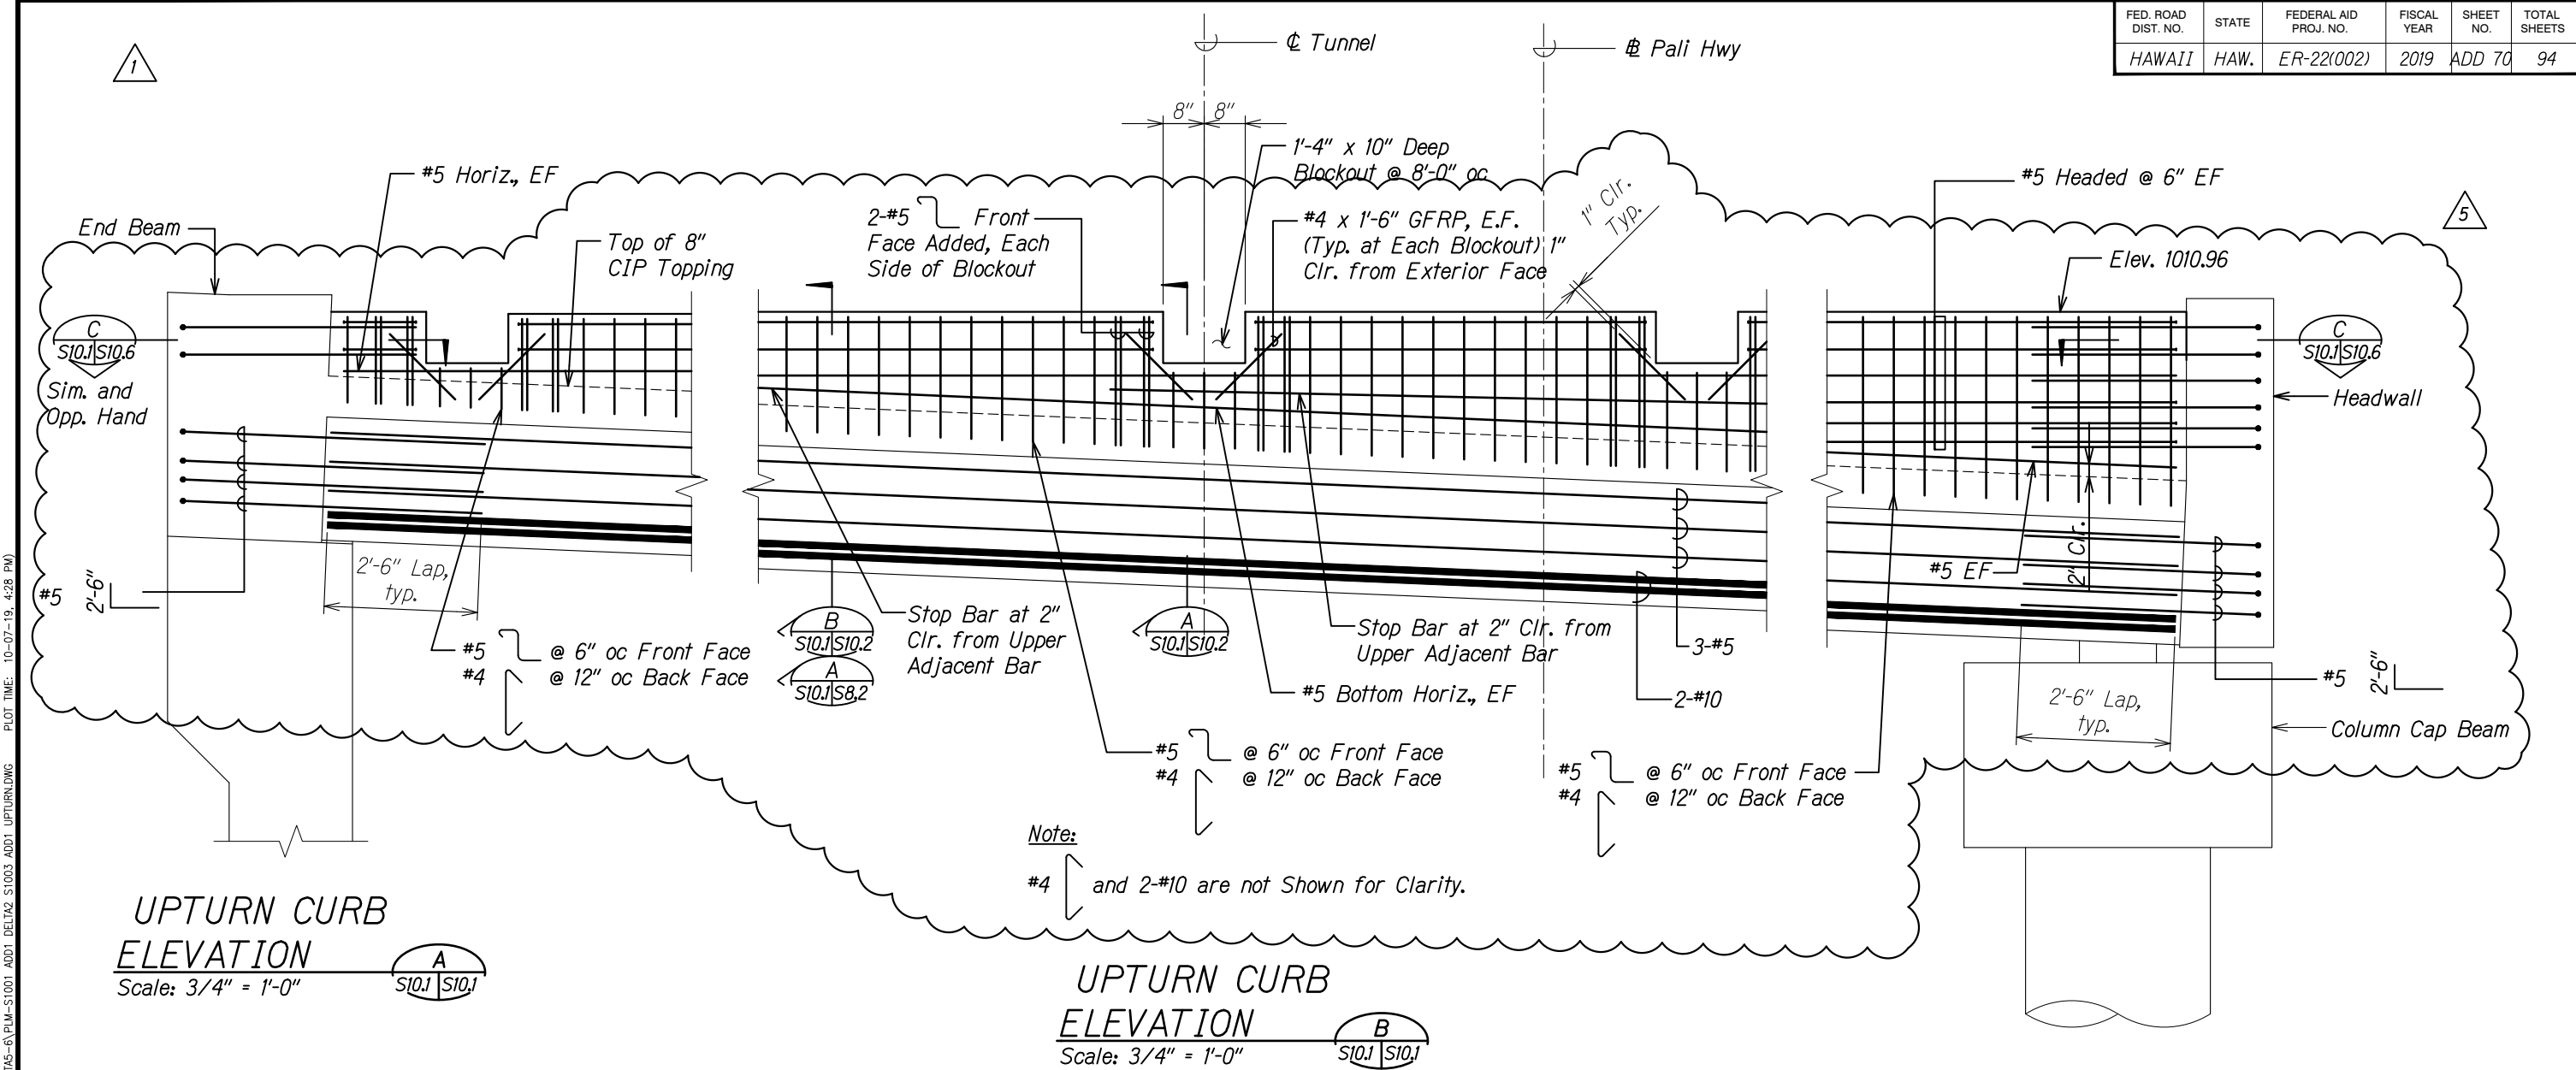

FED. ROAD DIST. NO.	STATE	FEDERAL AID PROJ. NO.	FISCAL YEAR	SHEET NO.	TOTAL SHEETS
HAWAII	HAW.	ER-22(002)	2019	ADD 70	94

DRAWING NAME: Z:\00 ONGOING\19-014\1A PALI HIGHWAY SHED POST DESIGN-WSP TMA\01 CAD\10-07-19 UPDATE DELTAS-6\PLM-S1001 ADD1 DELTAS S1003 ADD1 UPTURN.DWG PLOT TIME: 10-07-19, 4:28 PM



ORIGINAL PLAN	DATE
NO.	

8/06/19		<i>Revised Sections</i>
5/24/19		<i>Revised Sections</i>
DATE	REVISION	

STATE OF HAWAII  
DEPARTMENT OF TRANSPORTATION  
HIGHWAYS DIVISION

**UPTURN CURB ELEVATION**  
**AT NEW PORTAL**  
**PALI HIGHWAY**  
**LANDSLIDE MITIGATION PROJECT**  
**FAP Proj. No. ER-22(002)**

Scale: *As Noted*      Date: *May 6, 2019*

SHEET No. *S10.1* OF 5 SHEETS

FED. ROAD DIST. NO.	STATE	FEDERAL AID PROJ. NO.	FISCAL YEAR	SHEET NO.	TOTAL SHEETS
HAWAII	HAW.	ER-22(002)	2019	71 S-1	94

NOTES:


- Weld detail per AWS D1.4/D1.4M:2011, Fig. 3.2(A).
- Remove portion of reinforcing steel by saw cutting as necessary to provide 1" clear to precast and 1" clear to lower containment wall. (See Detail on this sheet).
- Butt weld rebar segment. Butt weld shall be V-Groove. Joints shall not be offset at weld by more than 1/8 inch. Trim back or shape ends of rebars to be butt welded with a V-Groove by carbon arc, oxyacetylene cutting or sawing. (See Details on sheet 2 of 2).
- Electrodes for manual shielded metal arc welding of ASTM A706 rebars shall conform to ASW 5.5 for E8016G3 or E8018 C3 electrodes.
- Butt weld the new rebar to the exposed existing rebar with a single pass/layer.
- Proceed to the next bar welding a single pass while letting the first welded bars cool off.
- When finished welding the first pass on all new bars, make sure that the first welded bars are cool then proceed with 2nd pass on each bar. Continue this process until weld is complete per structural repair detail. Immediately after completing welding, cover each side of welded joint with insulated wrapping to control rate of cooling. Keep insulated wrapping in place until rebar has cooled to below 200 degrees F or to the touch.
- Electrodes to be furnished in hermetically sealed containers or dry for two hours at 450 degrees F to 500 degrees F before use. Immediately after removal from hermetically sealed containers or drying ovens, store electrodes in ovens held at temperatures of at least 250 degrees F. Redry electrodes not in use within 4 hours after removal from hermetically sealed containers or from drying ovens.
- Do not weld in inclement or wet weather unless protection accepted by the engineer is provided.
- Preheating or post heating of ASTM A706 rebars in weld area is not required.
- Tack welding for alignment purposes will be allowed when tack weld will be consumed by subsequent weld.
- All butt welds will be special inspected. Completed welds shall be nondestructive tested per section 602 of the specification in note 17. Welds shall show no sign of cracks, lack of fission, under cutting, excessive piping, porosity or inadequate size.
- All butt welds shall be made by certified welders qualified for butt welding #4 and #5 rebars.
- Completed butt weld joints shall develop not less than the specified tensile strength of the rebar.

- Qualify butt welded rebar joint splice with job control tests on sample joint splice per section 602 of the specification in note 17. Welded butt joint in reinforcing steel shall be complete joint penetration butt welds conforming to requirements of AWS D1.4 Figure 3.2(A) Single V-Groove weld.

Job control tests: Sample joint splice shall consist of splice made at the job site to connect two 30 inch long minimum length bars, using same rebar size, material, splice material, position, location and equipment and following same procedures as are being used to make joint splices in the work. Make and test sample joint splice in the presence of the special inspector and perform nondestructive test on completed weld.


Perform nondestructive test on joint splices by radiographic examination of completed joint penetration butt welded joints. Welds found to be defective shall be repaired in accordance with requirements of AWS D1.4.

- Maximum stringer bead width shall be 2.5 times electrode diameter. Perform slagging between each weld pass. Weld reinforcement shall not exceed 1/8 inch in convexity.

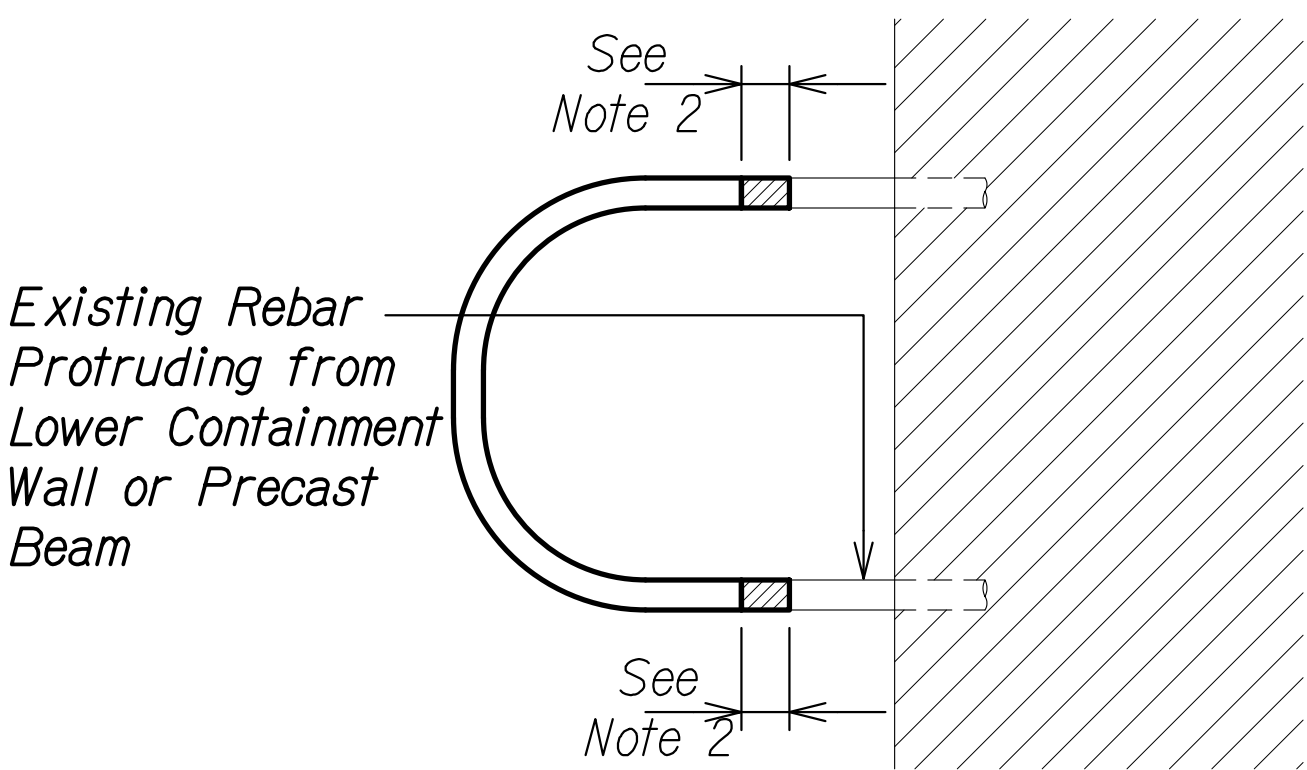


REBAR ALTERATION DETAIL

Scale: 3" = 1'-0"

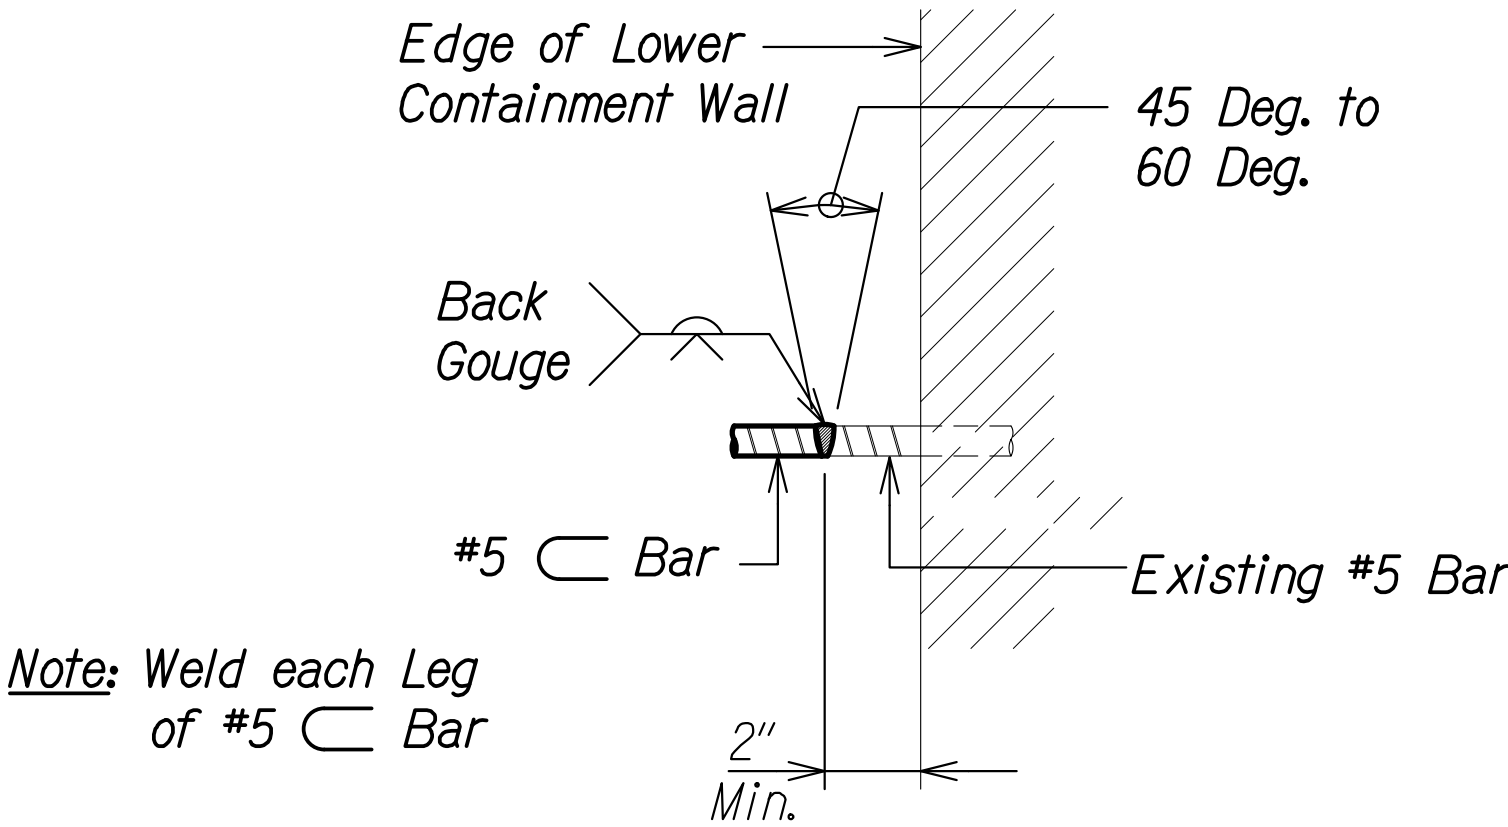

SIDE VIEW OF LOWER CONTAINMENT WALL

Scale: 3" = 1'-0"

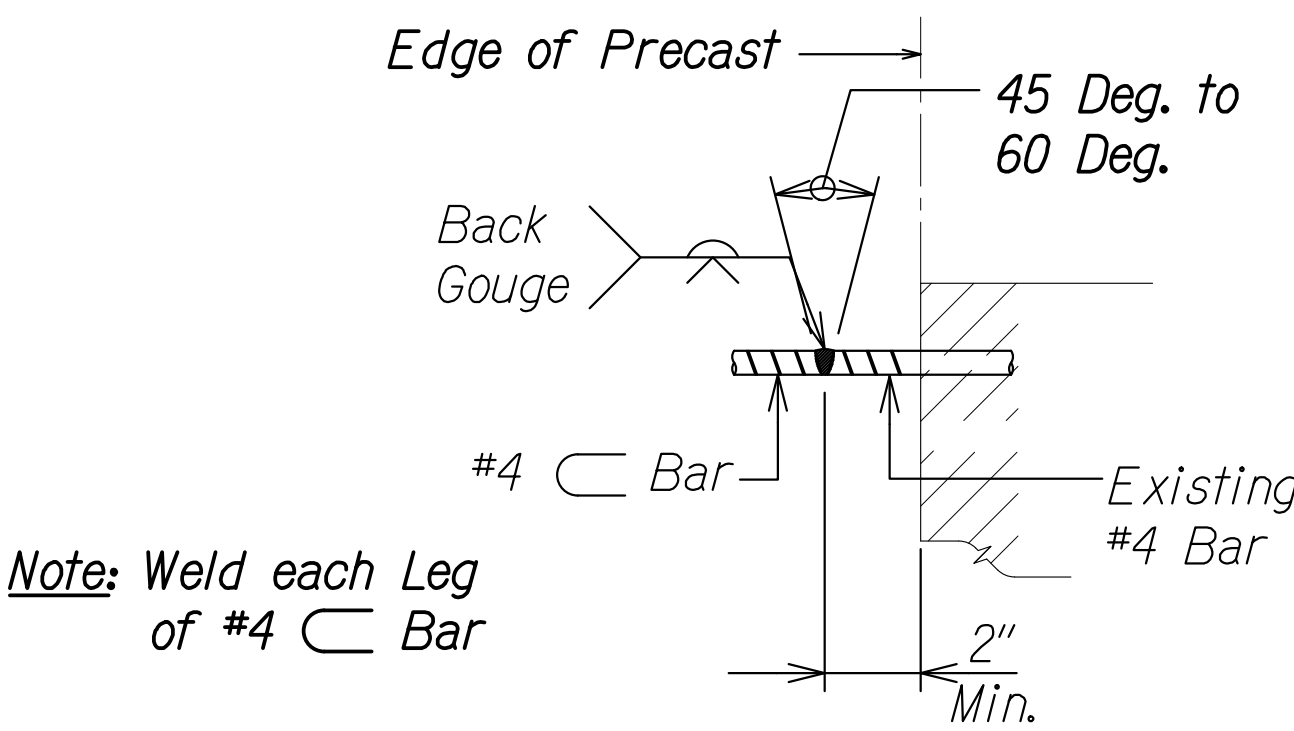

SIDE VIEW OF PRECAST

Scale: 3" = 1'-0"

STATE OF HAWAII DEPARTMENT OF TRANSPORTATION HIGHWAYS DIVISION	
<b>PRECAST PORTAL AND LOWER CONTAINMENT WALL REBAR ALTERATION</b>	
<b>PALI HIGHWAY LANDSLIDE MITIGATION PROJECT FAP Proj. No. ER-22(002)</b>	
Scale: As Noted	Date: May 6, 2019
SHEET No. S10.2A OF 5 SHEETS	

ORIGINAL PLAN	SURVEY PLOTTED BY	DATE
NOTE BOOK	DRAWN BY	
No.	DESIGNED BY	
	QUANTITIES BY	
	CHECKED BY	





DRAWING NAME: Z:\00 ONGOING\19-014.1A PALI ROOF SHED POST DESIGN-WSP.TIA\01 CAD\04-01-21 AS-BUILT RVSD S1002A.PLM-S1002 S1004 ADD1 DELTA 5 UPTURN ASB.DWG PLOT TIME: 05-04-21, 1:43 PM

"AS-BUILT"

71 S-1

FED. ROAD DIST. NO.	STATE	FEDERAL AID PROJ. NO.	FISCAL YEAR	SHEET NO.	TOTAL SHEETS
HAWAII	HAW.	ER-22(002)	2019	ADD 71	94


DRAWING NAME: Z:\00 ONGOING\19-0141A PALI ROOF SHED POST DESIGN-WSP.TIA\01 CAD\04-01-21 AS-BUILT\PLM-S1002-S1004 ADD1 DELTA 5 UPTURN AS-BUILDING PLOT TIME: 04-01-21, 3:40 PM

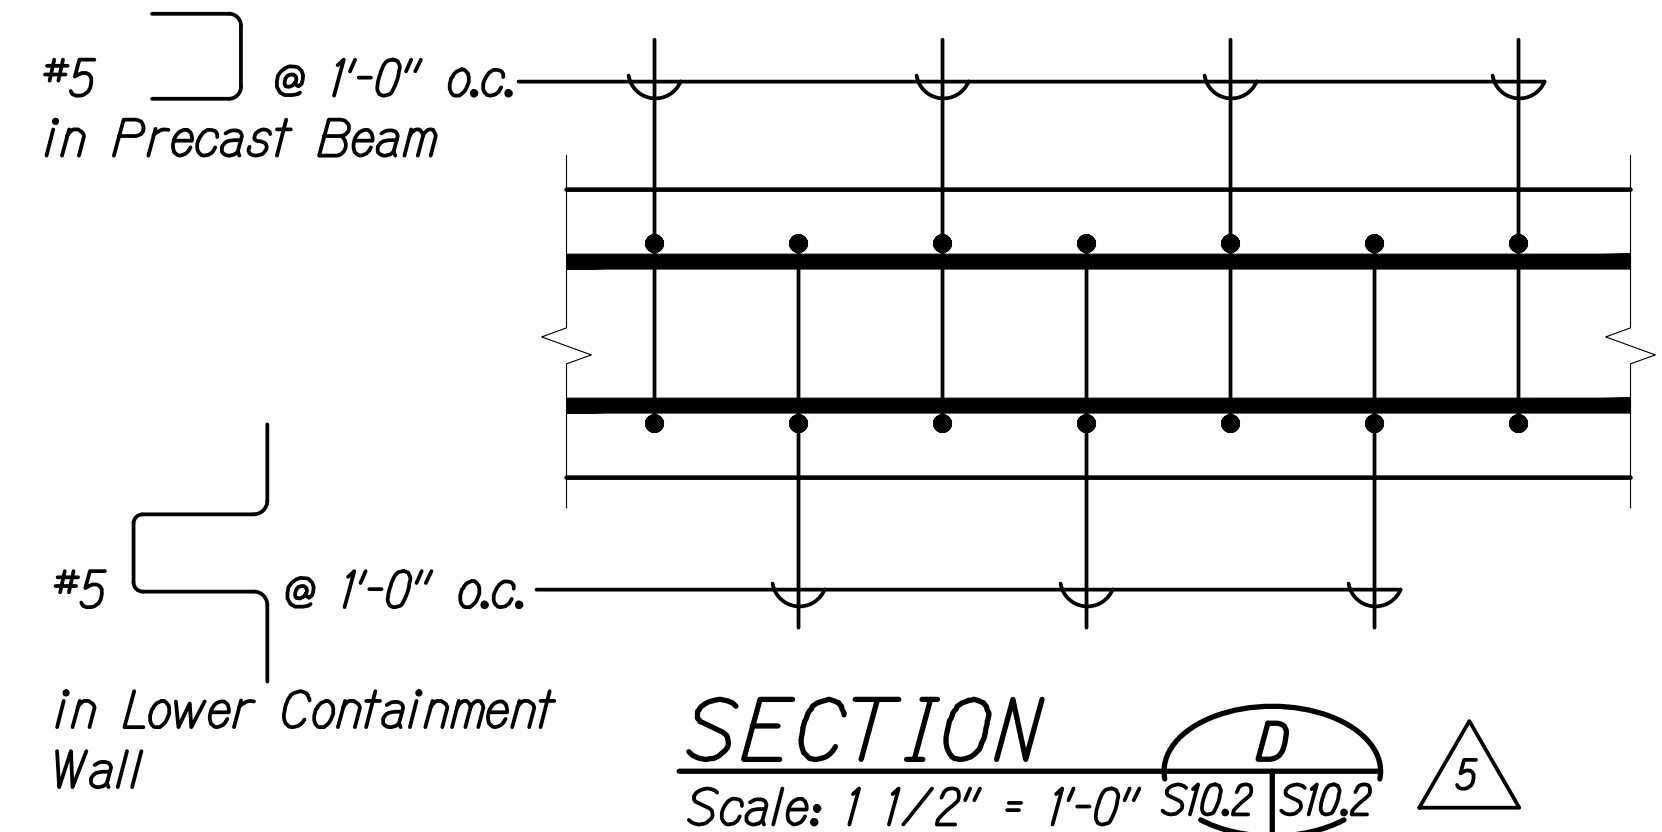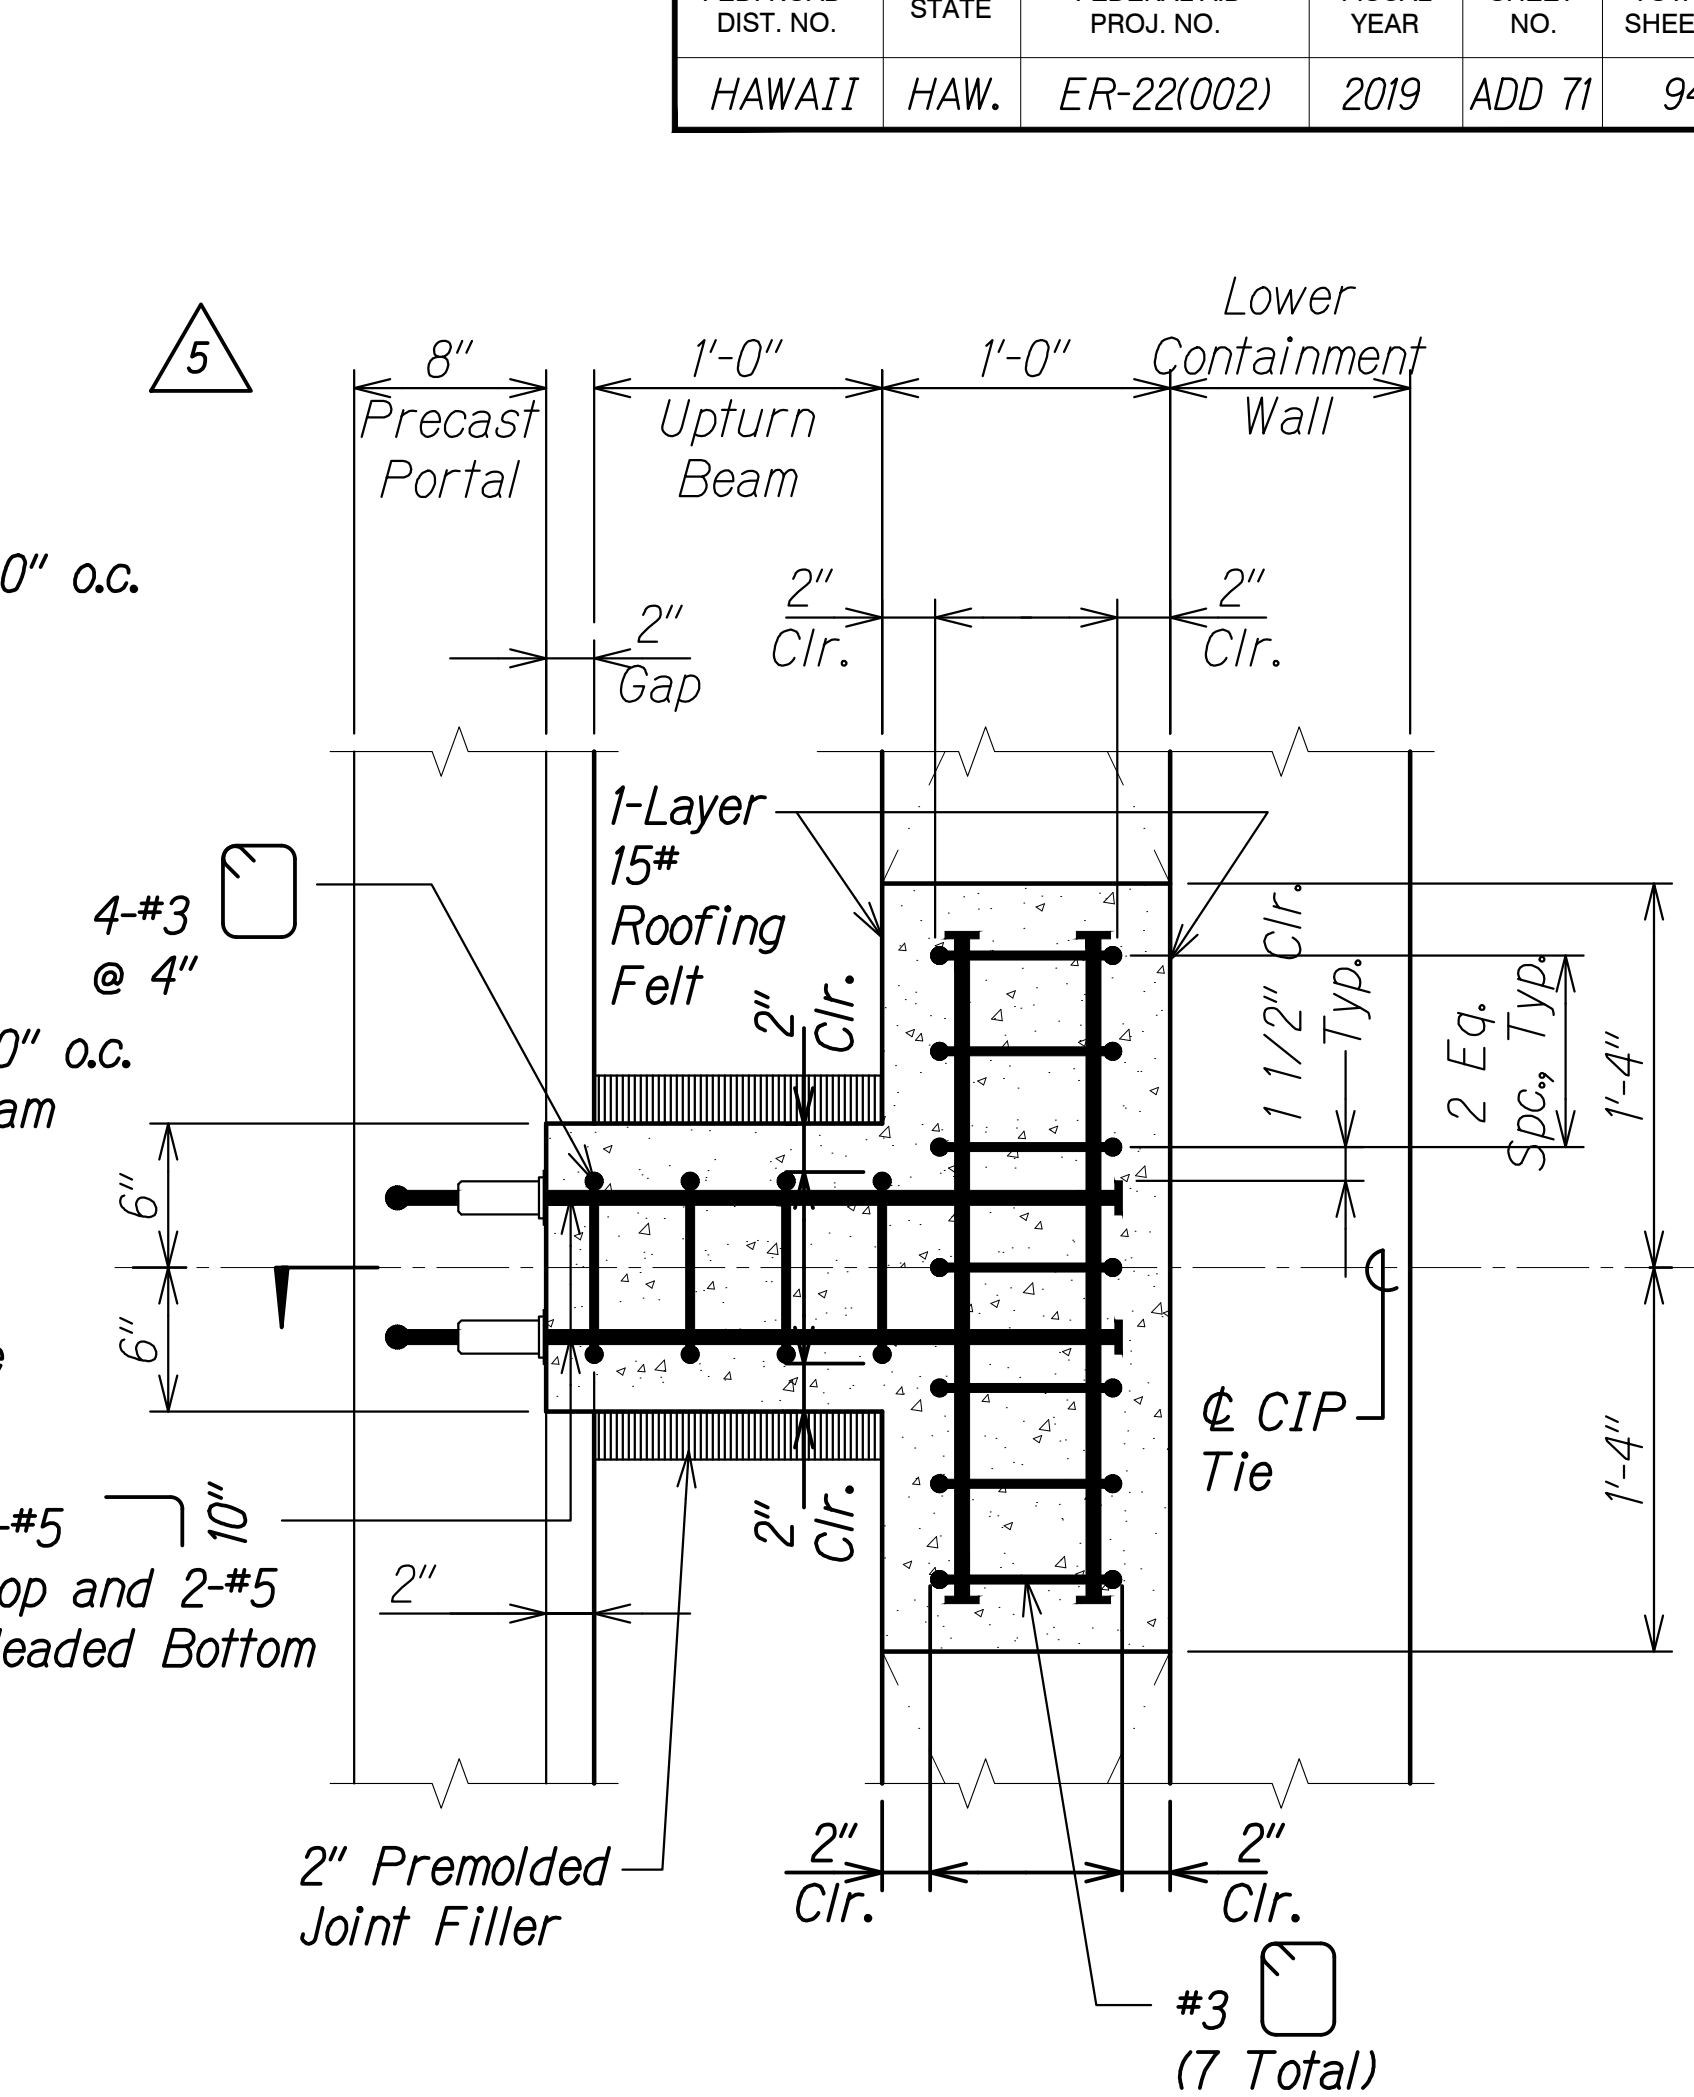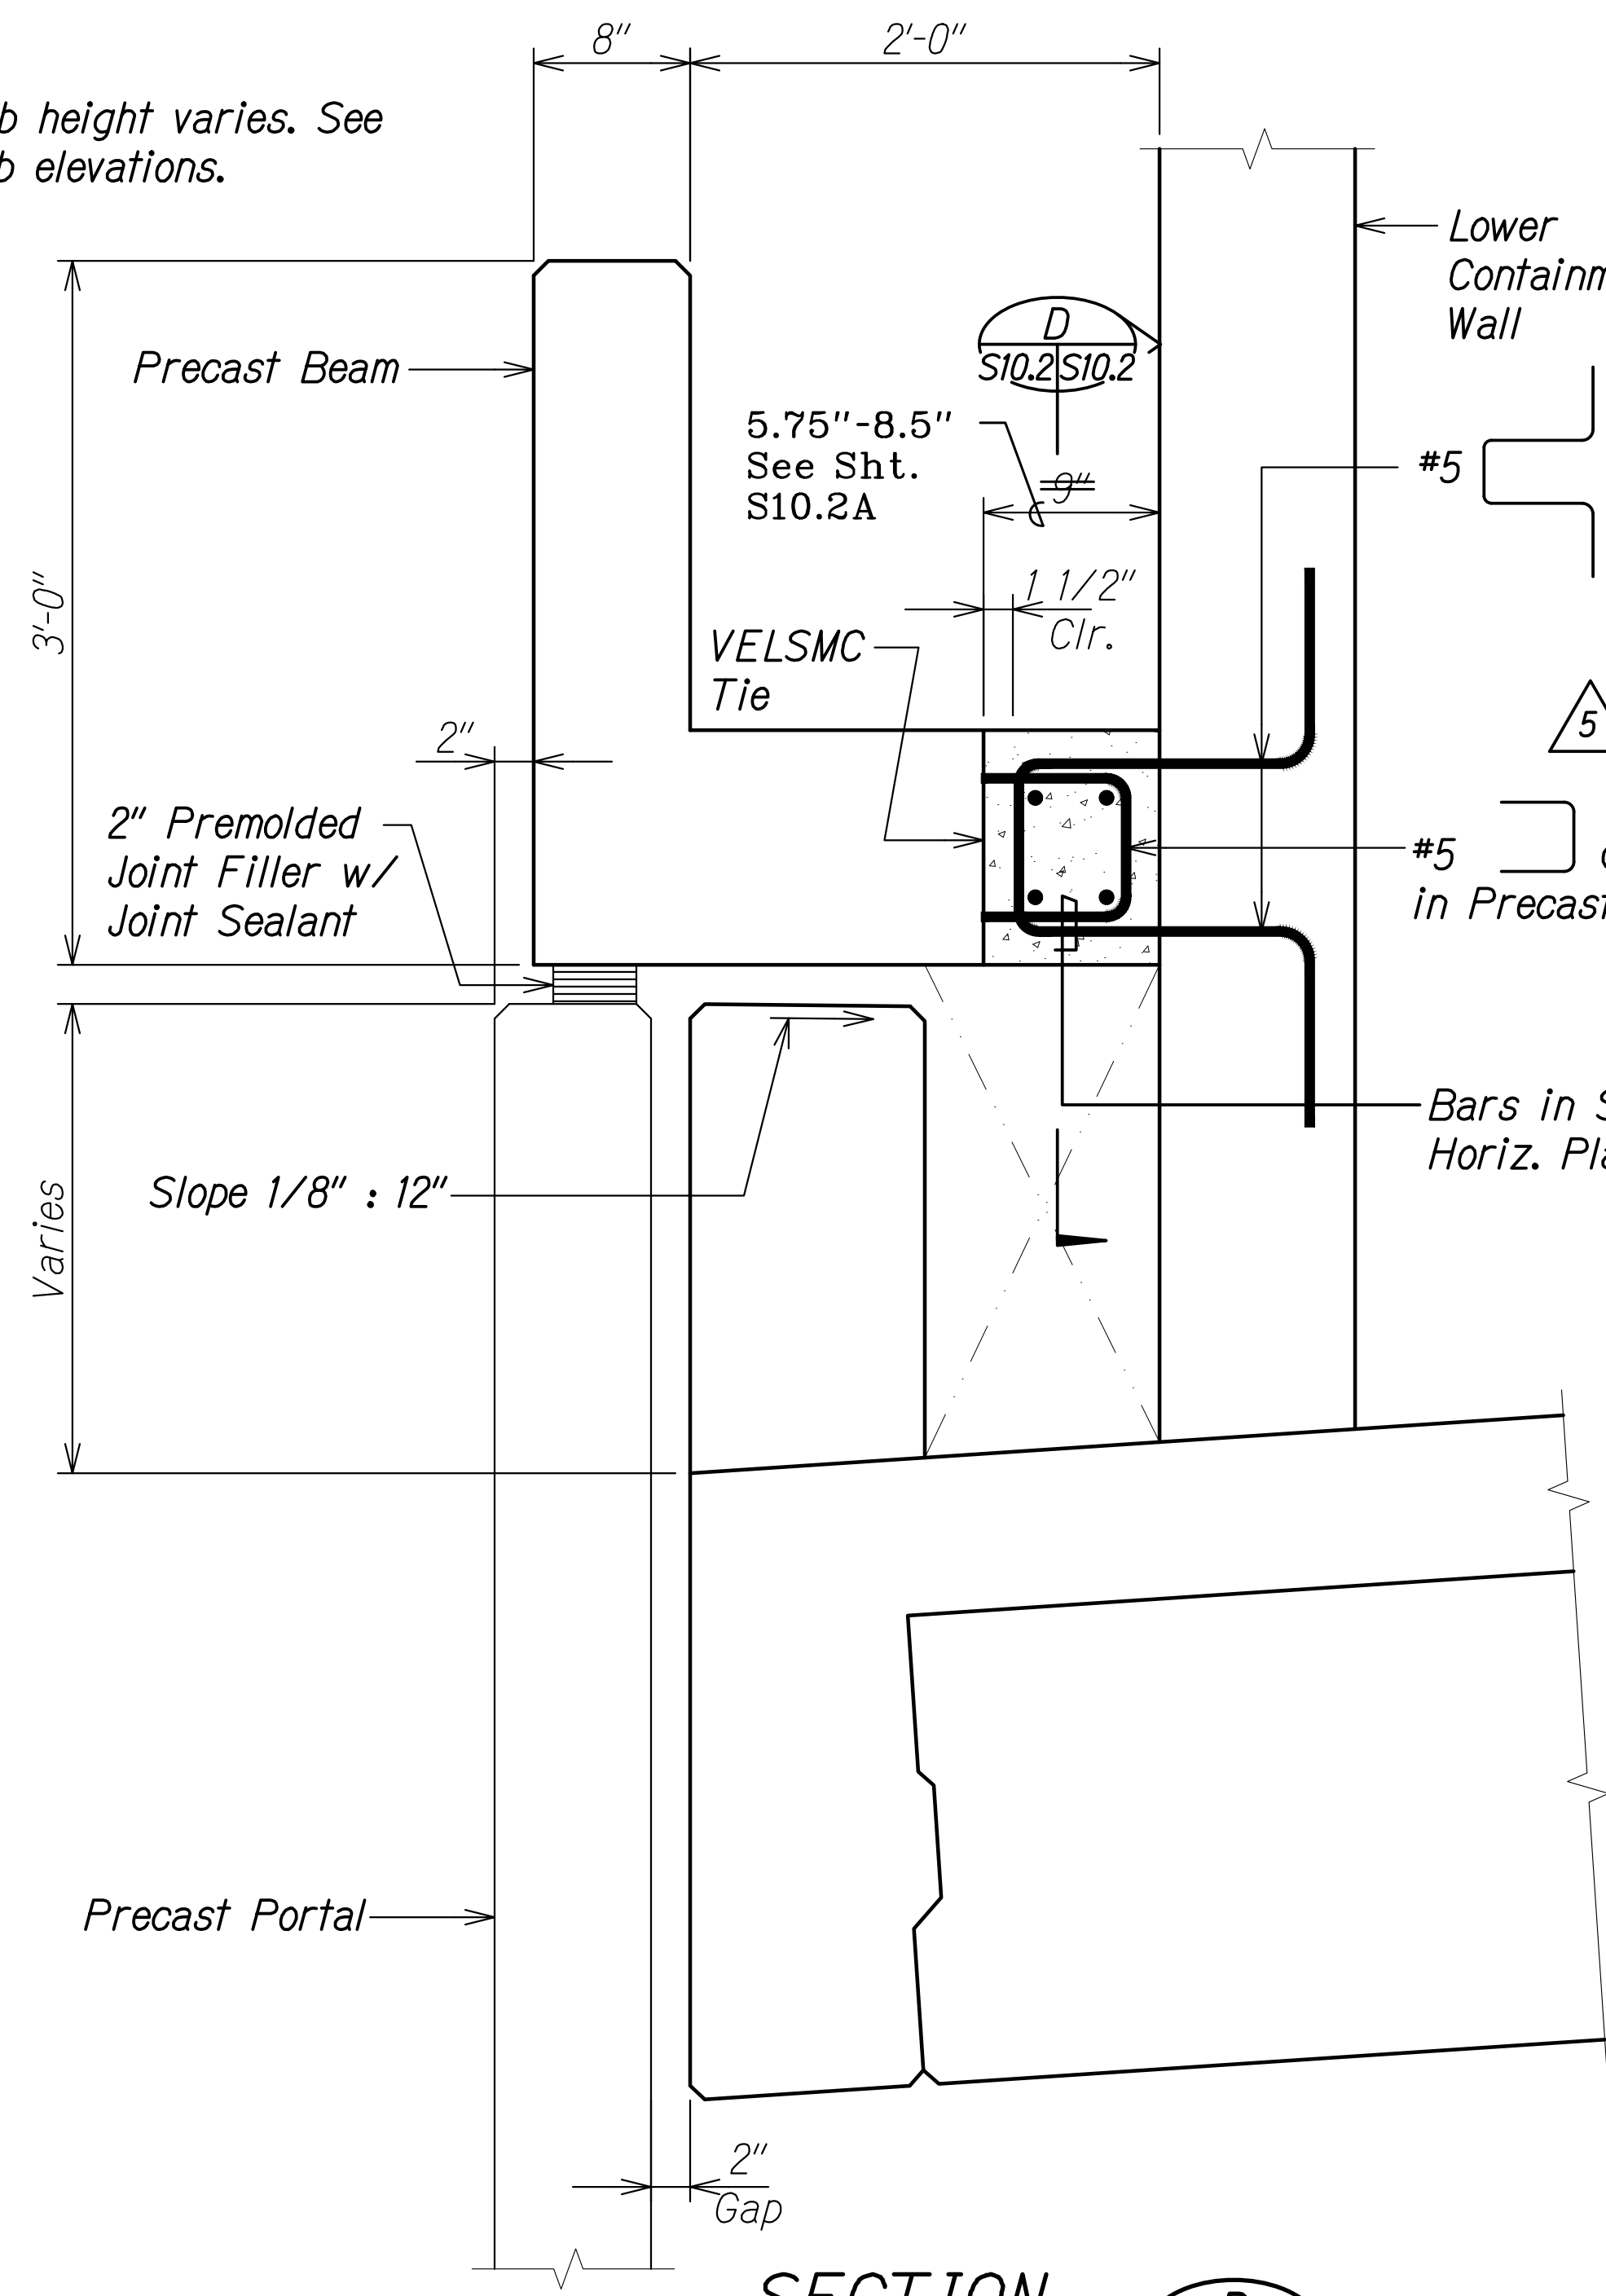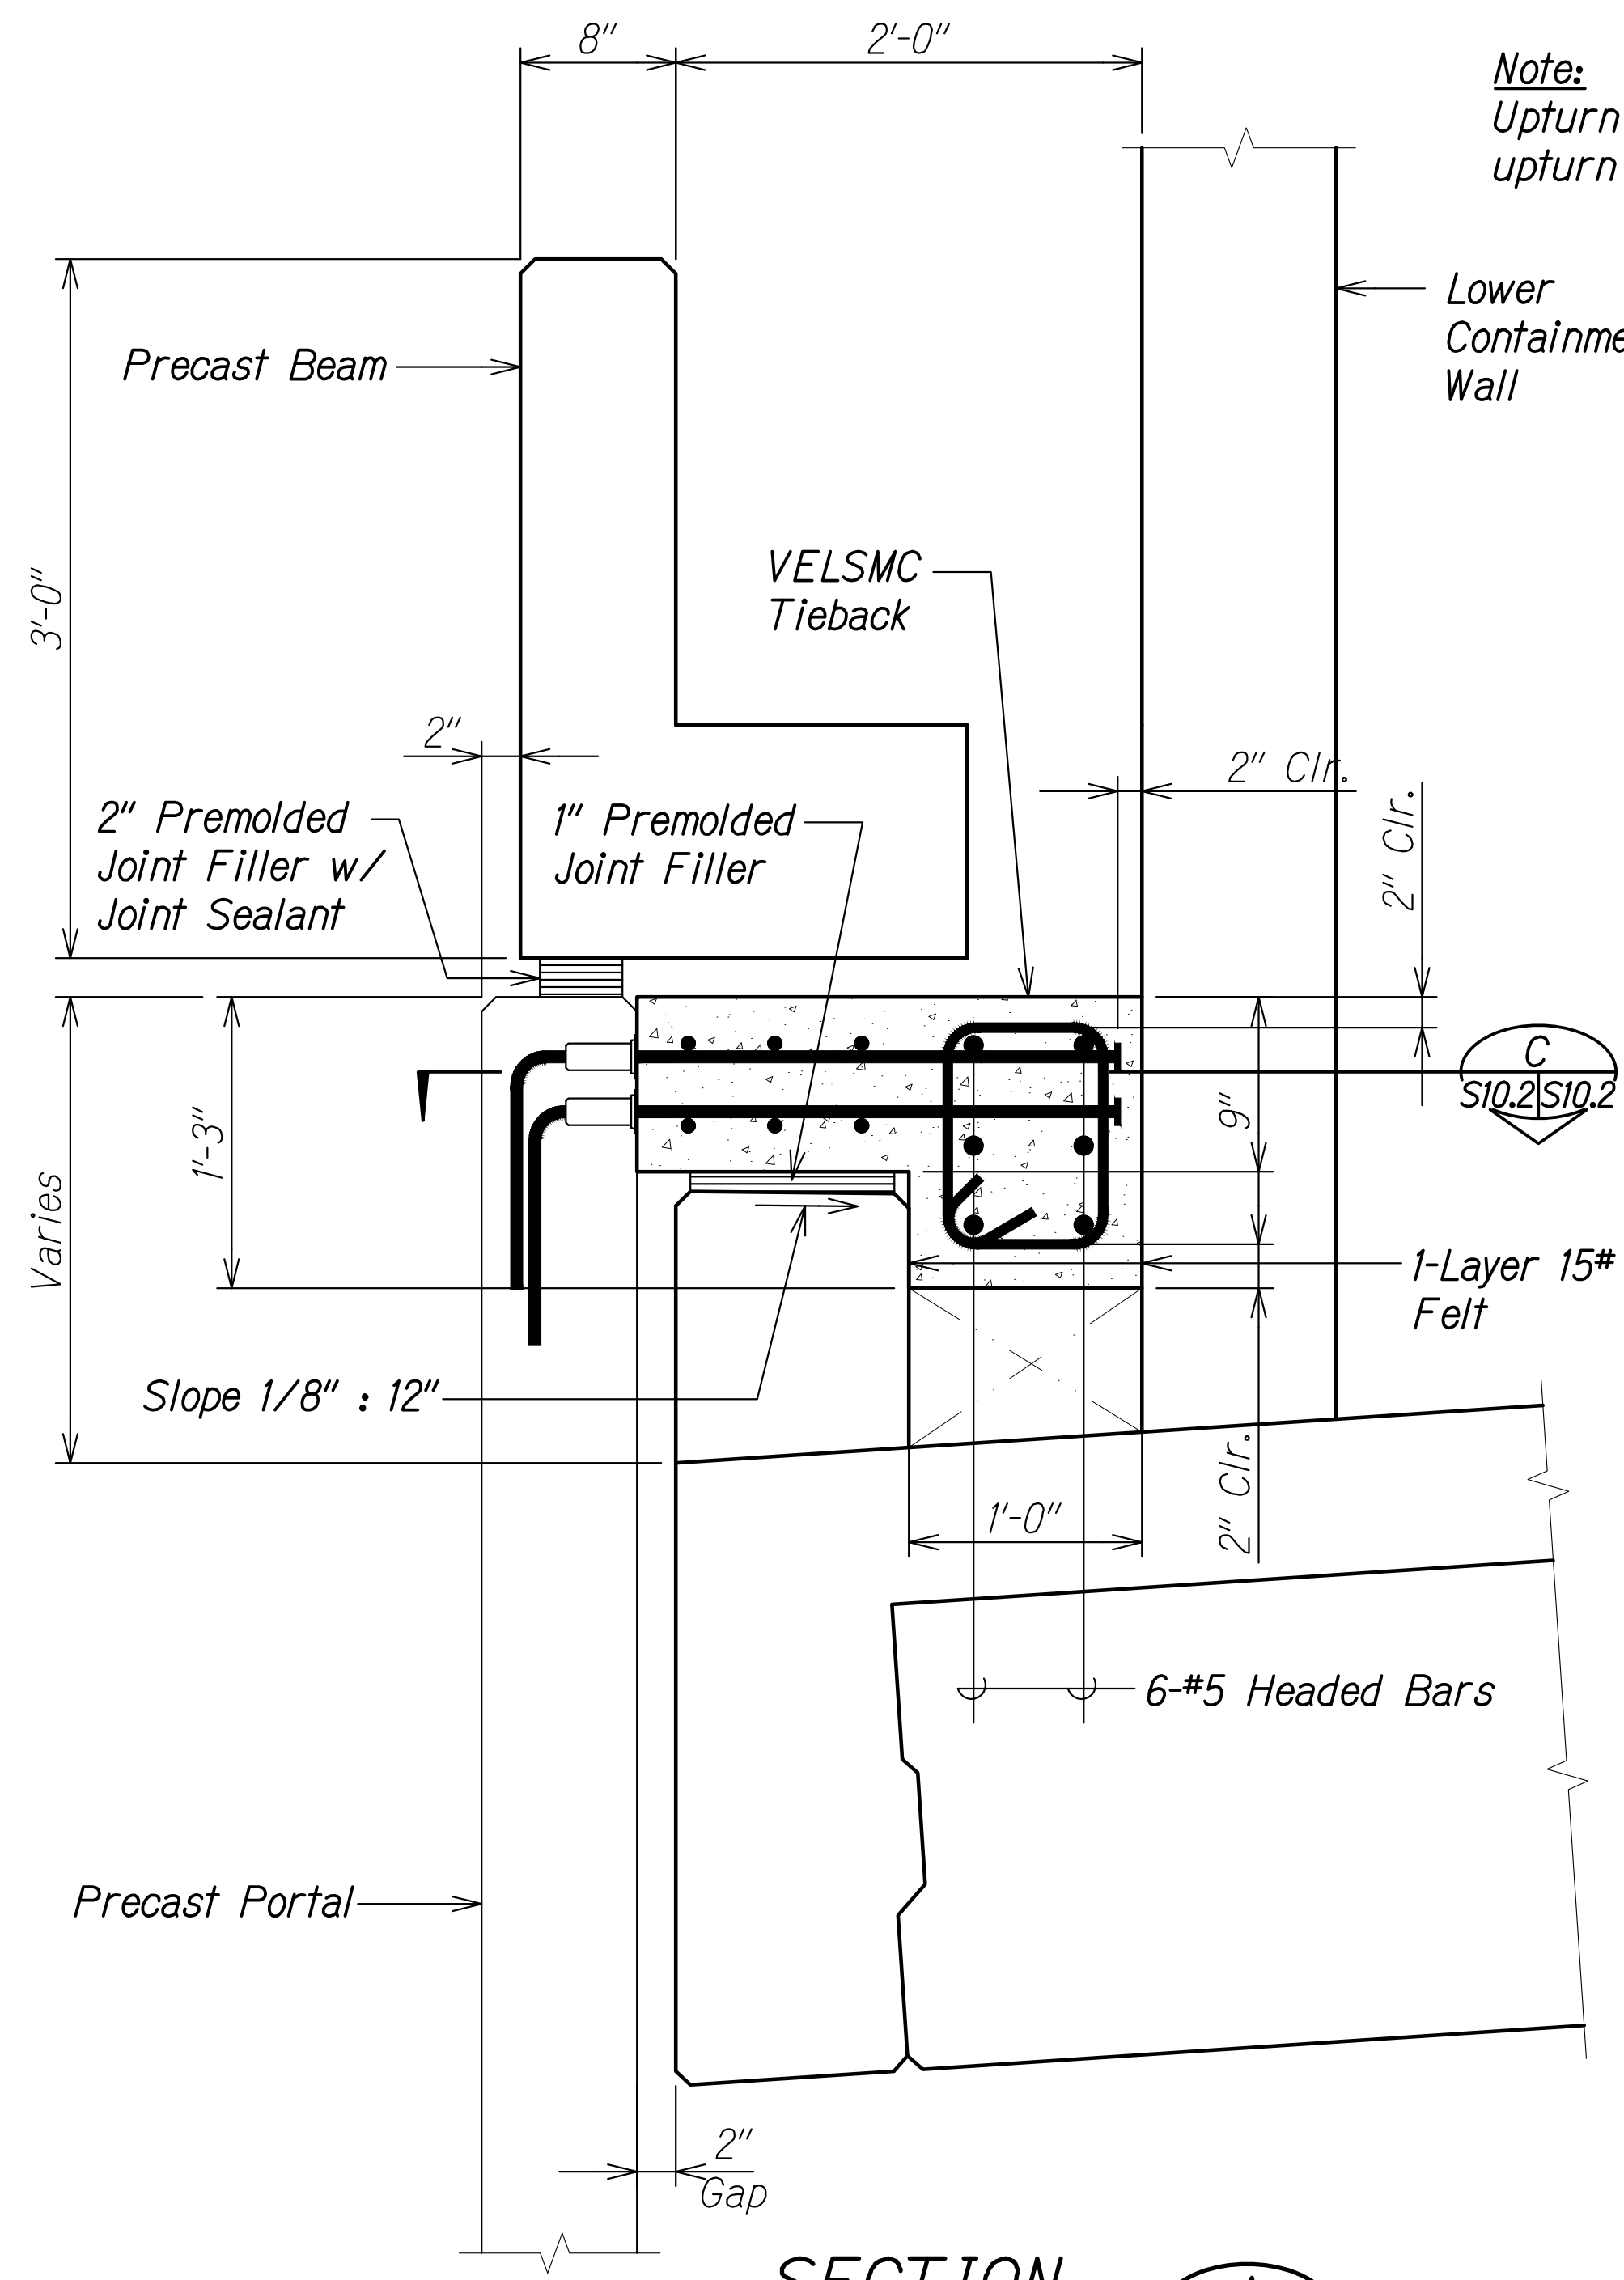

LEGEND FOR AS-BUILT POSTINGS	
	Squiggly line for as-built deletion
	Double line for as-built deletion
	Text for as-built posting

DATE	REVISION
8/06/19	5 Revised & Added Sections
5/24/19	1 Revised & Added Sections
STATE OF HAWAII DEPARTMENT OF TRANSPORTATION HIGHWAYS DIVISION <b>UPTURN CURB SECTIONS            AT NEW PORTAL</b> <b>PALI HIGHWAY</b> <b>LANDSLIDE MITIGATION PROJECT</b> <b>FAP Proj. No. ER-22(002)</b> Scale: As Noted Date: May 6, 2019 SHEET No. S10.2 OF 5 SHEETS	

FED. ROAD DIST. NO.	STATE	FEDERAL AID PROJ. NO.	FISCAL YEAR	SHEET NO.	TOTAL SHEETS
HAWAII	HAW.	ER-22(002)	2019	ADD 72	94

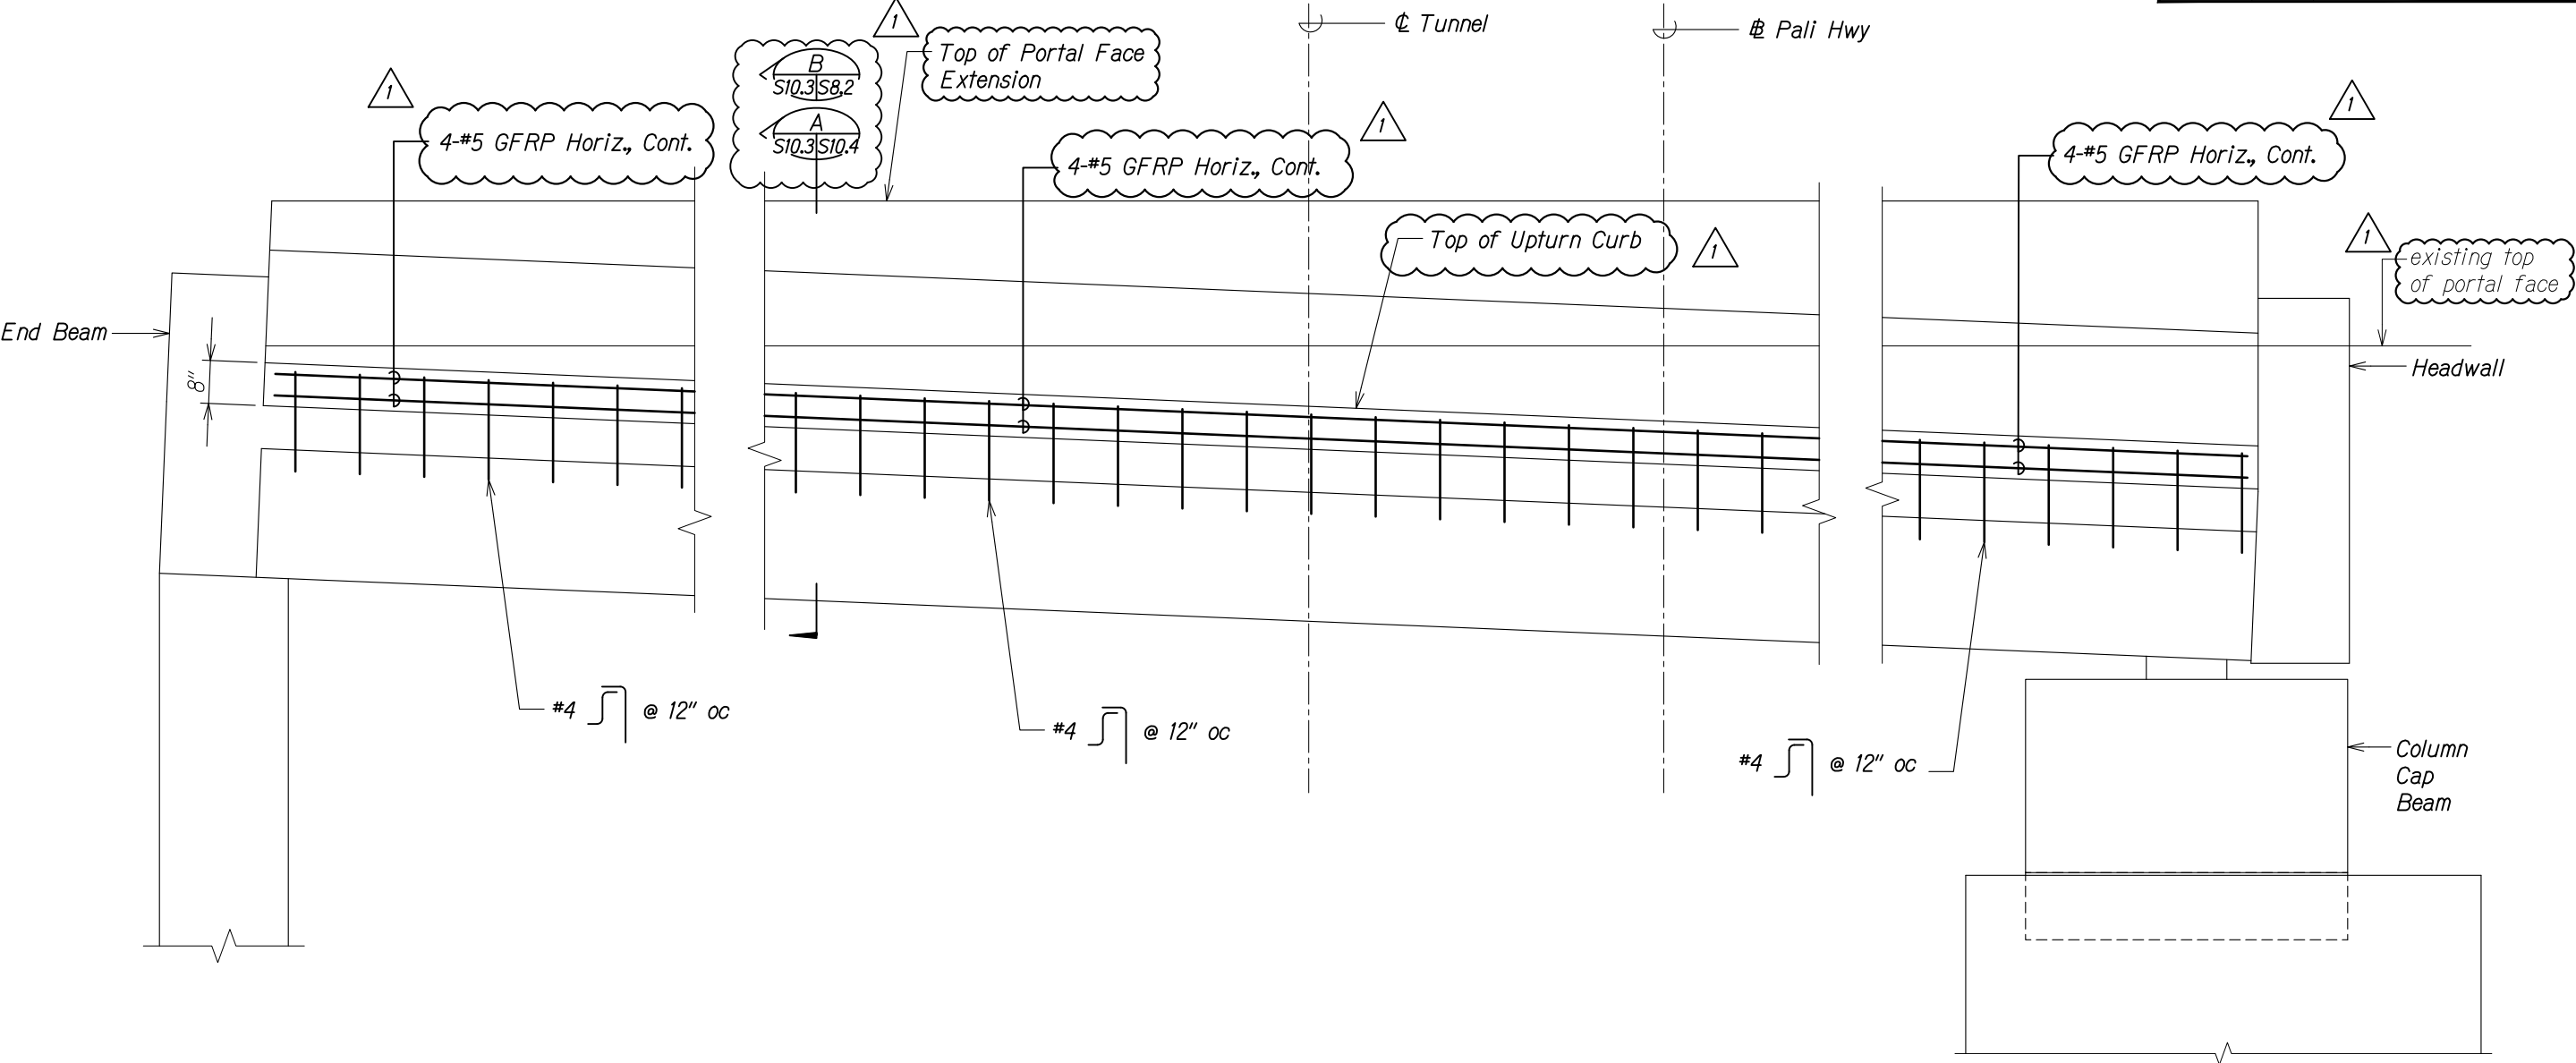

UPTURN CURB  
ELEVATION  
Scale: 3/4" = 1'-0"

A  
S10.3 S10.3

UPTURN CURB  
ELEVATION  
Scale: 3/4" = 1'-0"

B  
S10.3 S10.3

UPTURN CURB  
ELEVATION  
Scale: 3/4" = 1'-0"


C  
S10.3 S10.3

ORIGINAL PLAN	DATE
DESIGNED BY	
TRACED BY	
NOTE BOOK	
QUANTITIES BY	
CHECKED BY	

DRAWING NAME: Z:\00 ONGOING\19-014.1 PALI ROOF SHED-WSP TIA 01 CAD\05-24-19 PH 2\PLM-S1001 ADD1 S1003 UPTURN.DWG PLOT TIME: 06-03-19, 10:49 AM

5/24/19	1 Revised Elevations
DATE	REVISION
STATE OF HAWAII DEPARTMENT OF TRANSPORTATION HIGHWAYS DIVISION <b>UPTURN CURB ELEVATION AT EXISTING PORTAL</b> PALI HIGHWAY LANDSLIDE MITIGATION PROJECT FAP Proj. No. ER-22(002) Scale: As Noted Date: May 6, 2019 SHEET No. S10.3 OF 5 SHEETS	

FED. ROAD DIST. NO.	STATE	FEDERAL AID PROJ. NO.	FISCAL YEAR	SHEET NO.	TOTAL SHEETS
HAWAII	HAW.	ER-22(002)	2019	ADD 73	94

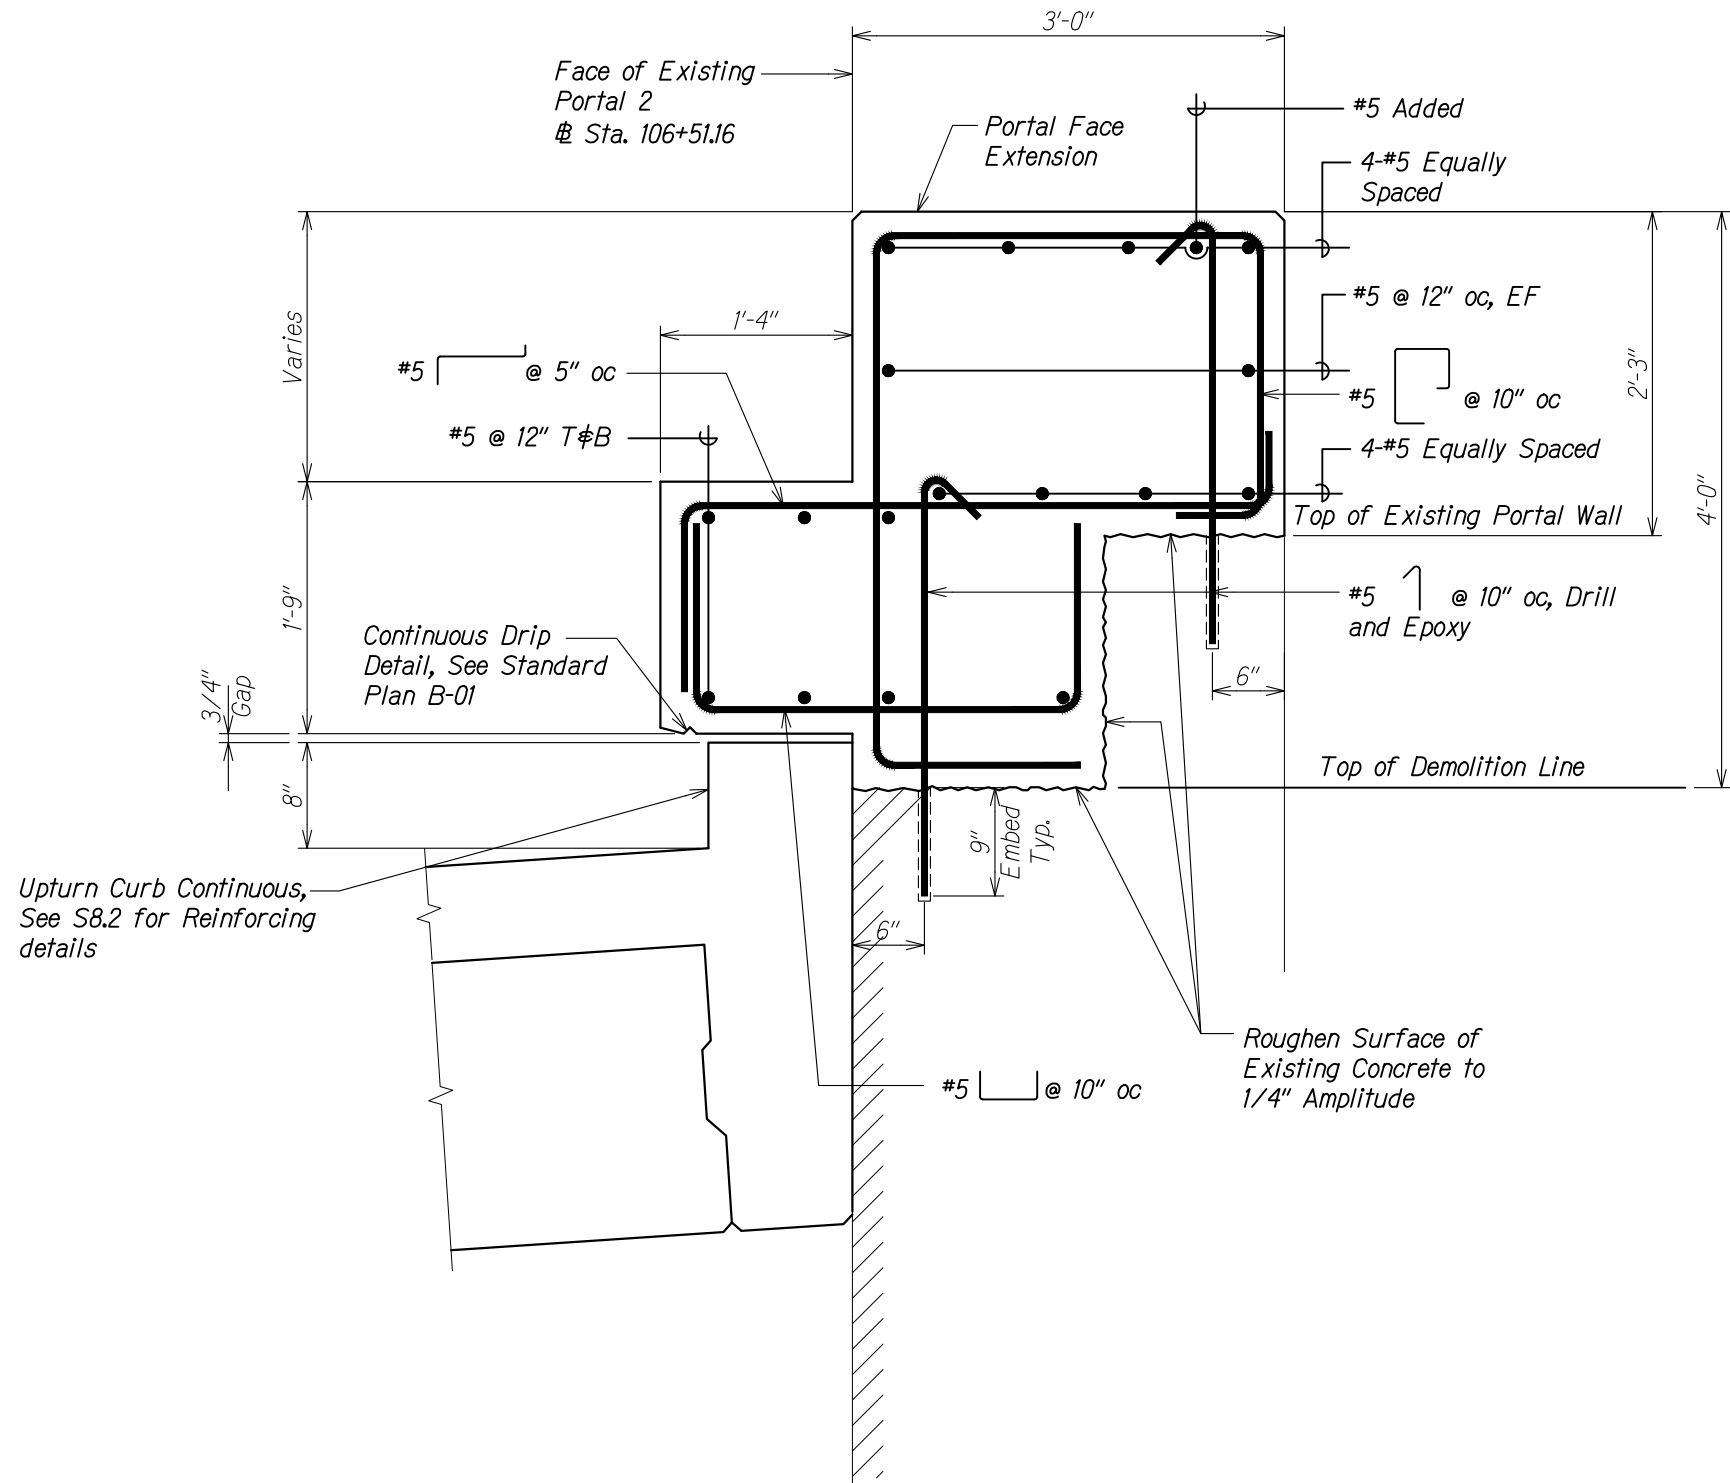


ORIGINAL PLAN	SURVEY PLOTTED BY	DATE
NOTE BOOK	DESIGNED BY	
	QUANTITIES BY	
	CHECKED BY	


DRAWING NAME: Z:\00 ONGOING\19-014.1 PALI ROOF SHED-WSP TIA 01 CAD\05-24-19 Ph 2\PLM-S1002 S1004 ADD1 UPTURN.DWG PLOT TIME: 06-03-19 10:55 AM

5/24/19	1 Revised Section
DATE	REVISION
STATE OF HAWAII DEPARTMENT OF TRANSPORTATION HIGHWAYS DIVISION <b>EXISTING PORTAL FACE EXTENSION SECTION</b> PALI HIGHWAY LANDSLIDE MITIGATION PROJECT FAP Proj. No. ER-22(002) Scale: As Noted Date: May 6, 2019 SHEET No. S10.4 OF 5 SHEETS	

FED. ROAD DIST. NO.	STATE	FEDERAL AID PROJ. NO.	FISCAL YEAR	SHEET NO.	TOTAL SHEETS
HAWAII	HAW.	ER-22(002)	2019	ADD 74	94

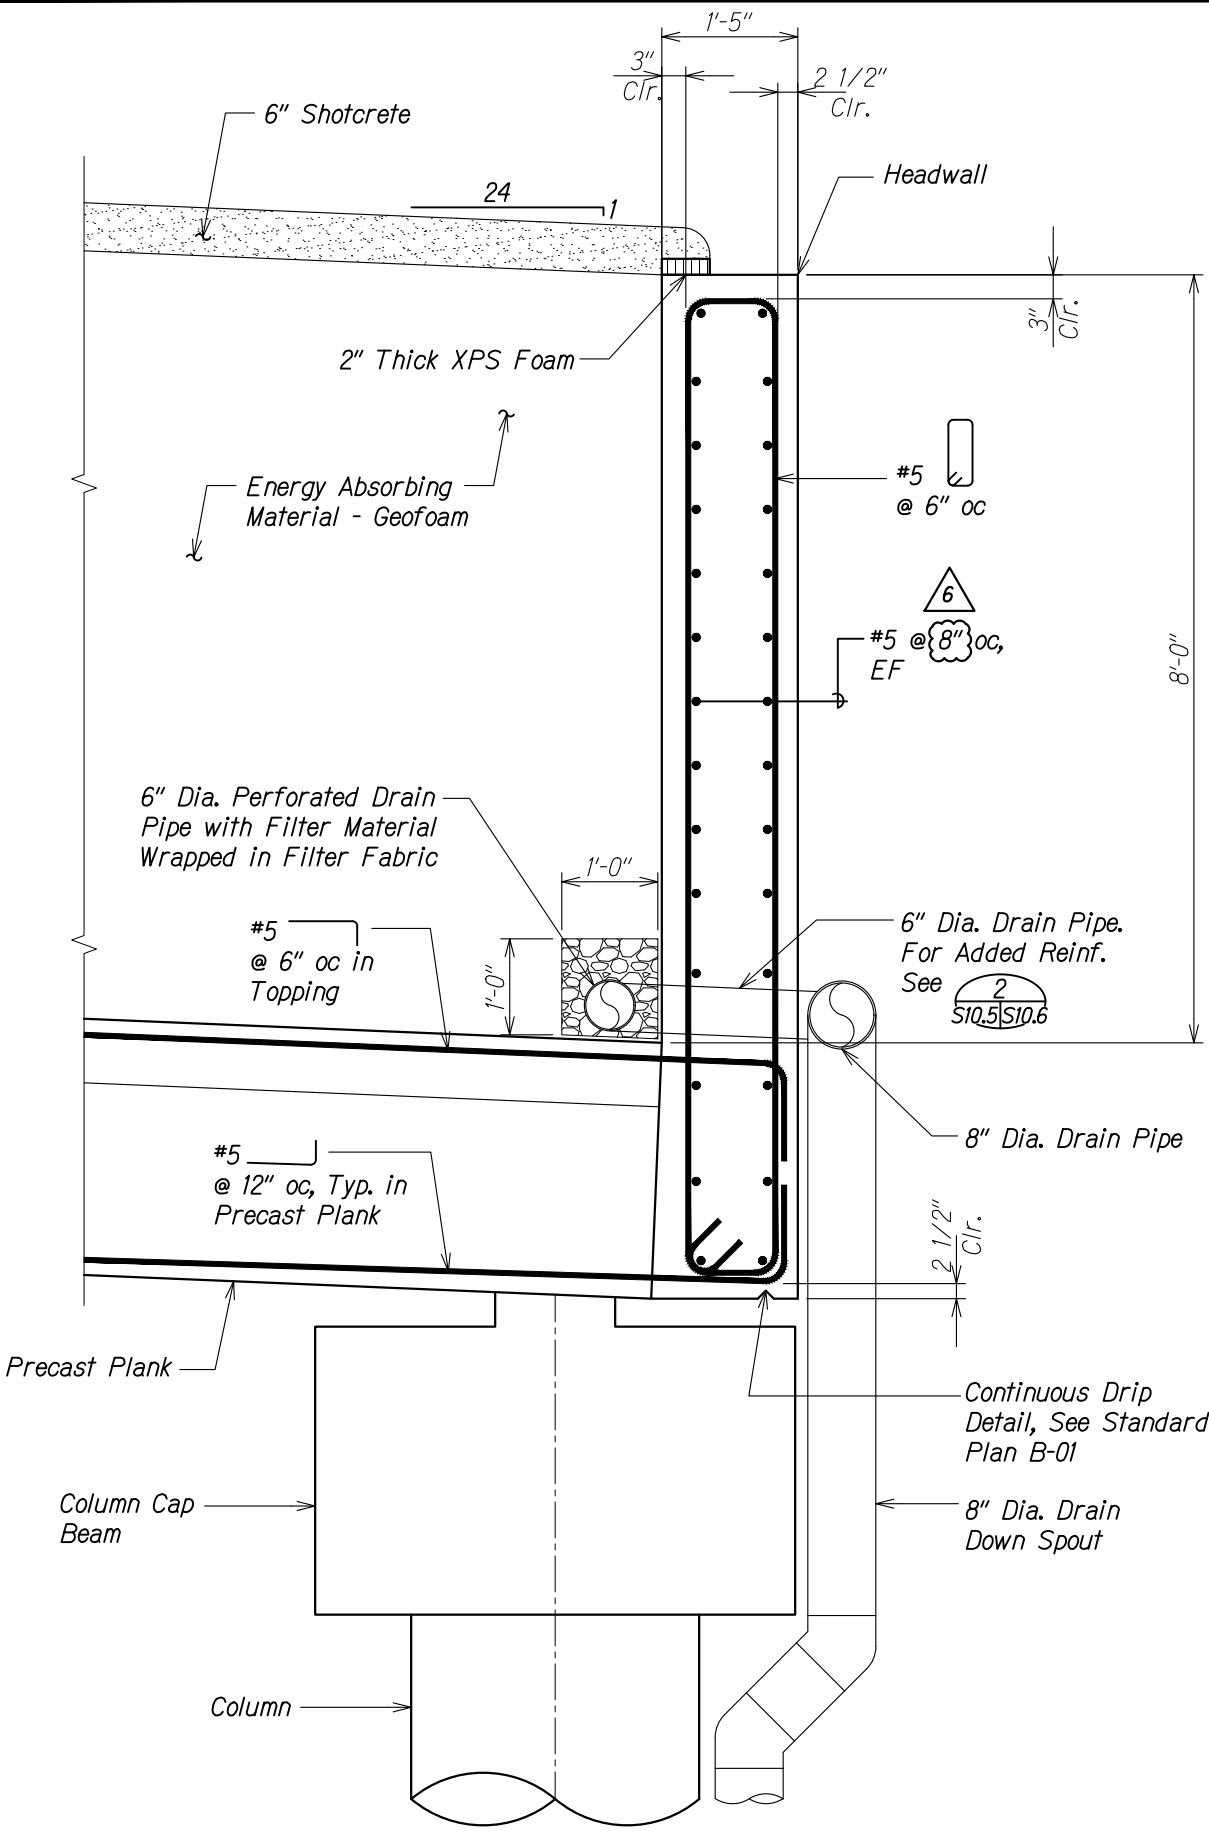





**SECTION AT 8'-0" HIGH HEADWALL**  
 Scale: 1" = 1'-0"  
 S1.6, S10.6

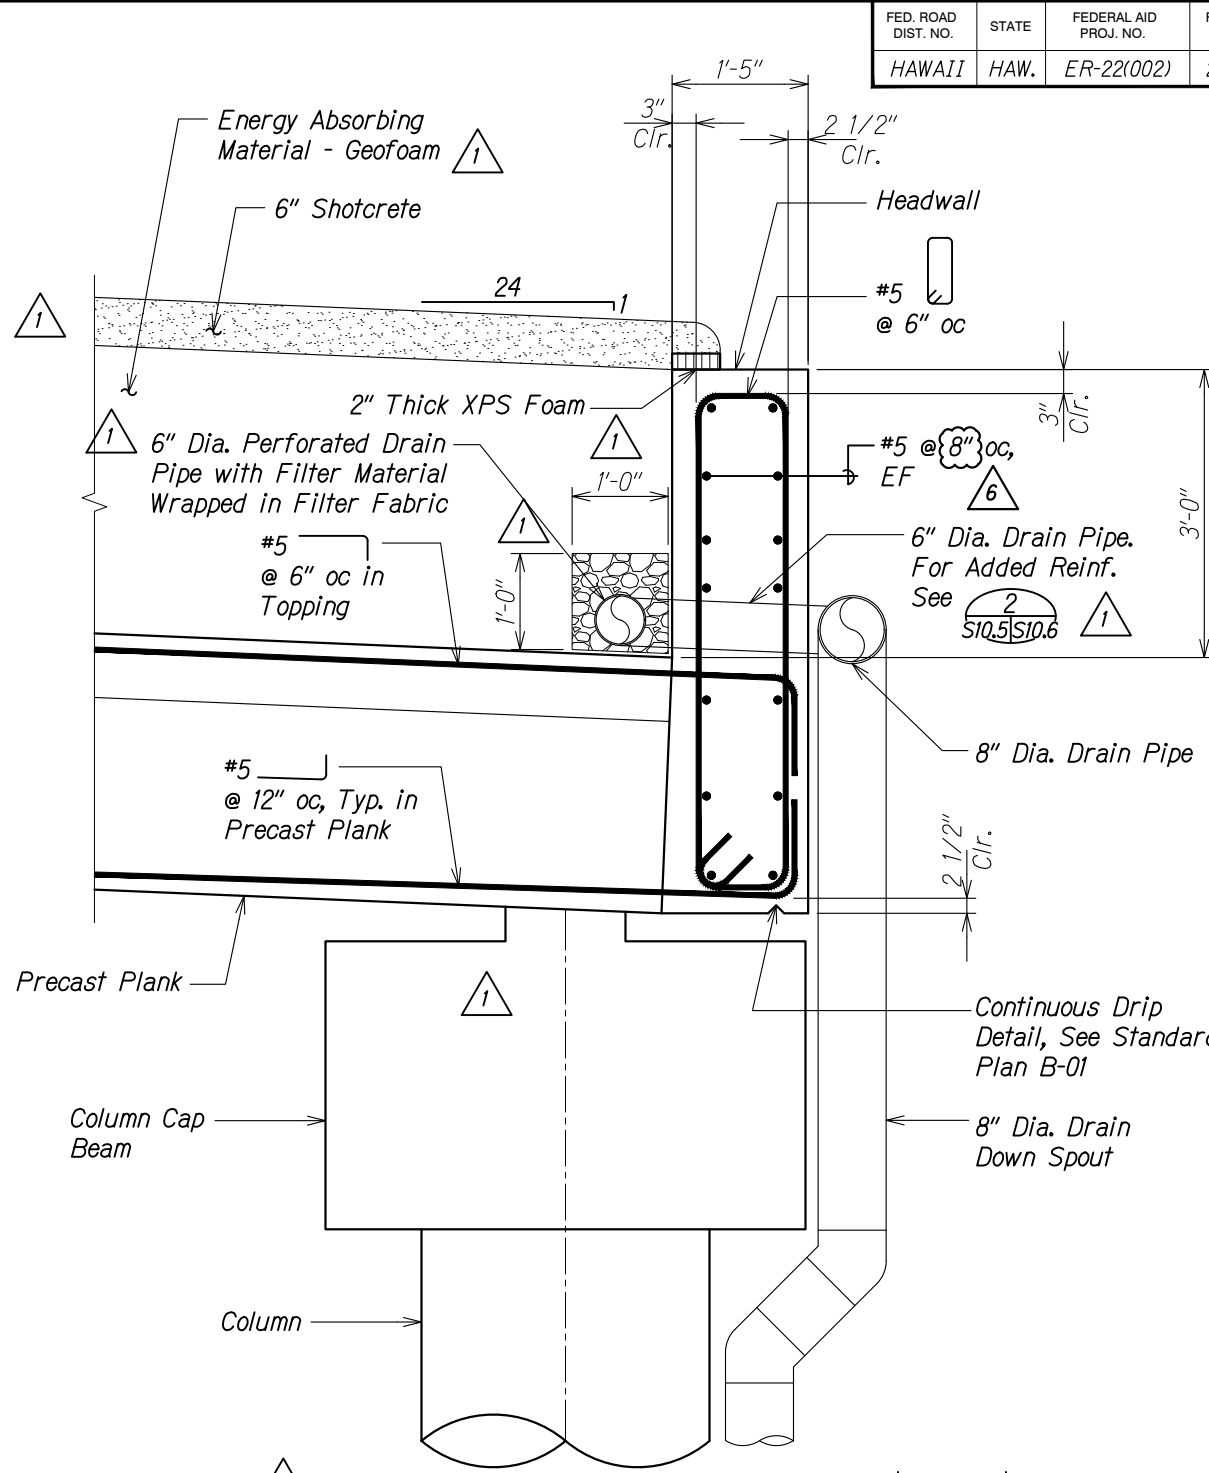

**SECTION AT 3'-0" HIGH HEADWALL**  
 Scale: 1" = 1'-0"  
 S1.6, S10.6

DATE	REVISION
8/13/19	Revised Reinforcing
5/24/19	Revised & Added Sections
DATE	REVISION
STATE OF HAWAII DEPARTMENT OF TRANSPORTATION HIGHWAYS DIVISION <b>HEADWALL SECTIONS</b> PALI HIGHWAY LANDSLIDE MITIGATION PROJECT FAP Proj. No. ER-22(002) Scale: As Noted Date: May 6, 2019 SHEET No. S10.5 OF 5 SHEETS	

FED. ROAD DIST. NO.	STATE	FEDERAL AID PROJ. NO.	FISCAL YEAR	SHEET NO.	TOTAL SHEETS
HAWAII	HAW.	ER-22(002)	2019	ADD 74S-1	94

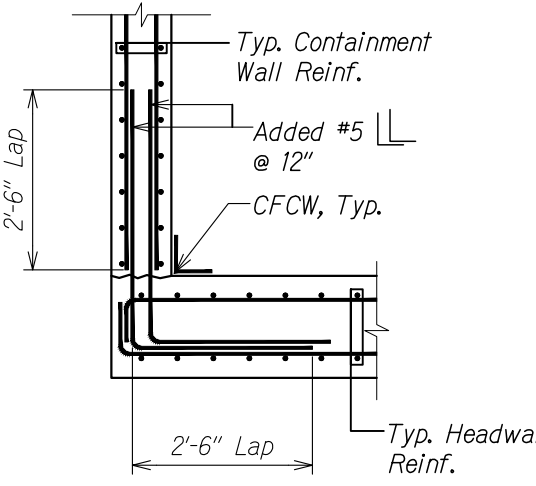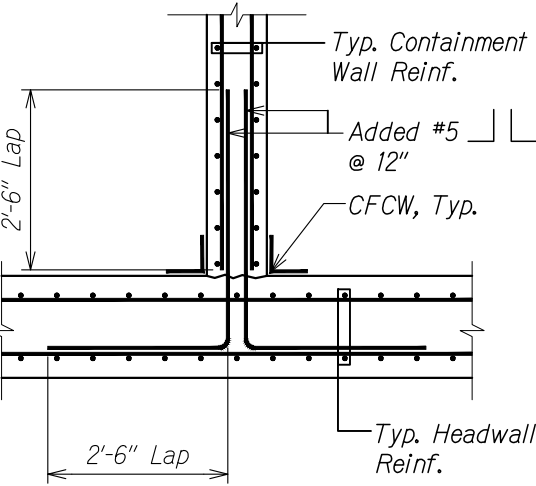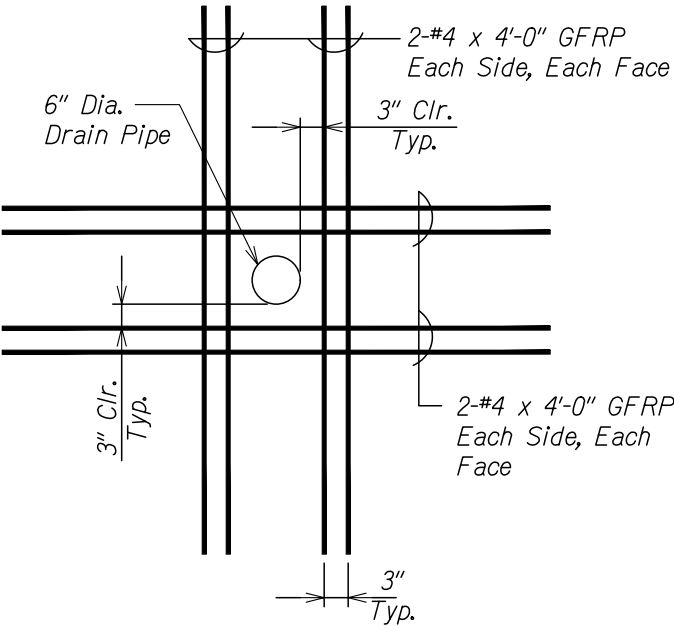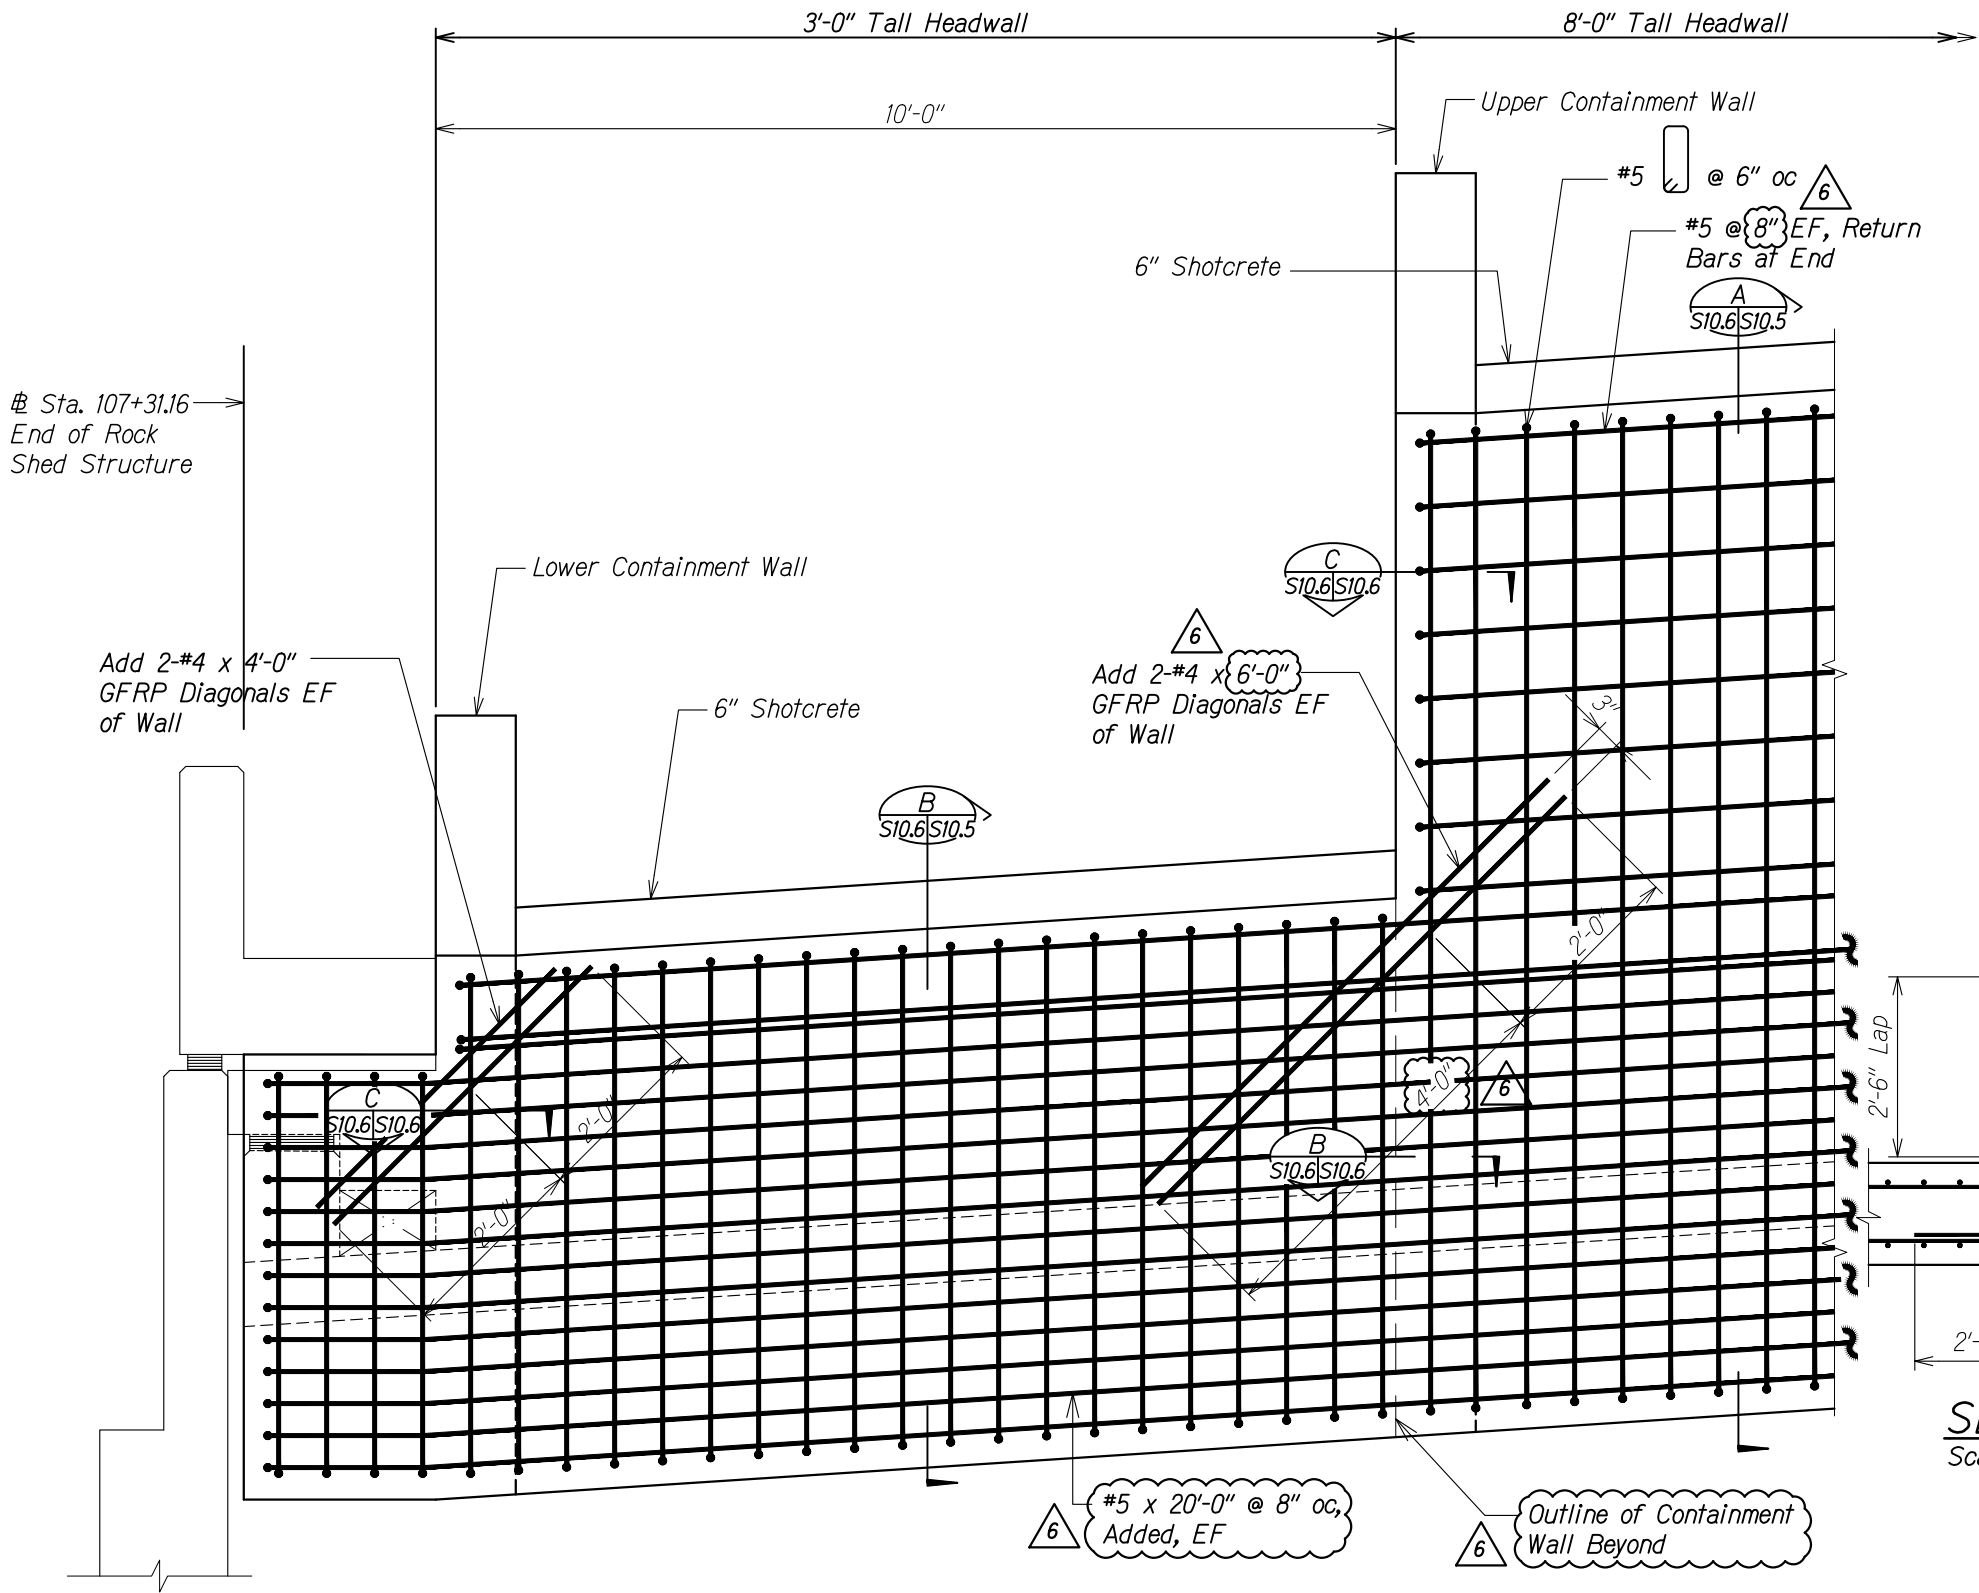

HEADWALL STEP SECTION

Scale: 1" = 1'-0"

SECTION A

Scale: 1" = 1'-0"

8/13/19	6	Revised Reinforcing
5/24/19	1	New Sheet
DATE	REVISION	

STATE OF HAWAII  
DEPARTMENT OF TRANSPORTATION  
HIGHWAYS DIVISION

**HEADWALL SECTION AND DETAIL**

PALI HIGHWAY  
LANDSLIDE MITIGATION PROJECT  
FAP Proj. No. ER-22(002)

Scale: As Noted Date: May 6, 2019

SHEET No. S10.6 OF 5 SHEETS