


FED. ROAD DIST. NO.	STATE	PROJ. NO.	FISCAL YEAR	SHEET NO.	TOTAL SHEETS
HAWAII	HAW.	61C-01-04M	2004	33	91

ABBREVIATIONS:

RM Reflector Marker
 OM Object Marker



SIGN LEGEND:

□ Sign
 - Sign Reference Number

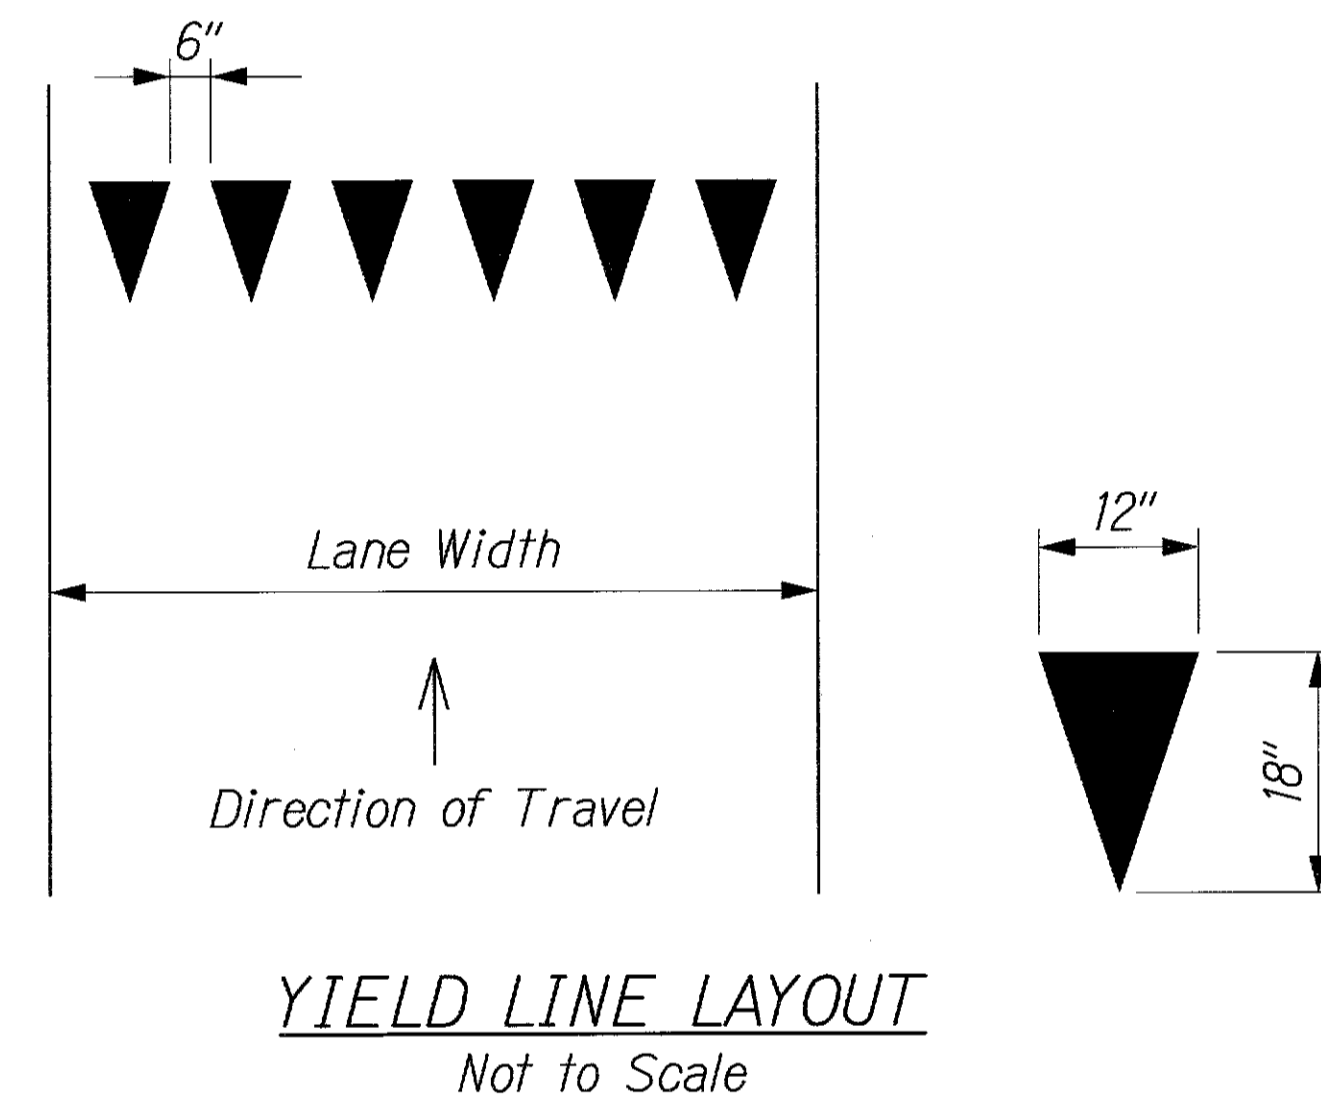

LEGEND:

- 4" White Edge Stripe with Type C Markers @ 40' o.c.
- 4" White Stripe, with Type C Markers @ 40' o.c. and 4" x 2' Long White Stripe @ 10' o.c.
- 8" White Stripe with Type C Markers @ 20' o.c.
- 4" White Guide Lines, 2' Long @ 6' o.c.
- 4" Yellow Edge Stripe with Type H Markers @ 40' o.c.

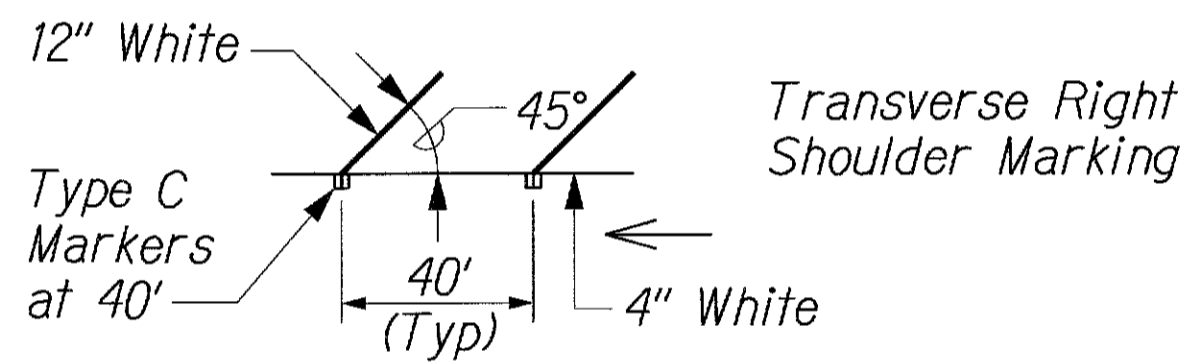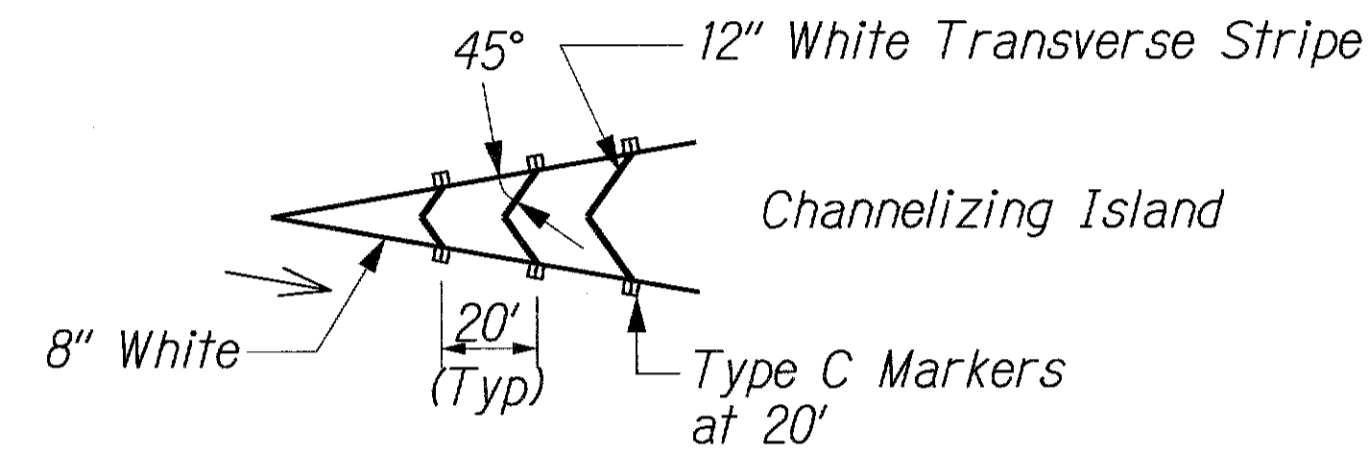

- Pavement Arrow
- Pavement Word
- New or Relocated Sign
- Existing Sign
- Direction of Traffic

SIGNING NOTES:

1. Sign details shall conform to the latest editions and amendments of the following FHWA publications: "Manual on Uniform Traffic Control Devices for Streets and Highways", "Standard Highway Signs" and "Standard Alphabets for Highway Signs".
2. For Miscellaneous Sign Details, see Standard Plan TE-01 to TE-18.
3. Superfluous Existing Signs are generally not shown on plans. They shall be removed and disposed of by the Contractor. Removal of signs shall also include the removal of post and foundation to a minimum height of 1-foot below the ground. Payment for the removal of such signs shall be incidental to the various contract items.
4. The Contractor shall backfill all holes, depressions and pits left by the removal of the existing signs with embankment material and grass all areas exposed in accordance with Specifications Section 618-Grassed Surfaces.

PAVEMENT MARKING NOTES:

1. Pavement edge striping shall be reflective thermoplastic compound pavement markings or permanent preformed pavement marking tape Type II. Lane striping shall be reflective thermoplastic compound pavement markings or permanent preformed pavement marking tape Type I. Symbols, legends and intersection markings shall be reflective thermoplastic compound pavement markings or permanent preformed pavement marking tape Type III.
2. Location of pavement markers is shown schematically. For exact location of markers in relation to stripe, see Standard Plans TE-30, TE-31 & TE-32.

ORIGINAL PLAN	SURVEY PLOTTED BY	DATE
NOTE BOOK	DRAWN BY	
	CHECKED BY	
	DESIGNED BY	
	CHECKED BY	

47/CASTLE JUNCTION/SIGN/SS-NOTE SIGN

	STATE OF HAWAII
	DEPARTMENT OF TRANSPORTATION
	HIGHWAYS DIVISION
	SIGNING AND PAVEMENT MARKING
	NOTES AND LEGEND
	KALANIANA'OLE HIGHWAY
	EMERGENCY LANDSLIDE REPAIRS AT CASTLE JUNCTION
	PROJECT NO. 61C-01-04M
Scale: None	Date: Sept. 26, 2003