


PLAN	DATE
BY	
CHECKED	
APPROVED	
NO. 1	
NO. 2	
NO. 3	
NO. 100	


NOTES:

1. All fences within the right of way which are not to be relocated shall be removed and stockpiled as directed by the Engineer. Suitable end posts shall be installed to properly support fence. All the above will not be paid for separately but is considered incidental to the item of Unclassified Excavation.
2. All utilities in the way of the construction operation will be adjusted by their respective owners, namely Hawaiian Electric Co., Mutual Telephone Co., U.S. Signal Corps and the Suburban Water System of the C. & C. of Honolulu.
3. All dwellings, garages and other miscellaneous structures not removed by the owners prior to the award of Contract shall be demolished by the Contractor under the item of Clearing and Grubbing.


Test Boring No. 1
Sta. 39+45 ± Left 70'

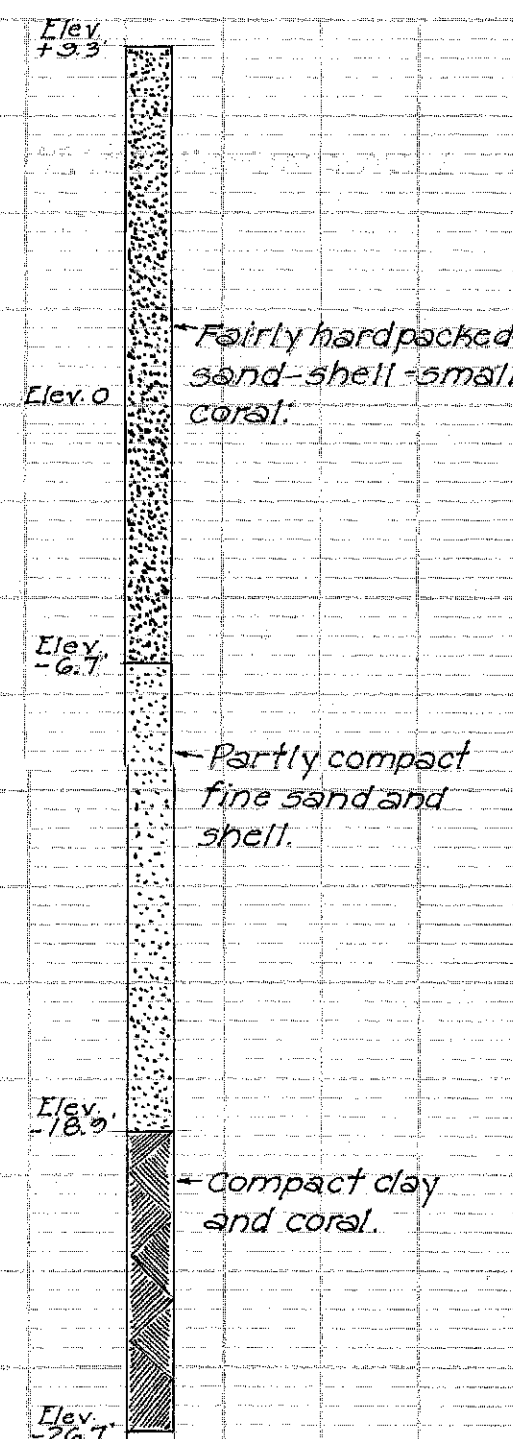


Test Boring No. 2
Sta. 37+00 ± Right 98'

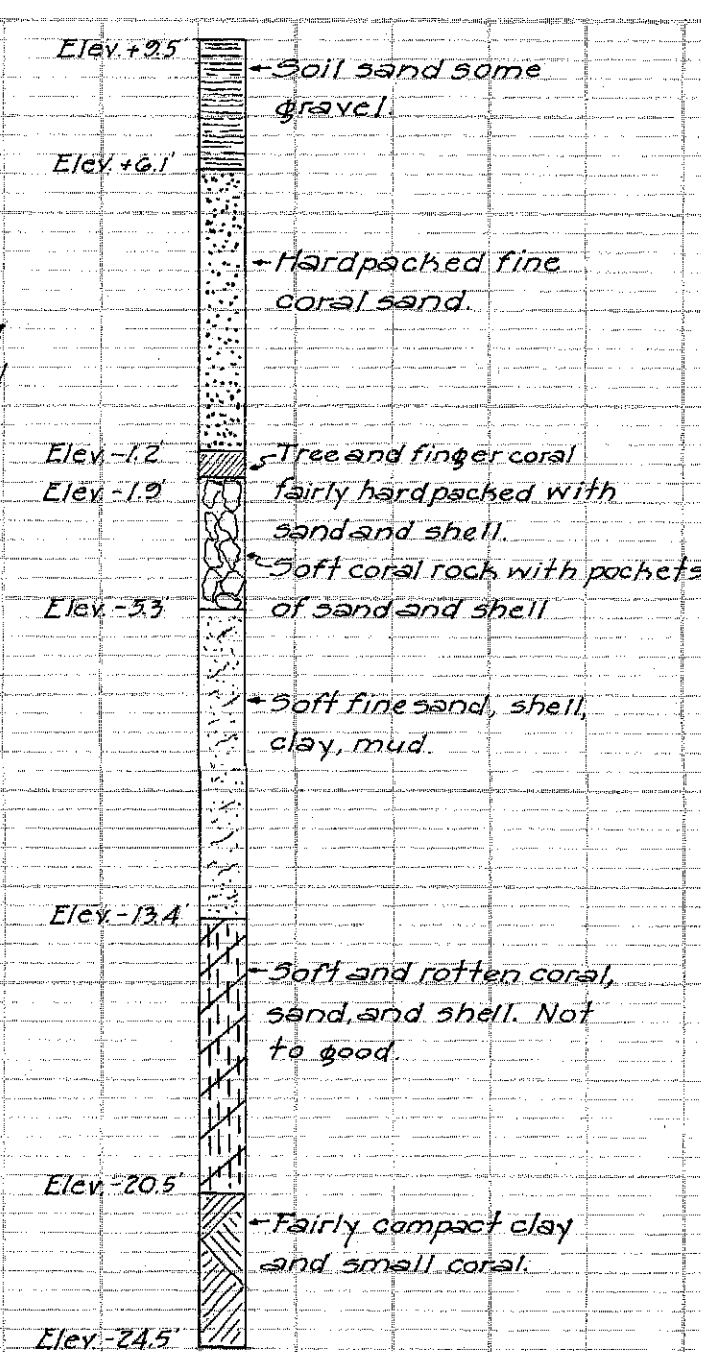

Test Boring No. 3
Sta. 19+00

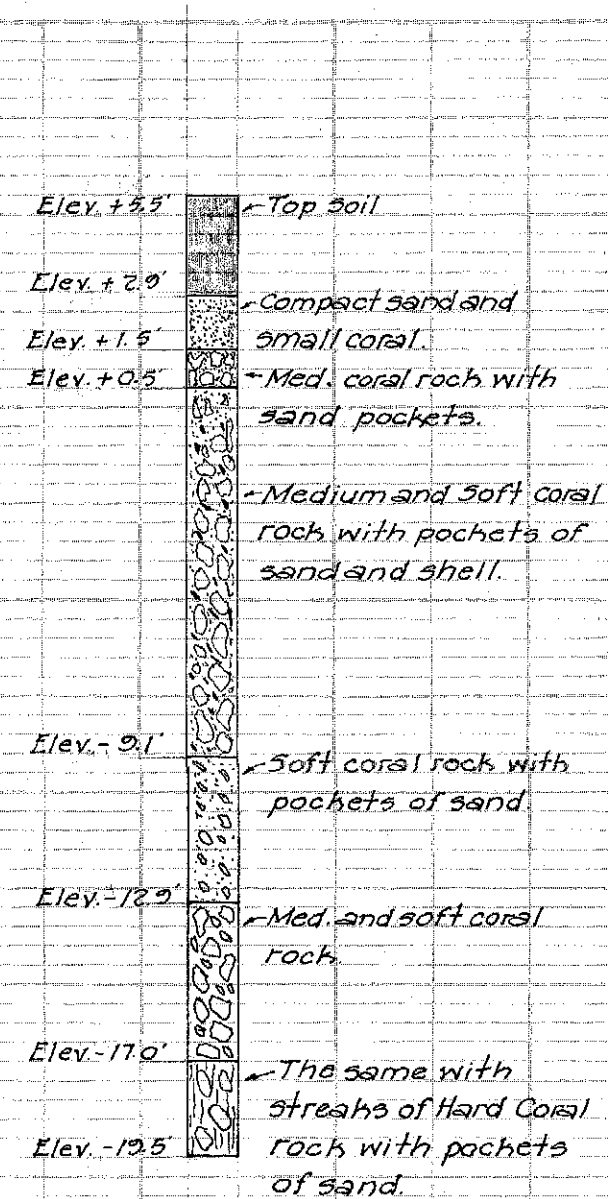


Test Boring No. 4
Sta. 80+58.40

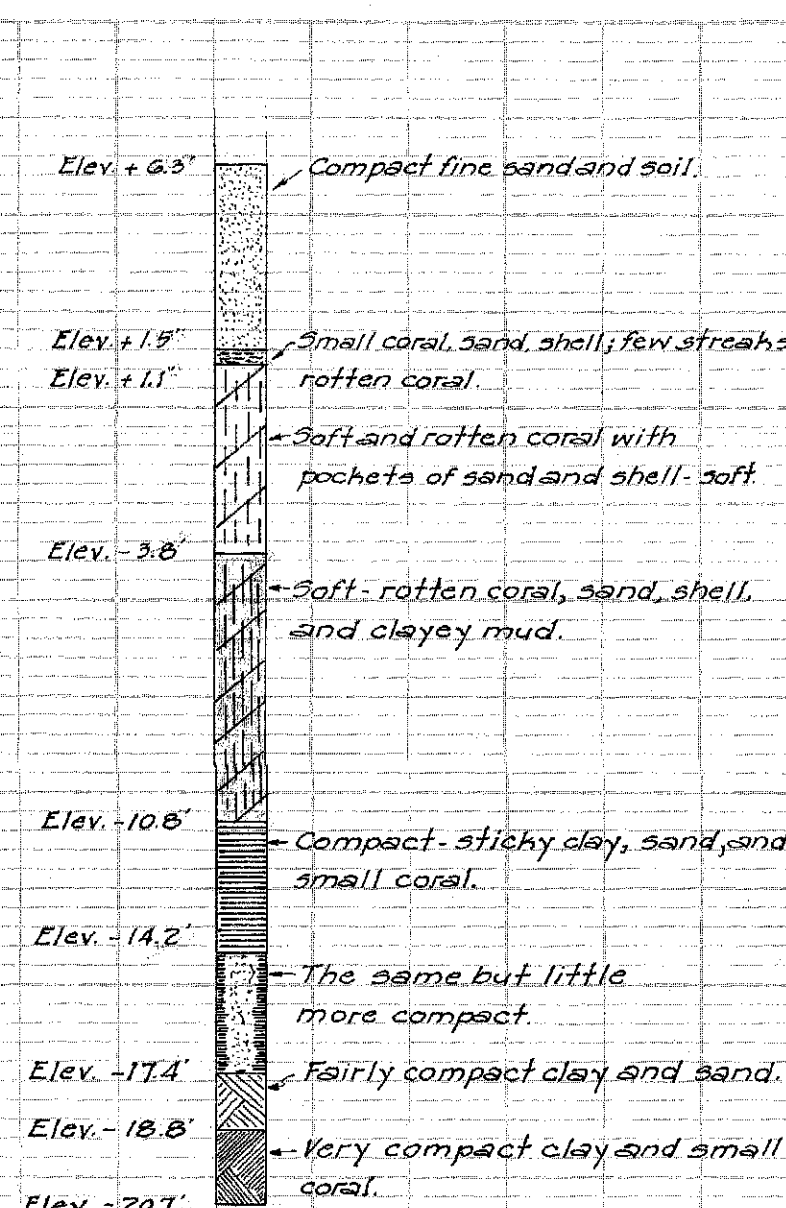


Notice To Contractors!

The data shown on these borings is intended for design purpose only and is for the convenience of the Engineer in the control of earthwork. The borings were carefully made and are believed to be reliable, but the Engineer does not guarantee the accuracy of same. The contractor is hereby advised and will be presumed to have made his own investigations on the site prior to submission of his bid.

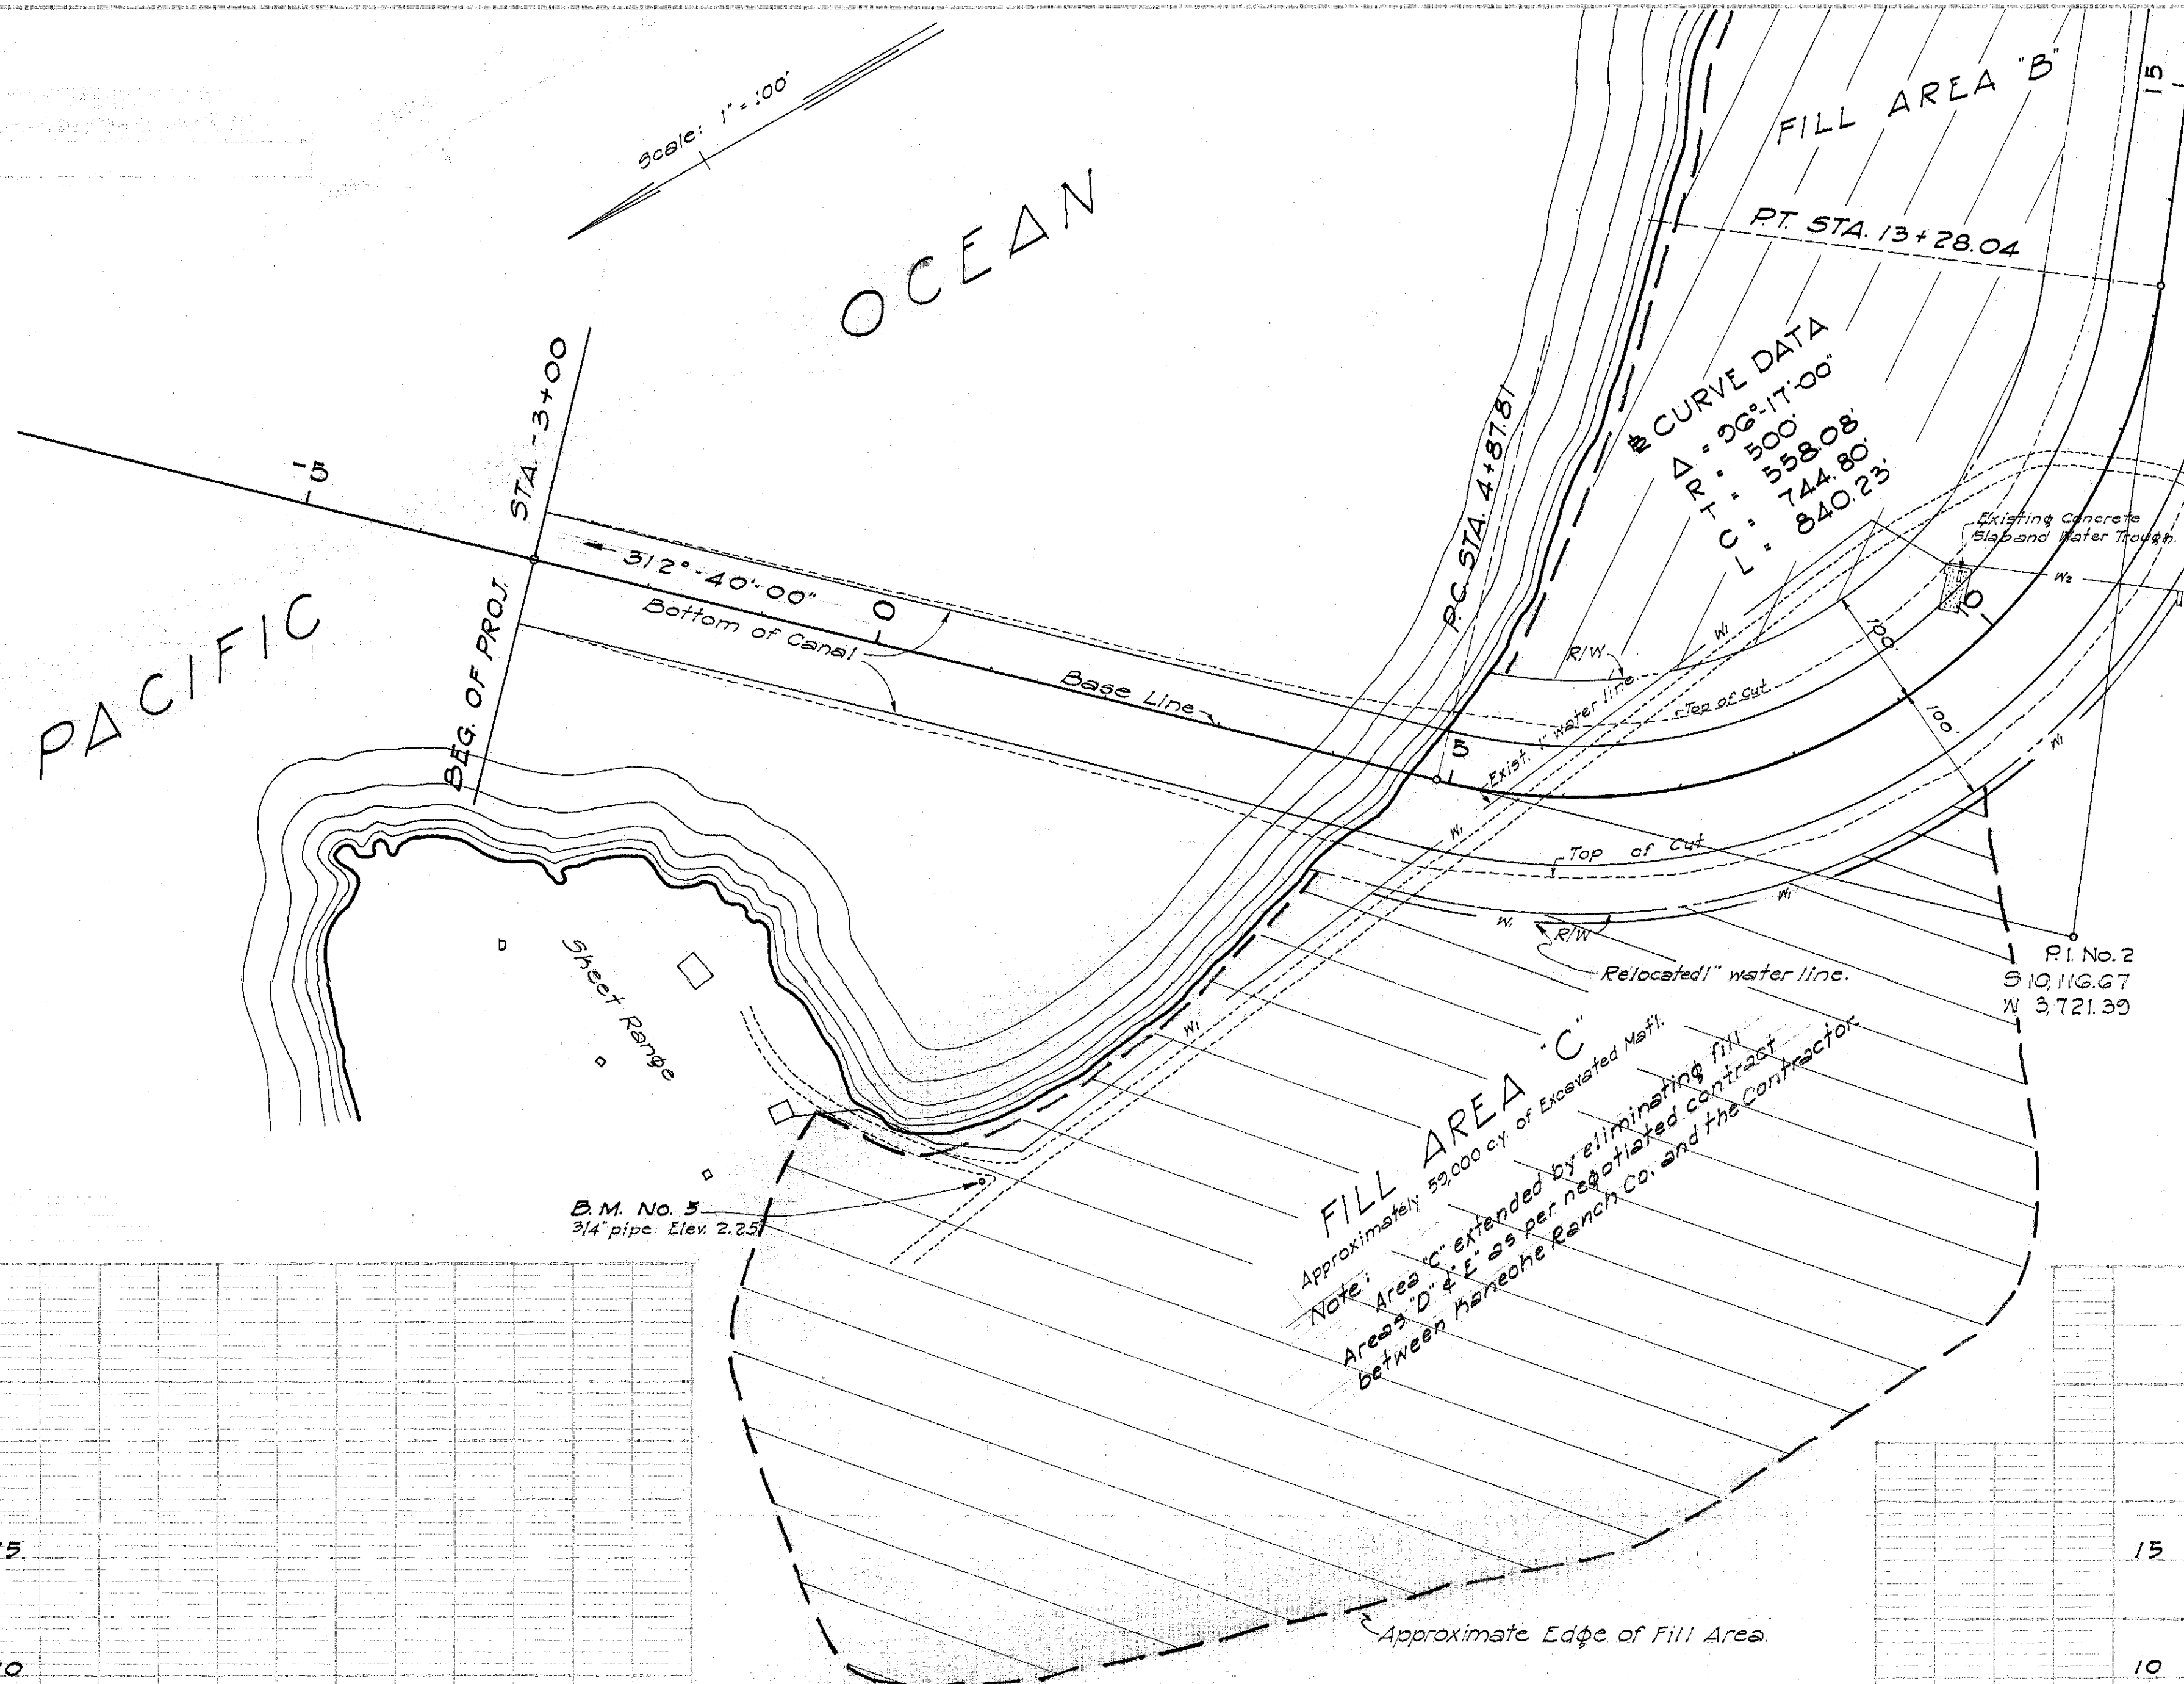


Existing Ground Line at #

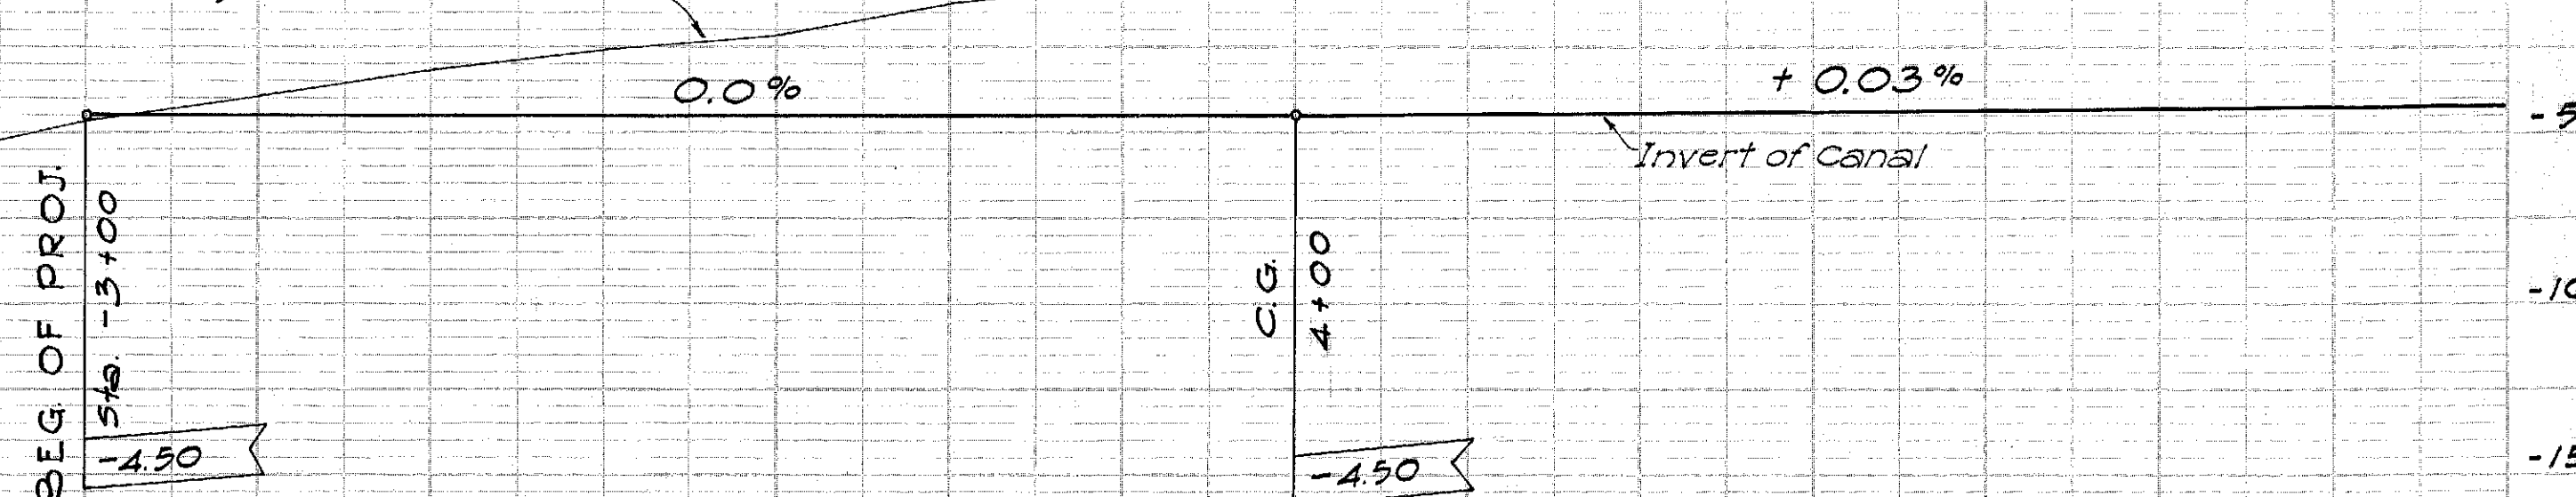

PLAN
 DRAWN BY: [blank]
 CHECKED BY: [blank]
 DATE: [blank]

PROFILE
 DRAWN BY: [blank]
 CHECKED BY: [blank]
 DATE: [blank]

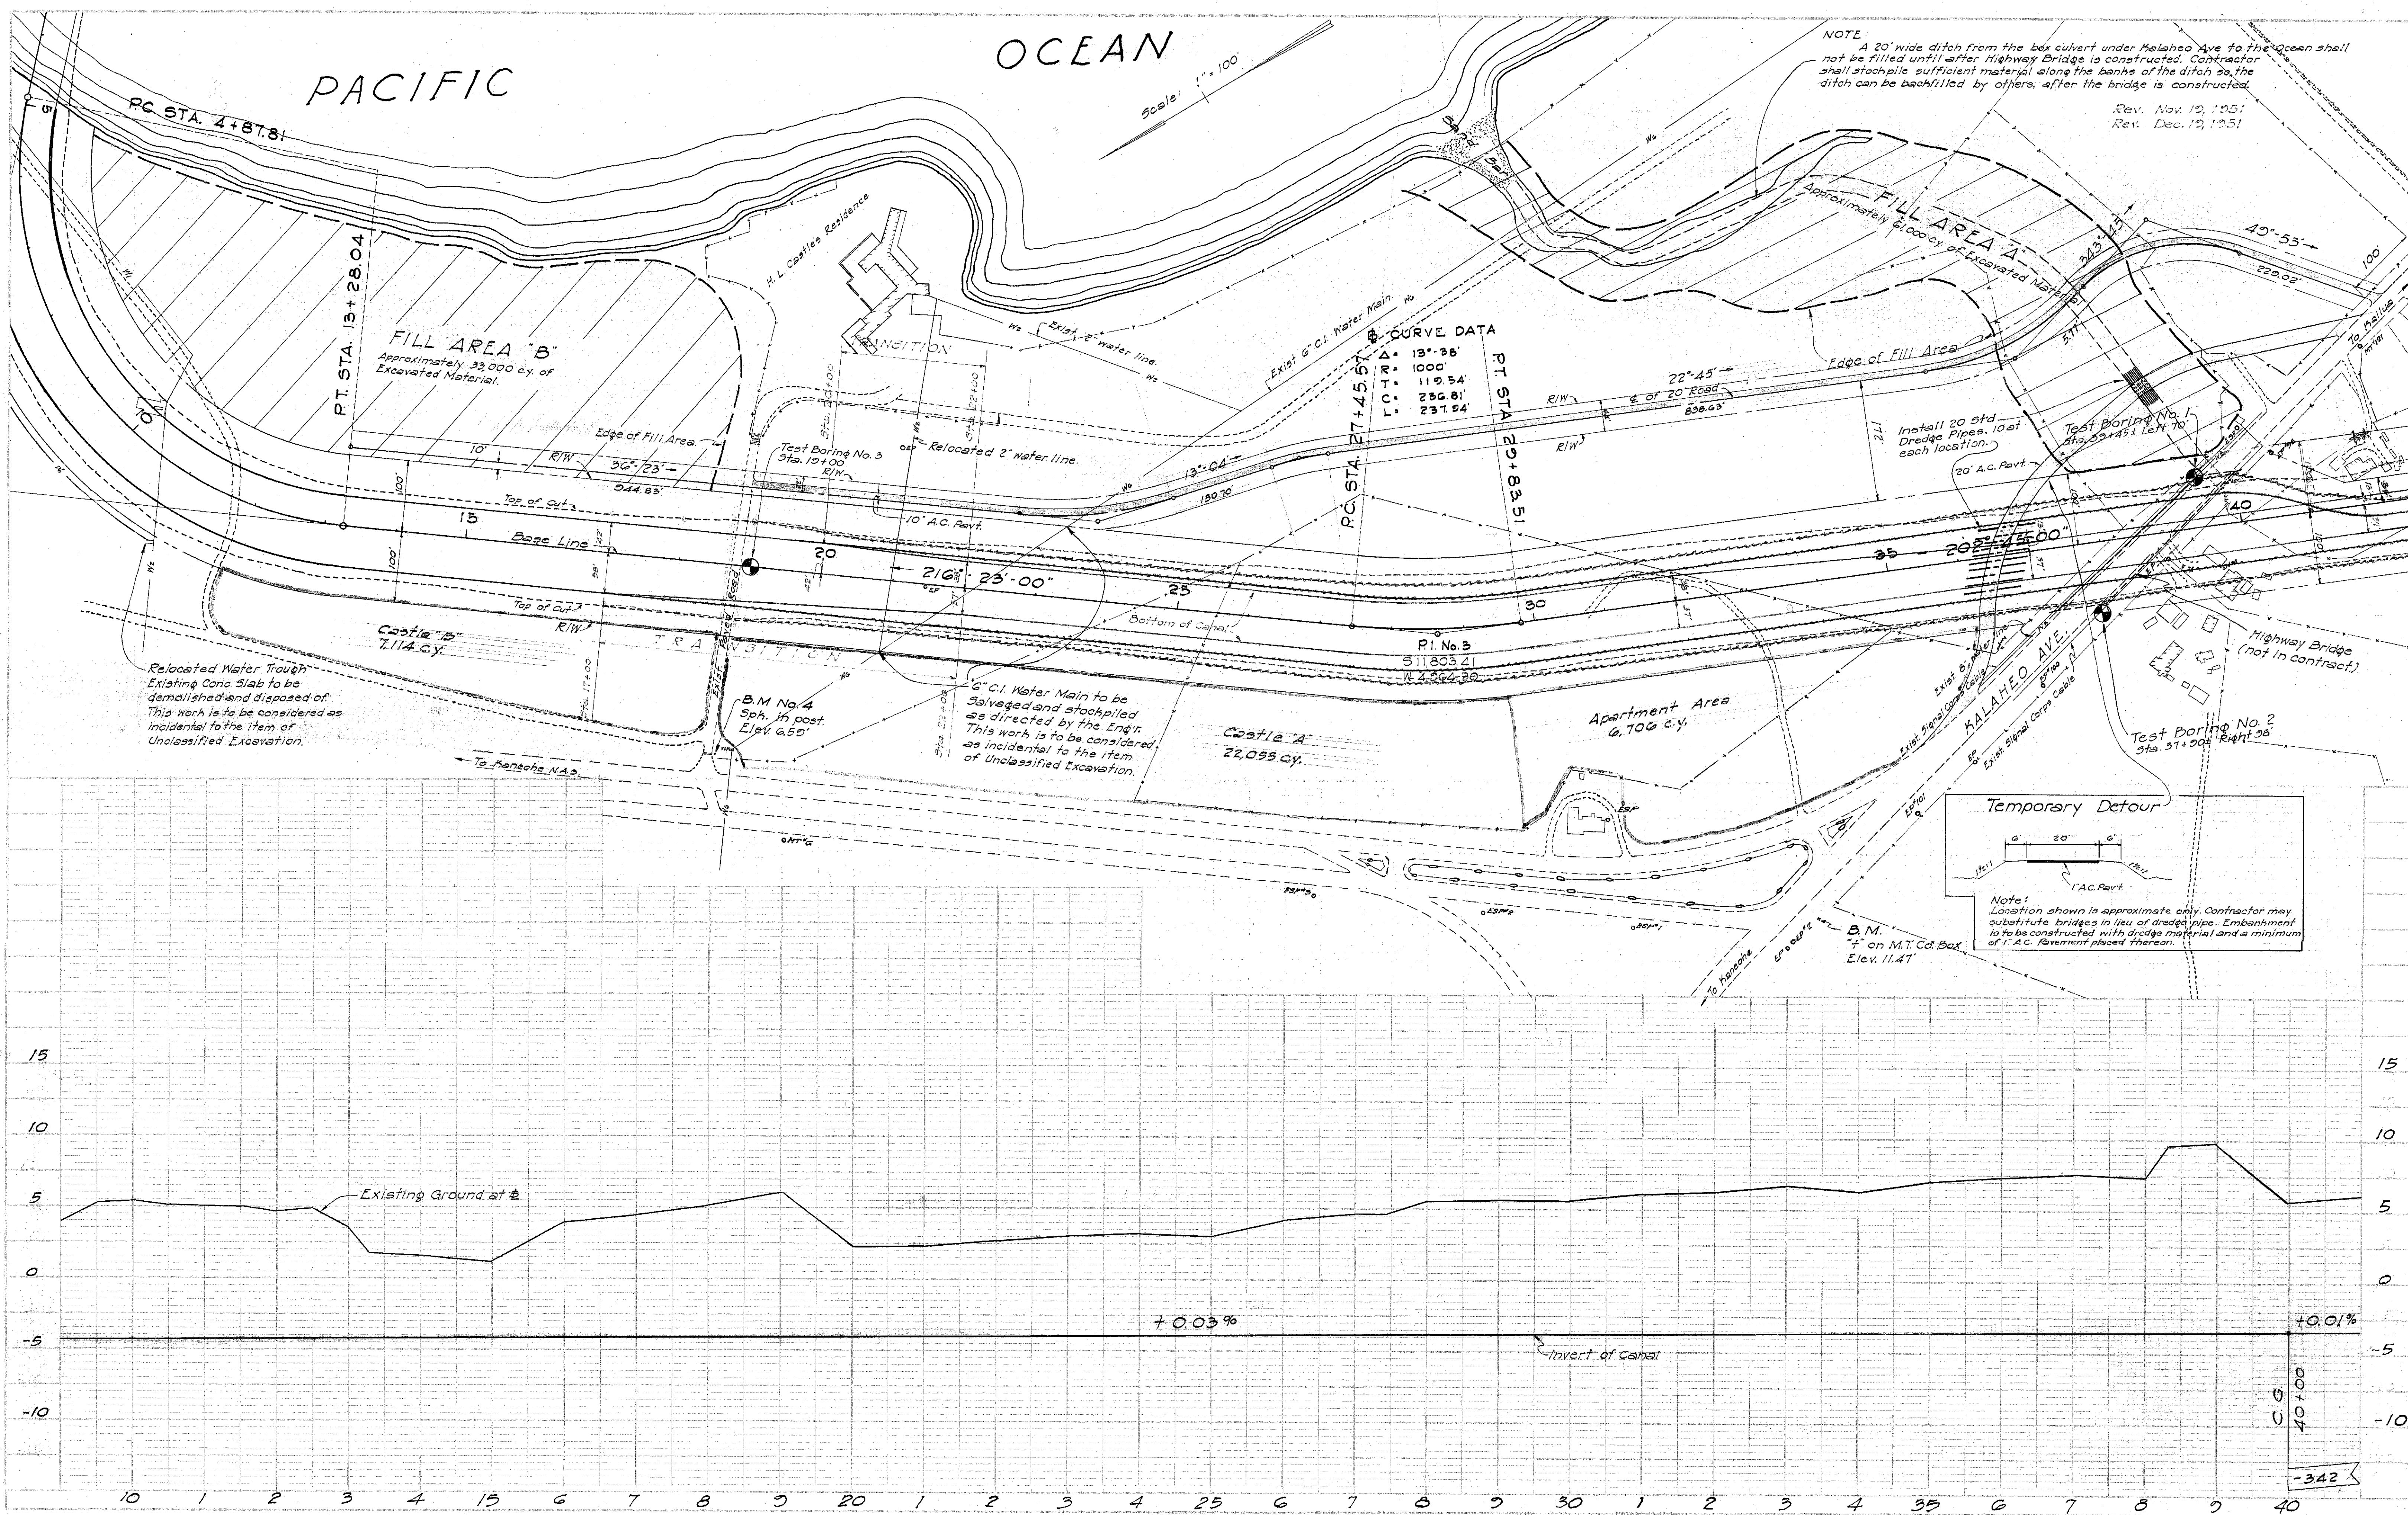

PLAN	DATE	BY
REVISION		
1. AS SHOWN		
2. AS SHOWN		
PROFILE	DATE	BY
REVISION		
1. AS SHOWN		
2. AS SHOWN		
3. AS SHOWN		
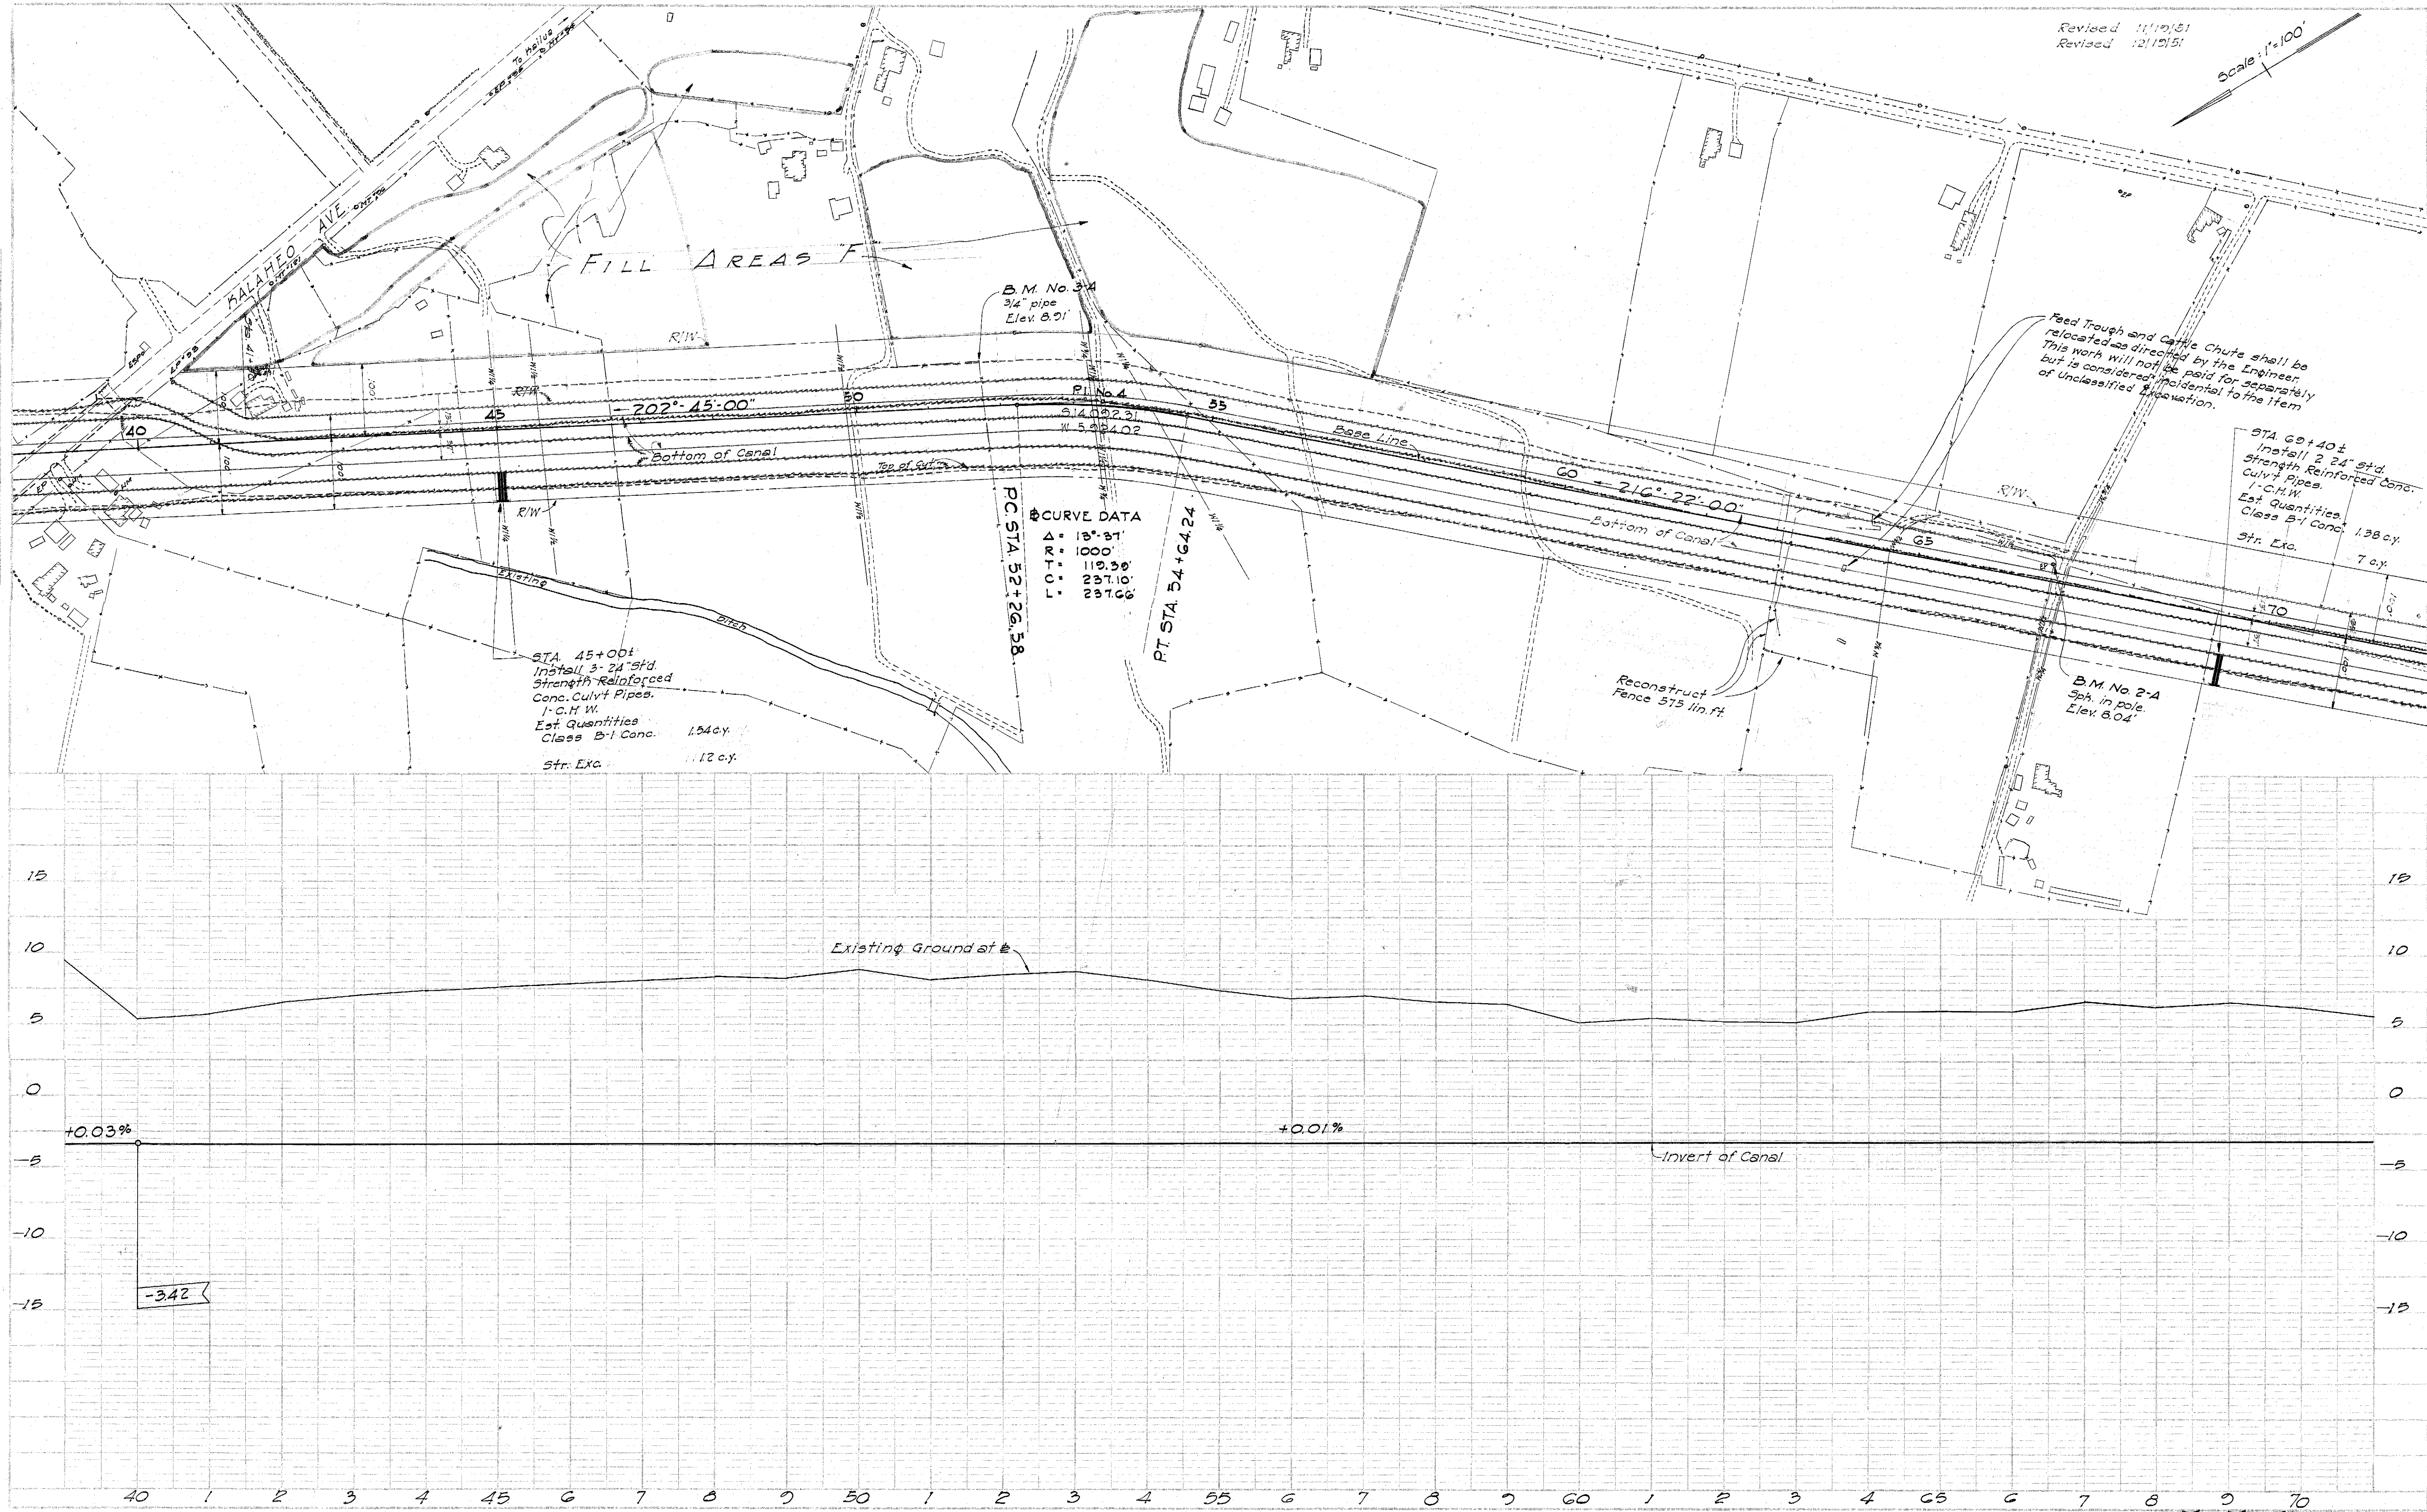


PLATE 1-PLAN-PROFILE 11/12/51 E. E. STANLEY
NEW YORK & ESSAY CO., NEW YORK

K & E Co., Inc. 34-11-10

5566.5

DATE	
BY	
CHECKED	
APPROVED	
REVISIONS	
1. SITE WORK - INCOMPLETE	
2. SITE WORK - INCOMPLETE	
3. SITE WORK - INCOMPLETE	
4. SITE WORK - INCOMPLETE	
5. SITE WORK - INCOMPLETE	
6. SITE WORK - INCOMPLETE	
7. SITE WORK - INCOMPLETE	
8. SITE WORK - INCOMPLETE	
9. SITE WORK - INCOMPLETE	
10. SITE WORK - INCOMPLETE	

DATE	
BY	
CHECKED	
APPROVED	
REVISIONS	
1. SITE WORK - INCOMPLETE	
2. SITE WORK - INCOMPLETE	
3. SITE WORK - INCOMPLETE	
4. SITE WORK - INCOMPLETE	
5. SITE WORK - INCOMPLETE	
6. SITE WORK - INCOMPLETE	
7. SITE WORK - INCOMPLETE	
8. SITE WORK - INCOMPLETE	
9. SITE WORK - INCOMPLETE	
10. SITE WORK - INCOMPLETE	

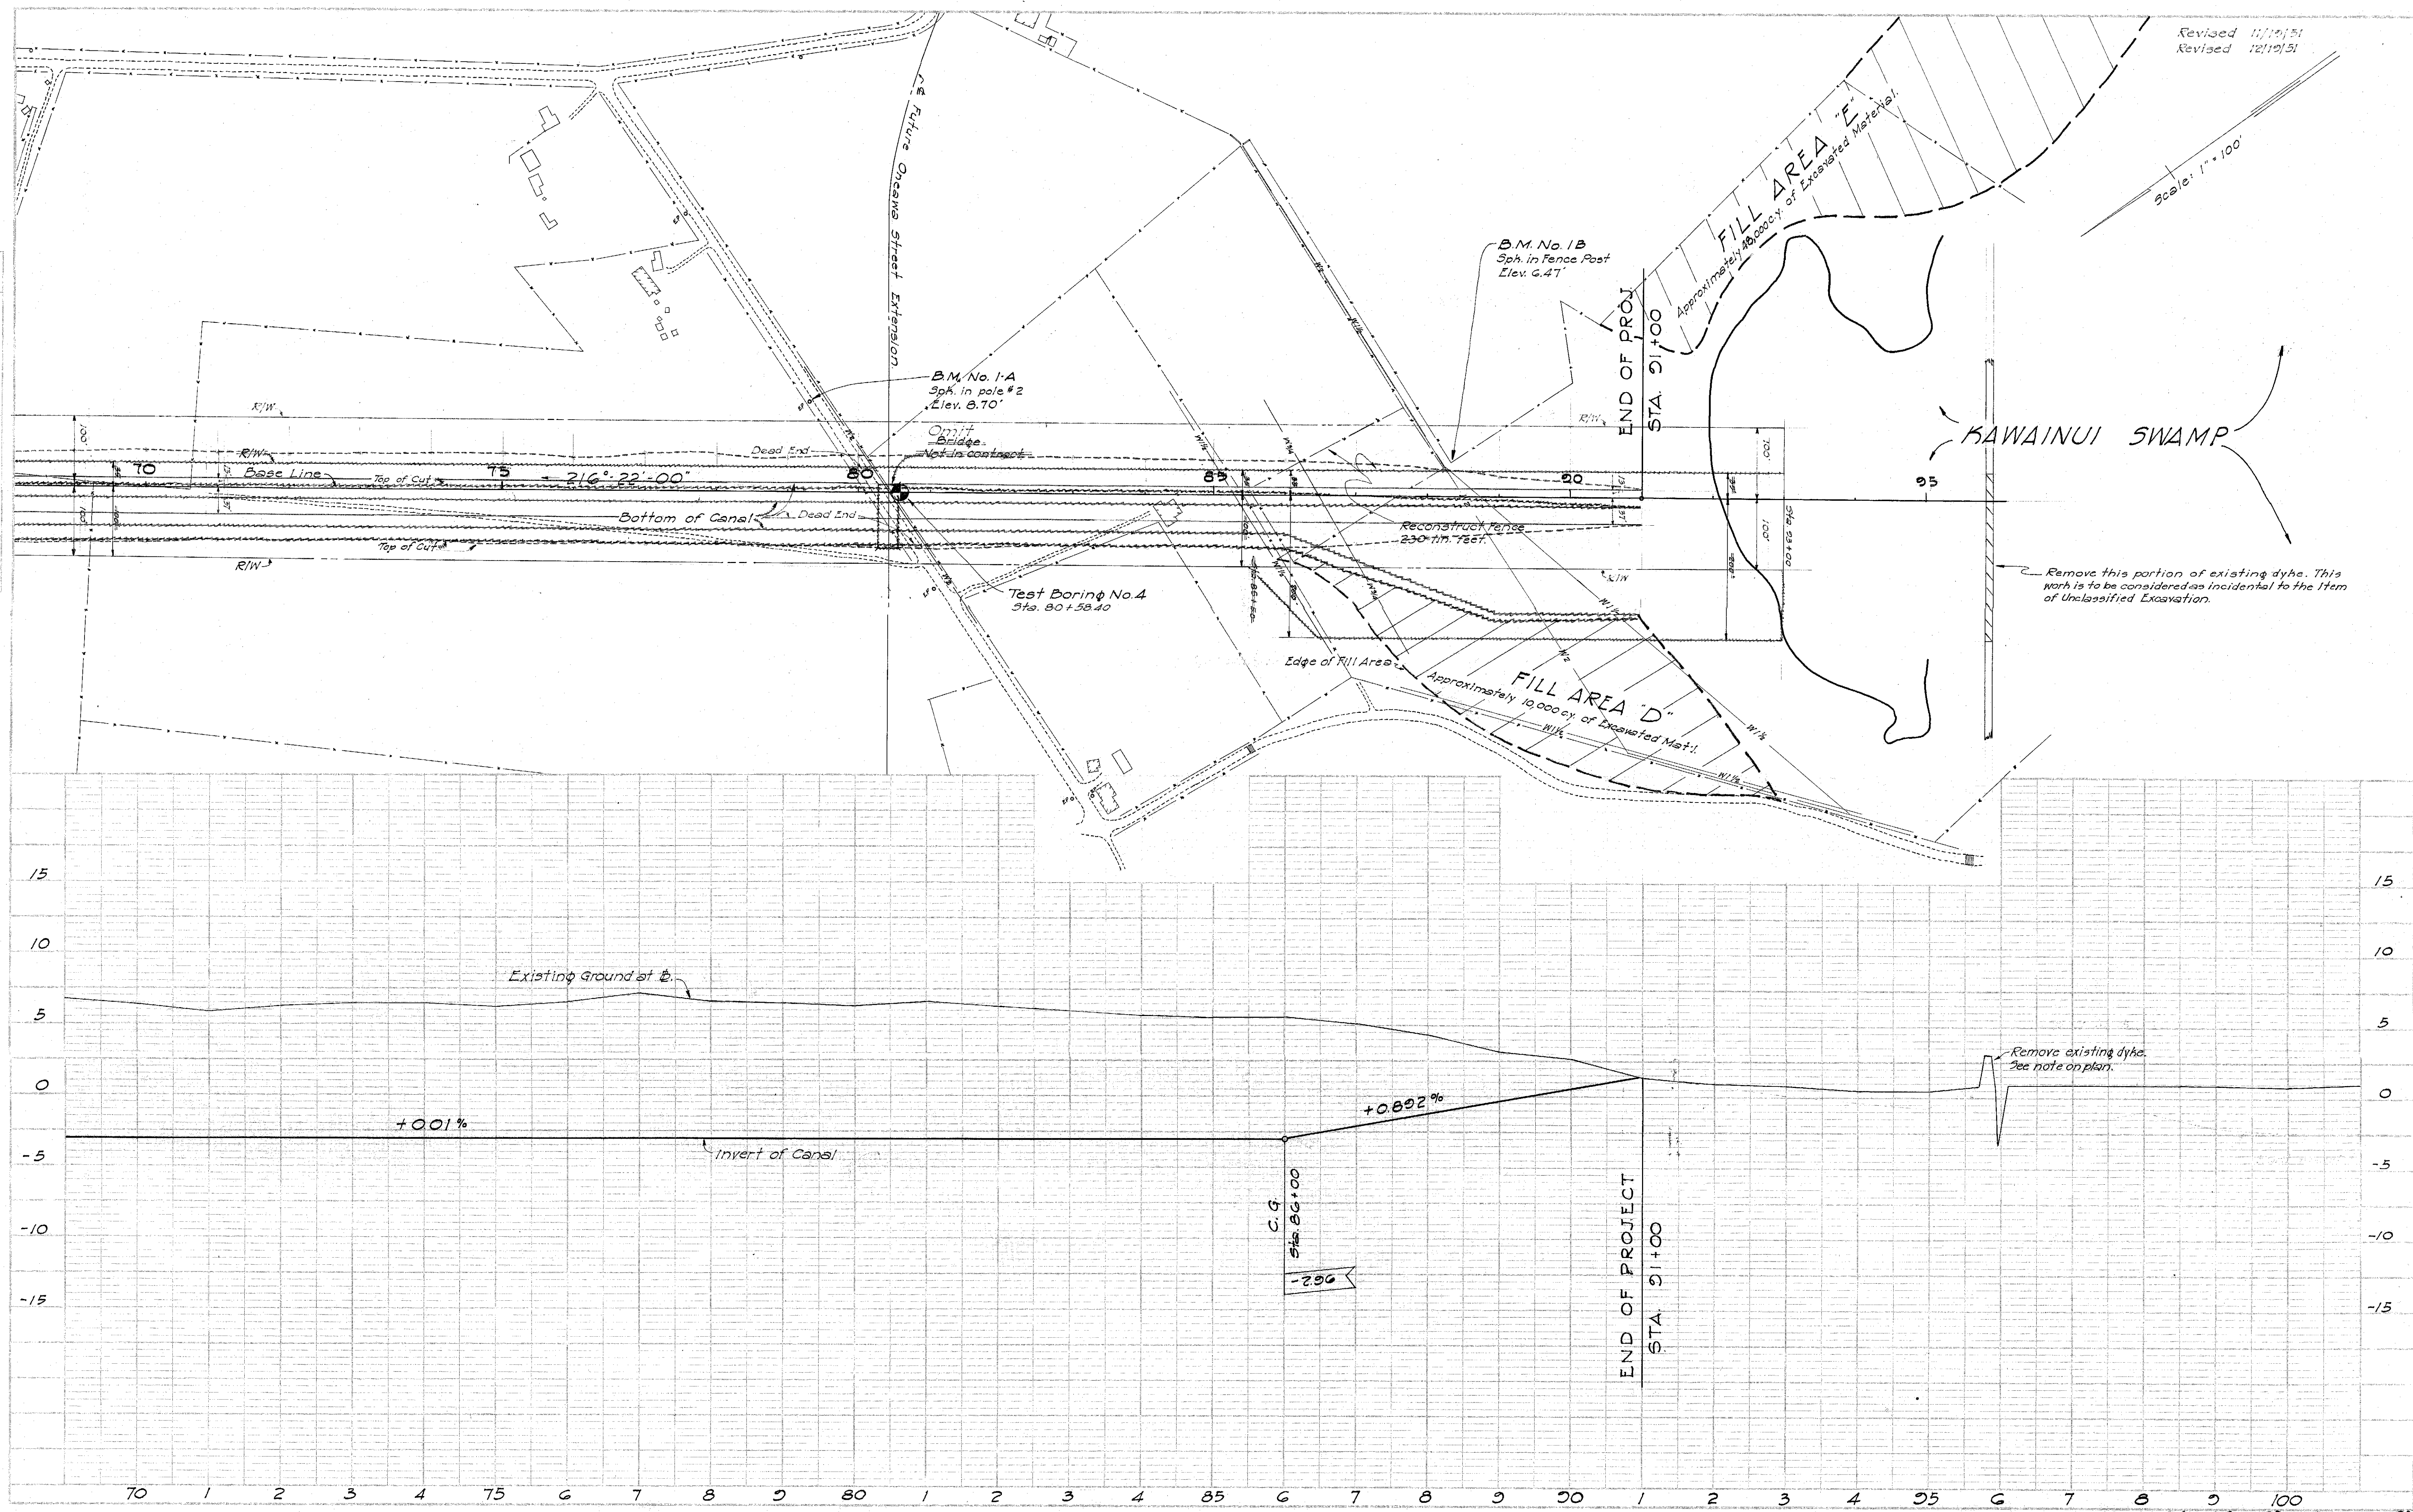


PLATE 1 - PLAN-PROFILE OF R.R. & STANDARD
HUNTLEY & ESSLER CO. NEW YORK

U. S. E. 7th. No. 348-B-10
1/10/51

5566.6