


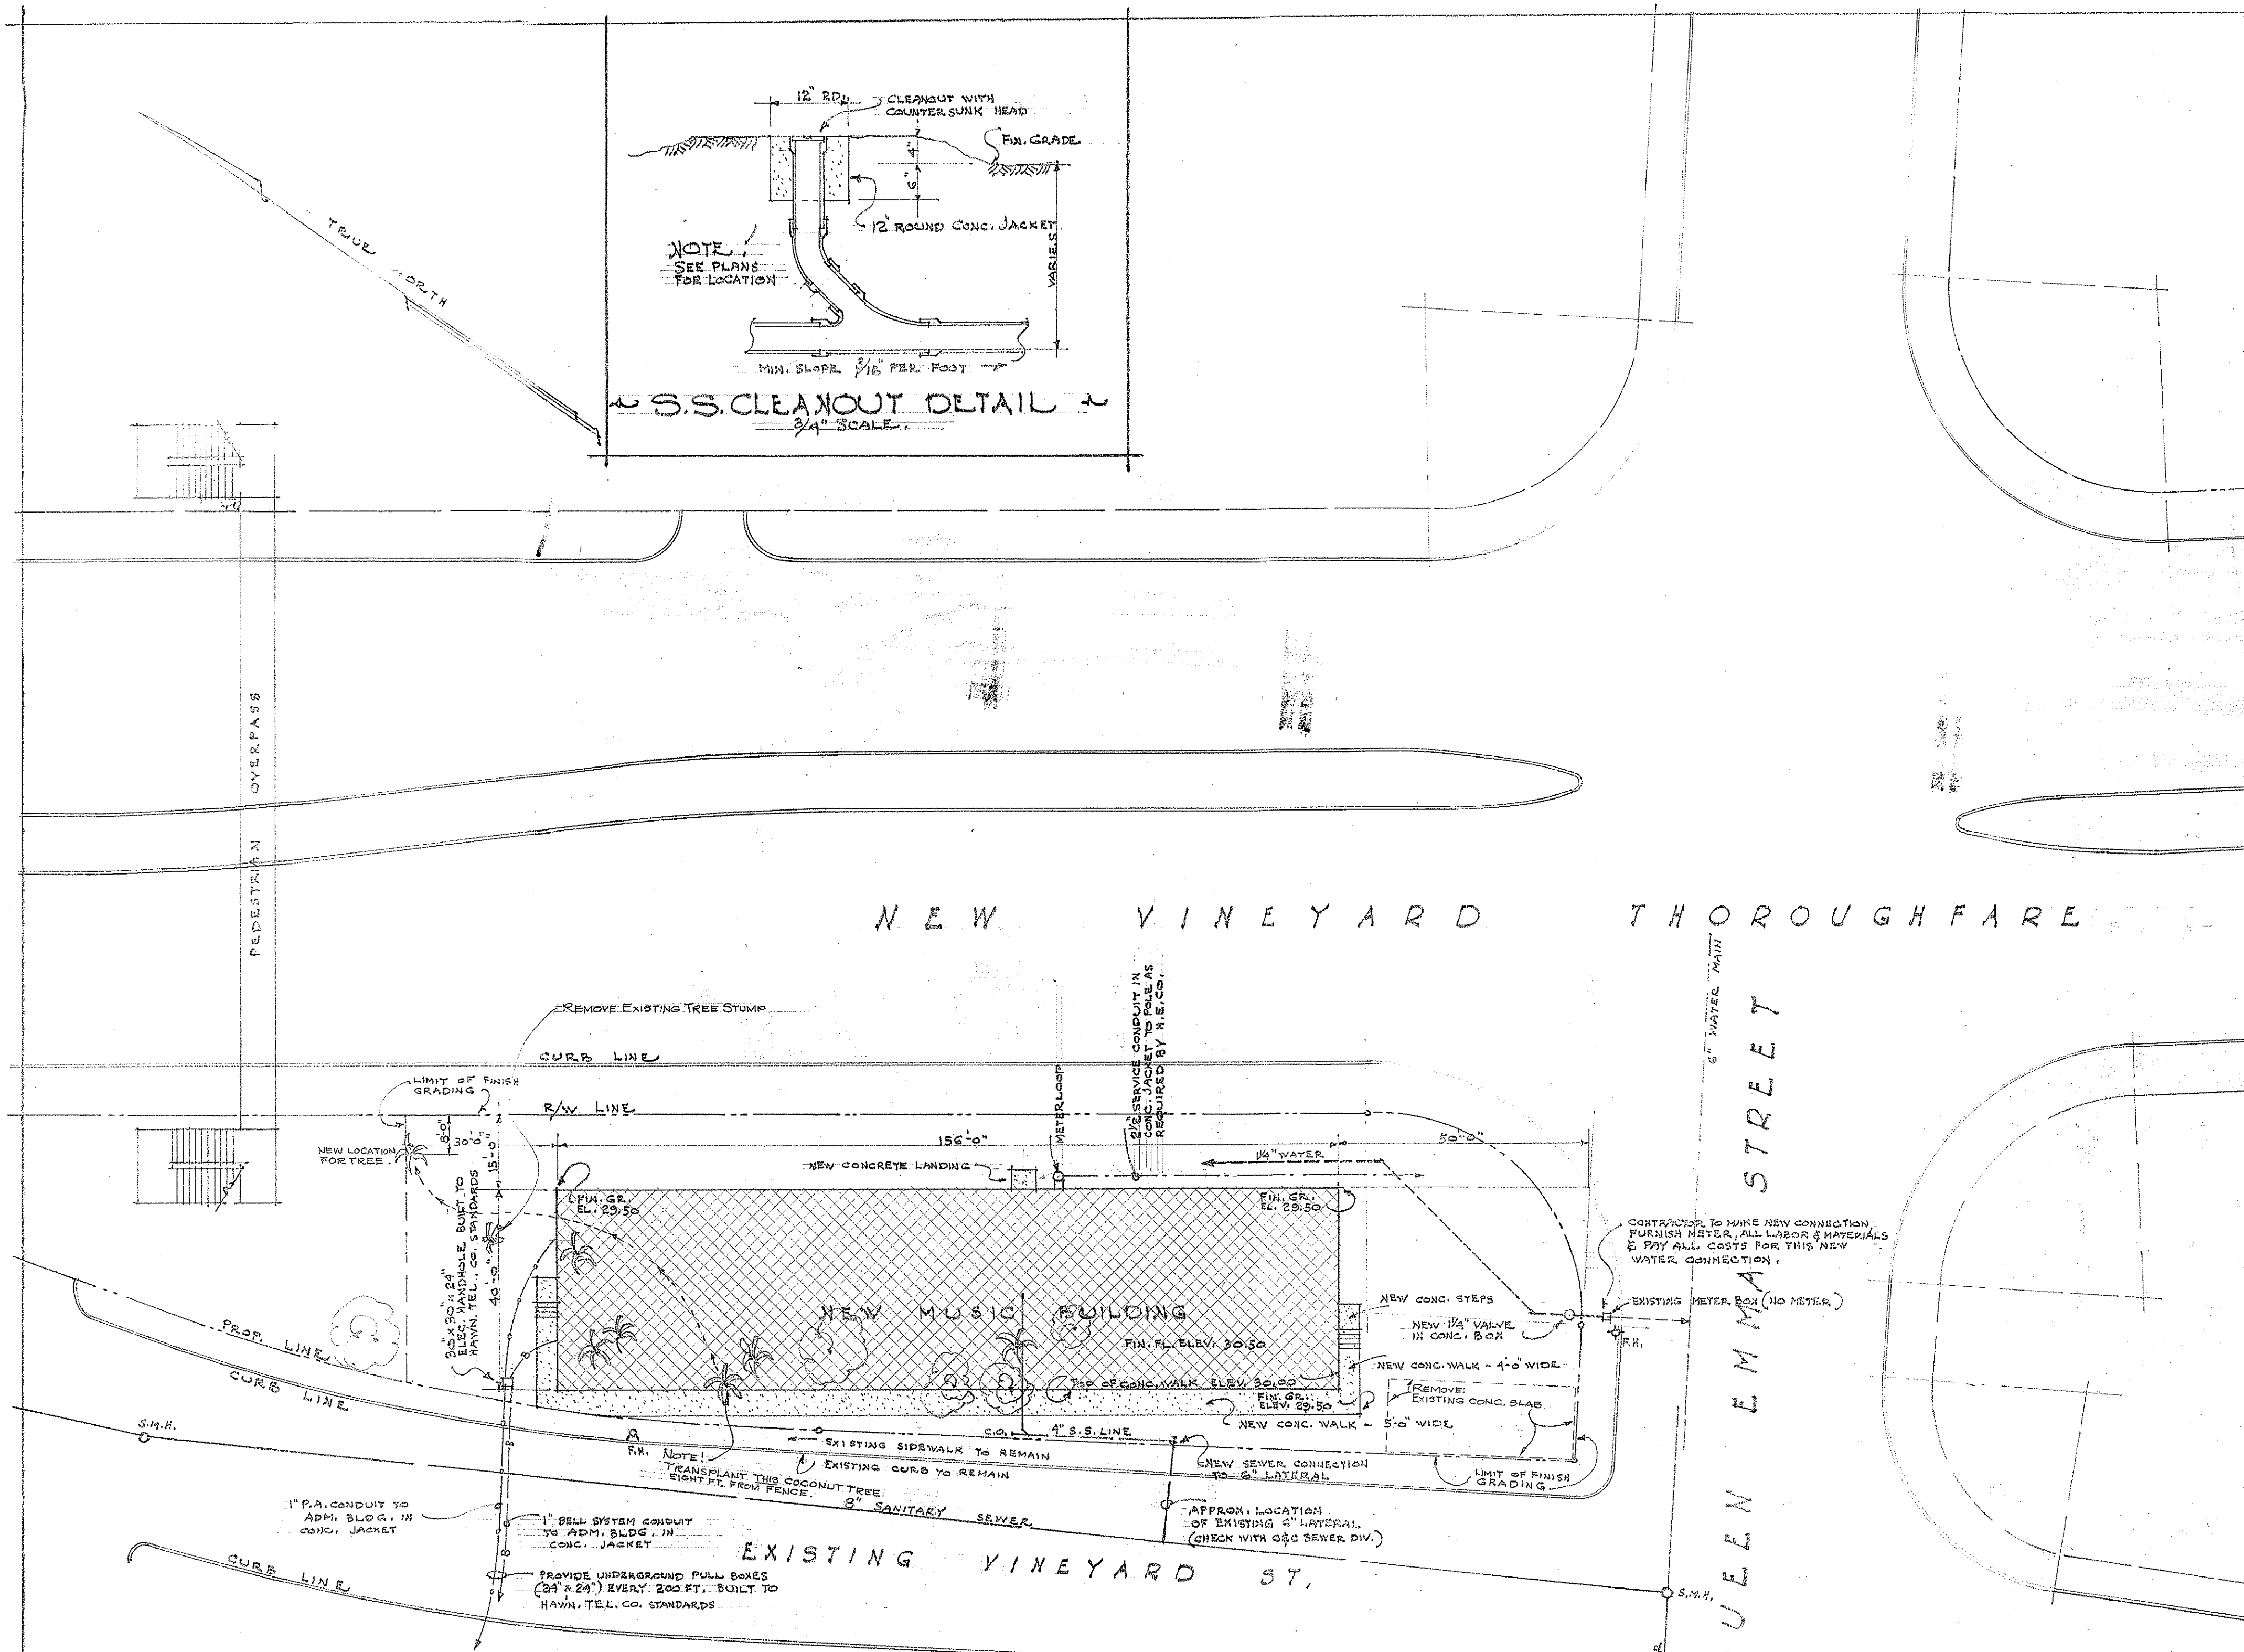


NEW VINEYARD THOROUGHFARE



QUEEN EMMA STREET

EXISTING VINEYARD ST.

~ PLOT PLAN ~
SCALE 1" = 20'

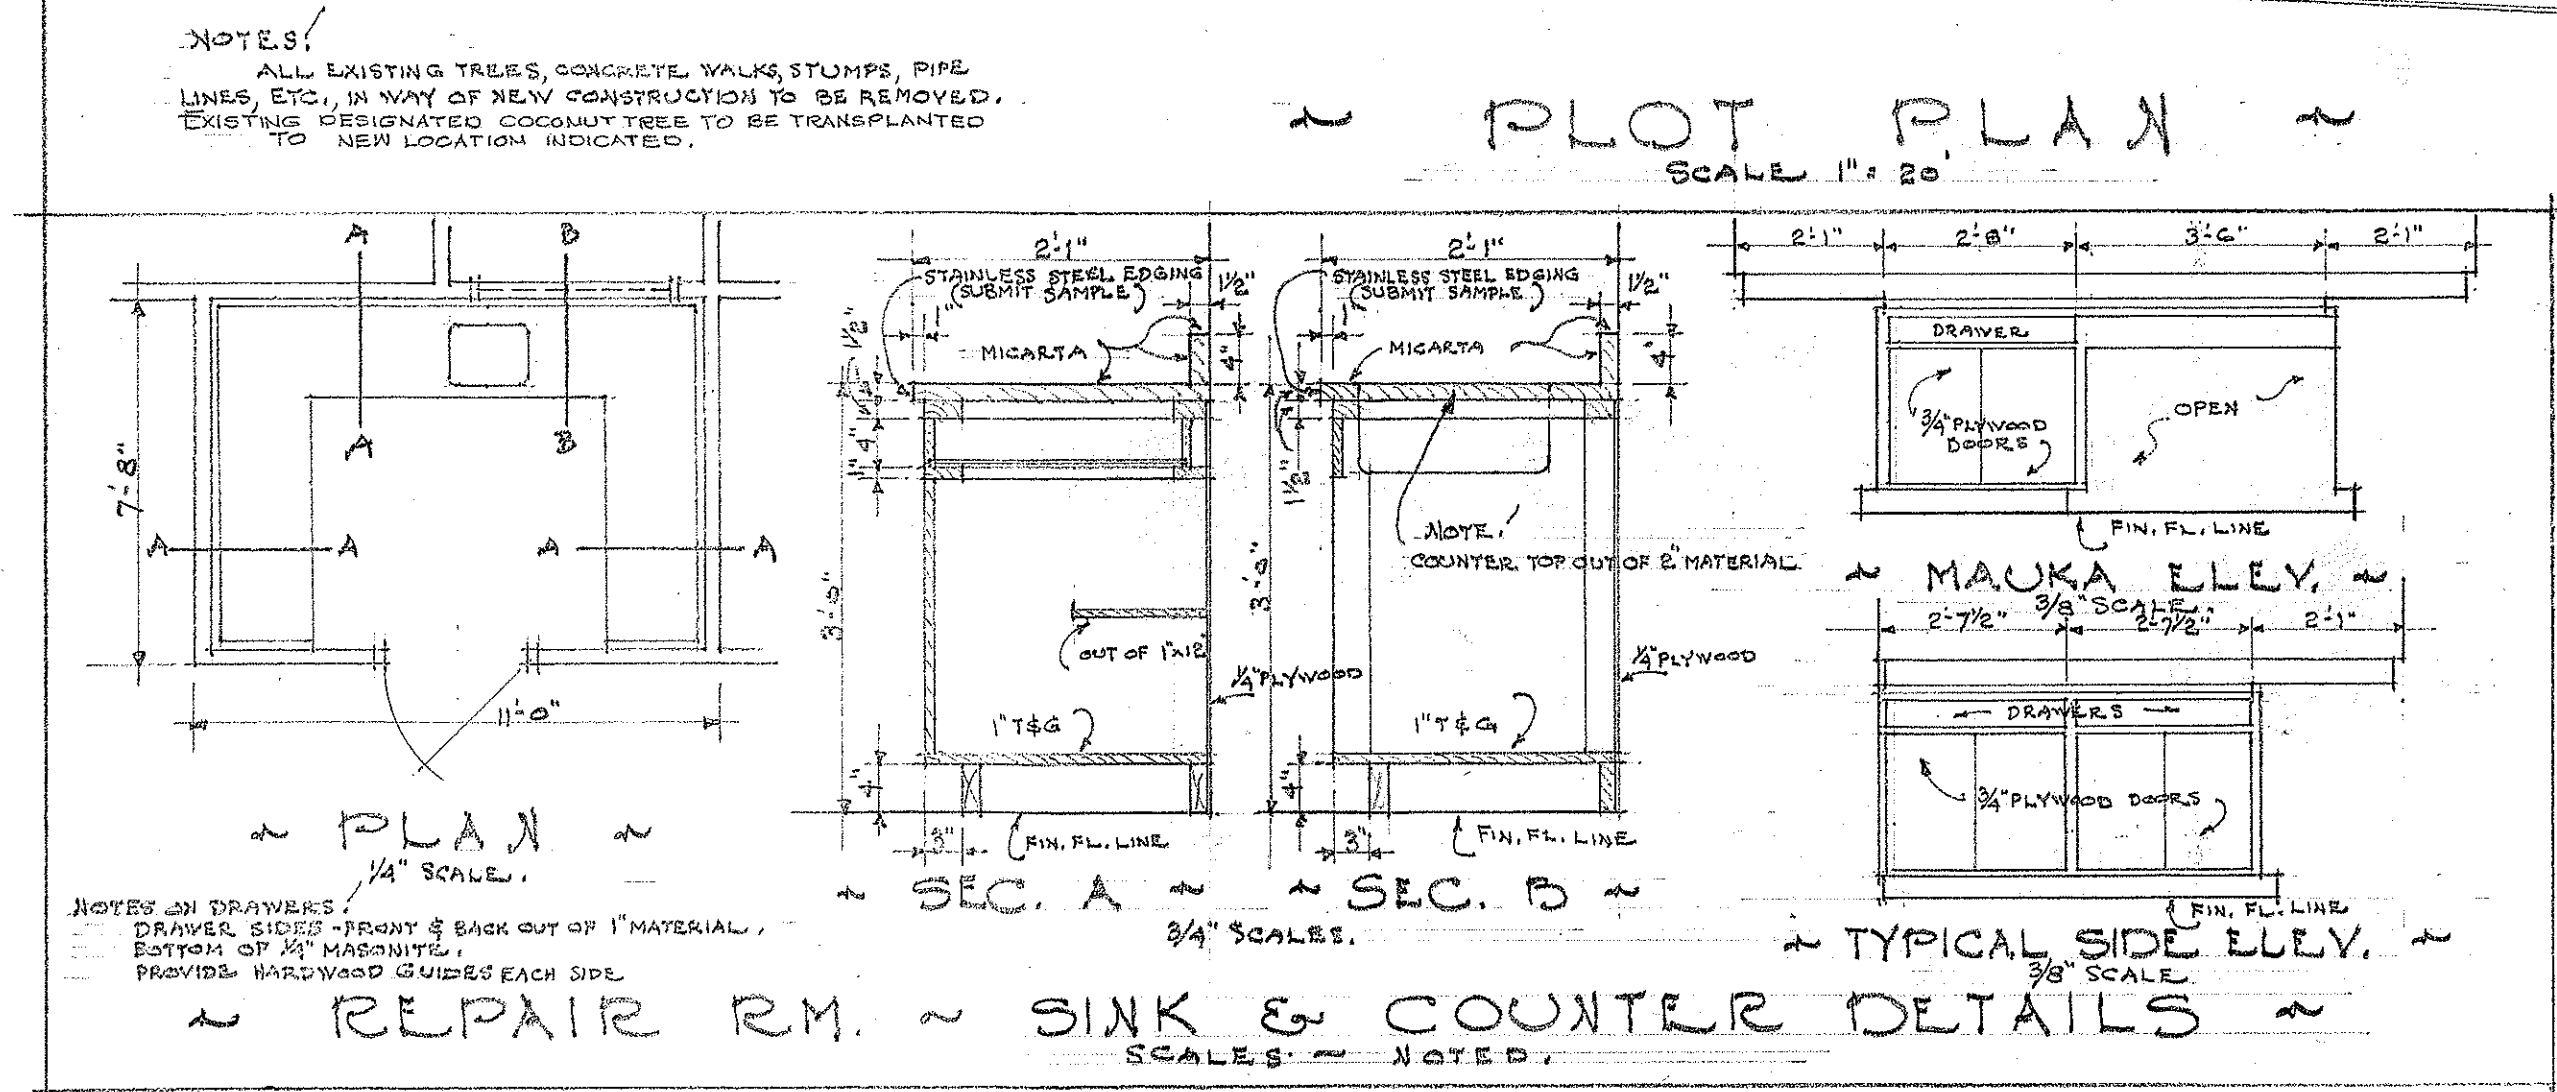

~ S.S. CLEANKUT DETAIL ~
3/4" SCALE

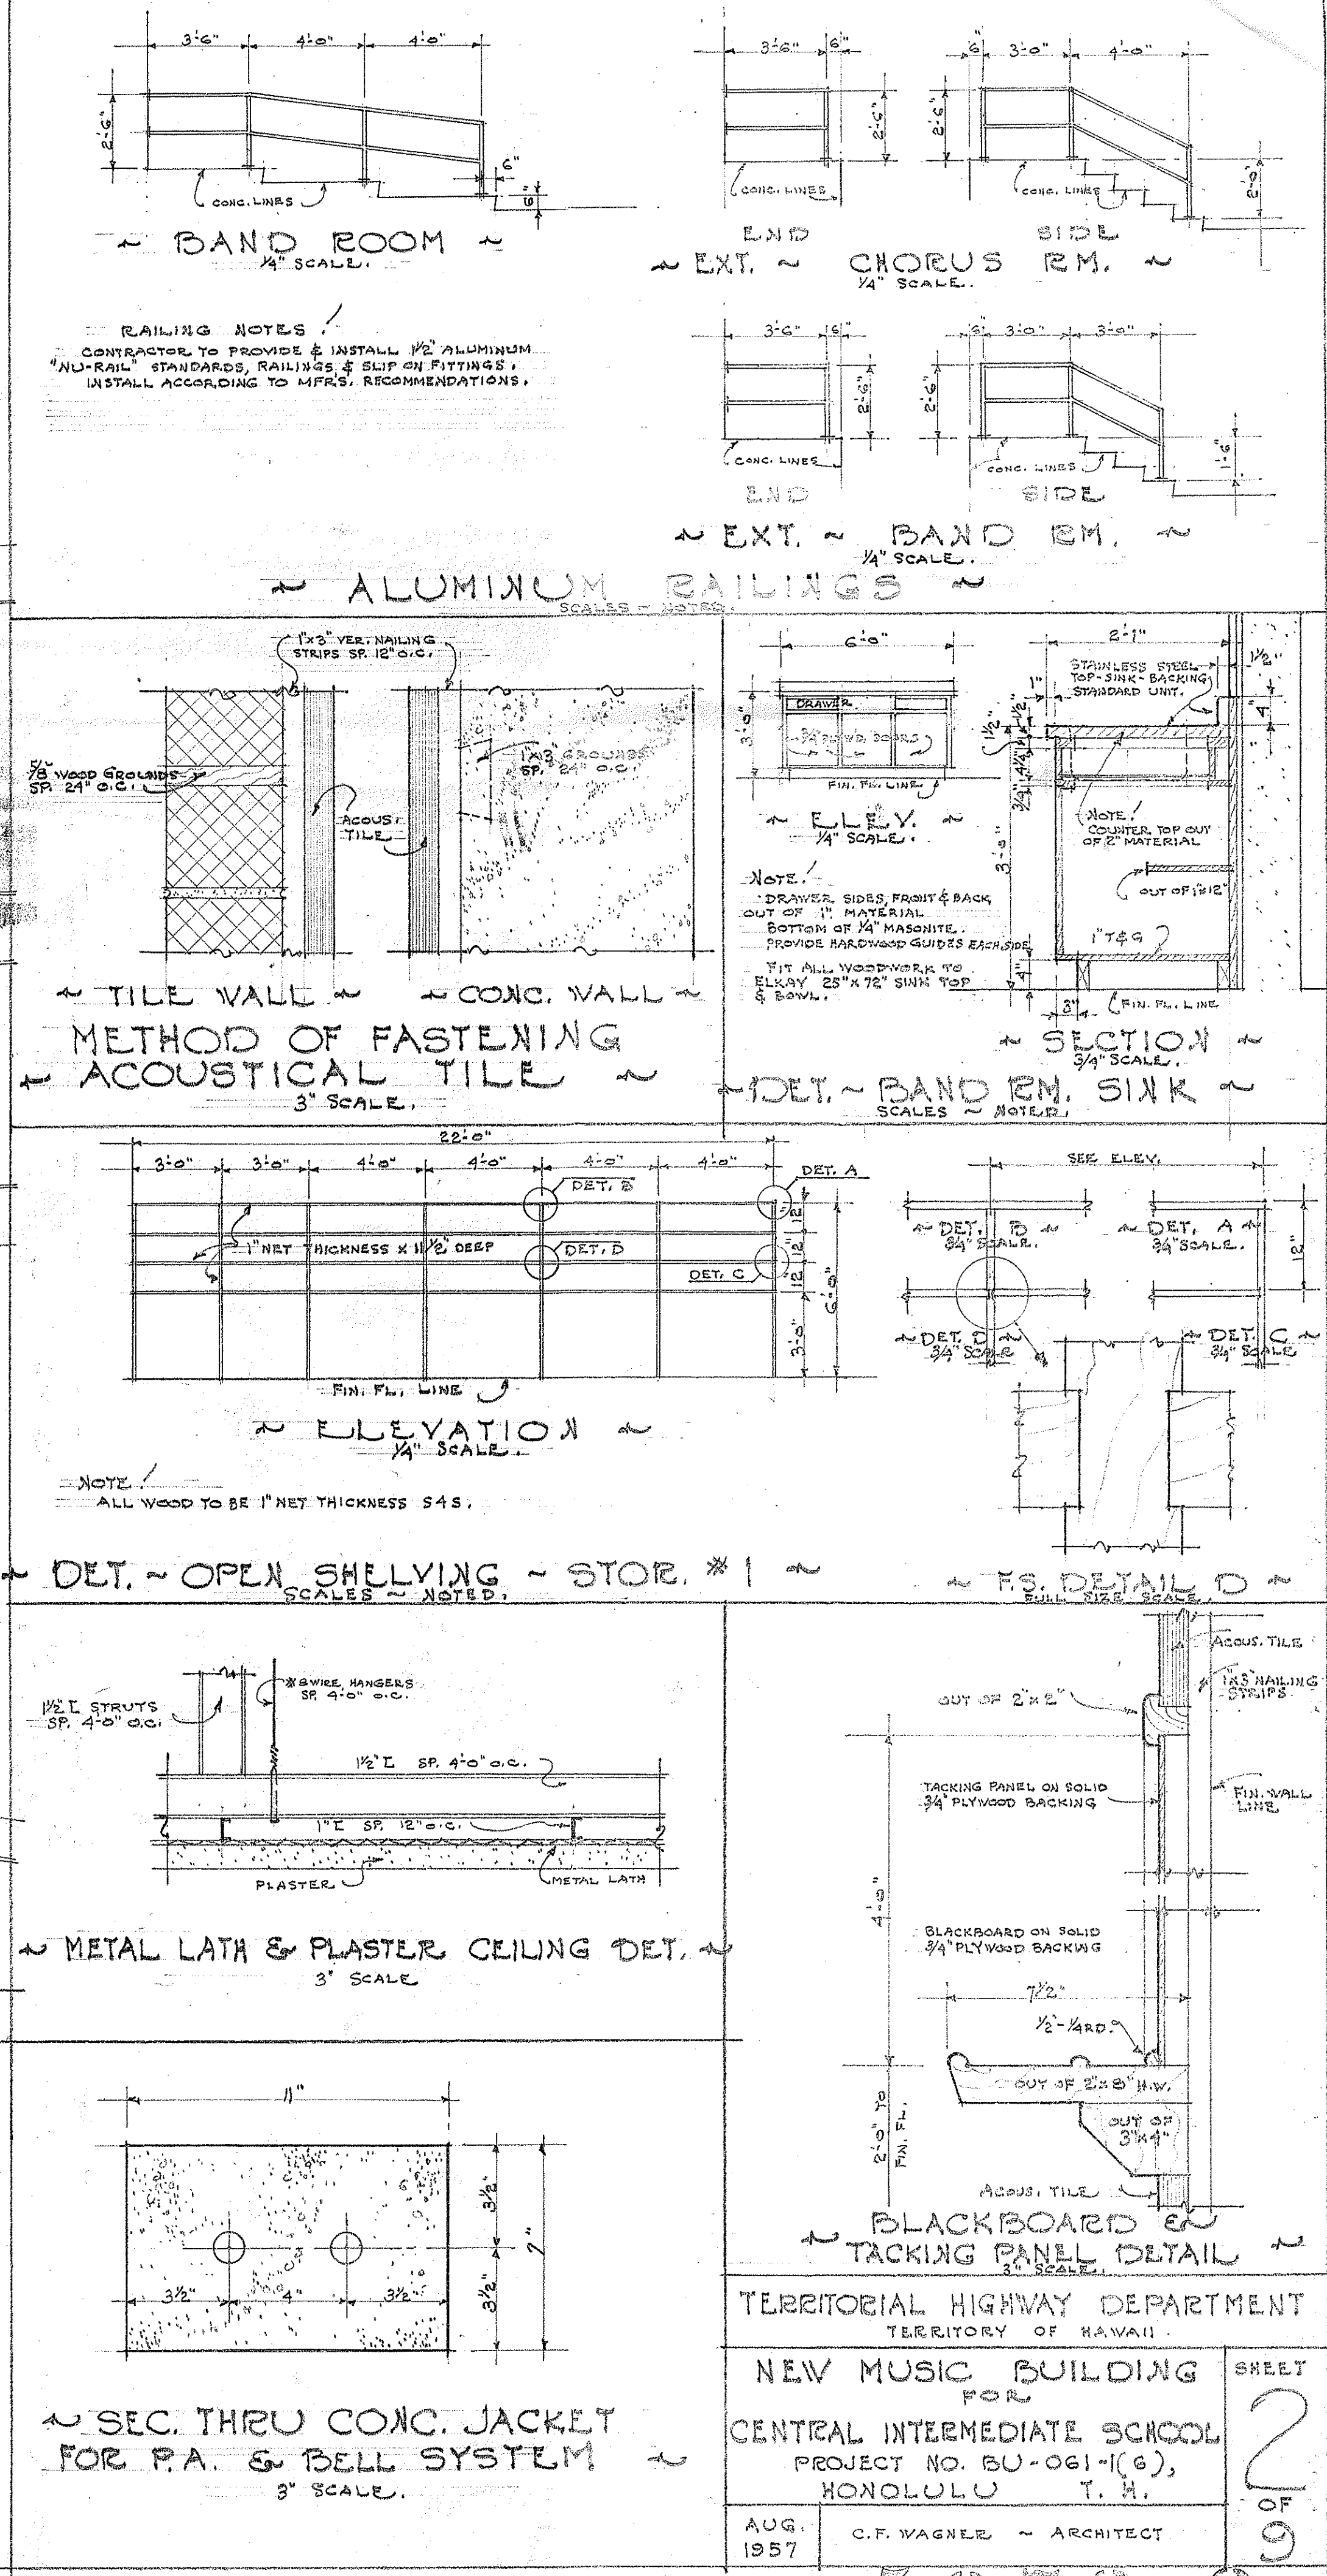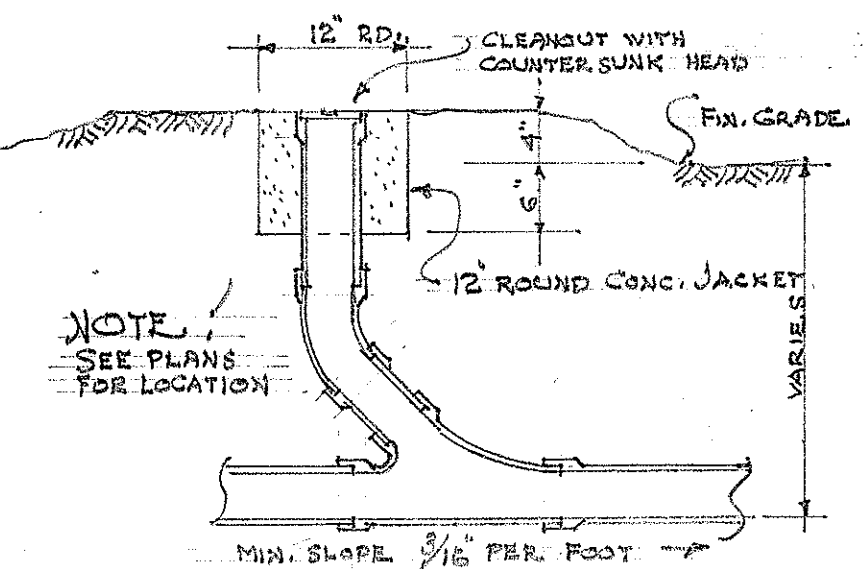

5952.2