

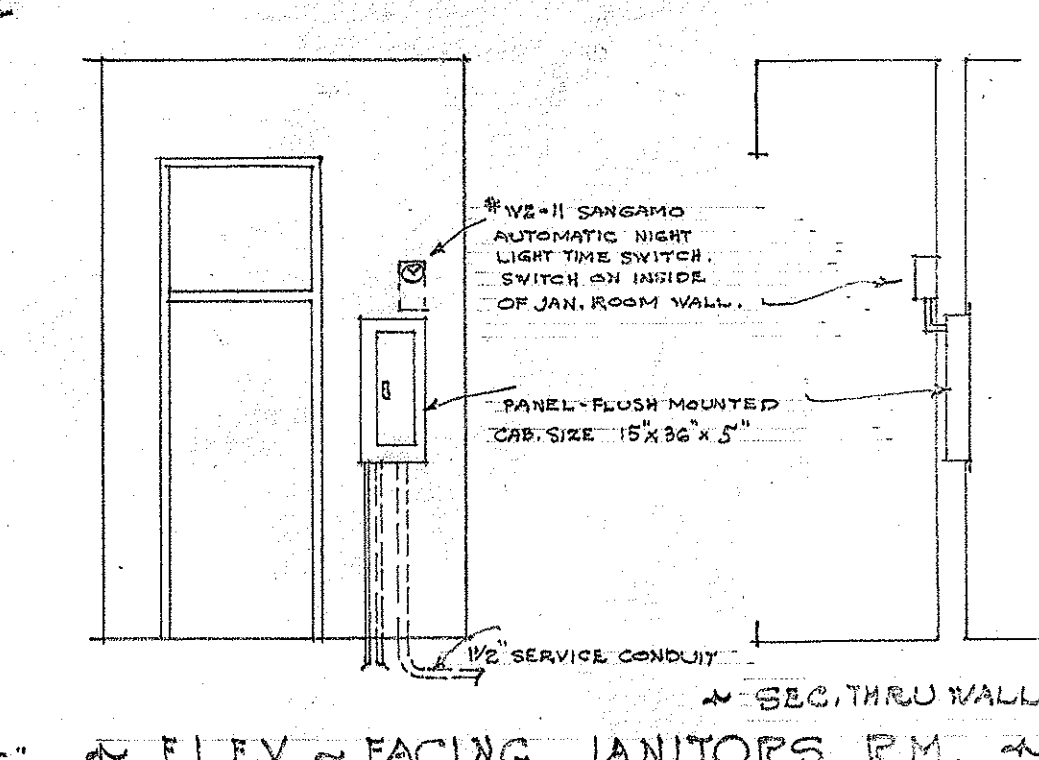
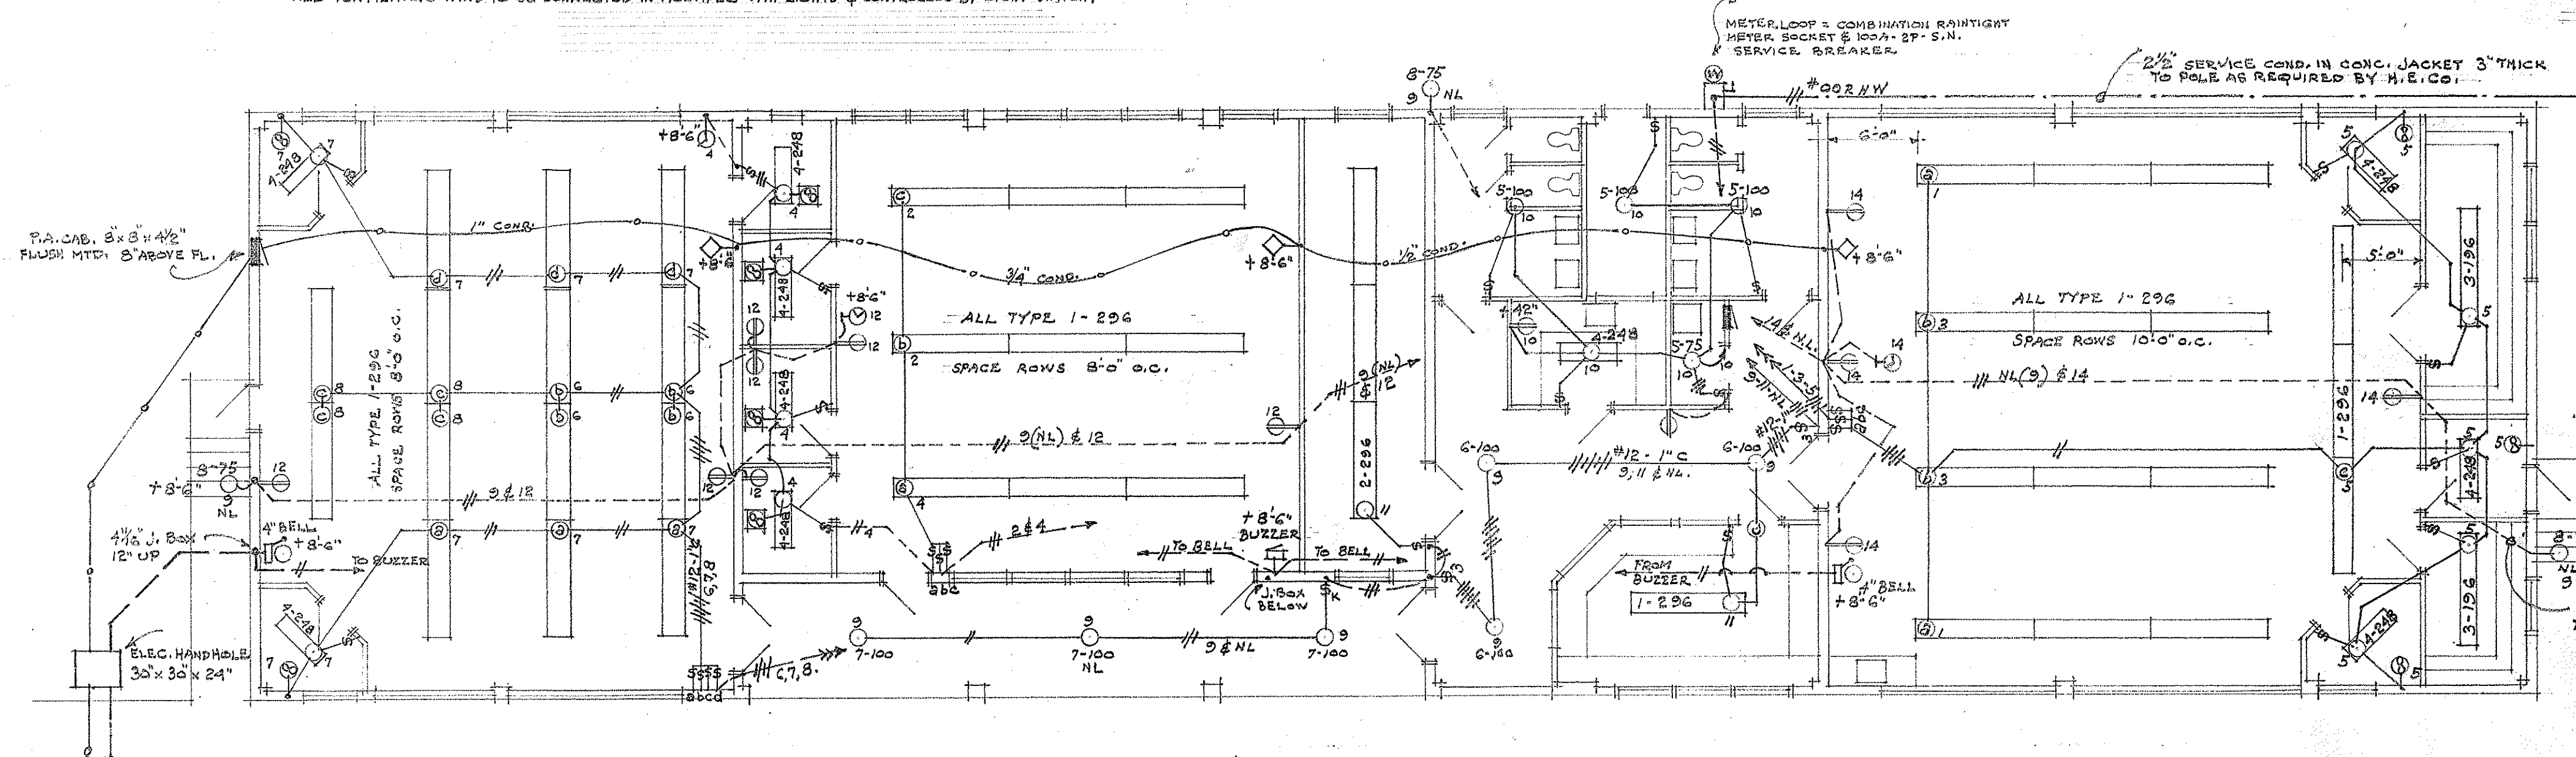
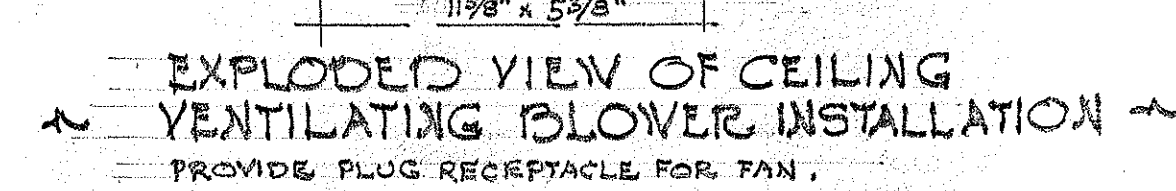
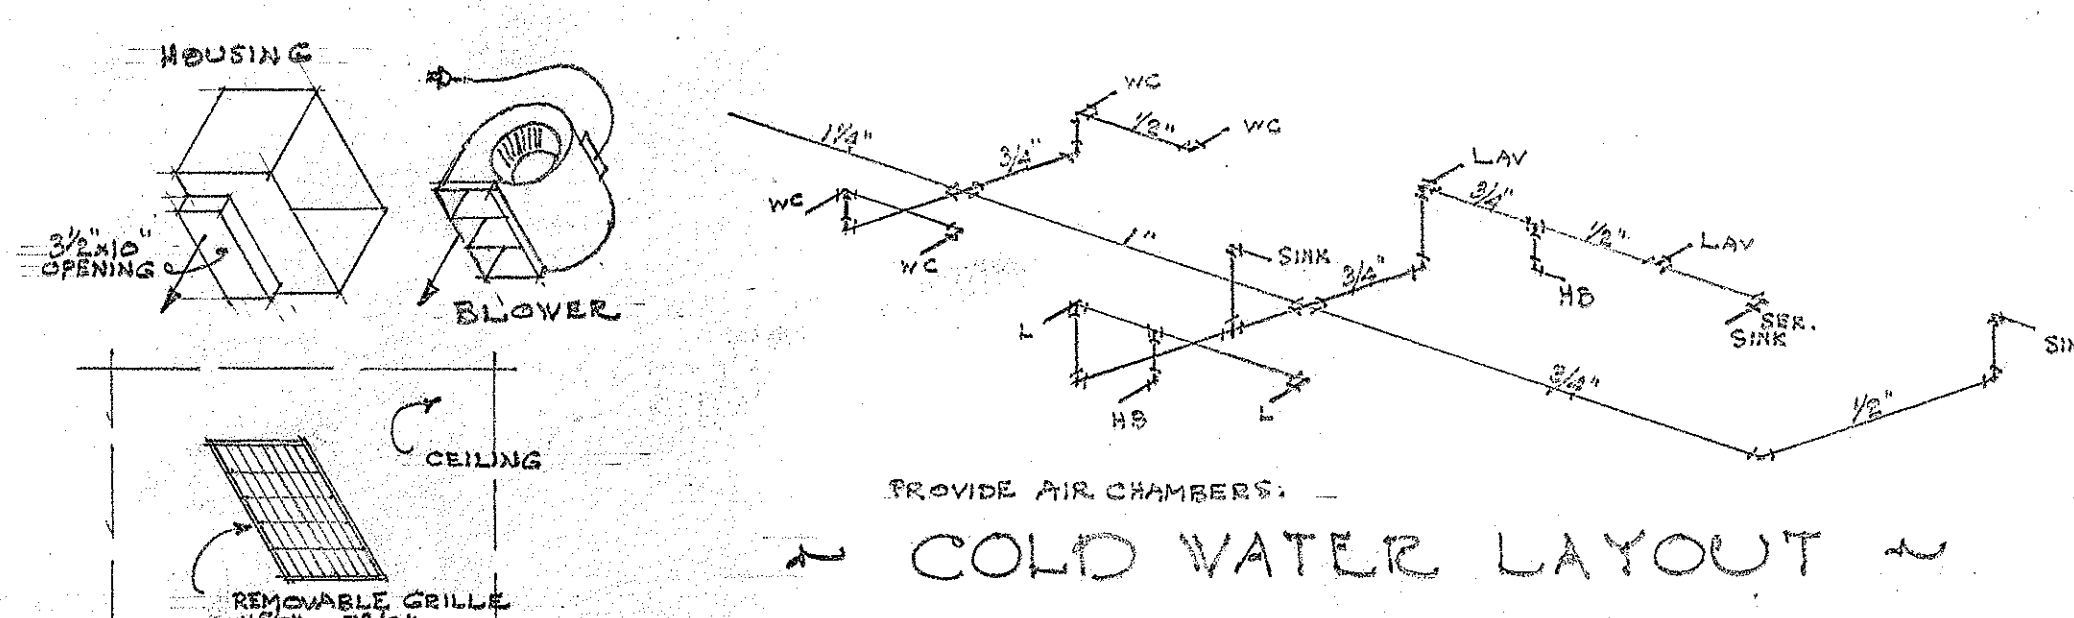
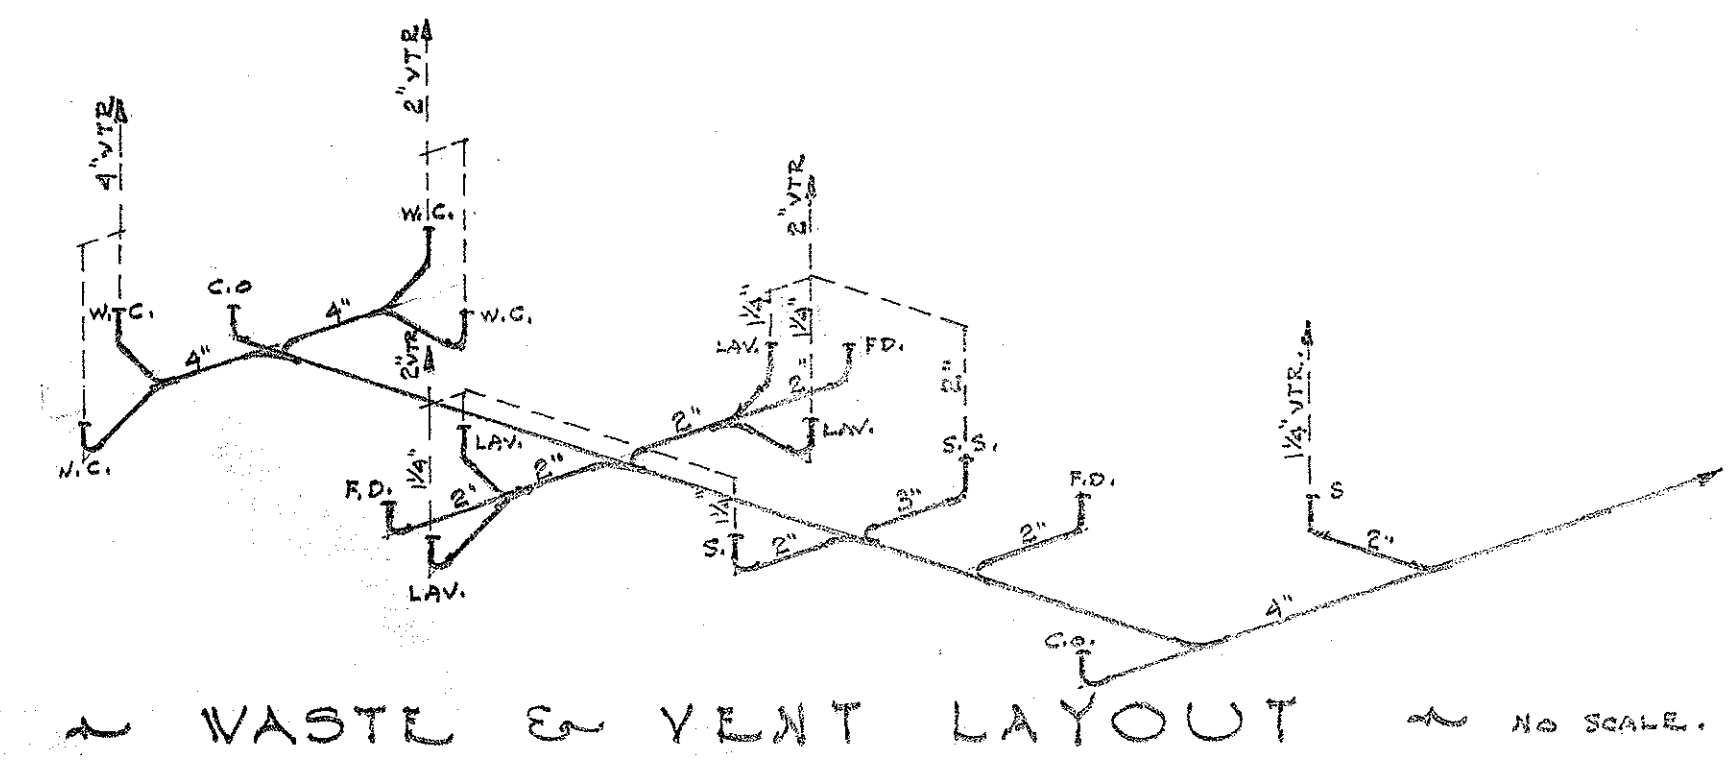


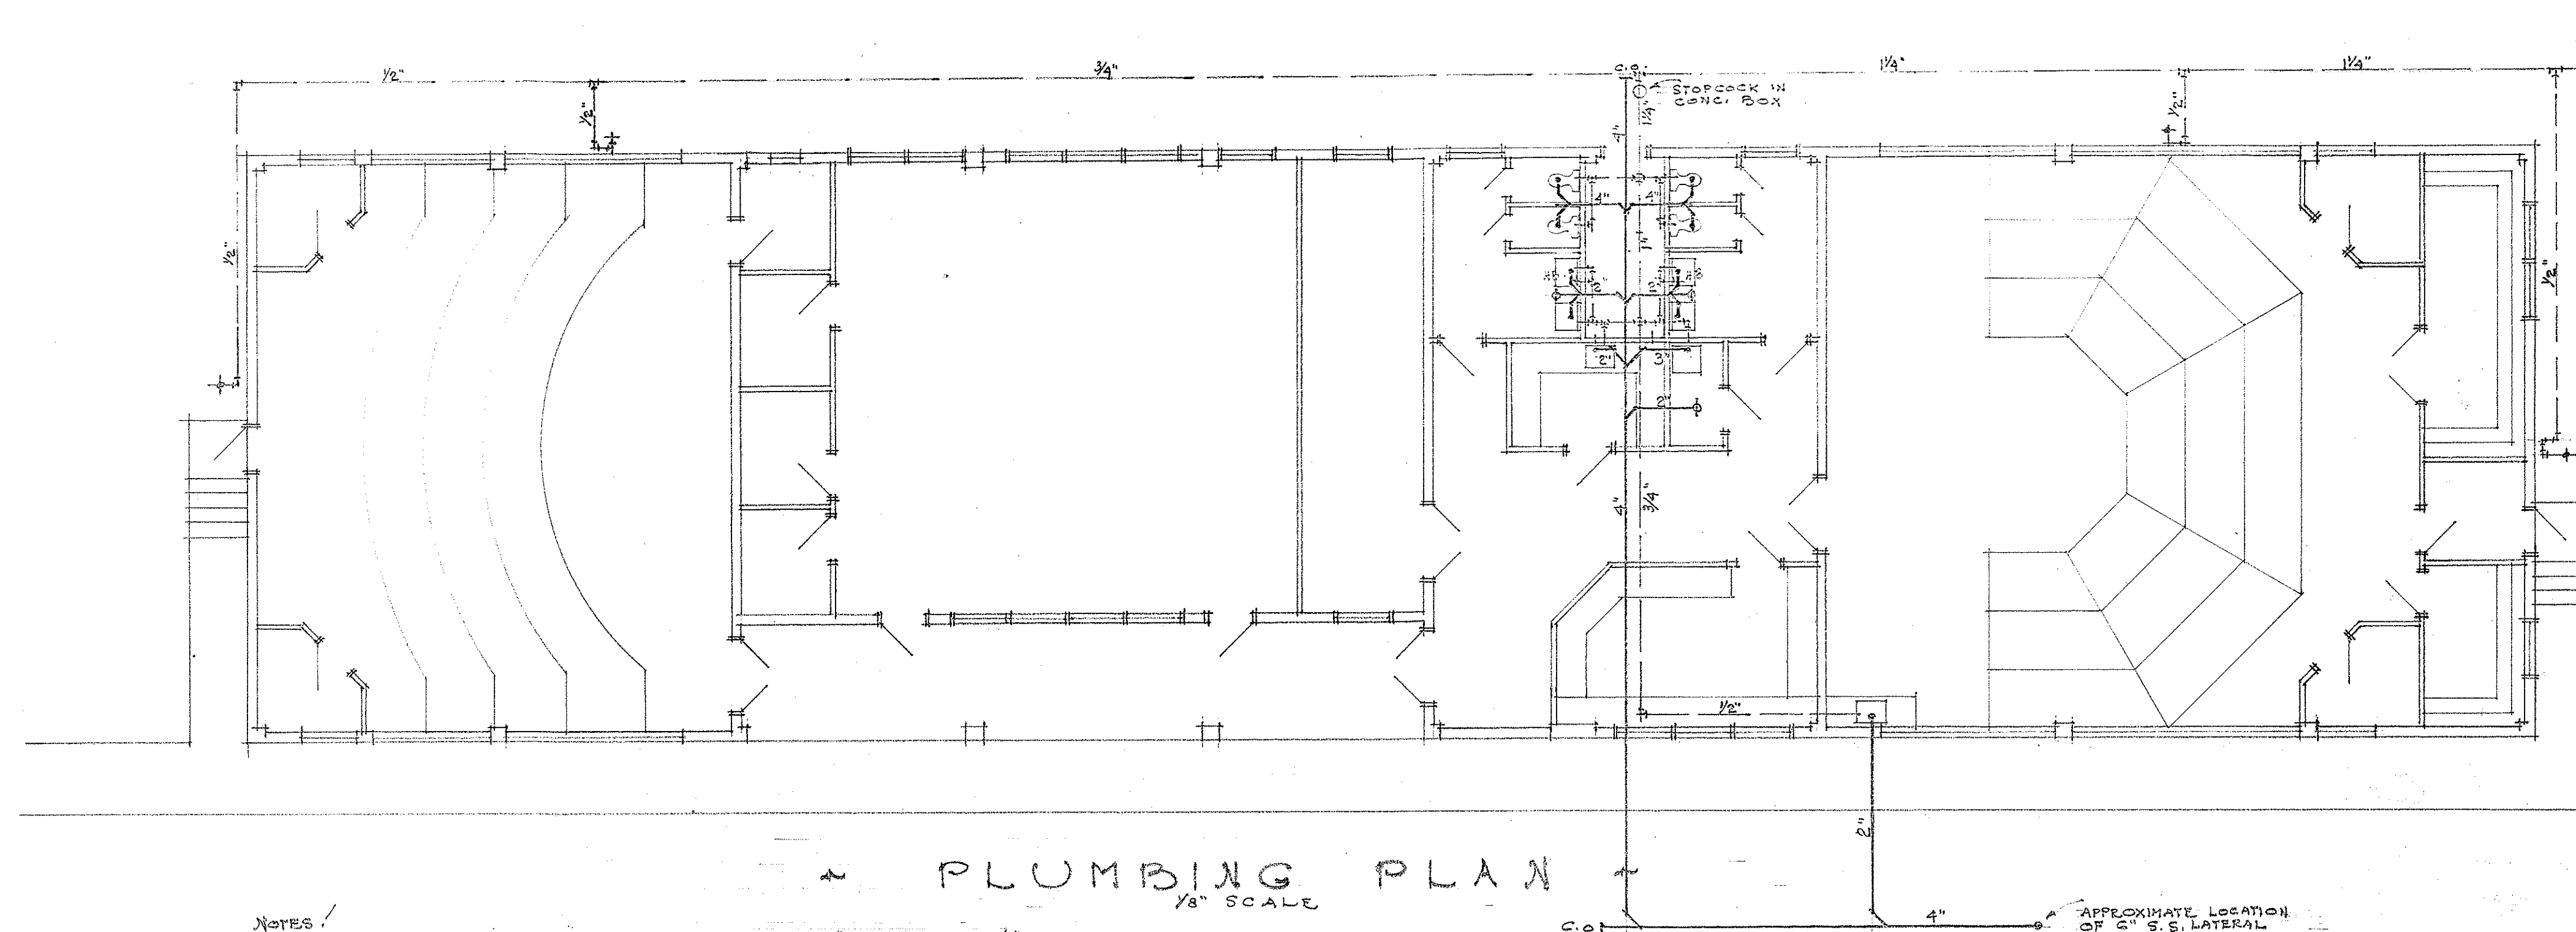




- SYMBOLS**
- CEILING LIGHT OUTLET - FRT. TYPE & CIRCUIT NO. AS NOTED.
 - WALL BRACKET LT. OUTLET - DITTO.
 - FLUORESCENT LIGHT OUTLET WITH FIXTURES MOUNTED IN CONTINUOUS ROWS.
 - FLUORESCENT LT. OUTLET - TYPE & SIZE NOTED.
 - CLOCK OUTLET, 120V., MOUNTED 8'-0" ABOVE FIN. FL. WITH CLOCK.
 - WALL FAN OUTLET RECEPTACLE - MOUNTED 8'-0" ABOVE FIN. FL.
 - CEILING FAN
 - DUPLEX CONVENIENCE RECEPTACLE - SAFETY TYPE #SP-45
 - PUBLIC ADDRESS SYSTEM OUTLET - MOUNTED 8'-0" ABOVE FIN. FL.
 - PROGRAM BELL
 - PROGRAM BUZZER
 - P.A. SYSTEM JUNCTION CABINET - 8" x 8" x 4 1/2"
 - CIRCUIT CONCEALED UNDER FLOOR OR CEILING.
 - NOTE: SUCH CIRCUITS W/O FURTHER DESIGNATIONS INDICATE 2 #12 T.W. CONDUCTORS IN A 3/4" CONDUIT. MORE THAN 2 WIRES ARE INDICATED BY HASH MARKS, THUS, #12/3. LARGER WIRE & CONDUIT SIZES ARE NOTED. P.A. SYSTEM CONDUIT WITH LEAD COVERED, 4 PAIR, #12, CABLE.
 - PROGRAM BELL SYSTEM.
 - S.P. FLUSH TUMBLER SWITCH, 20A/277V, QUIET, #1221.
 - 2-WAY - DITTO - HUBBELL #1223.
 - S.P. SWITCHES GANGED, SUFFIXES INDICATE CONTROL OF OUTLETS NOTED LIKEWISE.
 - PANEL BOARD - FLUSH MOUNTED - ACCESS FROM SIDE WITH DOOR.
- ALL OTHER SYMBOLS & WORK ARE AS NOTED IN DRAWINGS.

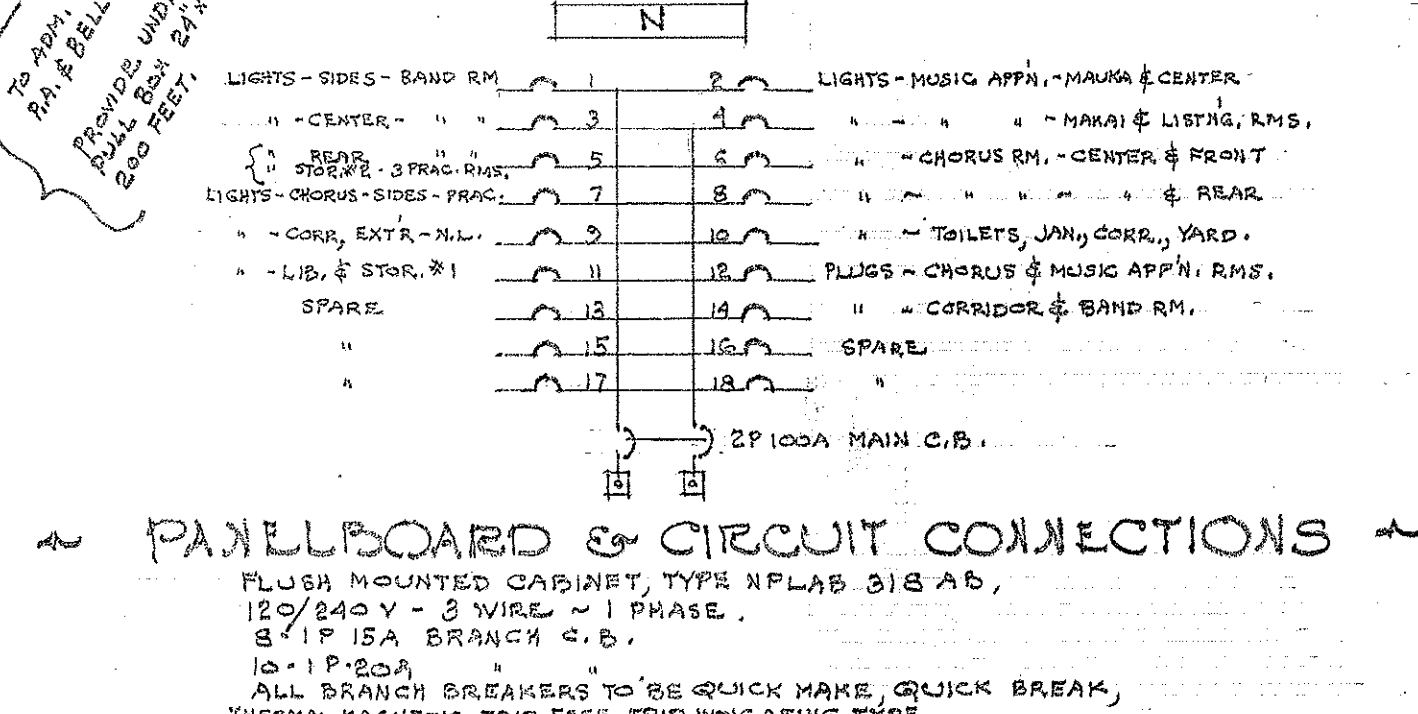

NOTE: MOUNTING HEIGHT FOR MUSIC APPRN. BAND & CHORUS RM. CEILING FIXTURES TO BE 12'-0" ABOVE NORMAL FLOOR LEVEL.

ELECTRICAL PLAN
1/8" SCALE

CIRCUIT NO.	SIZE	PANEL BOARD CIRCUIT ASSIGNMENT.	LOAD	WATTAGE
1	1P 20	PAND ROOM - SIDES.	1200W	
2	1P 20	MUSIC APPN. ROOM - MAUKA & CENTER.	1200W	
3	1P 20	BAND ROOM - CENTER.	1200W	1200W
4	1P 20	MUSIC APPN. RM. - MAKAI, LISTN. RMS, LIGHTS & FANS.	1400W	1400W
5	1P 20	BAND RM. - REAR, PRACTICE RMS, LTS, FANS, STOR. 2/3	1400W	
6	1P 15	CHORUS RM. - CENTER & FRONT.	300W	
7	1P 20	" " - SIDES, PRACTICE RM. LTS. & FANS.	1610W	
8	1P 15	" " - CENTER & REAR.	800W	
9	1P 15	CORRIDOR, EXTERIOR & NIGHT LIGHTS.	750W	
10	1P 15	TOILETS, REPAIR, JANITOR & YARD.	475W	
11	1P 15	LIBRARY - STORAGE #1	800W	
12	1P 20	PLUGS - CHORUS & MUSIC ROOMS.	1200W	
13	1P 20	SPARE		
14	1P 20	PLUGS	1200W	
15	1P 20	SPARE		
16	1P 15	"		
17	1P 15	"		
18	1P 15	"		
MAIN	2P 100		7025W	7020W

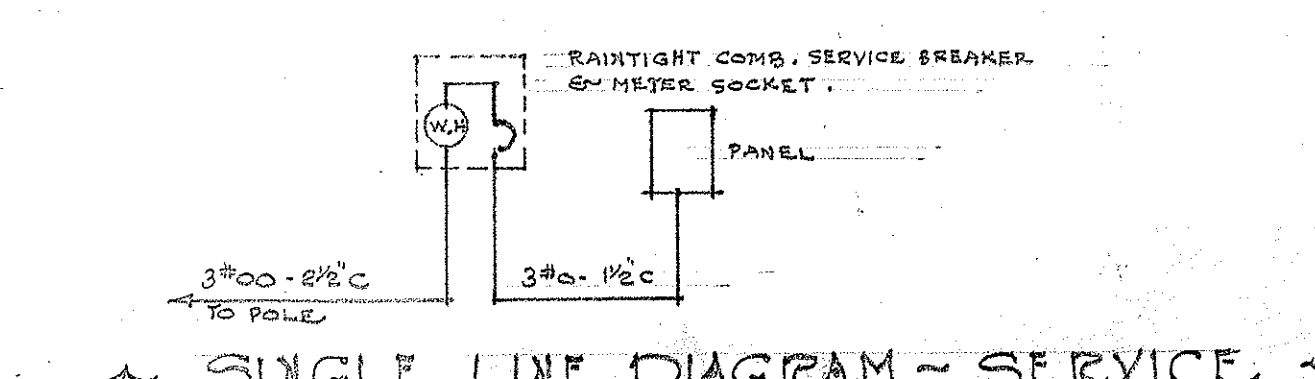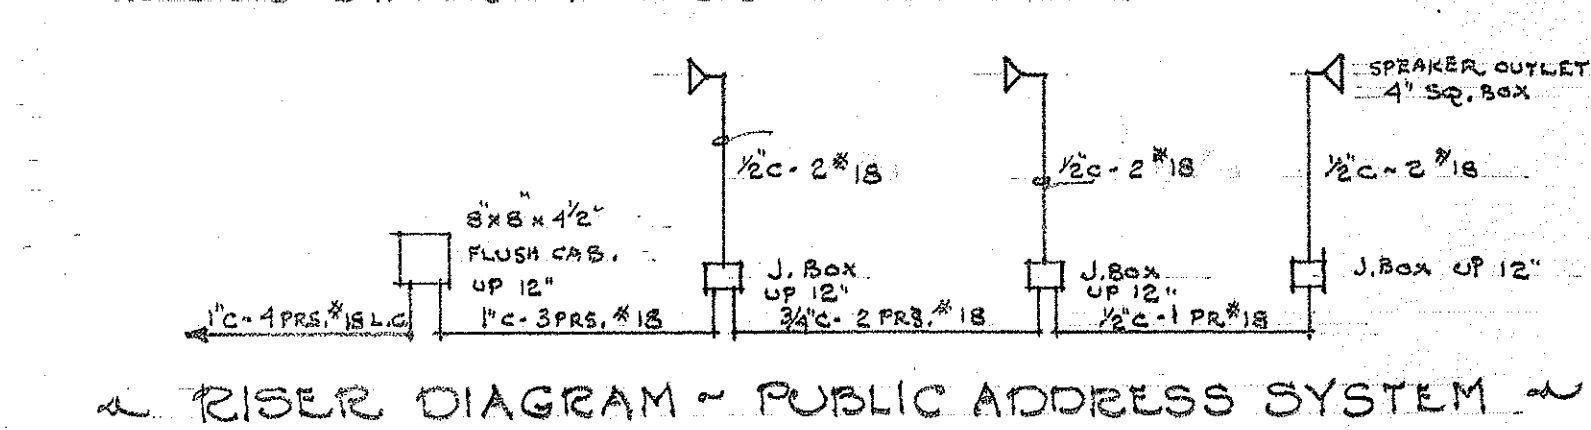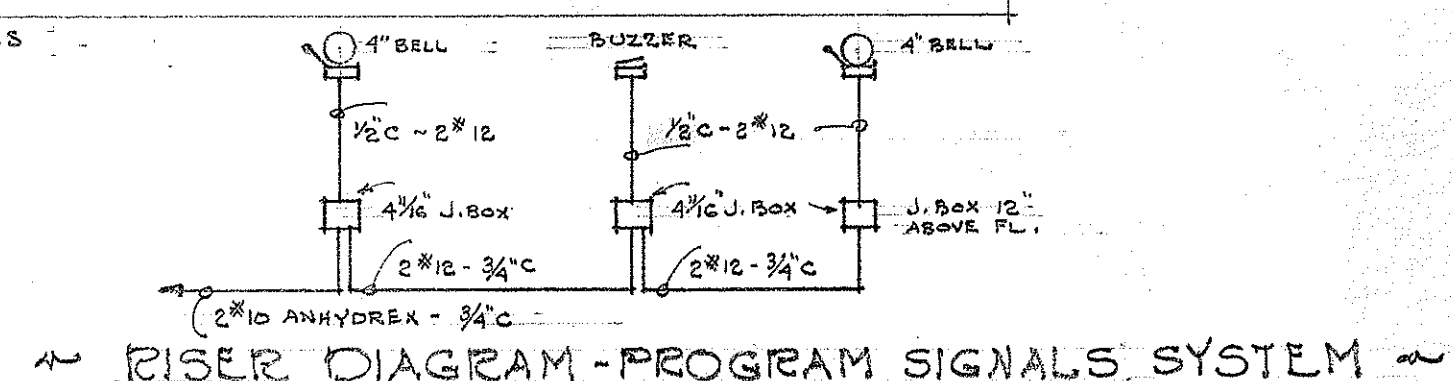

5972.8