



INDEX TO DRAWINGS	
SHEET NO.	DESCRIPTIONS
1	TITLE SHEET
2-3	TYPICAL SECTIONS
4-10	PLAN & PROFILE
11	INTERSECTION DETAILS
12-14	STANDARD DETAILS 14B-14D PEDESTRIAN OVERPASS
15-20A	BOX CULVERT DETAILS
21-37	CROSS SECTION
10A	SOIL PROFILE
12A-12B	STANDARD DETAILS
14A	MISCELLANEOUS DETAILS

CONVENTIONAL SIGNS USED

Boundary Lines	or.....
Box Culvert	
Bridge	120.....
Centerline	6 Mon......
Centerline Monument	
Circular Culvert	
Concrete Drop Intake	
Electric Line Pole	
Existing Road	
Fences (Noted)	or.....
Fire Hydrant	
Railroad	or.....
Sewer Line	S ₆S ₈S ₁₀
Sewer Manhole	SMH.....
Standard Manhole	MH.....
Telephone Manhole	TMH.....
Telephone Pole	TP.....
Tree (Large)	or.....
Warning & Regulatory Signs	Type.....
Water Main	W ₆W ₈W ₁₀
Water Valve	WV.....
Water Valve Manhole	WVM.....

TERRITORY OF HAWAII TERRITORIAL HIGHWAY DEPARTMENT HONOLULU T.H. PLANS OF PALI ROAD FEDERAL AID SECONDARY PROJECT NO. S216 (1) DISTRICT OF HONOLULU ISLAND OF OAHU

SCALE	
PLAN	1 INCH = 50 FEET
PROFILE	1 INCH = 50 FEET
	1 INCH = 10 FEET
CROSS SECTION	1 INCH = 10 FEET
	1 INCH = 10 FEET

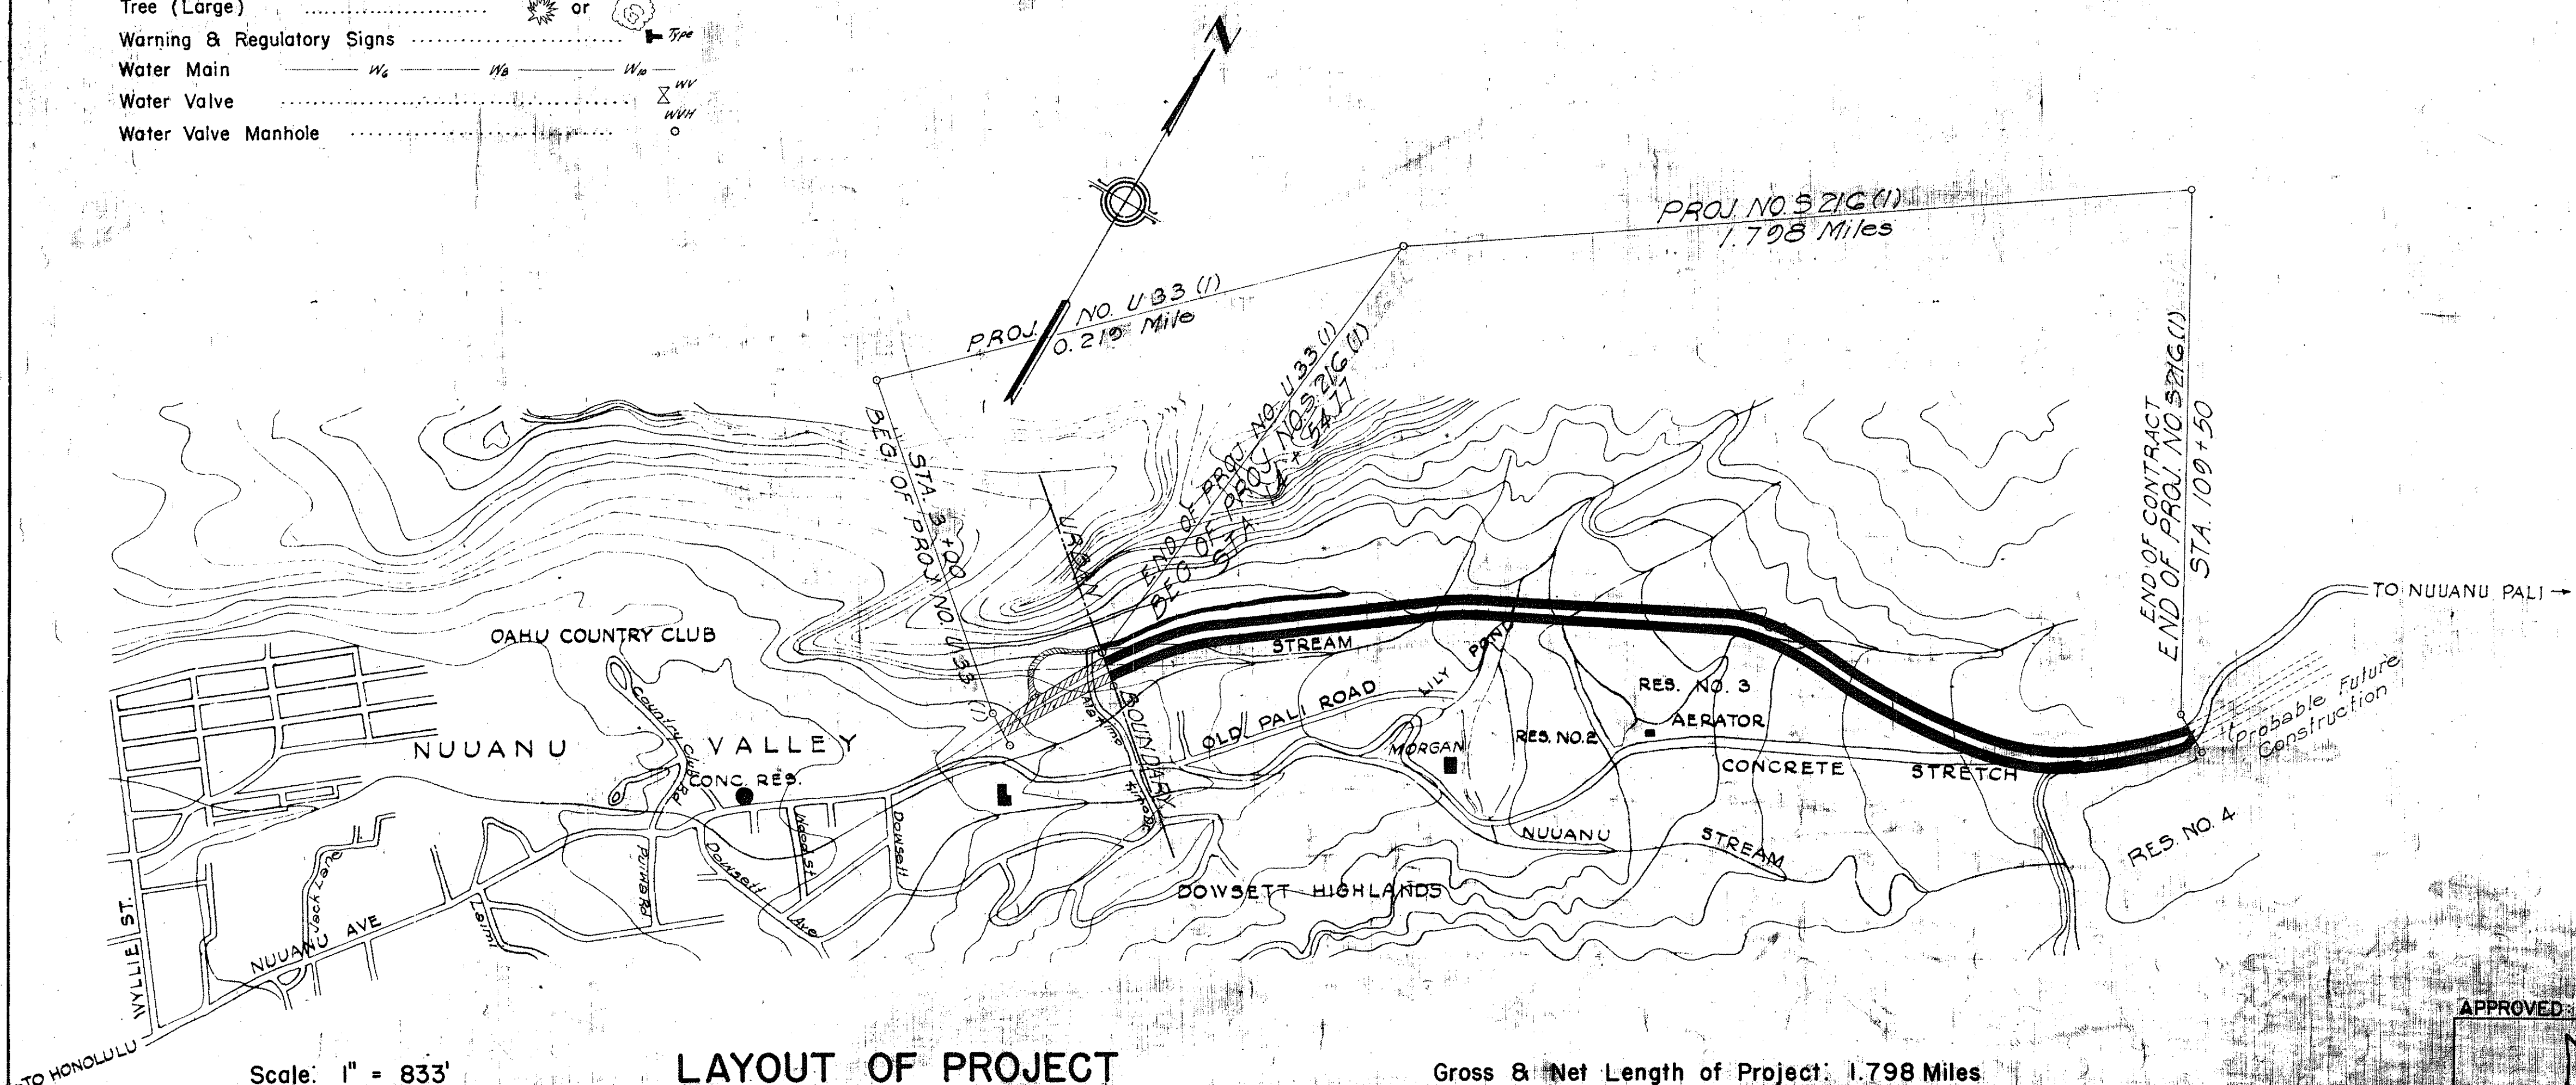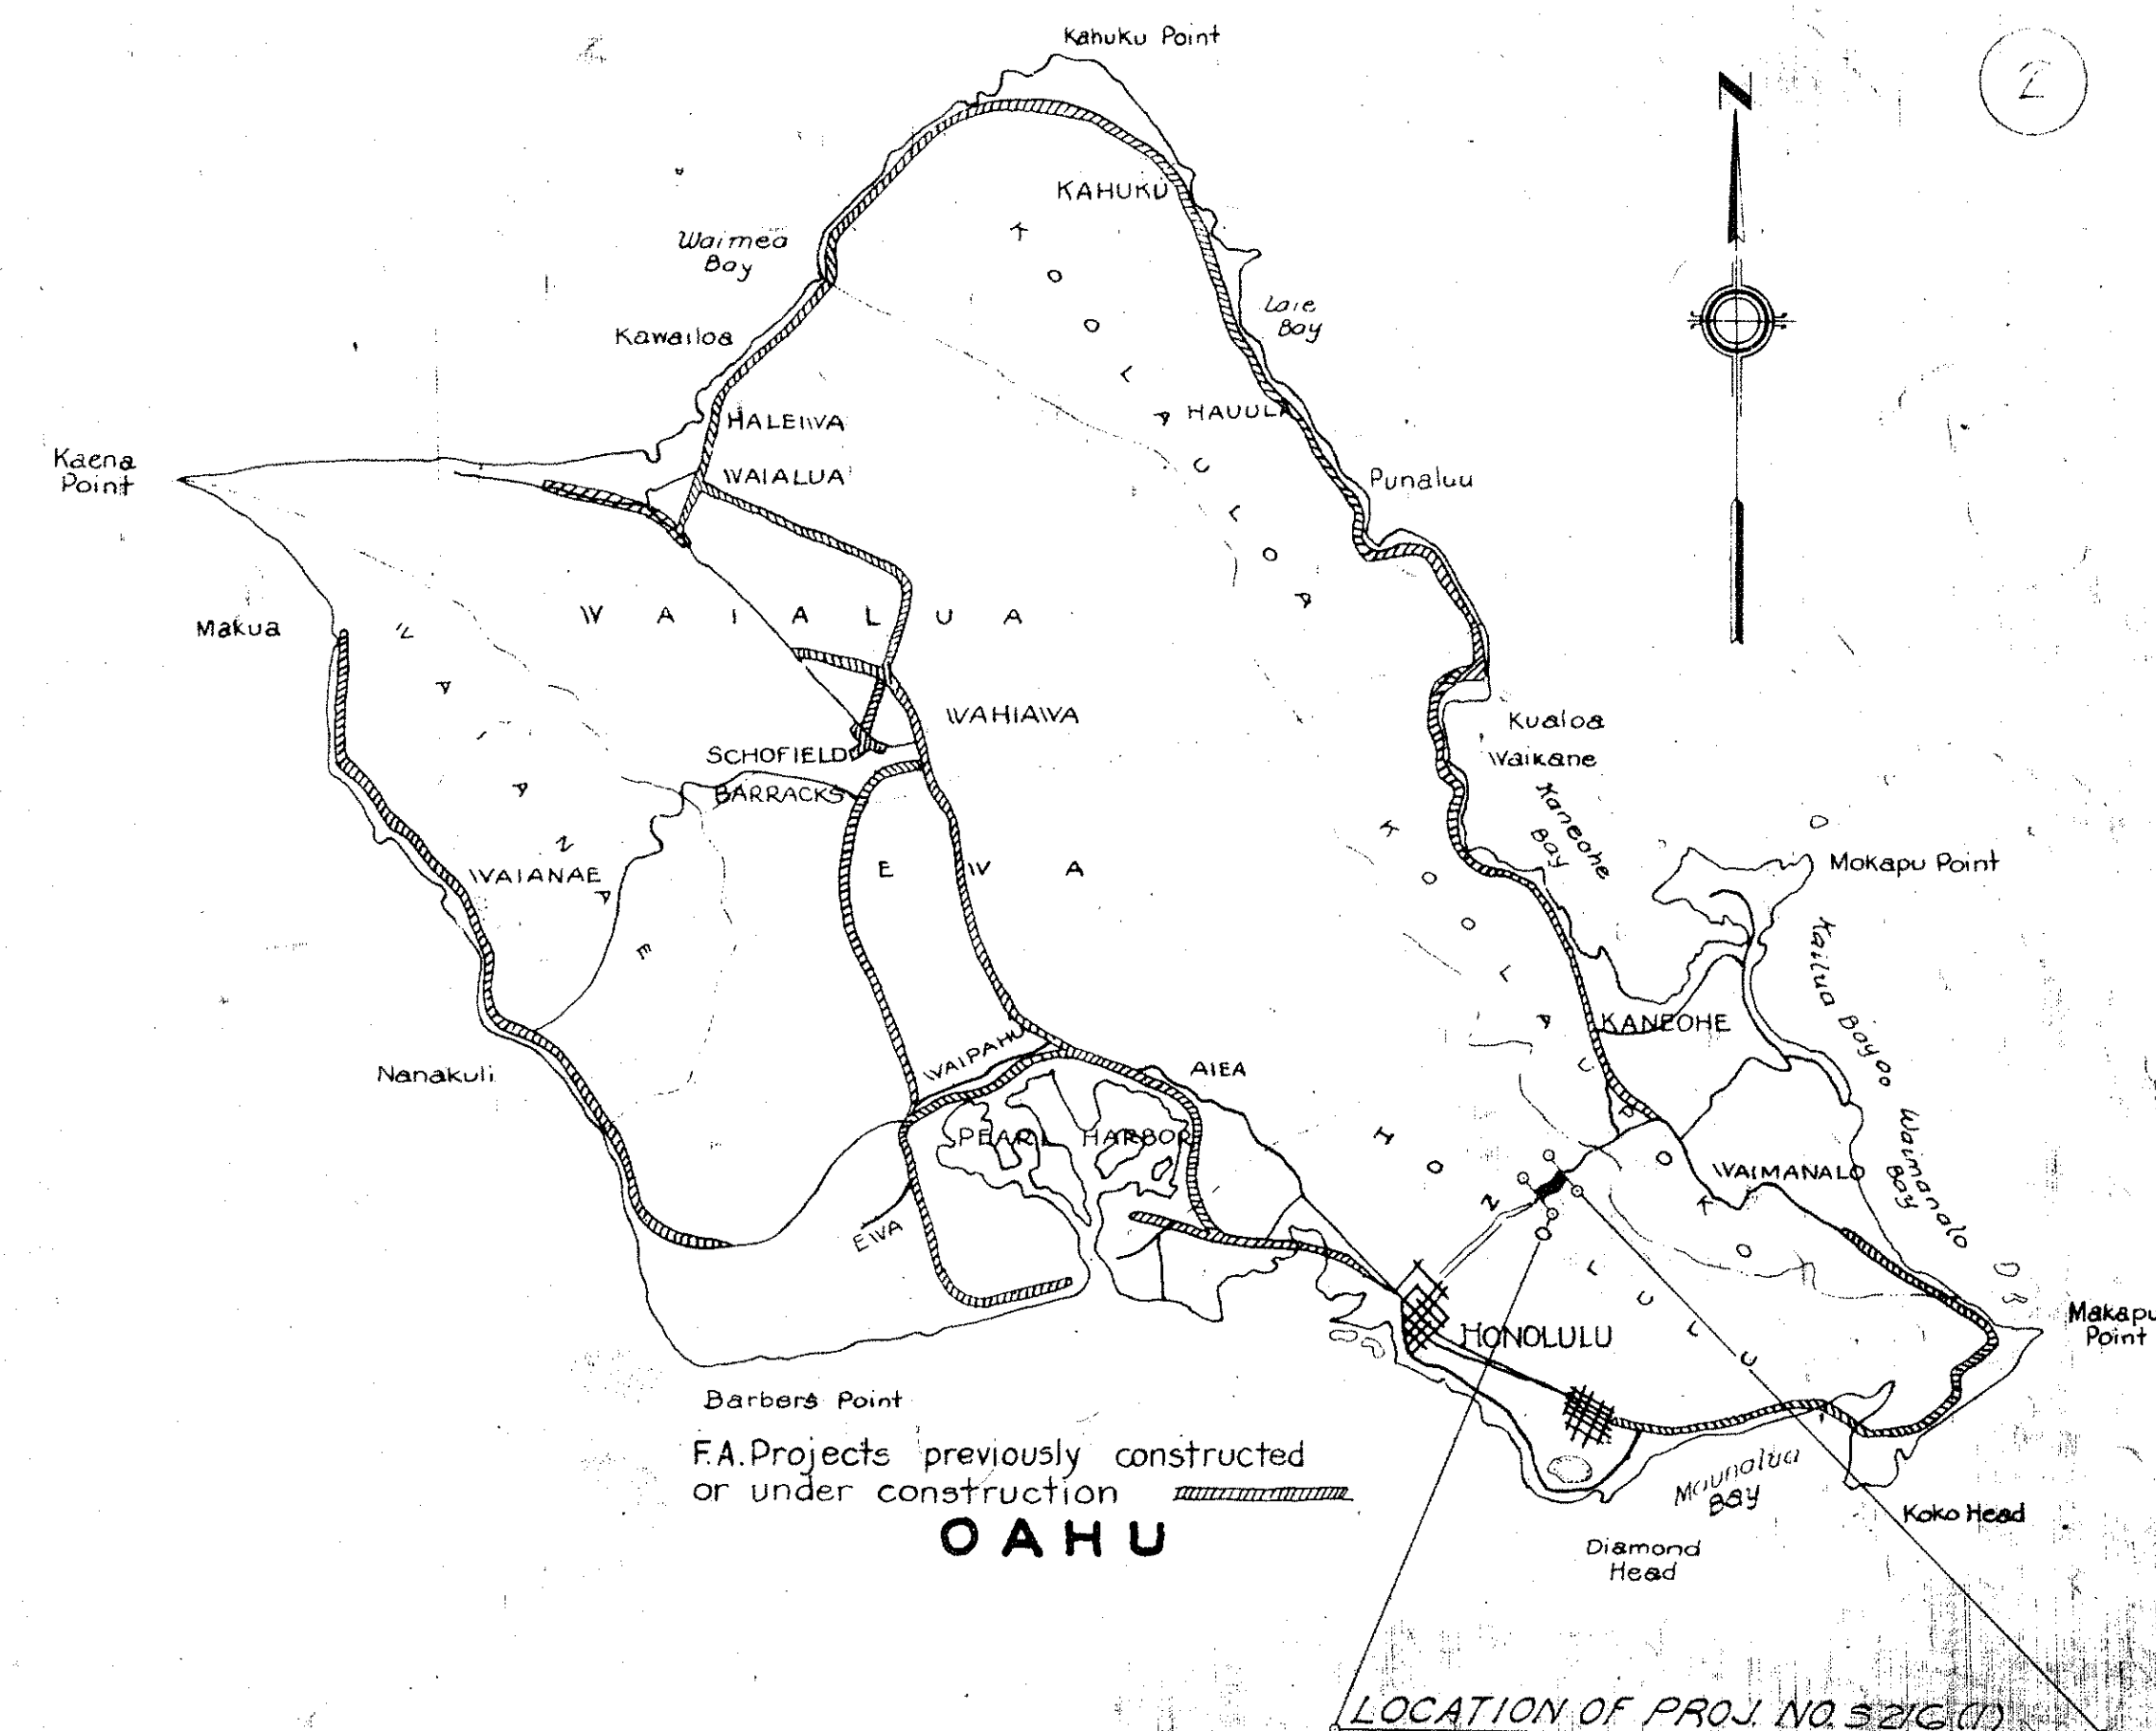

Scale: 1" = 833'

LAYOUT OF PROJECT

Gross & Net Length of Project: 1.798 Miles

APPROVED: *[Signature]*
DATE: 2-25-42
TERRITORIAL HIGHWAY ENGINEER

RECOMMENDED FOR APPROVAL: _____ DATE: _____	
DISTRICT ENGINEER PUBLIC ROADS ADMINISTRATION FEDERAL WORKS AGENCY	
APPROVED: _____ DATE: _____	
DIVISION ENGINEER PUBLIC ROADS ADMINISTRATION FEDERAL WORKS AGENCY	

5303.1