


PROFILE	SURVEYED	BY	DATE
	PLOTTED		
NOTE BOOK	GRADES CHECKED		
NO.	B. M.'S NOTED		
	STRUCTURE NOTATIONS CHECKED		

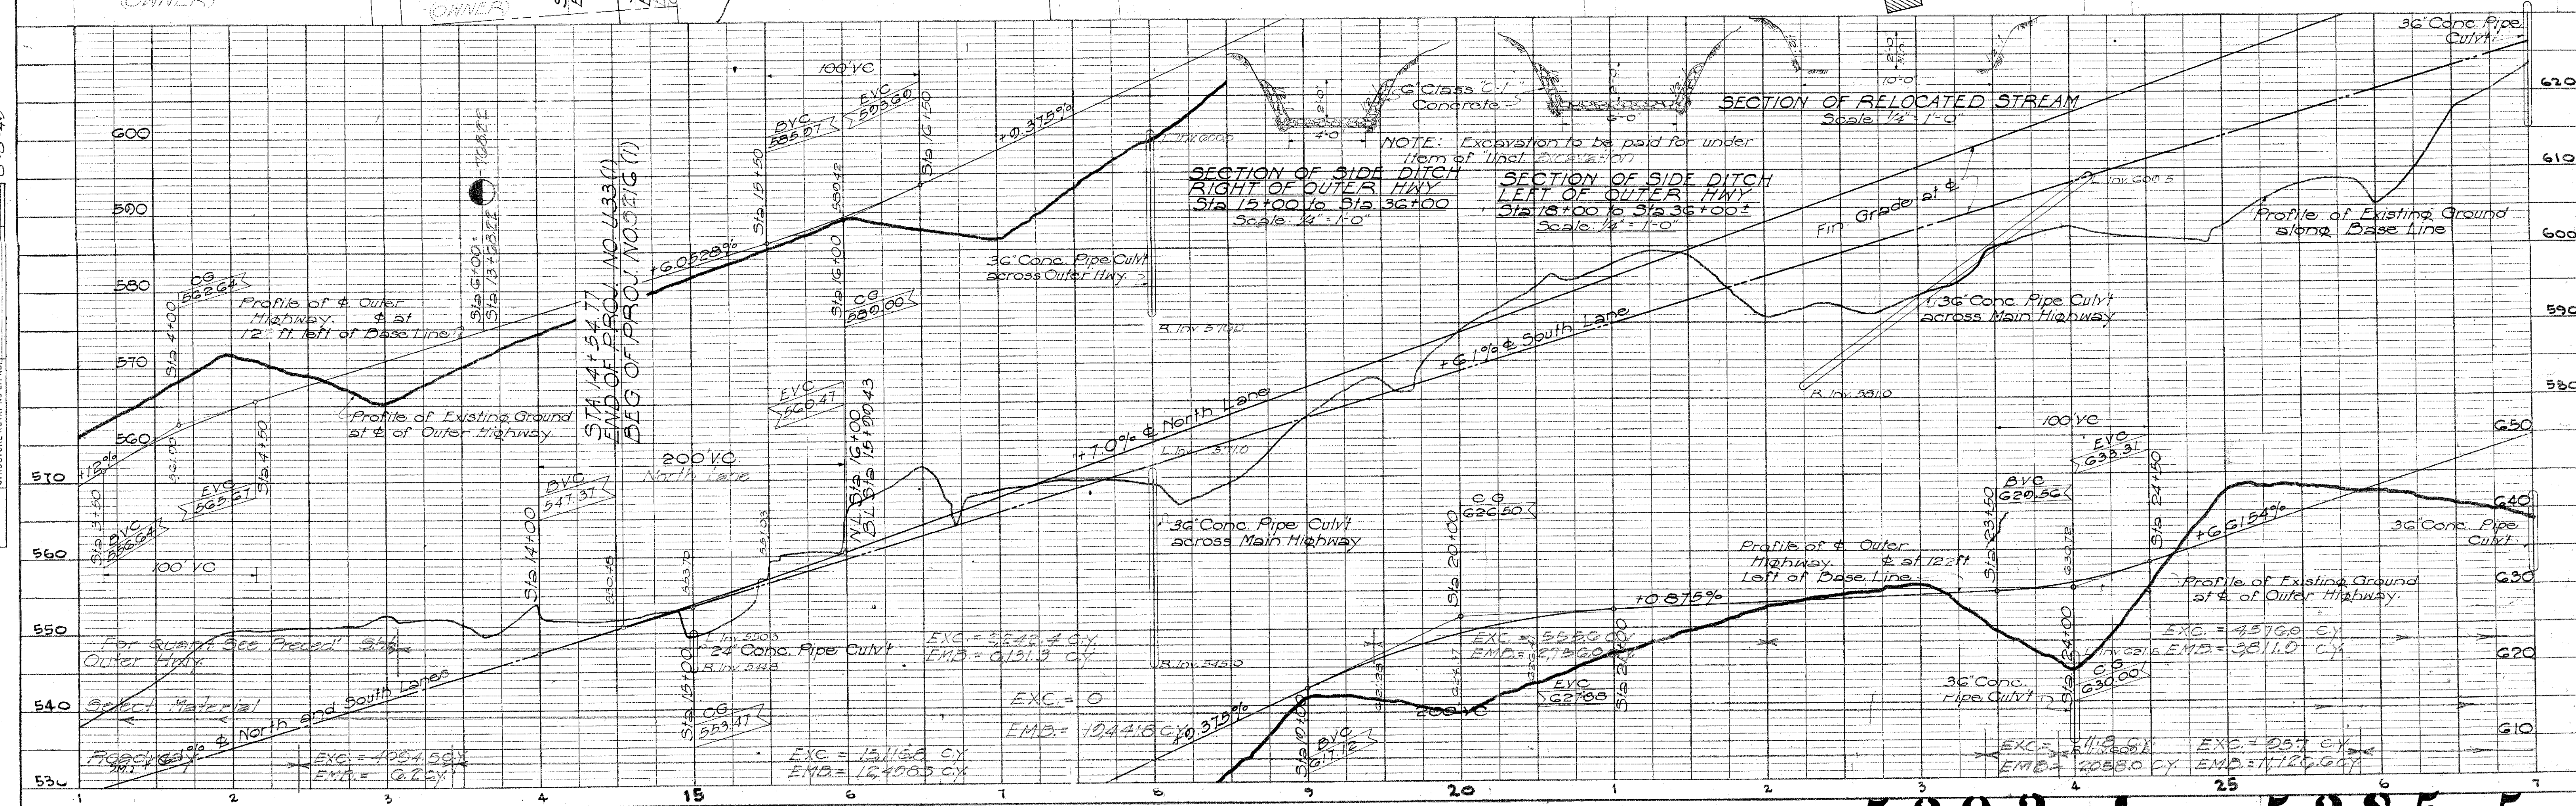

5 3 0 3 . 4 5 3 8 5 . 5