


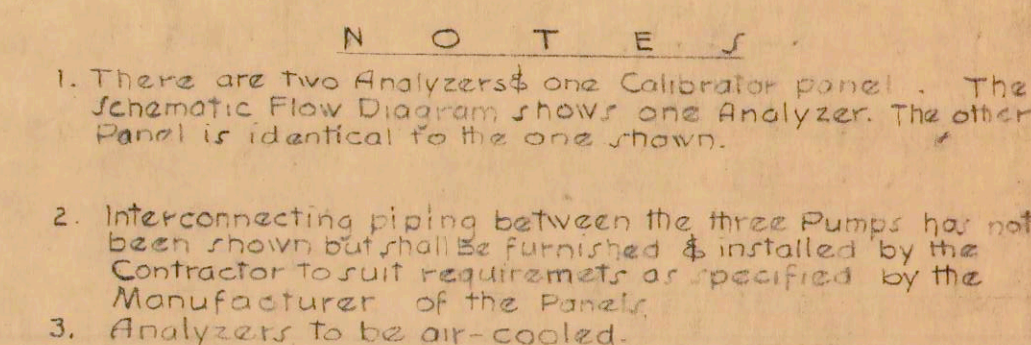

FILE	ROCKET	FOLDER	NO.
------	--------	--------	-----