



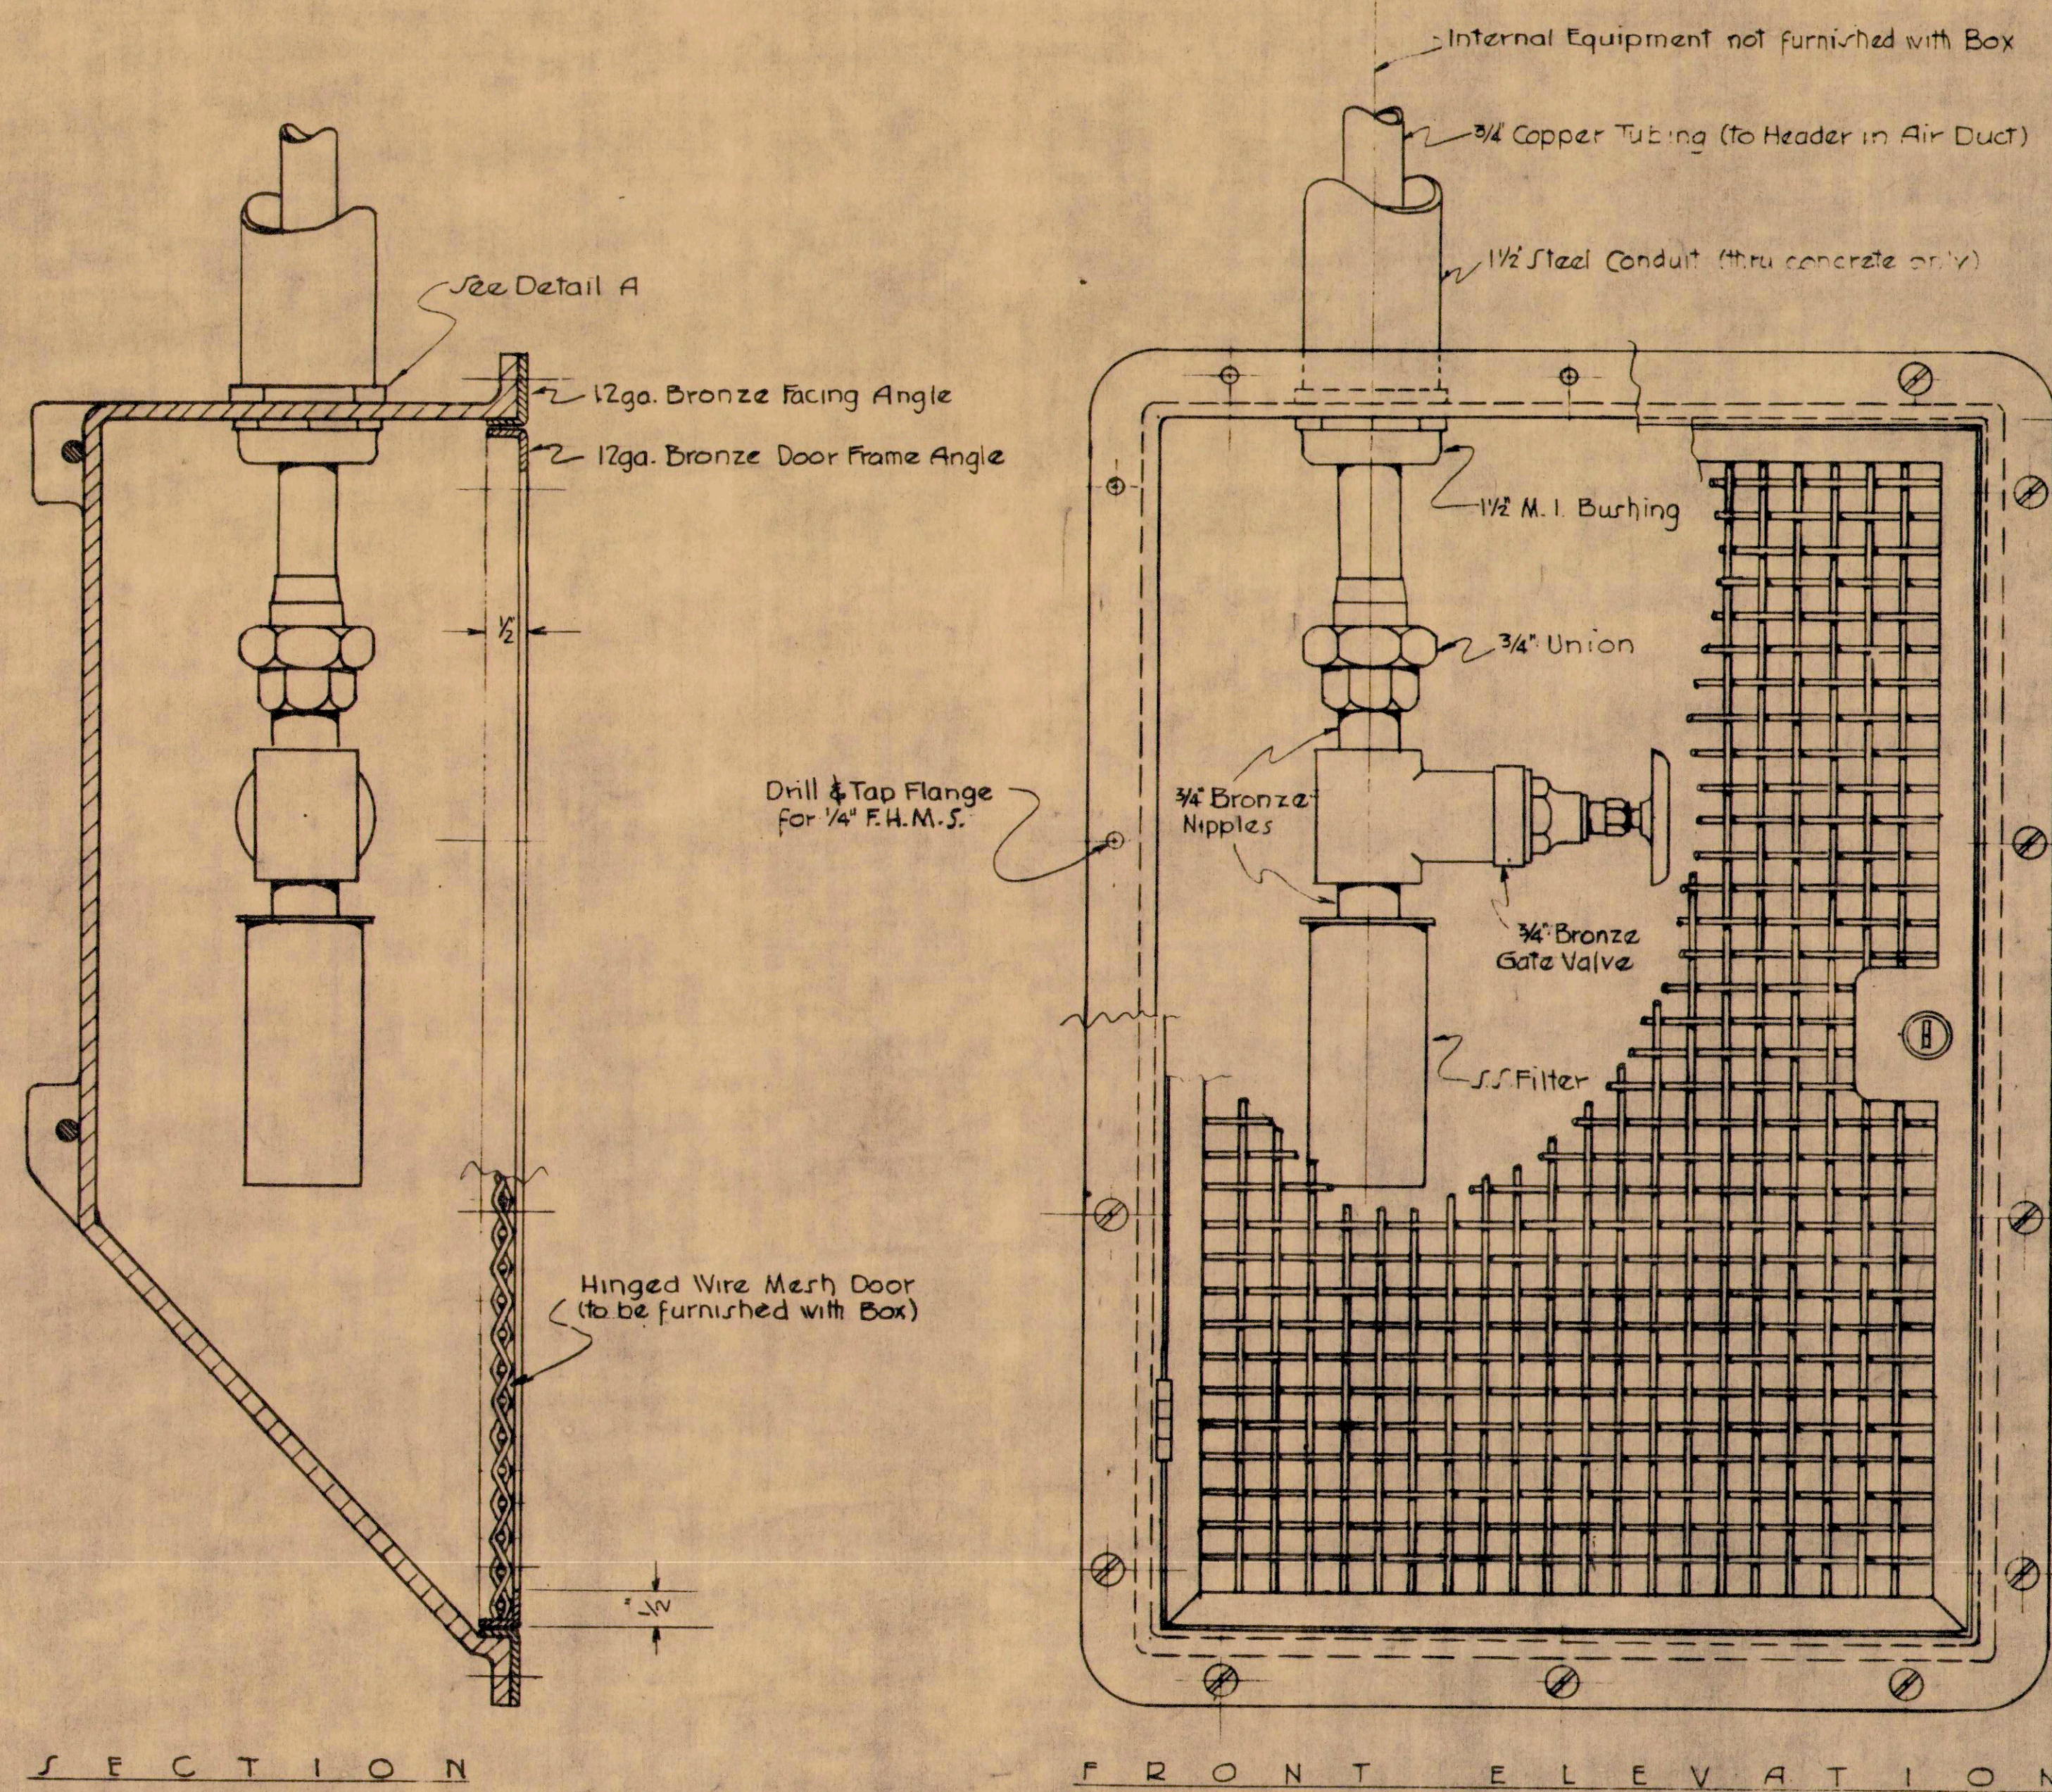

A S S E M B L Y

Scale - Half size

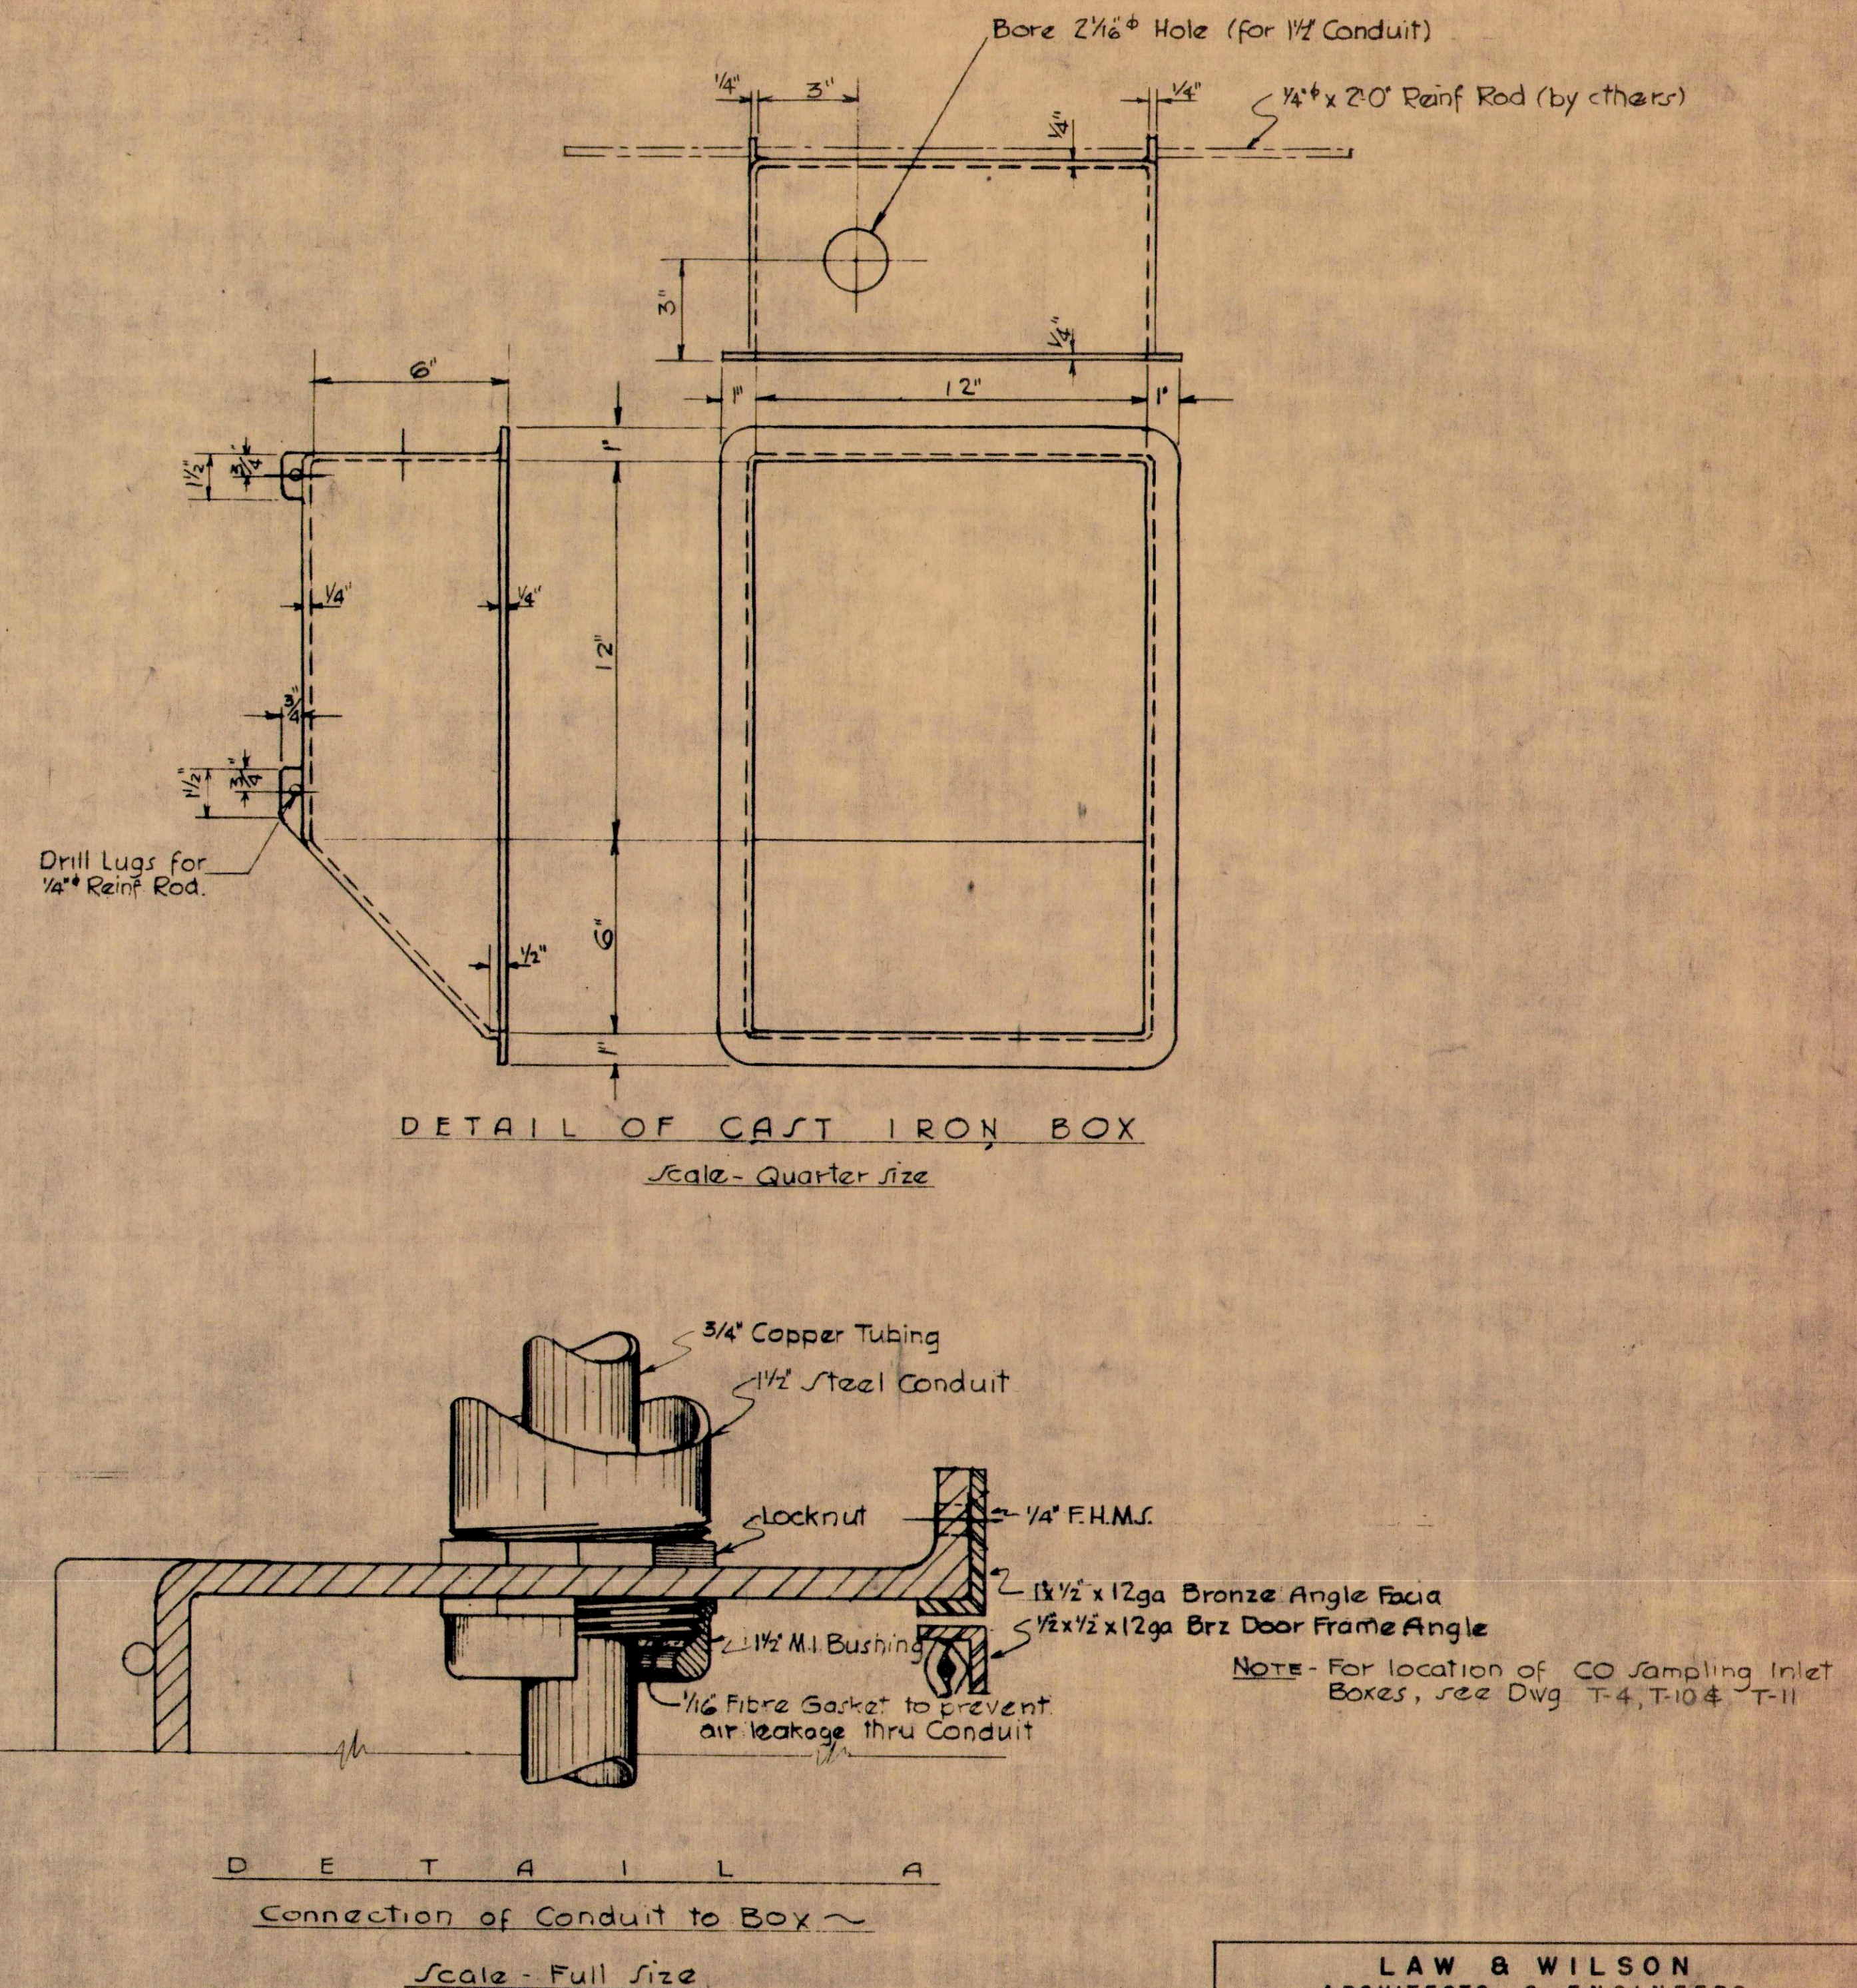

LAW & WILSON ARCHITECTS & ENGINEERS			
DEPARTMENT OF PUBLIC WORKS CITY AND COUNTY OF HONOLULU			
BUREAU OF PLANS			
KALIHI TUNNEL			
VENTILATION			
C.O. SAMPLING INLET DETAIL			
ENGINEER L. B. W.	DATE JULY 15, 1953		
DRAFTSMAN C. H.	CHECKED BY E. M. Williams		
SCALE AS NOTED	TRACER		
APPROVED	APPROVED		
CHIEF ENGINEER	BUREAU ENGINEER		
W. S.	PROFILE	C. B.	
CH SEC.	P. S.	S. S.	
W. M. BY	P. W. BY	S. BY	