


FINAL SURVEY	SURVEYED	DATE
	PLOTTED	BY
	NOTE BOOK	
	NO.	

ORIGINAL SURVEY	SURVEYED	DATE
	PLOTTED	BY
	NOTE BOOK	
	NO.	

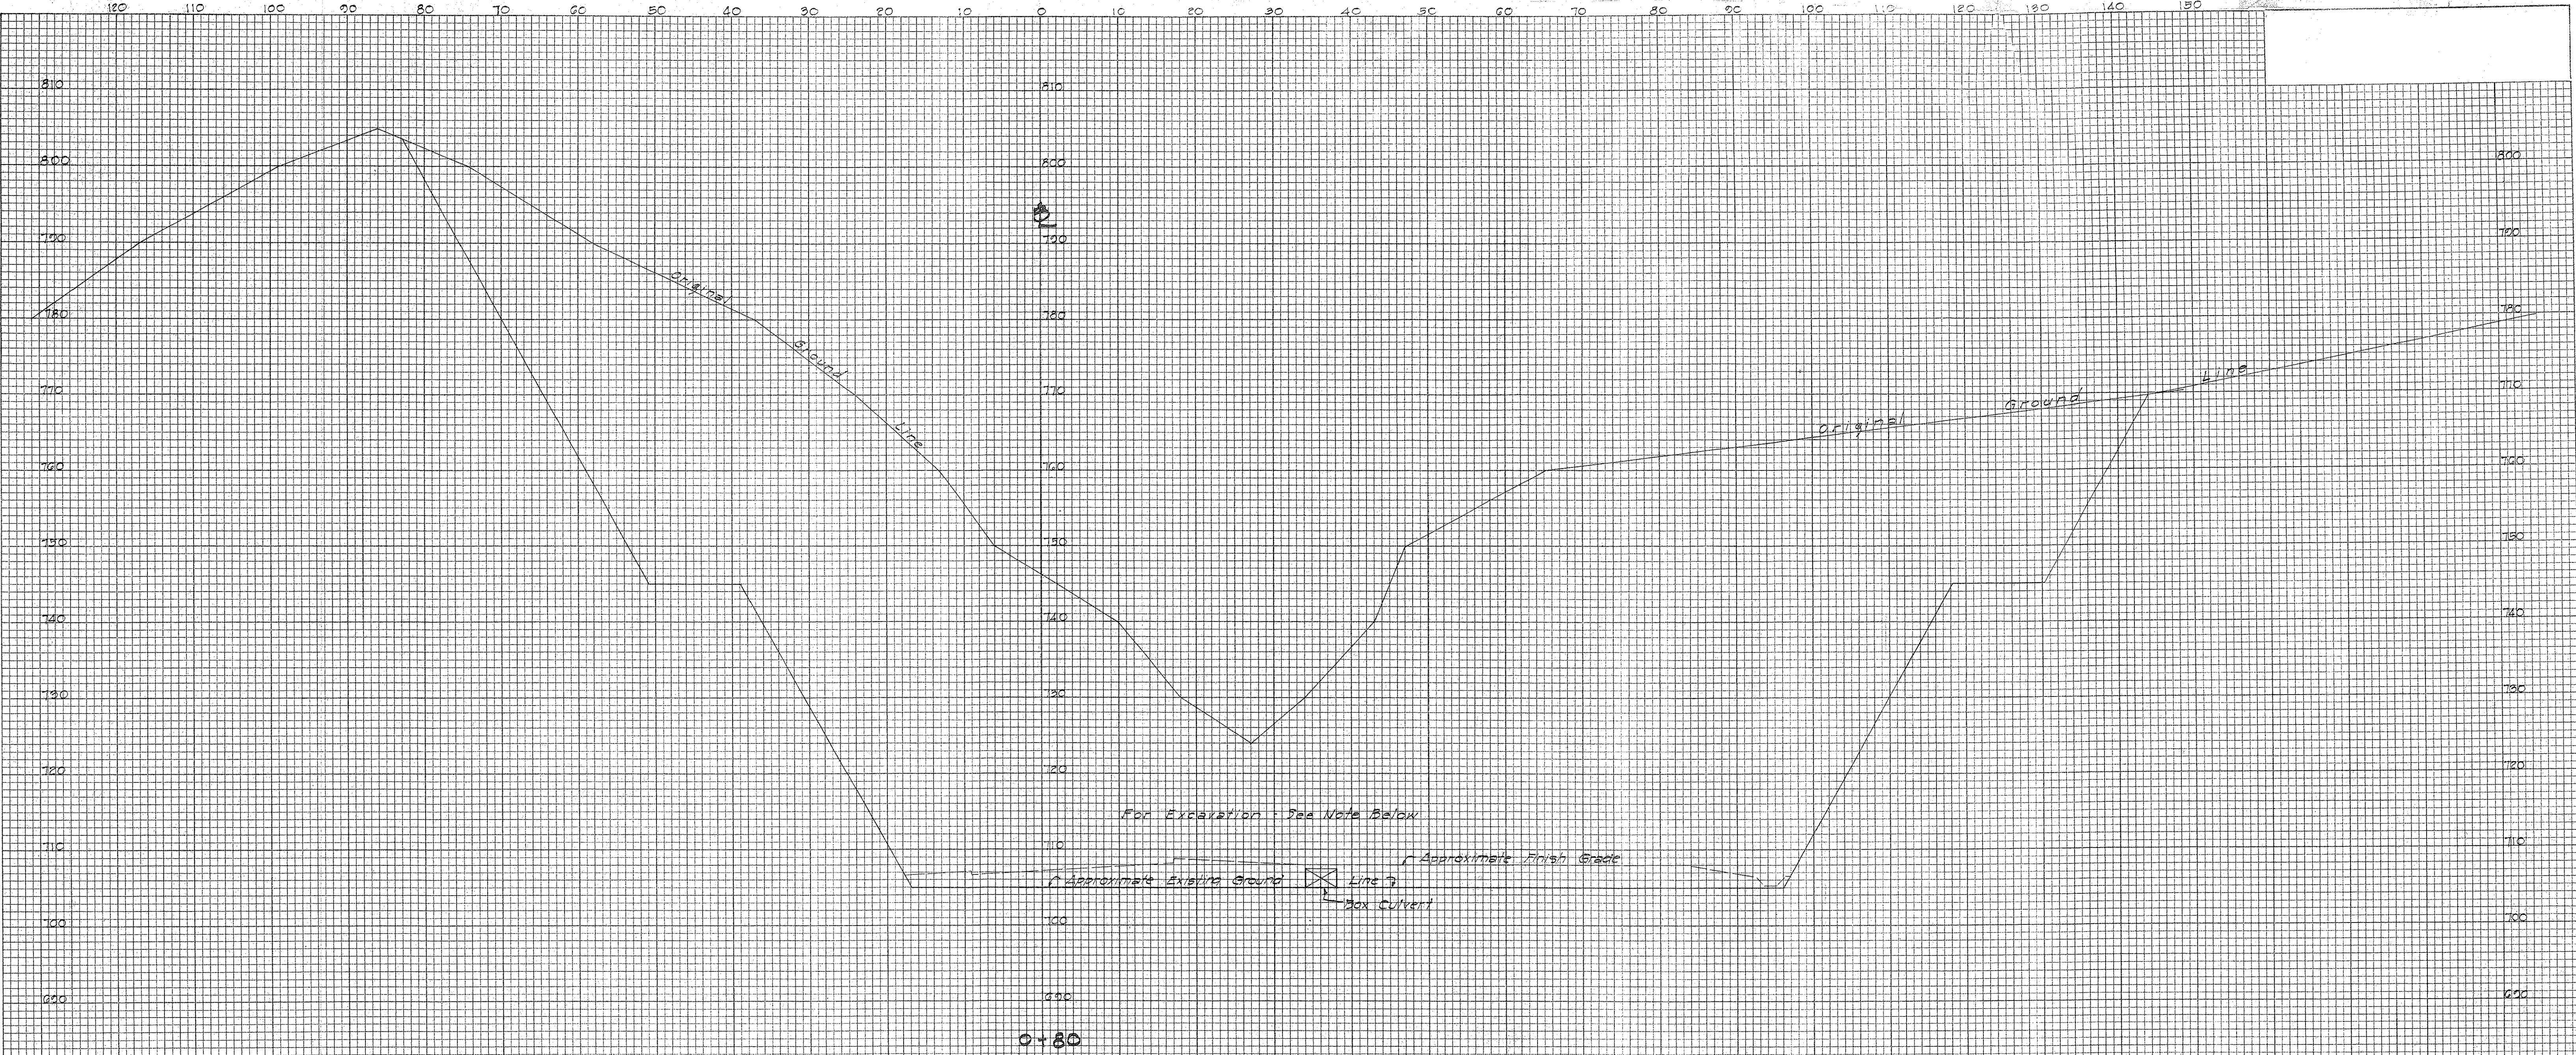

6 Roadway - Kalihi Sta 200+3538 = Kaneohe Sta 0+8020
This section is parallel with Kaneohe Portal Line.

NOTE: All excavation, rough grading, and embankment have already been done by others, and shall not be included in this Contract - Job No. 26-53.

Prior to commencement of work, elevations at the existing ground line shall be measured by the Engineer, and the Contractor shall place fill material and base course to grade under the various items of work in accordance with the Plans and Specifications and as ordered by the Engineer.

This note shall apply to Dwg. No. R-31, R-32, R-33, R-34, & R-35, Sheet No. 40, 41, 42, 43, & 44.

APPROVED
[Signature]
ENGINEER, KALIHU TUNNEL

SECTION C

DEPARTMENT OF PUBLIC WORKS CITY AND COUNTY OF HONOLULU BUREAU OF PLANS KALIHU TUNNEL KANEHOE APPROACH ROAD CROSS SECTIONS			
ENGINEER... S.D.H.	DATE... JULY 15, 1933		
DRAFTSMAN... J.S.	CHECKED BY... S.D.H. & R.H.		
SCALE Vert. 1"=10' Hor. 1"=10'	TRACER... J.K.L.		
APPROVED <i>[Signature]</i> CHIEF ENGINEER	APPROVED <i>[Signature]</i> BUREAU ENGINEER		
W.S. GR. SEC. W.M. BY:	PROFILE F.B. F.W. BY:	G.S. S.B. S.B.Y.	

JOB NO. 26-53


DWG. R-31

Sheet No. 40 of 252 Sheets

FILE	POCKET	FOLDER	NO.
7	5	2	3

FINAL	SURVEYED	DATE
SURVEY	PLOTTED	BY
NOTE BOOK	TEMPLATE	
NO.	AREAS CHECKED	

ORIGINAL	SURVEYED	DATE
SURVEY	PLOTTED	BY
NOTE BOOK	TEMPLATE	
NO.	AREAS CHECKED	

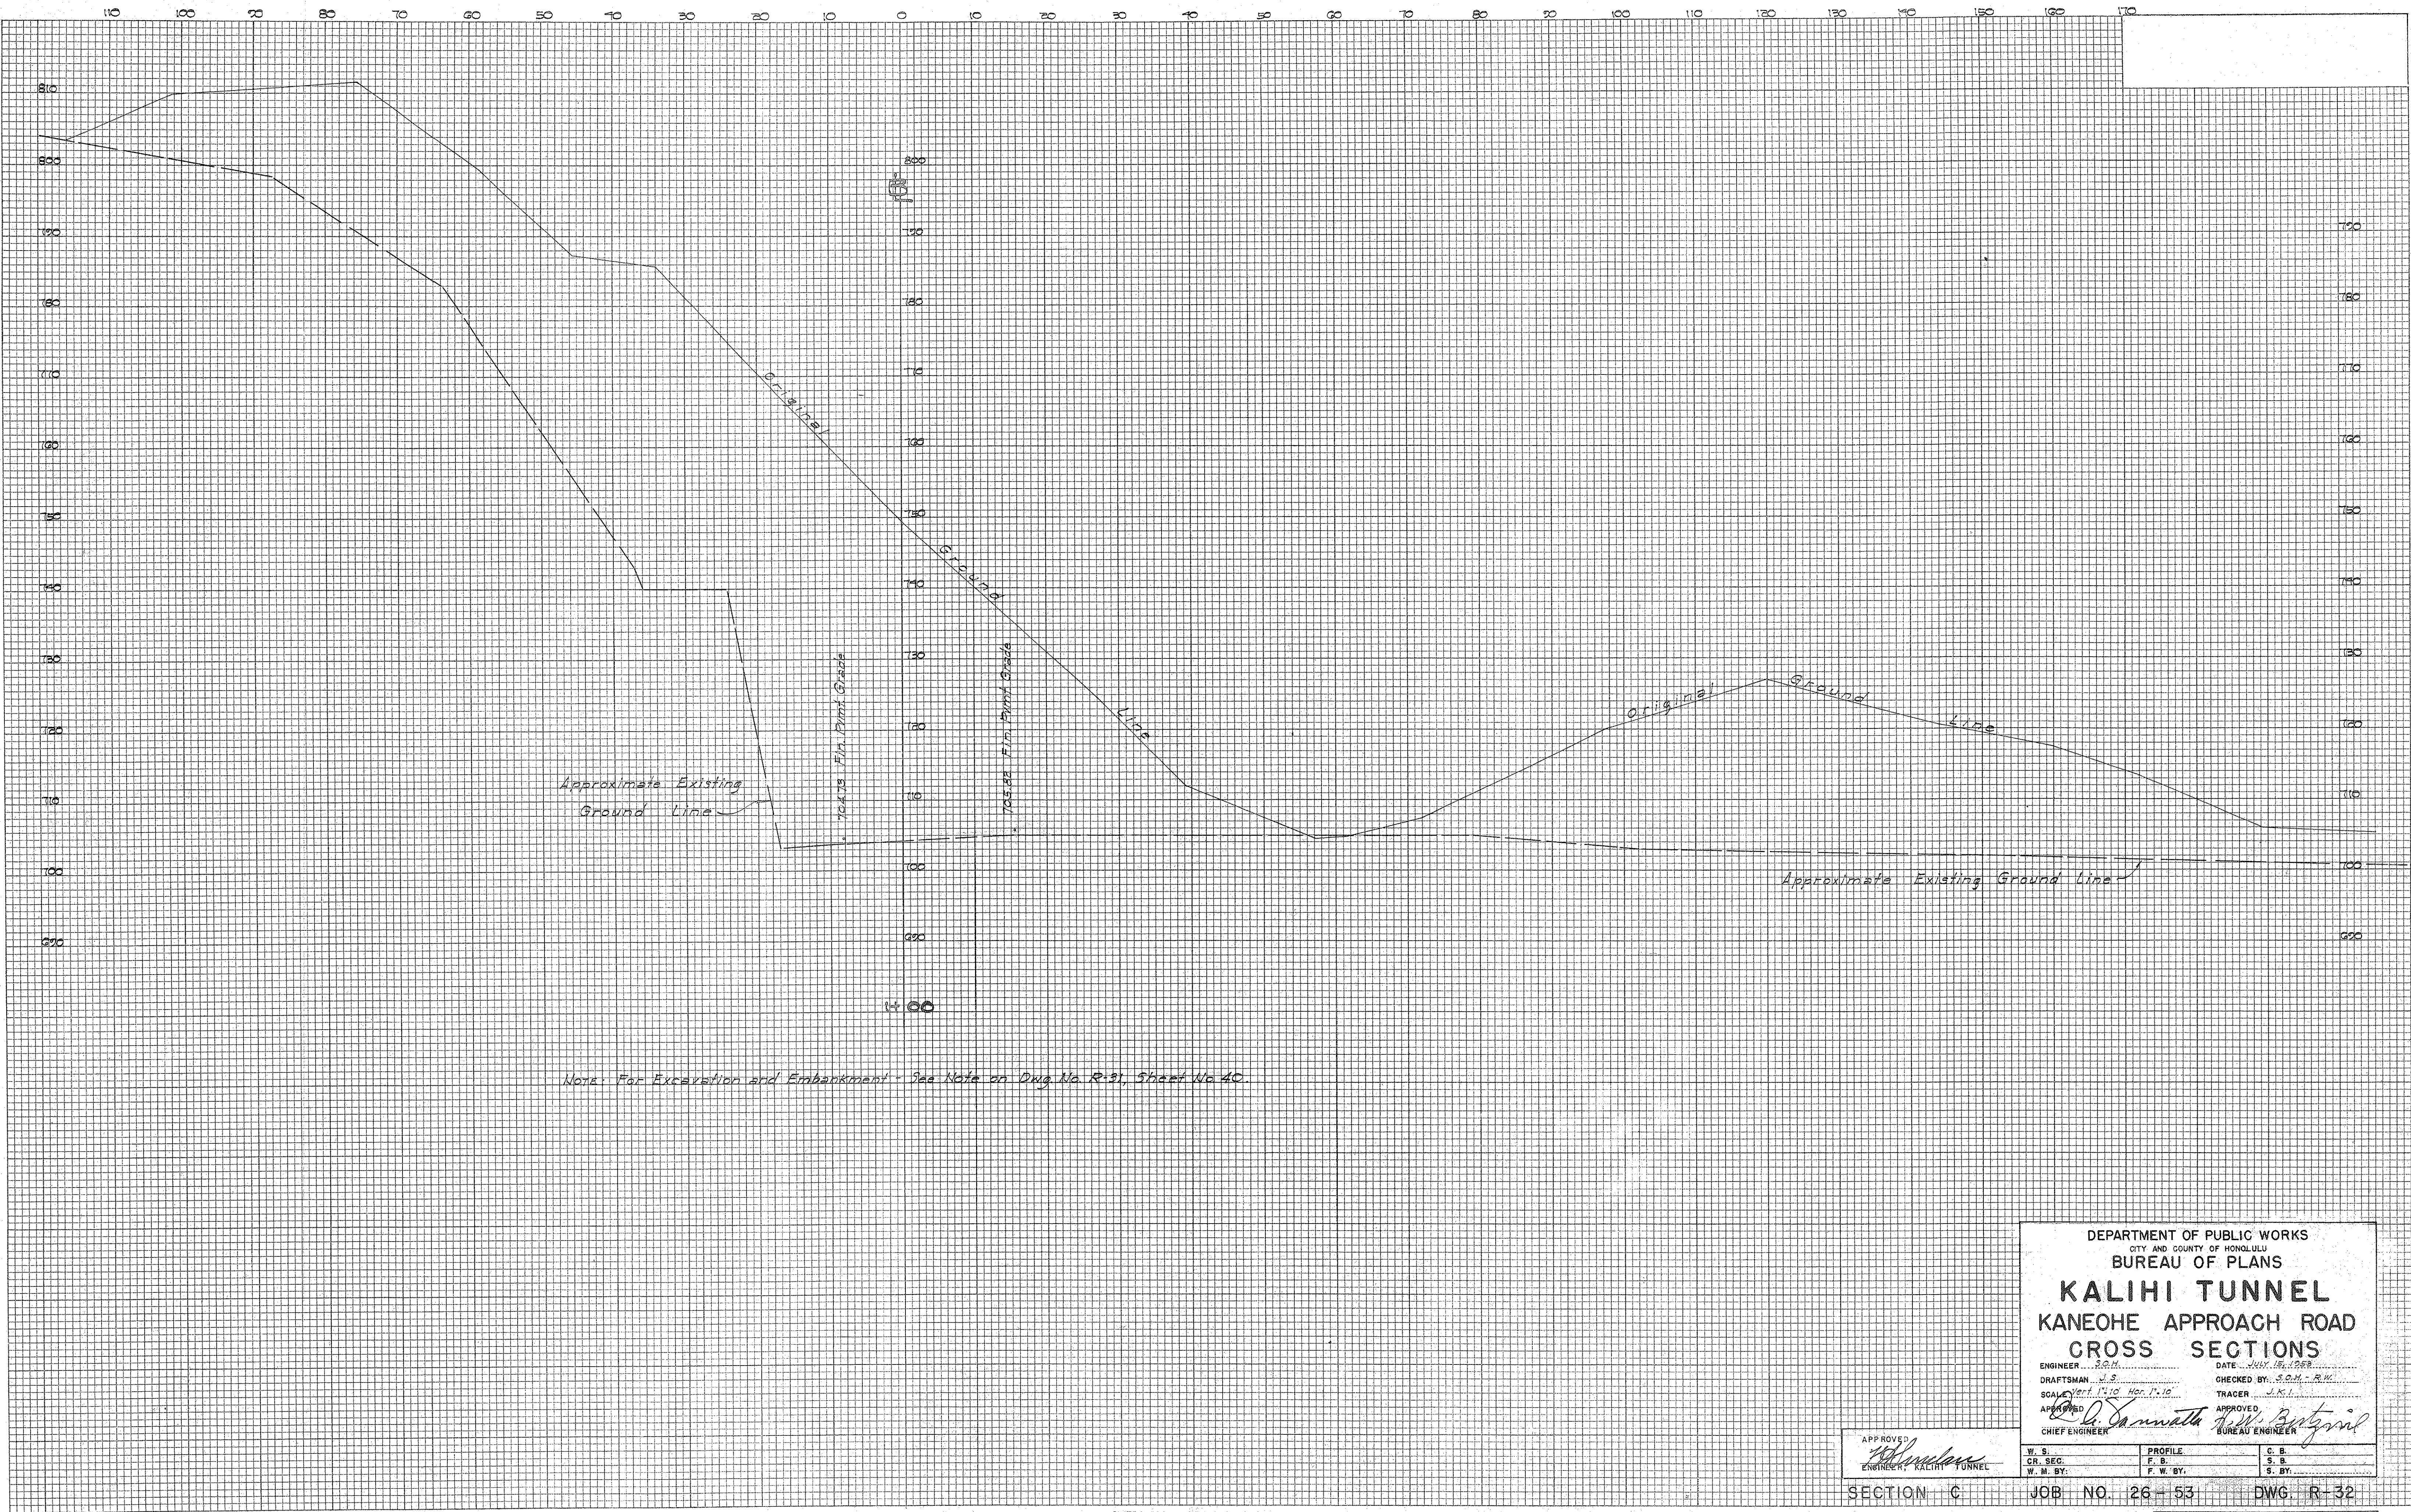

DEPARTMENT OF PUBLIC WORKS CITY AND COUNTY OF HONOLULU BUREAU OF PLANS			
KALIHI TUNNEL			
KANEOHE APPROACH ROAD			
CROSS SECTIONS			
ENGINEER: R.C.H.	DATE: JULY 15, 1928	CHECKED BY: S.M. R.W.	TRACER: S.M. R.W.
DRAFTSMAN: J.S.	SCALE: 1" = 10' HORIZ. 1" = 10' VERT.	APPROVED: D. Samuels	APPROVED: H. Butz
CHIEF ENGINEER	BUREAU ENGINEER		

APPROVED
ENGINEER, KALIHI TUNNEL


W. S.	PROFILE	C. B.
CR. SEC.	F. B.	S. B.
W. M. BY:	F. W. BY:	S. BY:

SECTION C JOB NO. 26-53 DWG. R-32

FILE	POCKET	FOLDER	NO.
7	5	2	4

FINAL	SURVEYED	DATE
SURVEY	BY	
NOTE BOOK	PLOTTED	
NO.	AREAS CHECKED	

ORIGINAL	SURVEYED	DATE
SURVEY	BY	
NOTE BOOK	PLOTTED	
NO.	AREAS CHECKED	

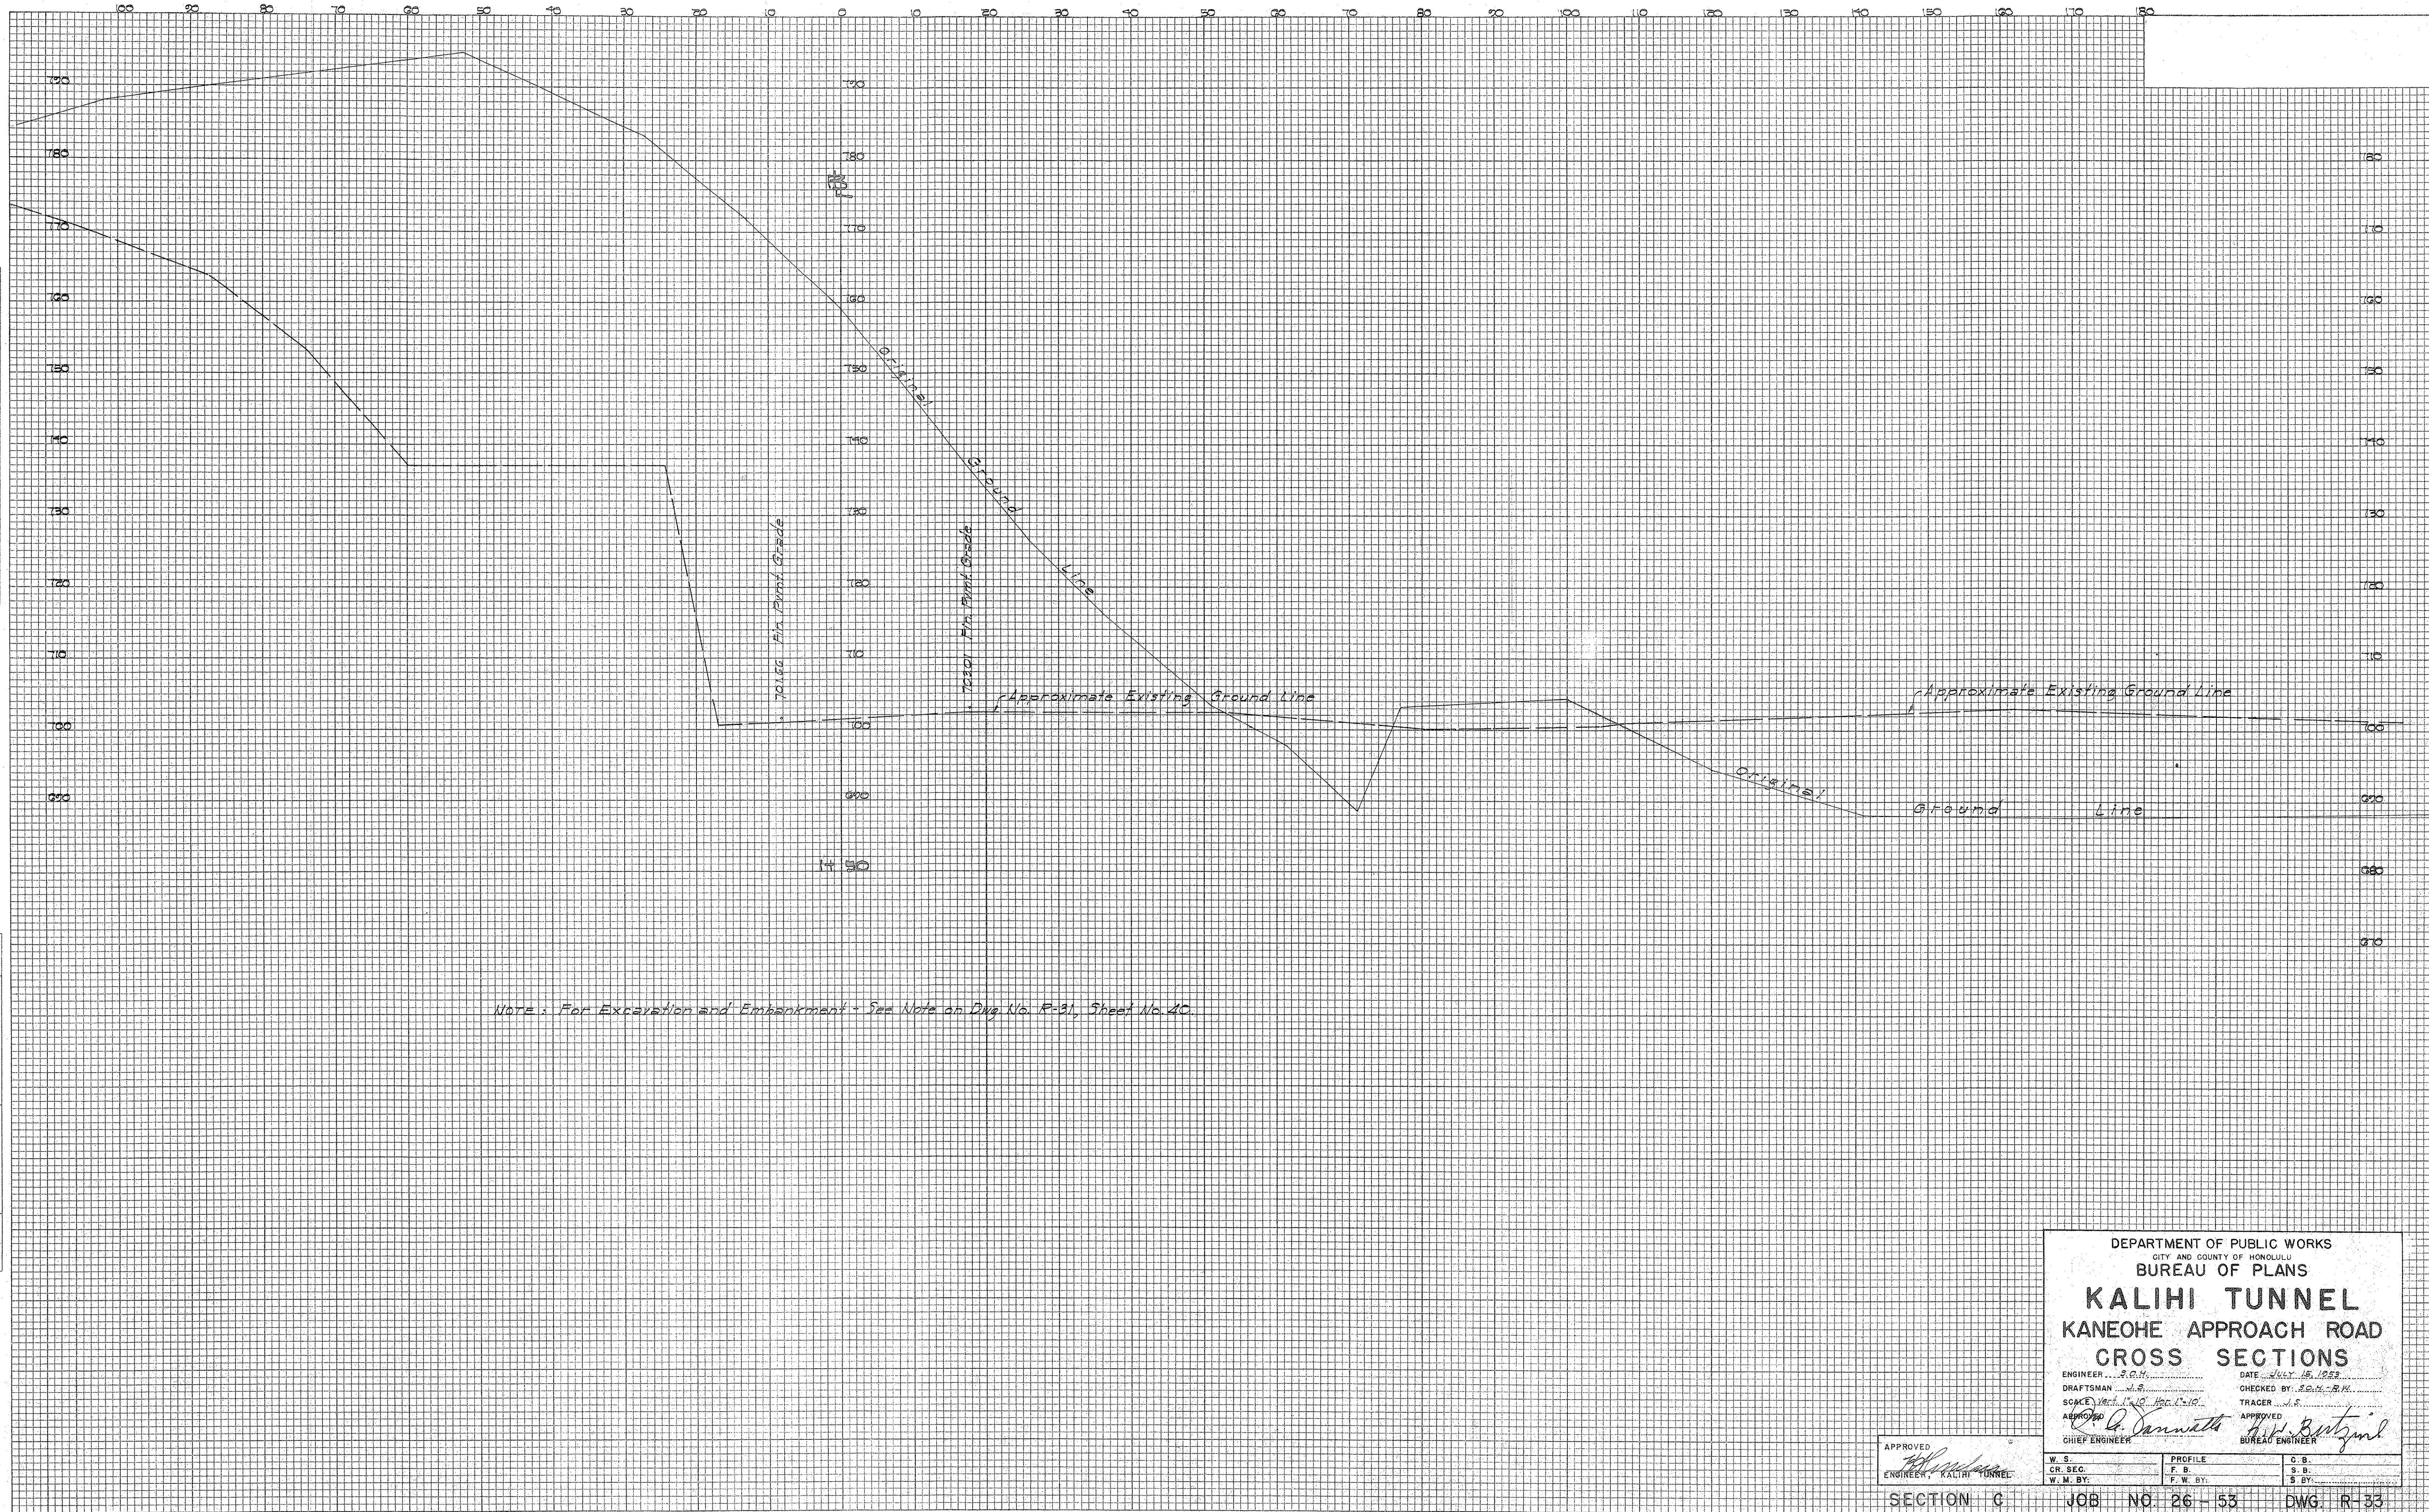

DEPARTMENT OF PUBLIC WORKS CITY AND COUNTY OF HONOLULU BUREAU OF PLANS			
KALIHI TUNNEL KANEHOE APPROACH ROAD CROSS SECTIONS			
ENGINEER	DATE	C. B.	
DRAFTSMAN	CHECKED BY	S. B.	
SCALE	TRACER	S. B.	
APPROVED	APPROVED	S. B.	
CHIEF ENGINEER	BUREAU ENGINEER	S. B.	

APPROVED
ENGINEER, KALIHI TUNNEL


W. S.	PROFILE	C. B.
CR. SEC.	F. B.	S. B.
W. M. BY:	F. W. BY:	S. B.

SECTION C	JOB NO. 26-53	DWG. R-33
-----------	---------------	-----------

FILE	POCKET	FOLDER	NO.
5	5	5	5

FINAL	SURVEYED	DATE
SURVEY	BY	
NOTE BOOK	PLOTTED	
NO.	TEMPLATE	
	AREAS CHECKED	

ORIGINAL	SURVEYED	DATE
SURVEY	BY	
NOTE BOOK	PLOTTED	
NO.	TEMPLATE	
	AREAS CHECKED	

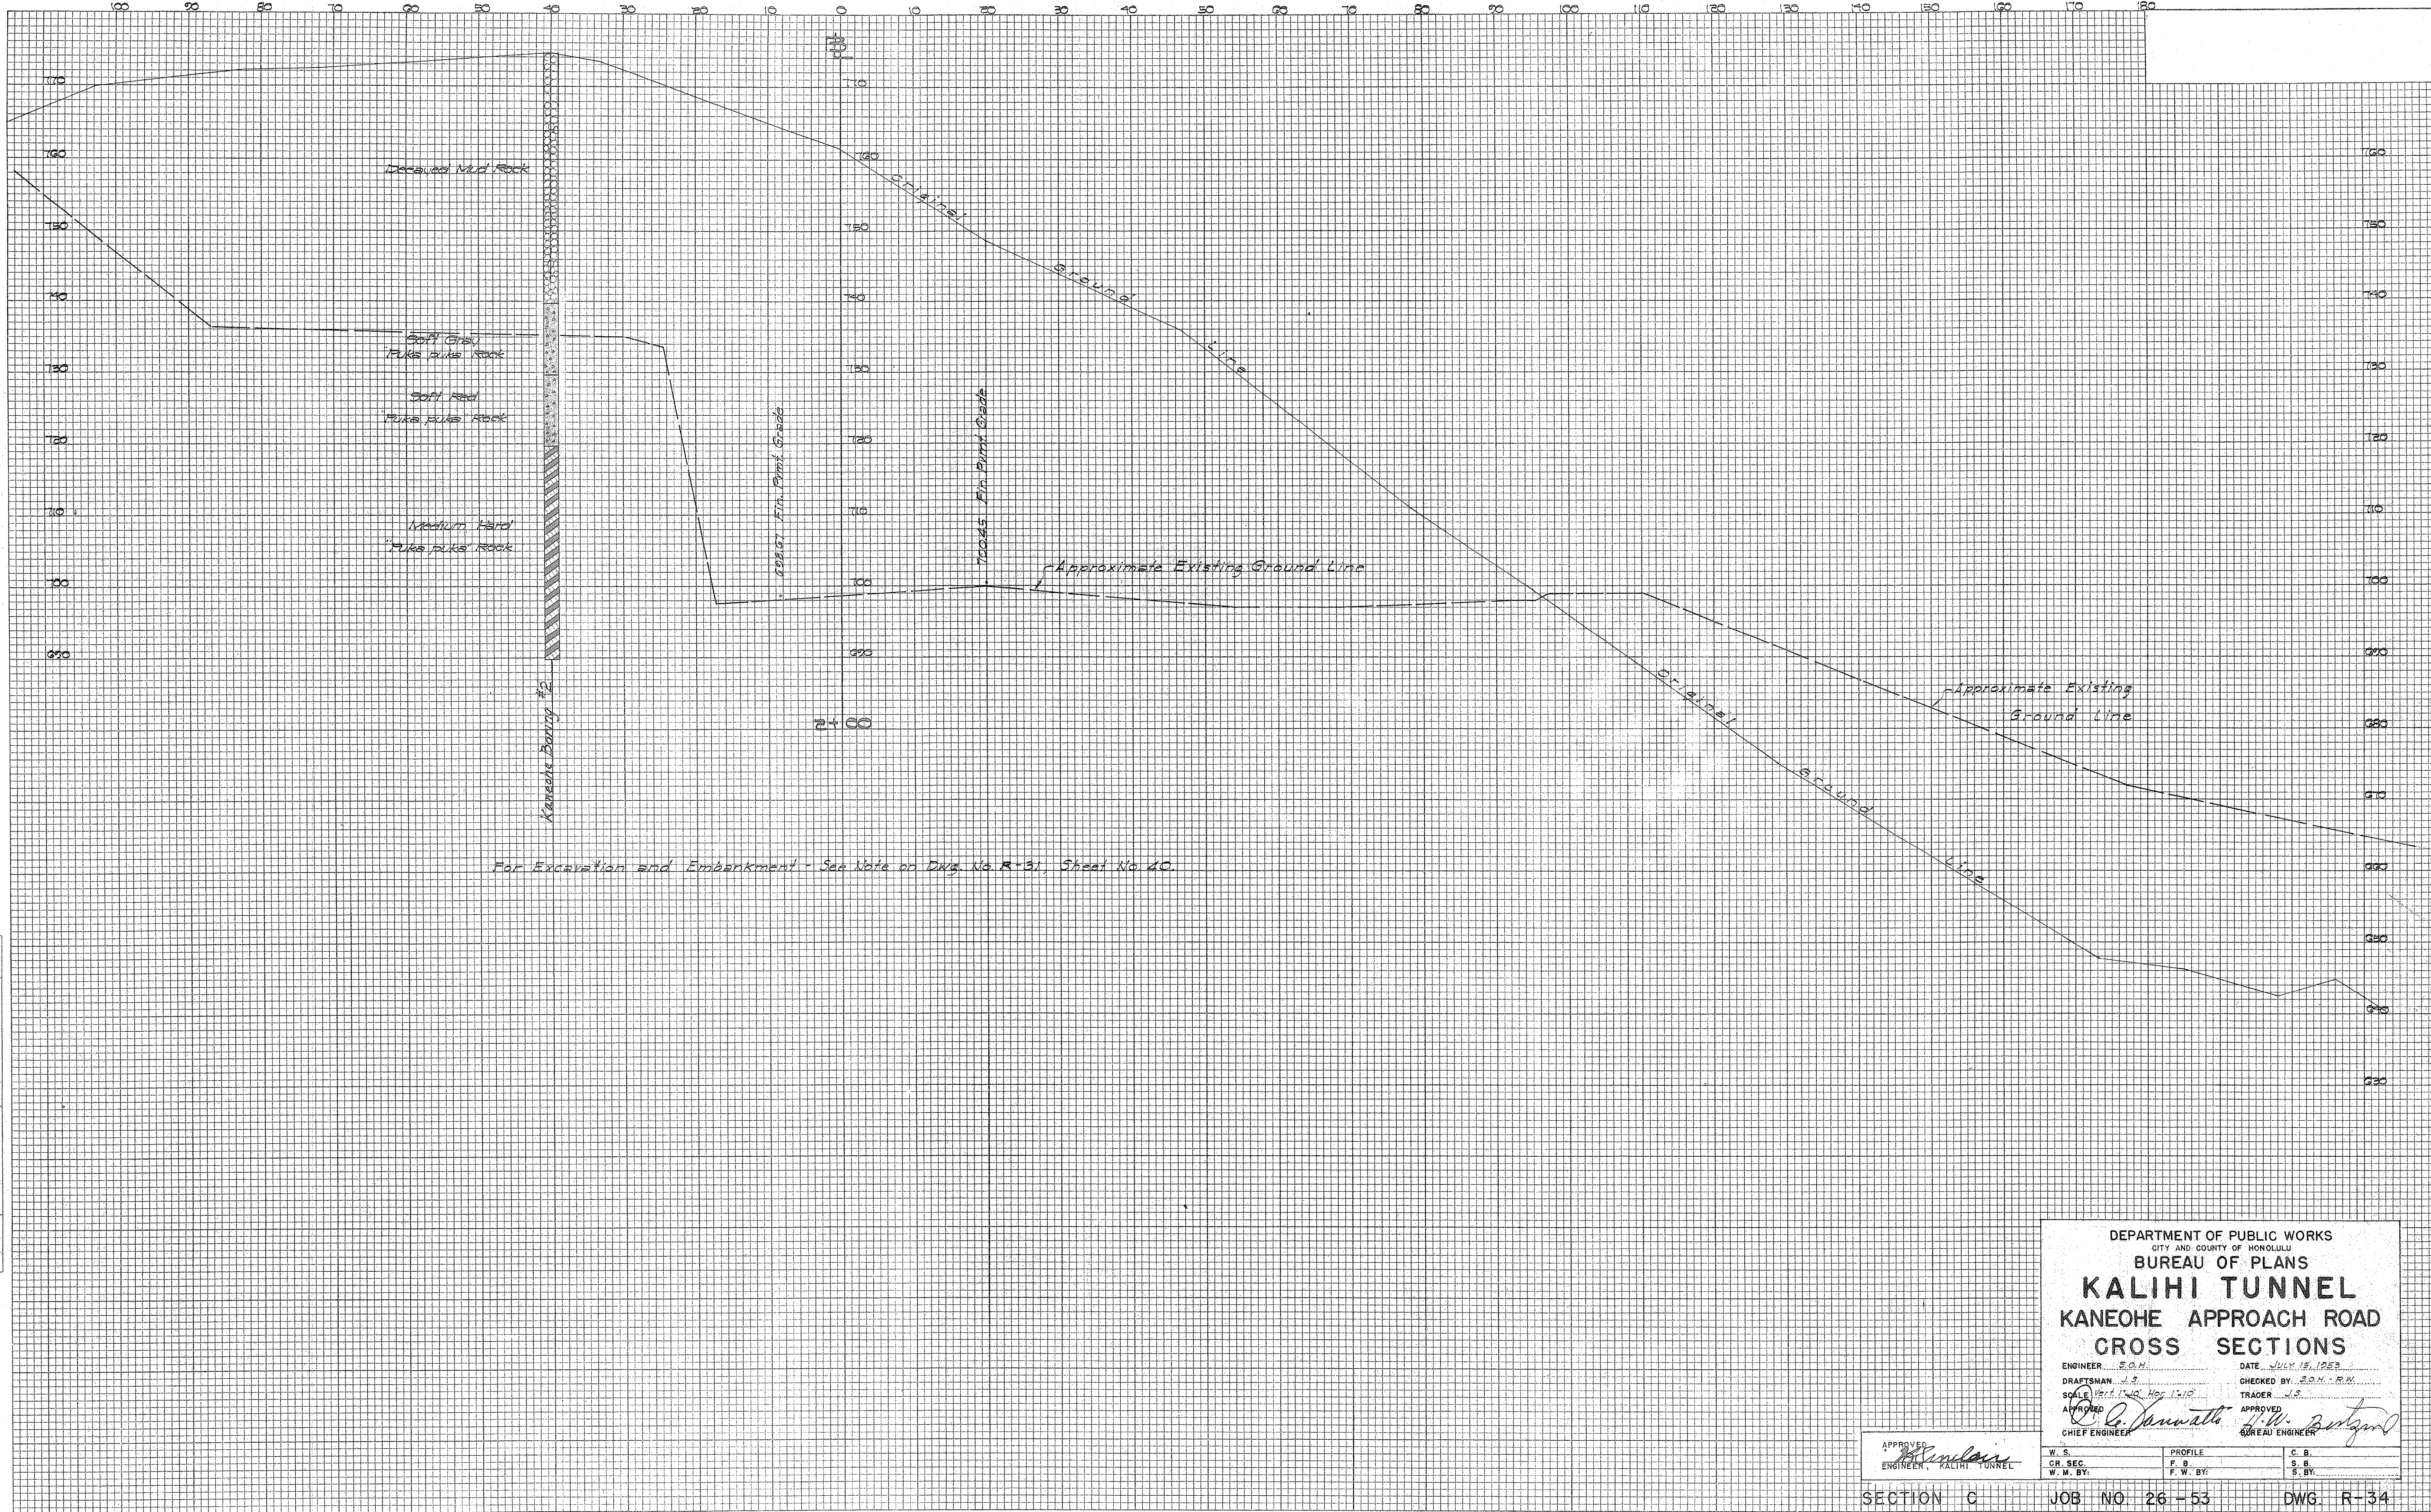

DEPARTMENT OF PUBLIC WORKS CITY AND COUNTY OF HONOLULU			
BUREAU OF PLANS			
KALIHI TUNNEL			
Kaneohe Approach Road			
CROSS SECTIONS			
ENGINEER	S.O.H.	DATE	JULY 15, 1953
DRAFTSMAN	J.S.	CHECKED BY	S.O.H. - R.M.
SCALE	Vert. 1" = 10' Hor. 1" = 10'	TRACER	J.S.
APPROVED	C. J. J. J.	APPROVED	J. W. J.
CHIEF ENGINEER		BUREAU ENGINEER	

APPROVED	ENGINEER, KALIHI TUNNEL
----------	-------------------------


W. S.	PROFILE	C. B.
DR. SEC.	F. S.	S. S.
W. M. BY.	F. W. BY.	S. BY.

SECTION C JOB NO. 26-53 DWG. R-34

FILE	POCKET	FOLDER	NO.
7	5	2	6

FINAL SURVEY	SURVEYED	BY	DATE
NO.	PLOTTED		
	TEMP. PLATE		
	AREAS		
	CHECKED		

ORIGINAL SURVEY	SURVEYED	BY	DATE
NO.	PLOTTED		
	TEMP. PLATE		
	AREAS		
	CHECKED		

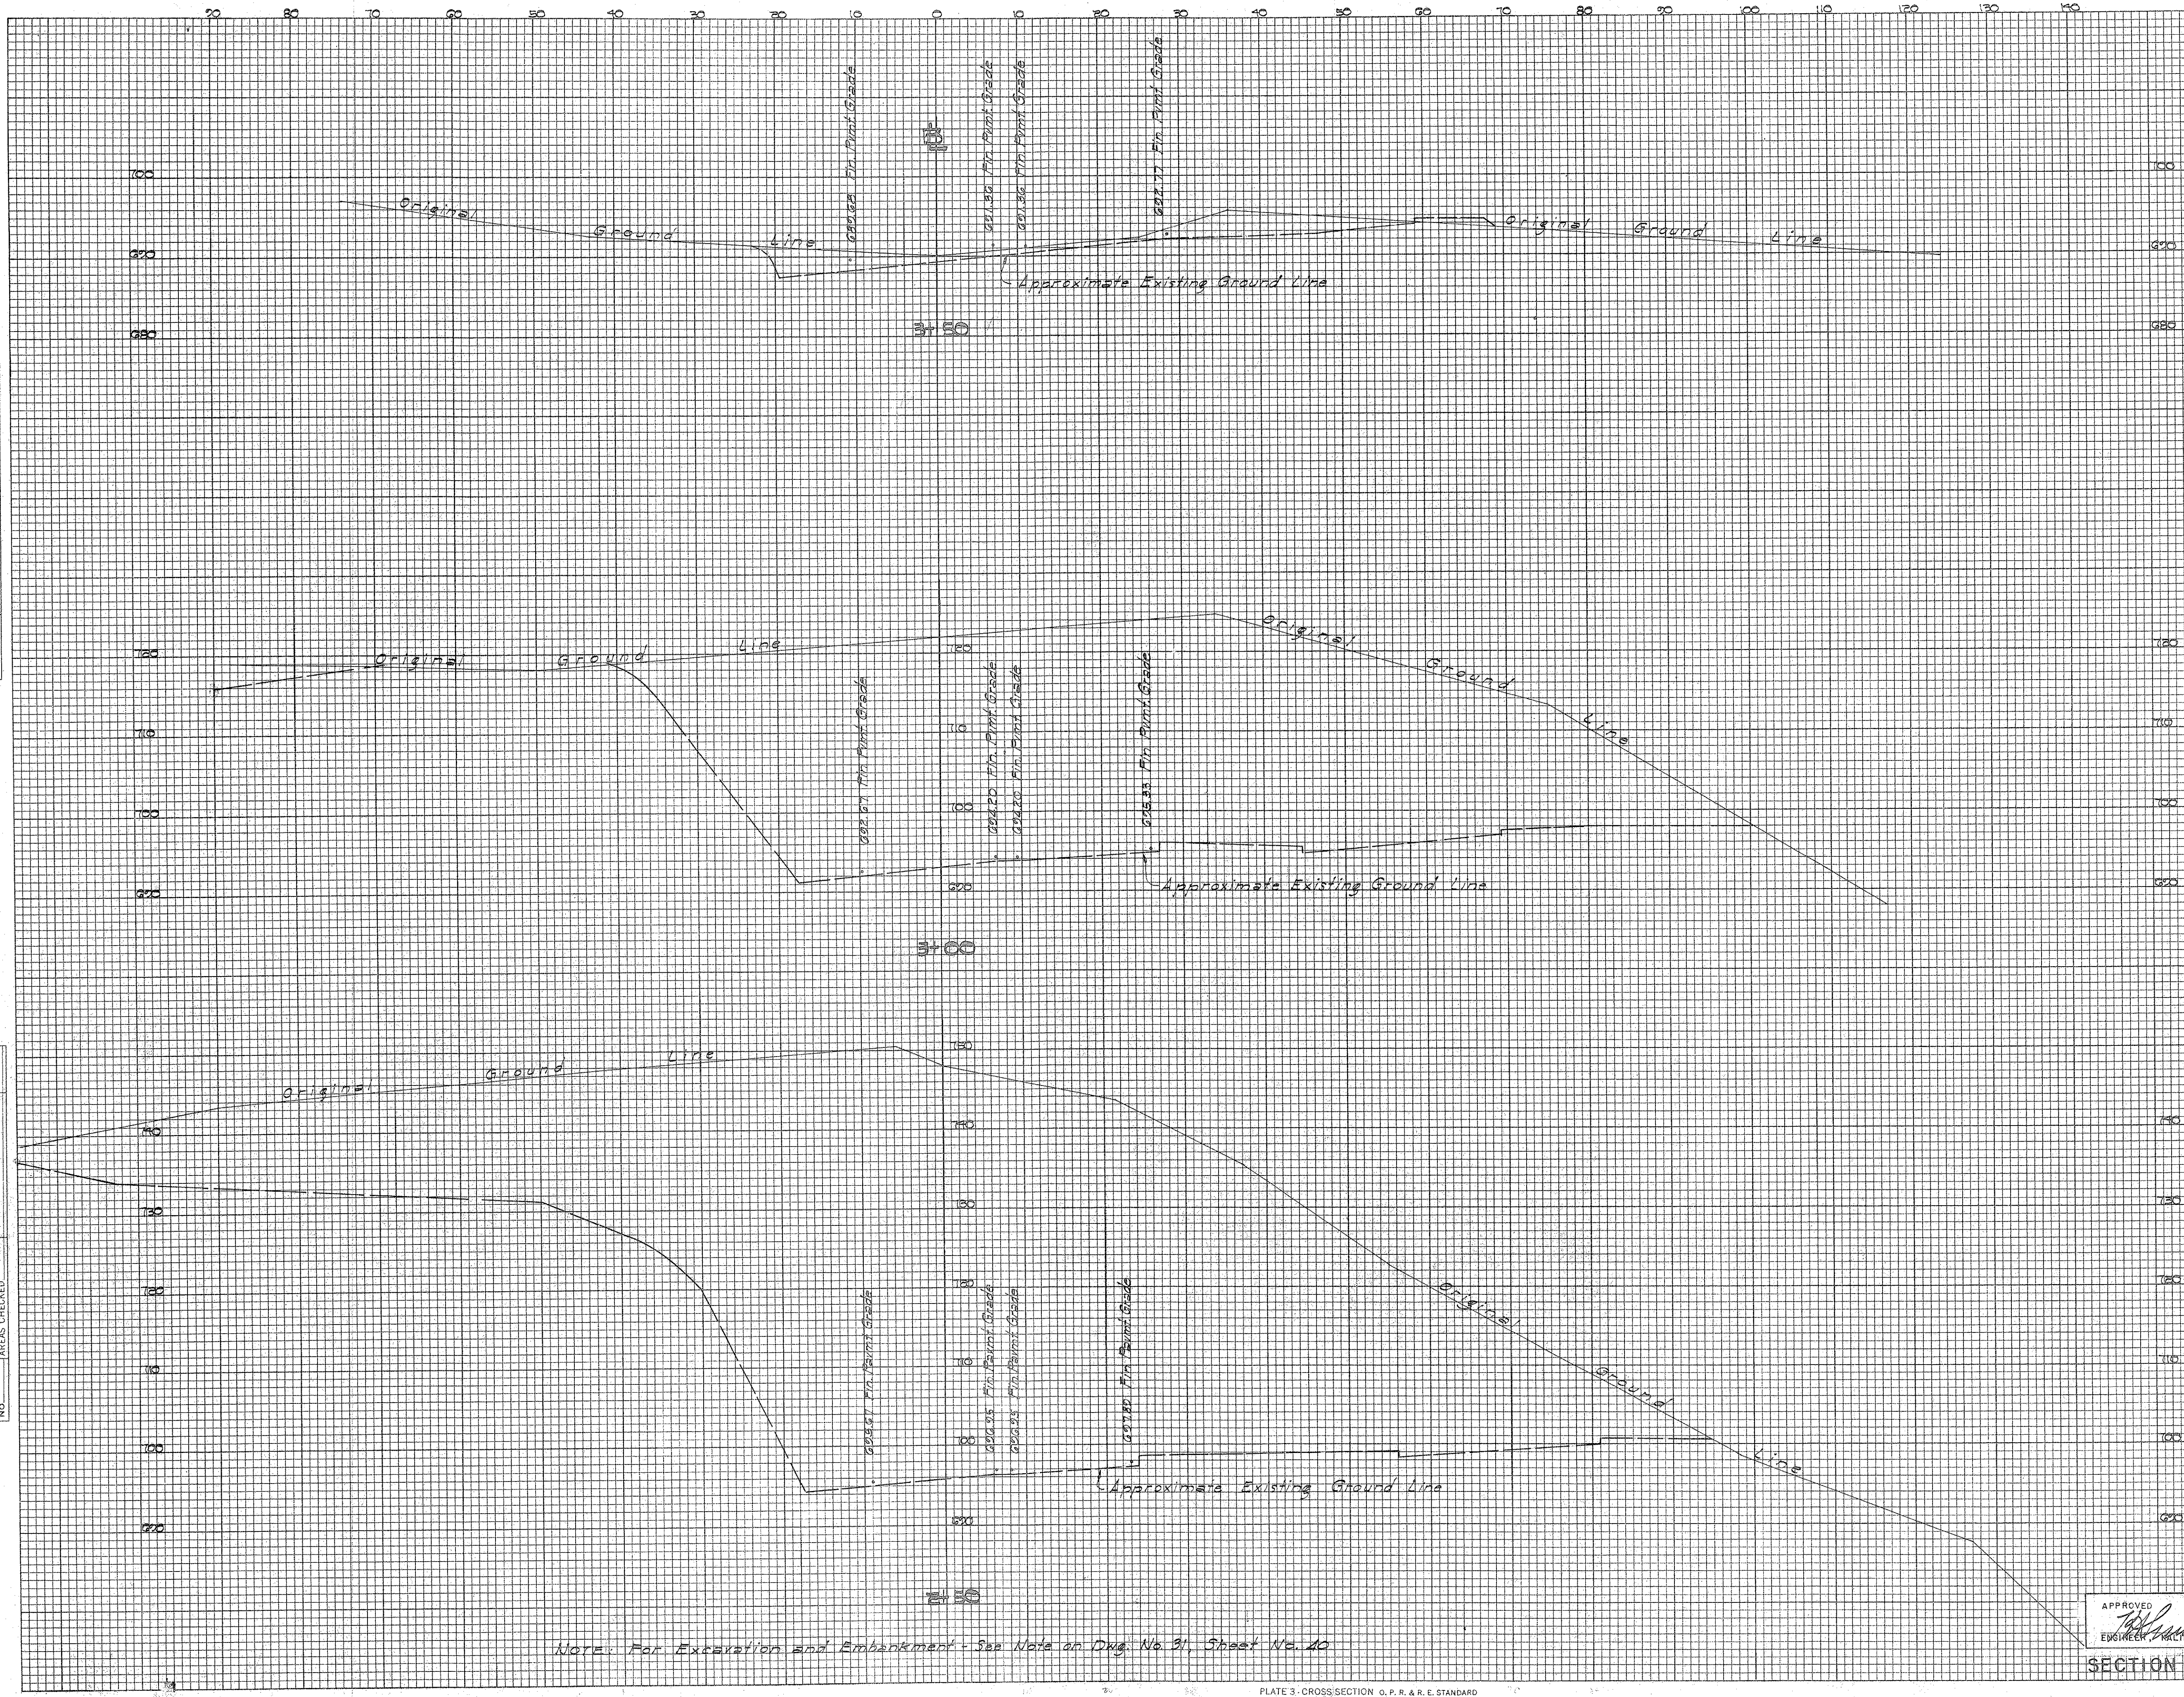

Note: For Excavation and Embankment - See Note on Dwg. No. 31, Sheet No. 40

DEPARTMENT OF PUBLIC WORKS CITY AND COUNTY OF HONOLULU BUREAU OF PLANS			
KALIHI TUNNEL			
KANEOHE APPROACH ROAD			
CROSS SECTIONS			
ENGINEER	S.D.H.	DATE	JULY 15, 1953
DRAFTSMAN	J.S.	CHECKED BY	S.D.H.
SCALE	1" = 10'	TRACER	J.S.
APPROVED	<i>[Signature]</i>	APPROVED	<i>[Signature]</i>
CHIEF ENGINEER		BUREAU ENGINEER	

APPROVED
[Signature]
ENGINEER

SECTION C	JOB NO. 26-53	DWG. R-35
-----------	---------------	-----------

FILE	POCKET	FOLDER	NO.
7	5	2	7